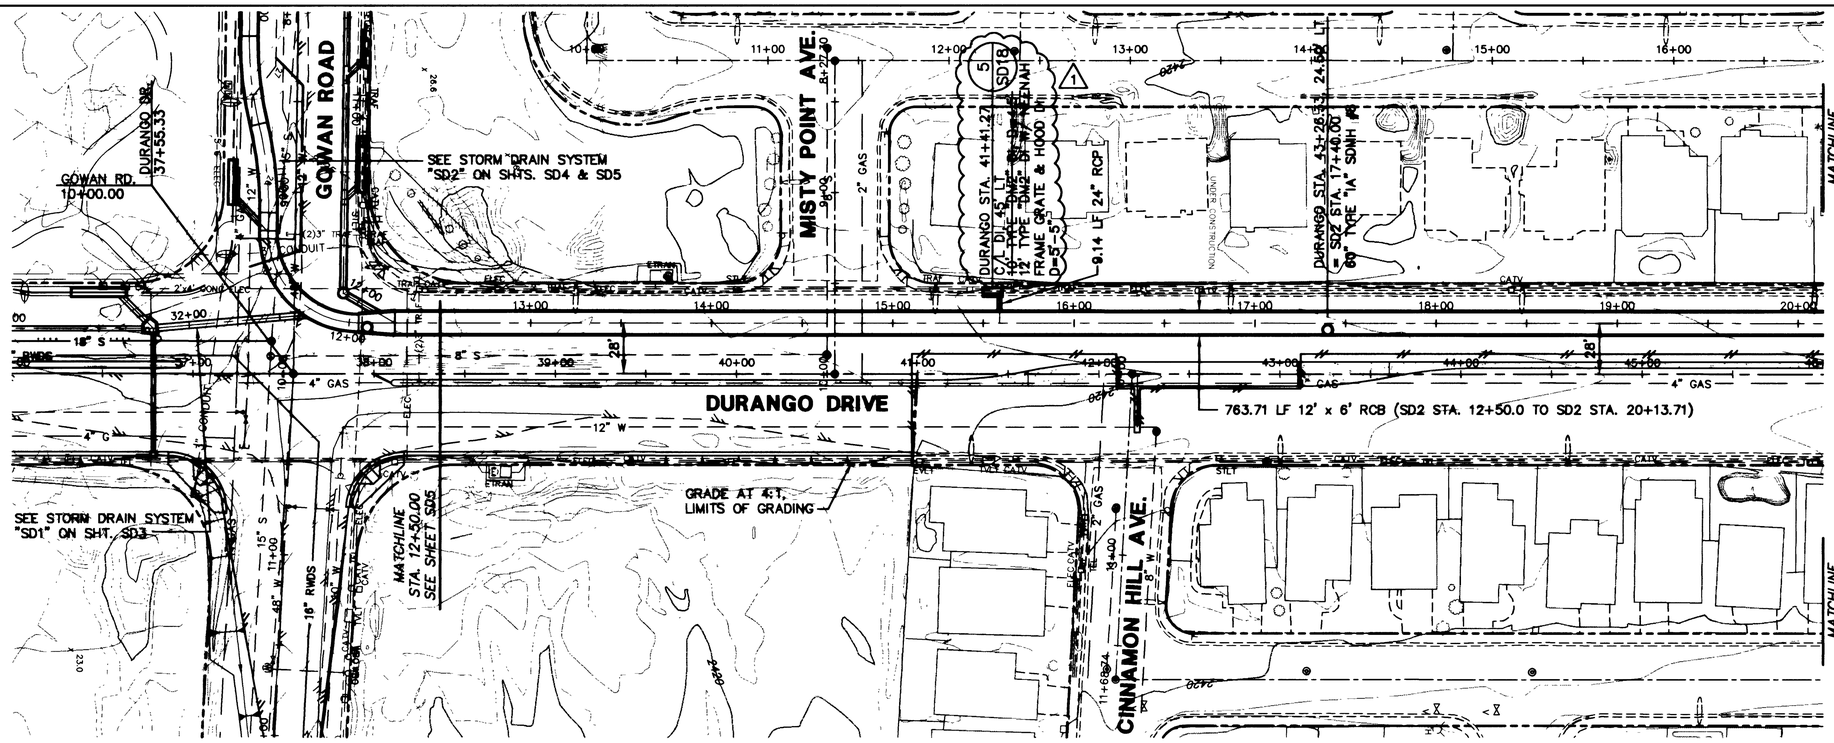

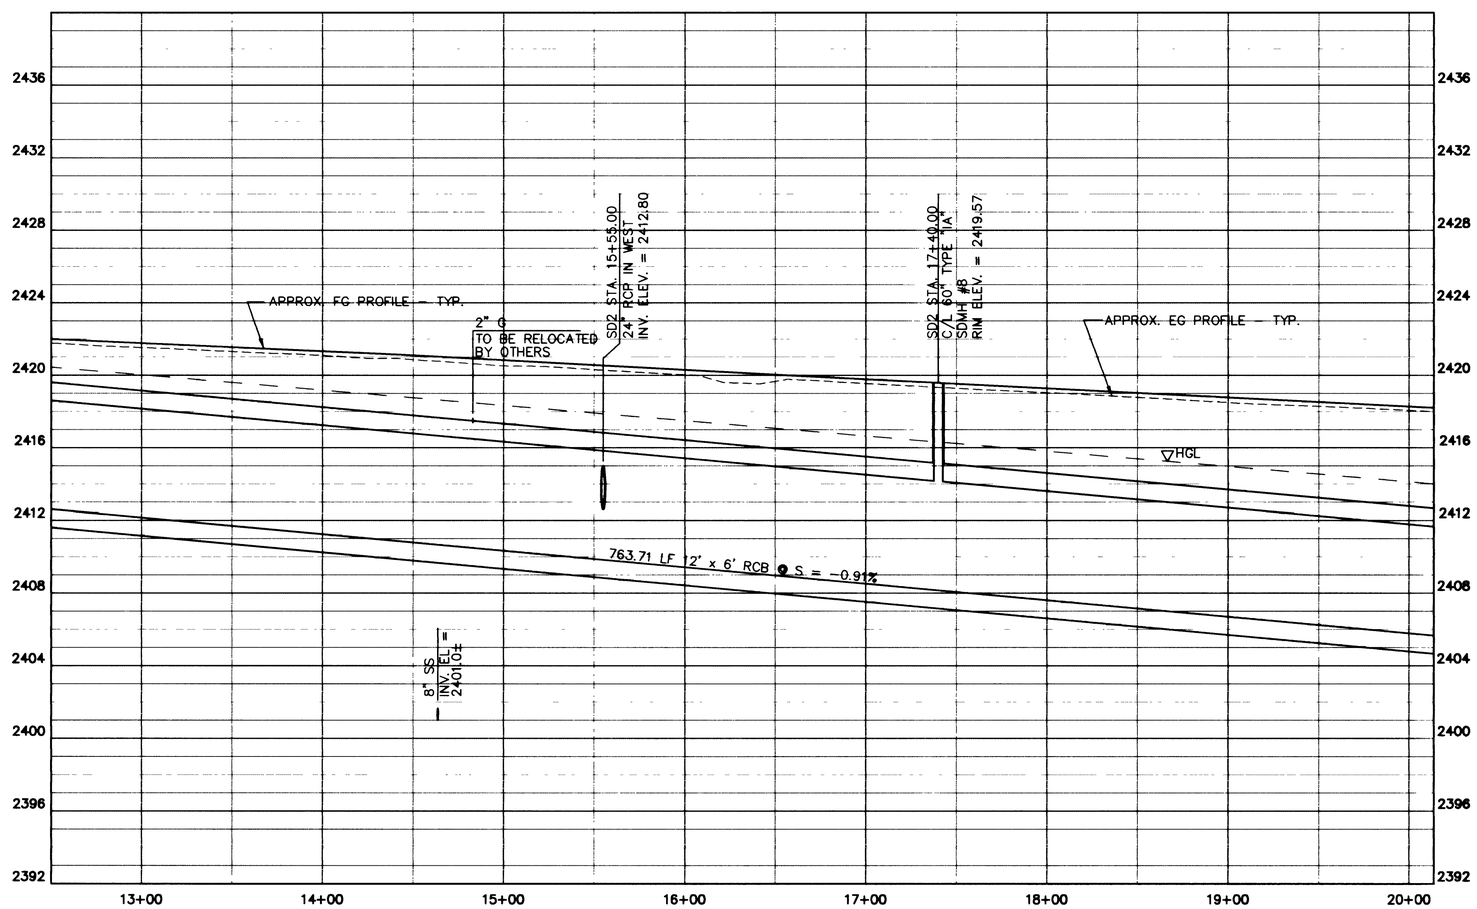

NOTES:
1. ALL RCP IS TO BE CLASS III.
2. ALL MH SHOWN ON THIS SHEET TO HAVE 30" RING & COVER
3. ALL RCB SHALL BE PRECAST RCB.
4. INSTALL MH STEPS PER STD. DWG. #410 AT MH RISER AND RCB.

REV	DATE	BY	REVISION
1	02/08/01	KJO	REVISED PER AS-BUILTS

DEPARTMENT OF PUBLIC WORKS
CITY OF LAS VEGAS, NEVADA

vtn nevada
CONSULTING ENGINEERS • PLANNERS • LAND SURVEYORS
2727 SOUTH RAINBOW BOULEVARD
LAS VEGAS, NEVADA 89102-5148 PHONE (702) 873-7550 FAX (702) 362-2597

DRAWING: STORM DRAIN PLAN AND PROFILE SD2 STA. 12+50.00 TO 20+13.71 DURANGO DRIVE

PROJECT: DURANGO DRIVE IMPROVEMENTS CHEYENNE AVENUE TO LONE MOUNTAIN ROAD

SEAL

W.O. NO.	5249
BY	JL,LMW,WBM
DATE	07/17/98
SCALE HORIZ. VERT.	1"=40' 1"=4'
DRAWING	SD6
SHEET	57 OF 106 SHEETS

VIEWS: MS = "D", PS = "PLT"
I:\CAD\PUBWRK\5249\5249-SD.DWG

32241

RECORD DRAWING 03/23/01