

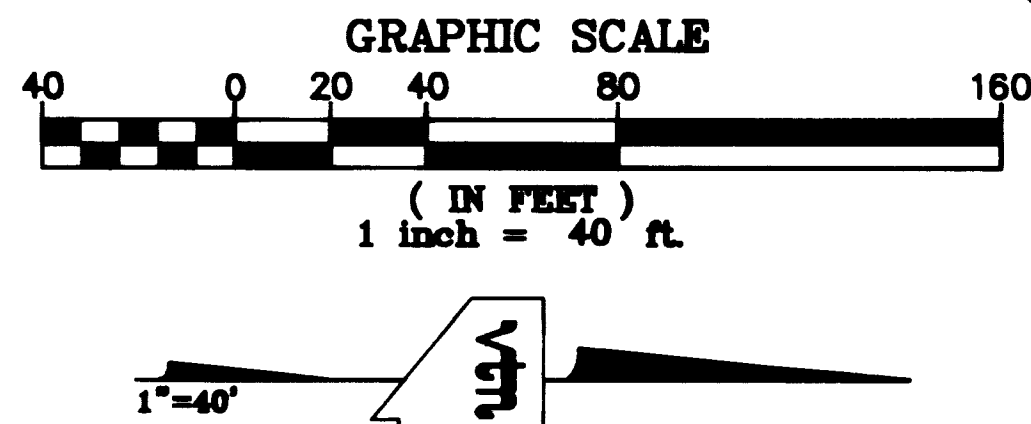
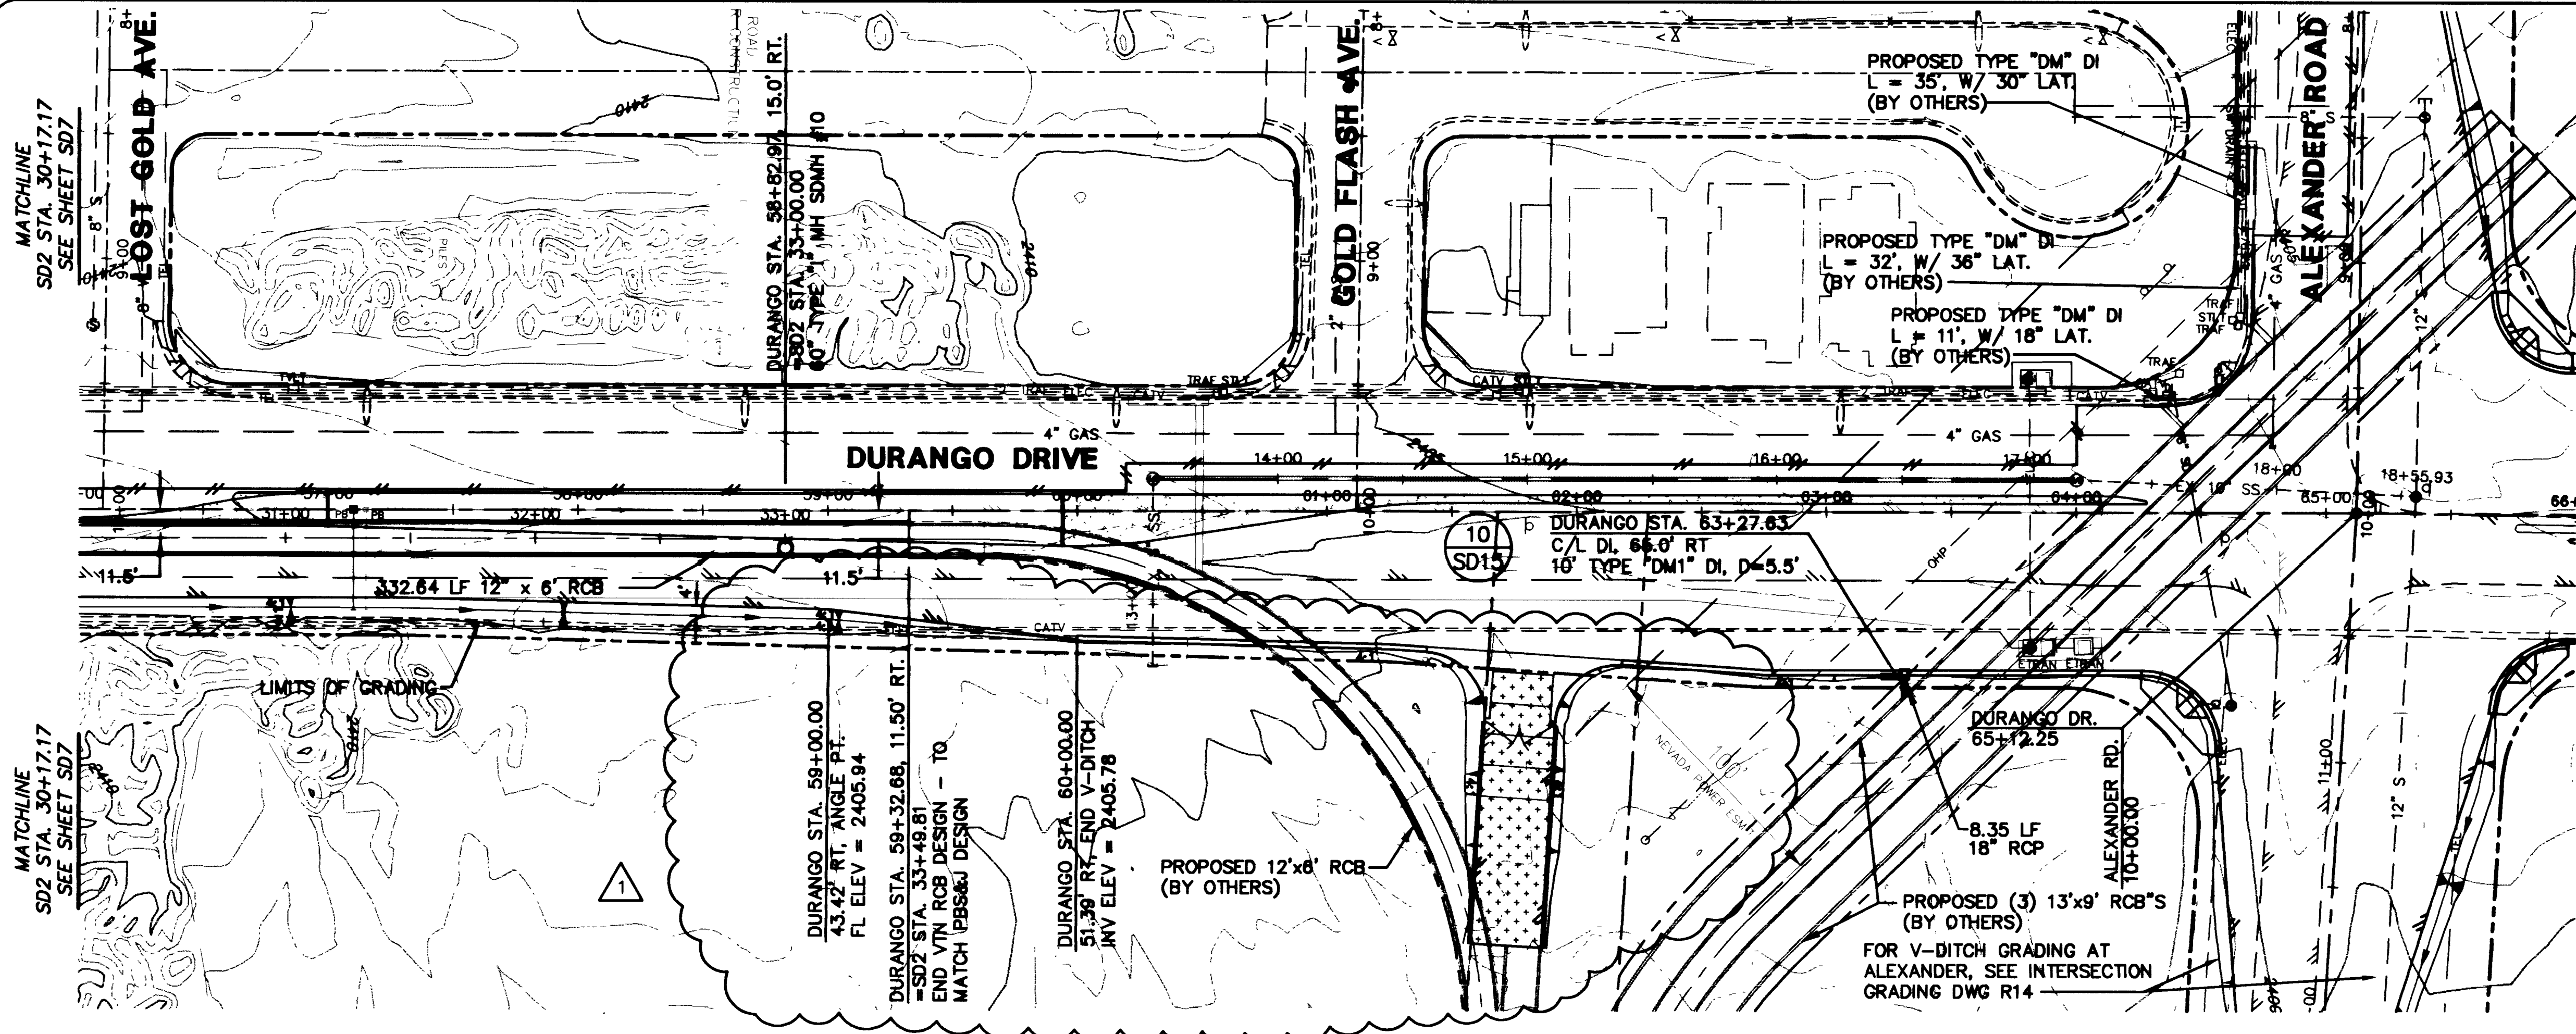


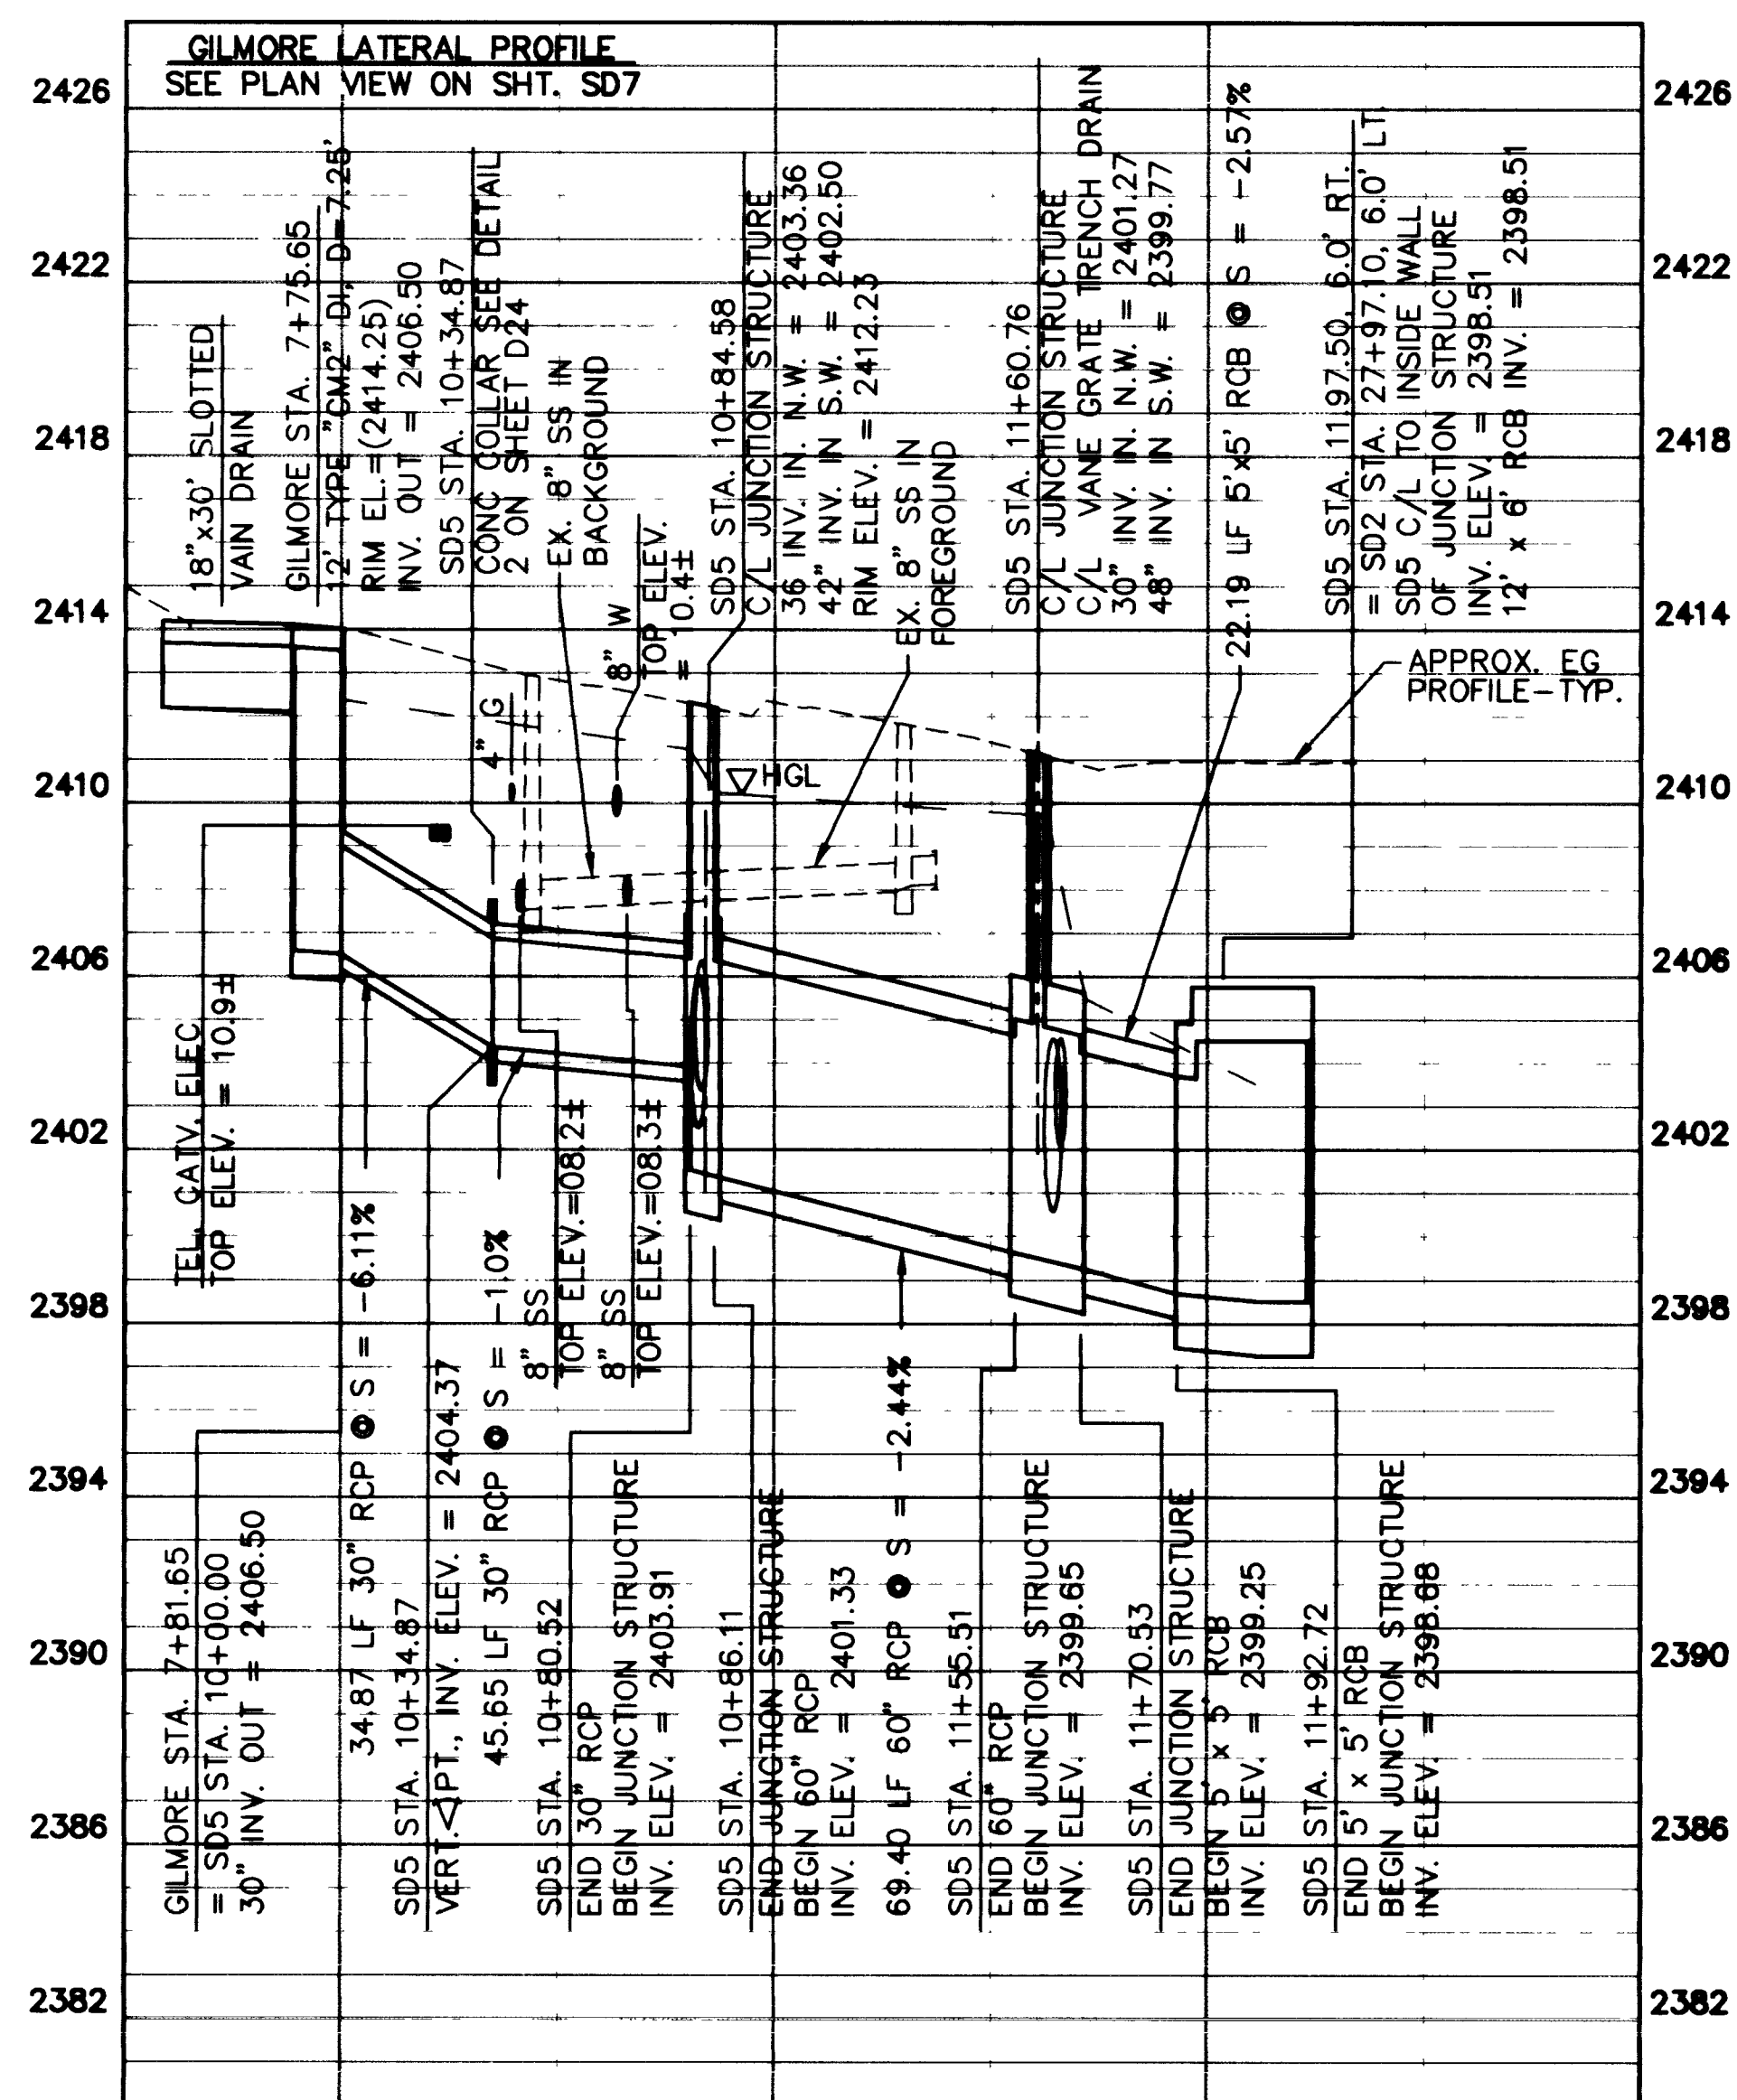

- NOTES:**
1. ALL RCP IS TO BE CLASS III.
 2. ALL MH SHOWN ON THIS SHEET TO HAVE 30\"/>

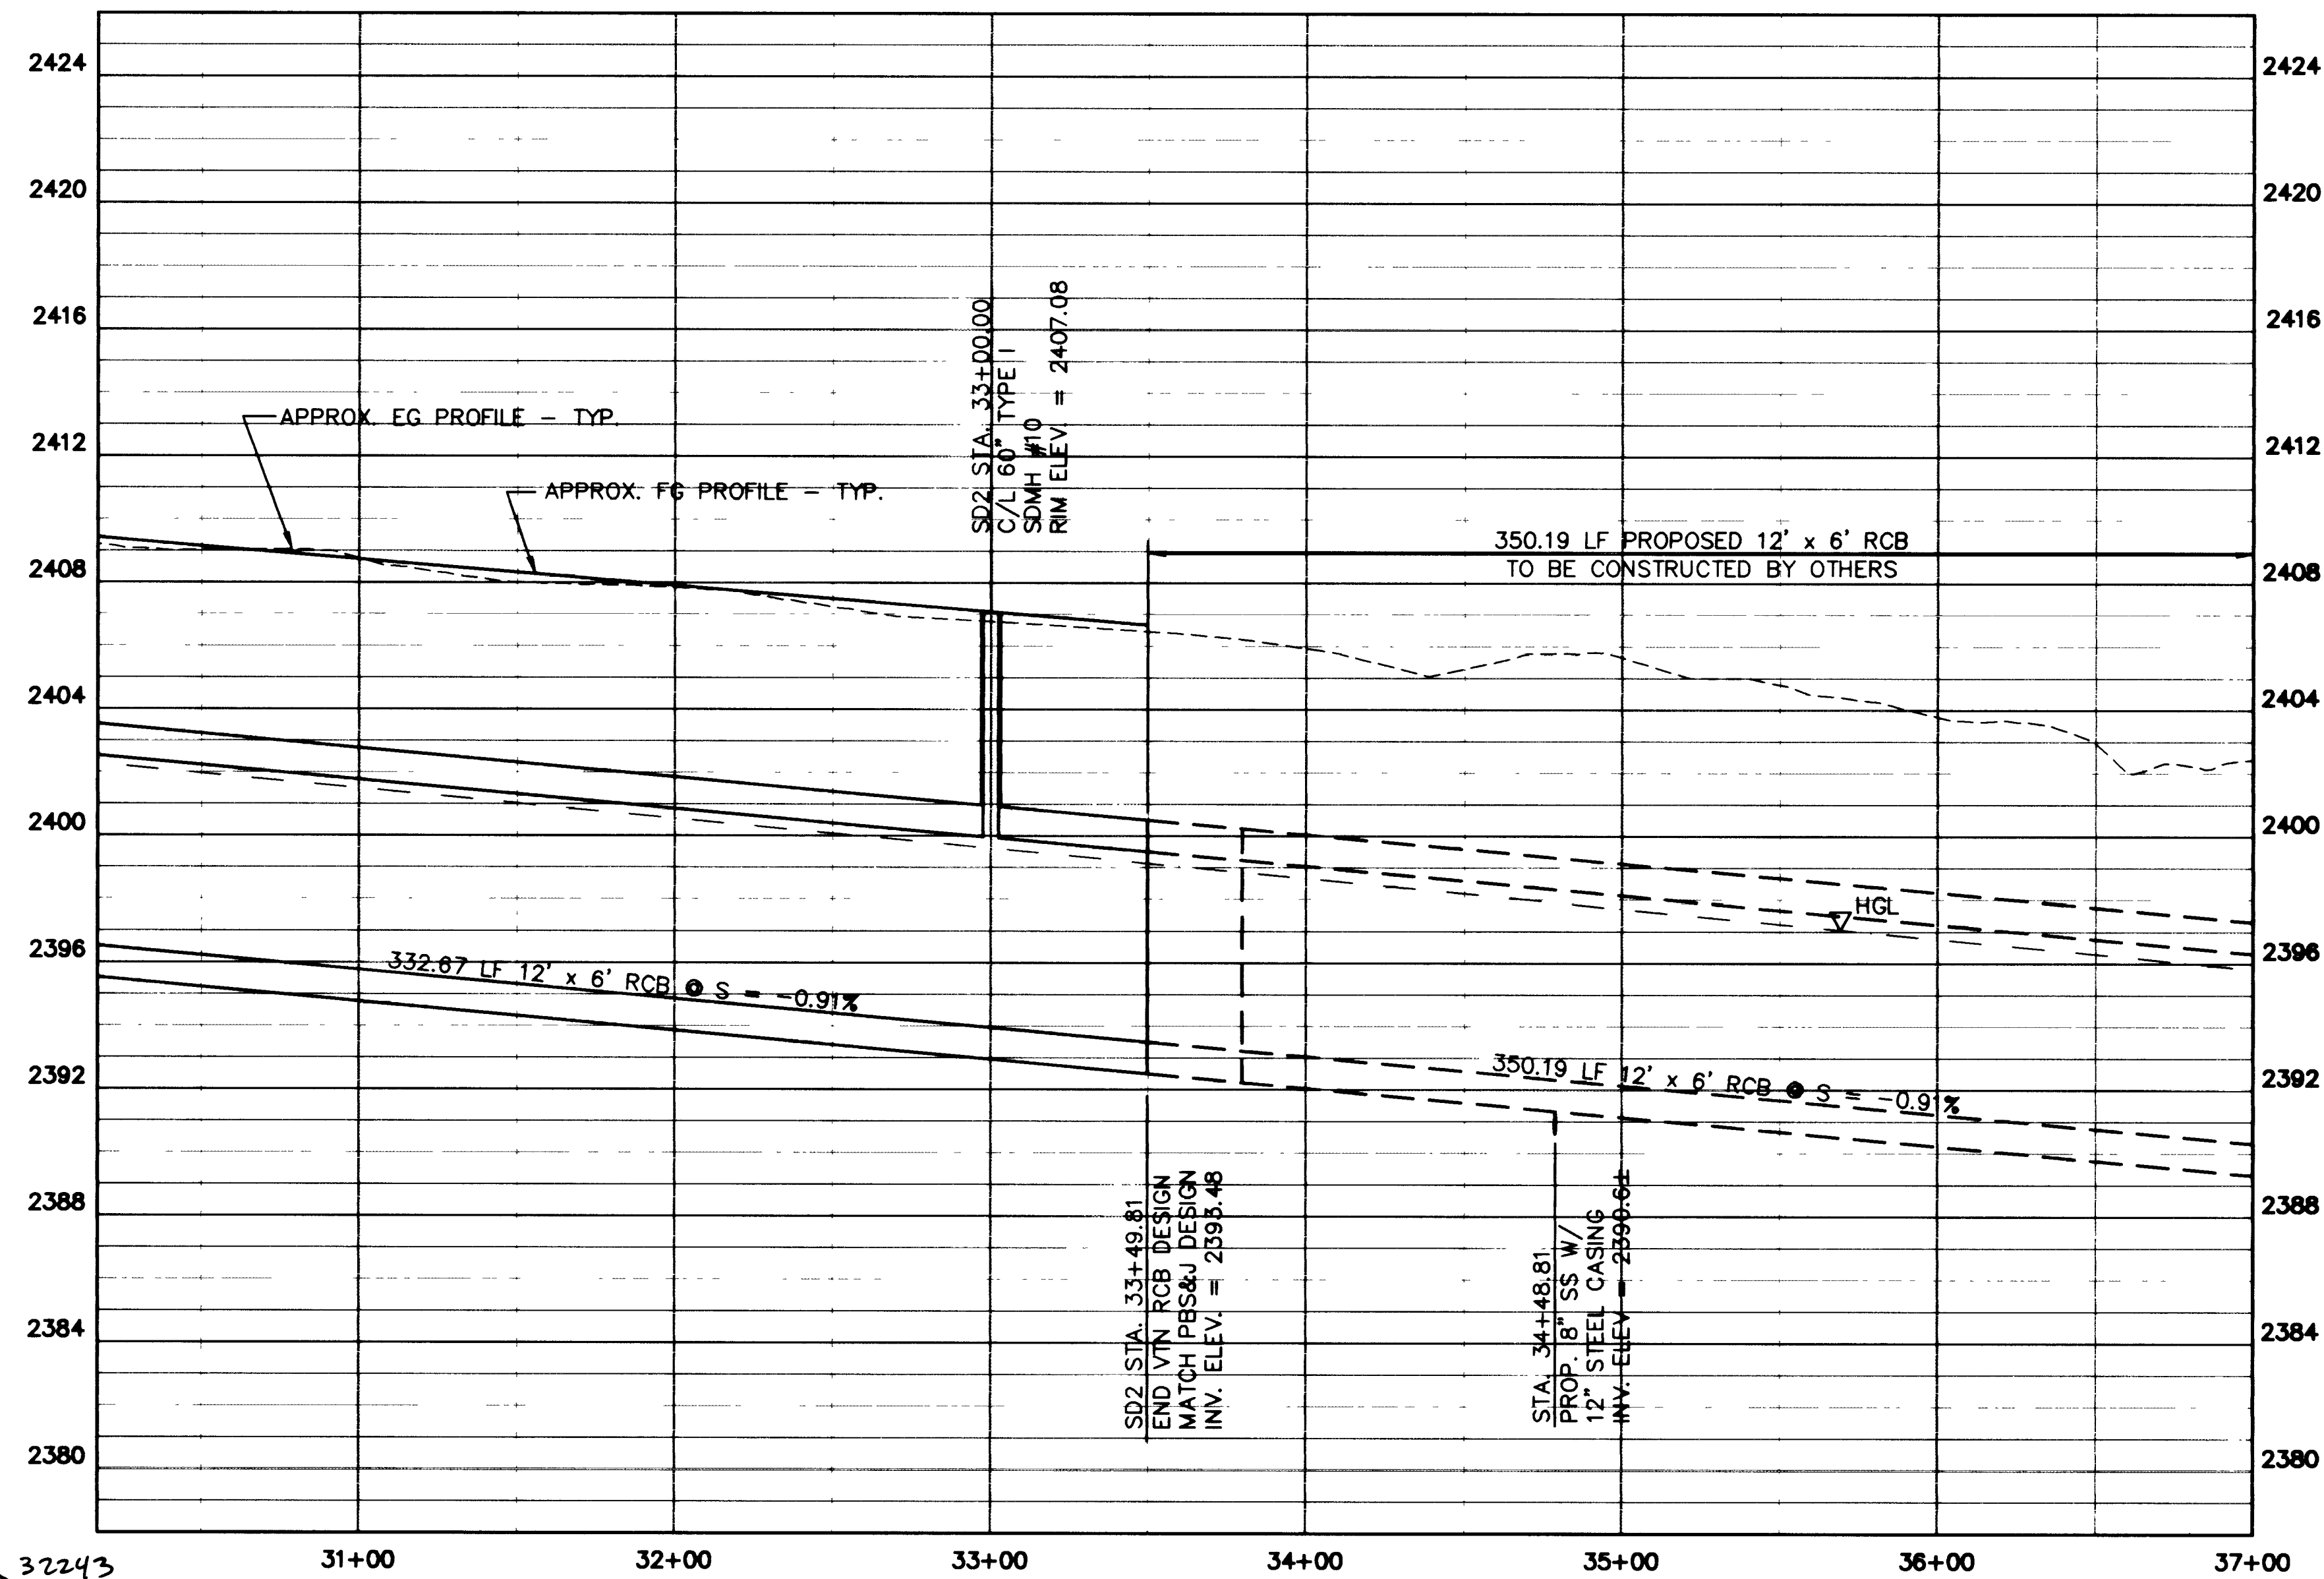

DEPARTMENT OF PUBLIC WORKS CITY OF LAS VEGAS, NEVADA		CONSULTING ENGINEERS • PLANNERS • LAND SURVEYORS 2727 SOUTH RAINBOW BOULEVARD LAS VEGAS, NEVADA 89102-5148 PHONE (702) 873-7550 FAX (702) 362-2597	
PROJECT DURANGO DRIVE IMPROVEMENTS CHEYENNE AVENUE TO LONE MOUNTAIN ROAD		SHEET 59 OF 106	
NO. NO. 5249		BY JL, LMW, WBM	
DATE 07/17/08		SCALE HORIZ. 1"=40' VERT. 1"=4'	
DRAWING SD8		REVISION DATE BY	