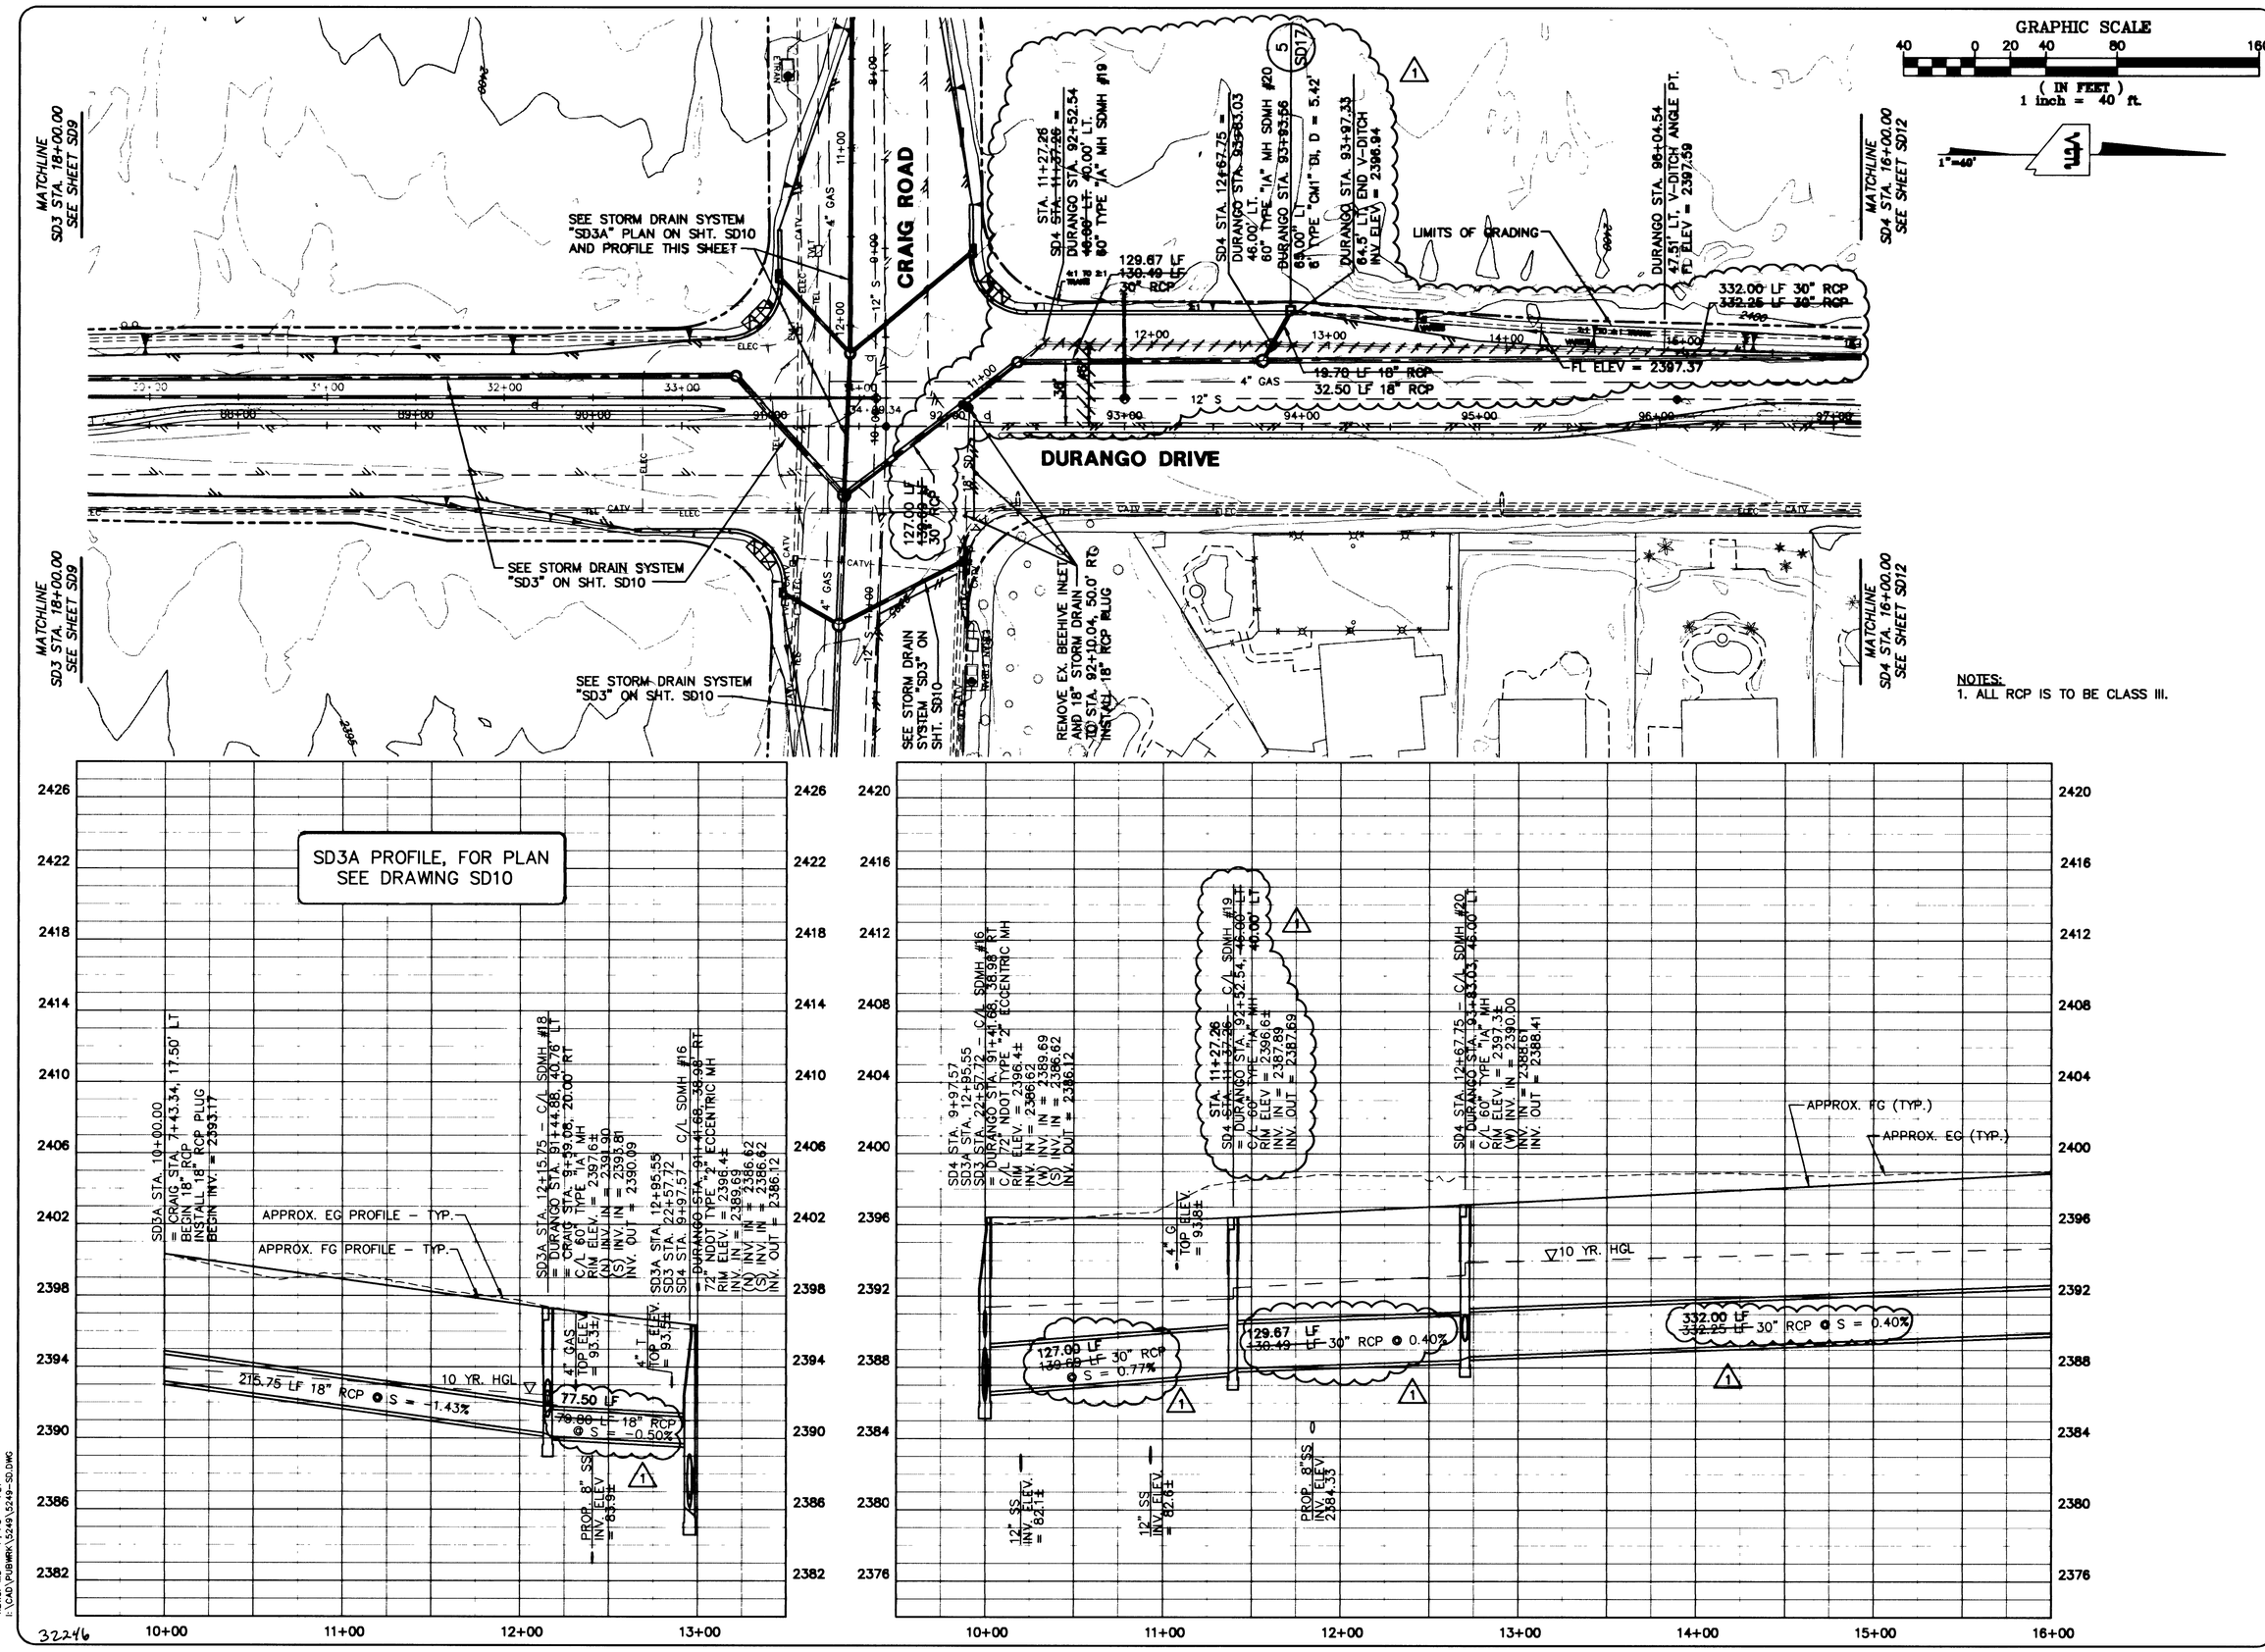

NOTES:
1. ALL RCP IS TO BE CLASS III.

REV	DATE	BY	REVISION
1	02/07/01	MJD	REVISED PER AS-BUILTS

DEPARTMENT OF PUBLIC WORKS
CITY OF LAS VEGAS, NEVADA

vtn nevada
CONSULTING ENGINEERS • PLANNERS • LAND SURVEYORS
2727 SOUTH RAINBOW BOULEVARD
LAS VEGAS, NEVADA 89102-5148 PHONE (702) 873-7550 FAX (702) 362-2597

STORM DRAIN PLAN AND PROFILE SD4 STA. 10+00 TO STA 16+00 DURANGO DRIVE

PROJECT: DURANGO DRIVE IMPROVEMENTS
CHEYENNE AVENUE TO LONE MOUNTAIN ROAD

SEAL

WO. NO.	5249
BY	JL/LMW/DJB
DATE	07/17/98
SCALE HORIZ. VERT.	1"=40' 1"=4'
DRAWING	SD11
SHEET	62 OF 106 SHEETS

VIEWS: MS = "M", PS = "PLT"
I:\CAD\PUBWRK\5249-SD.DWG

RECORD DRAWING 03/23/01