
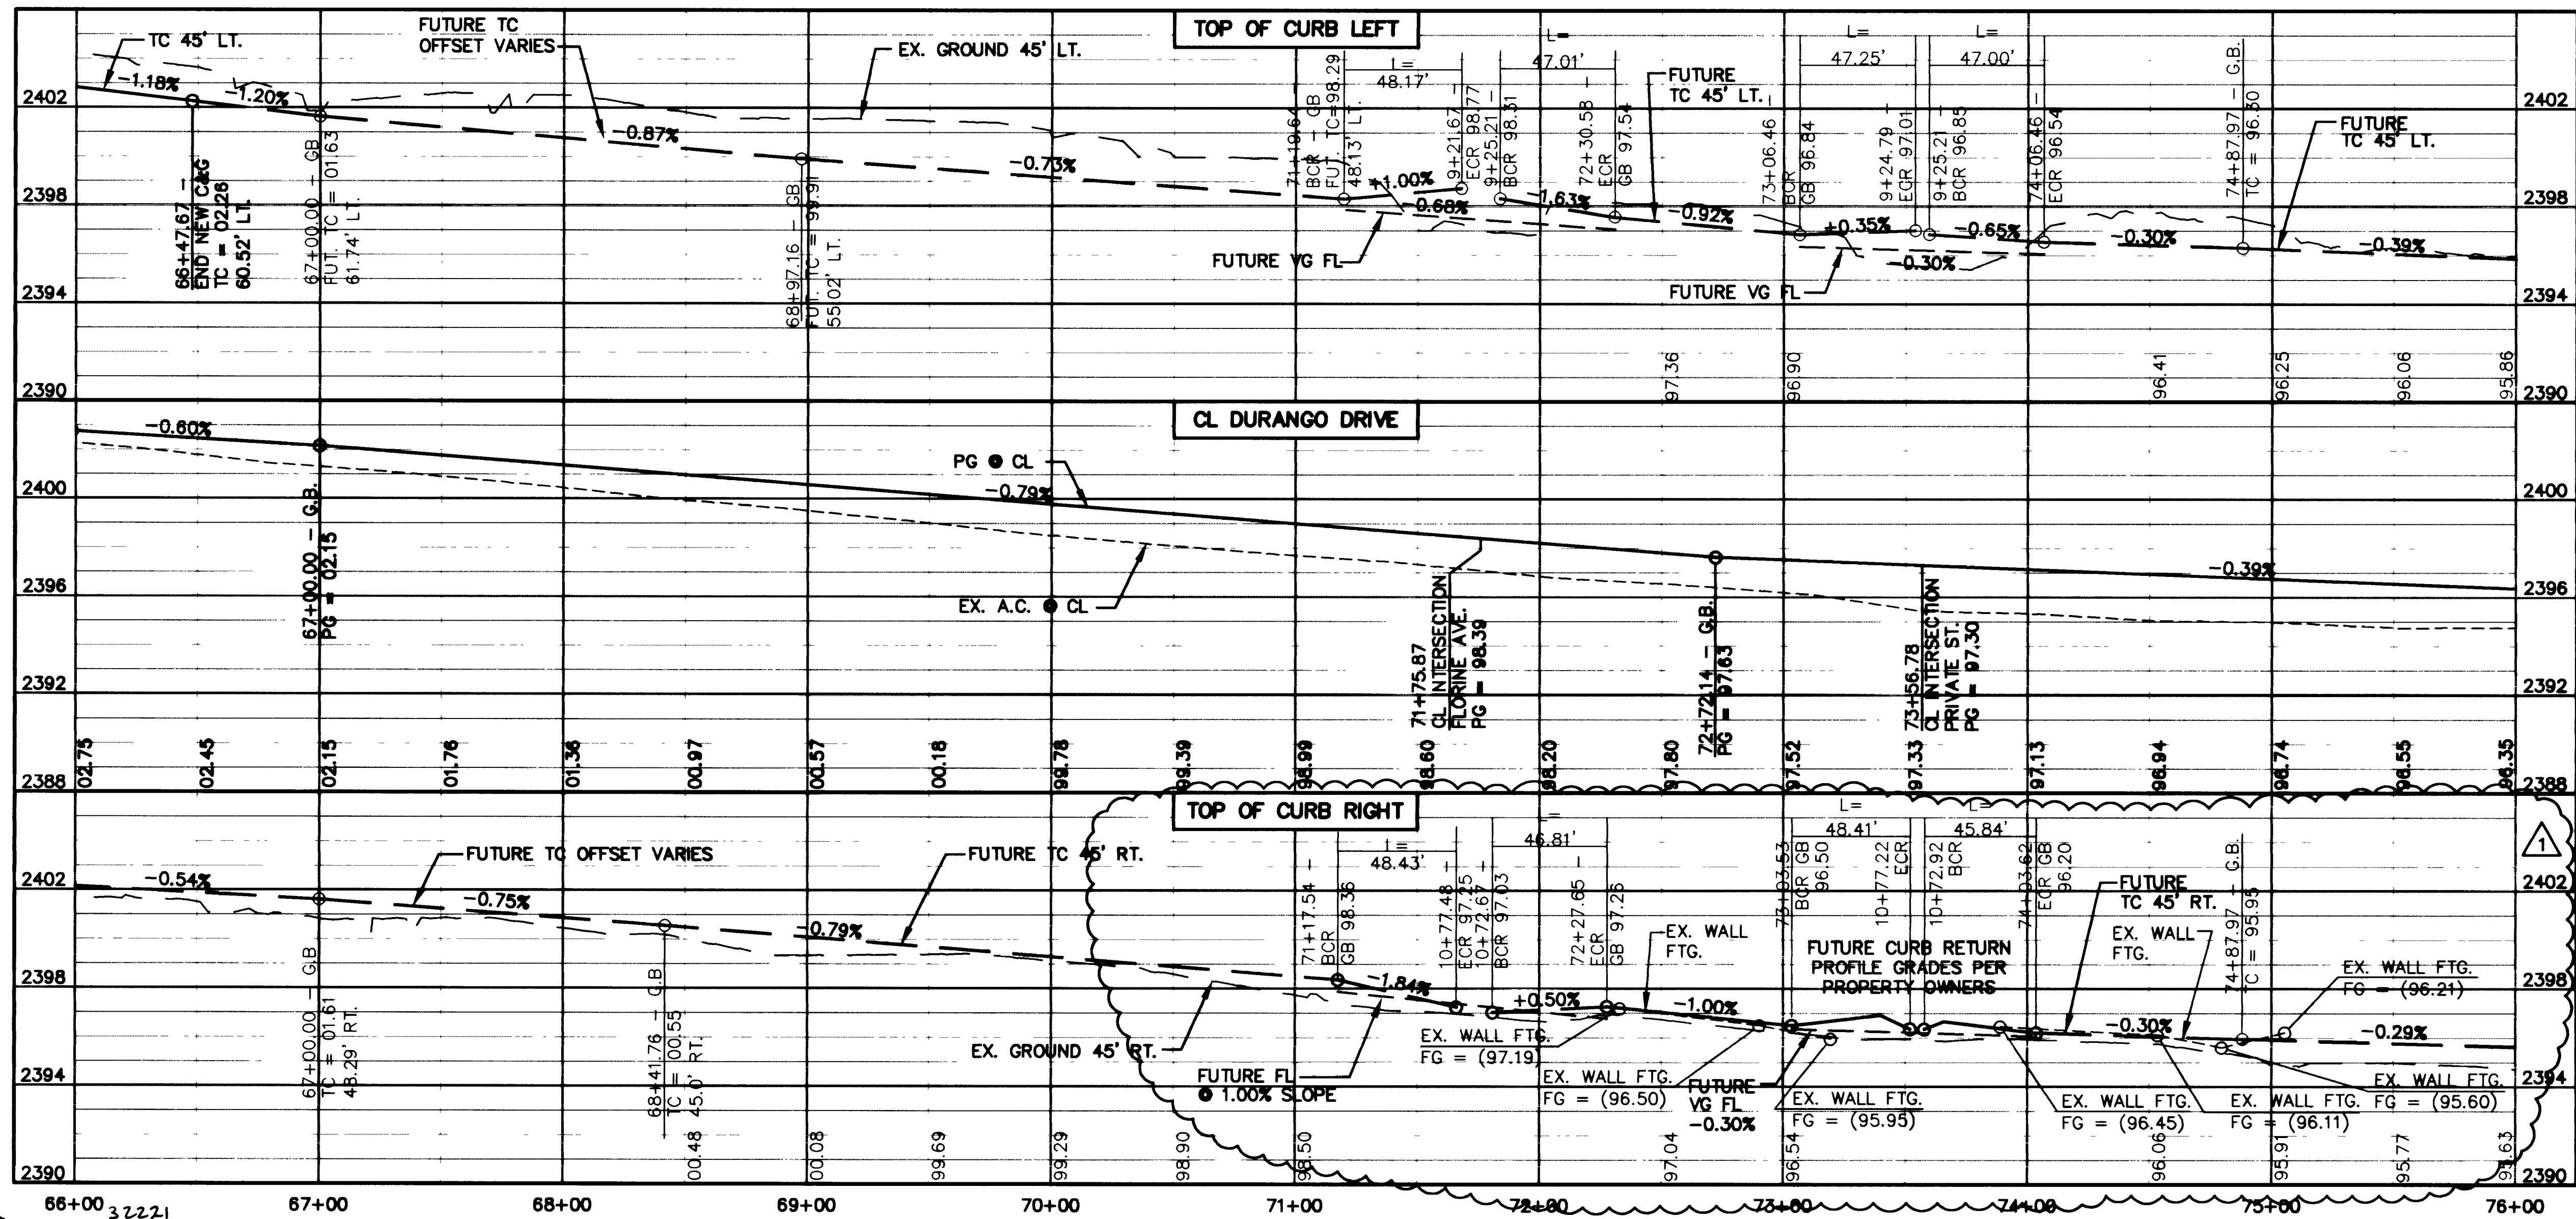
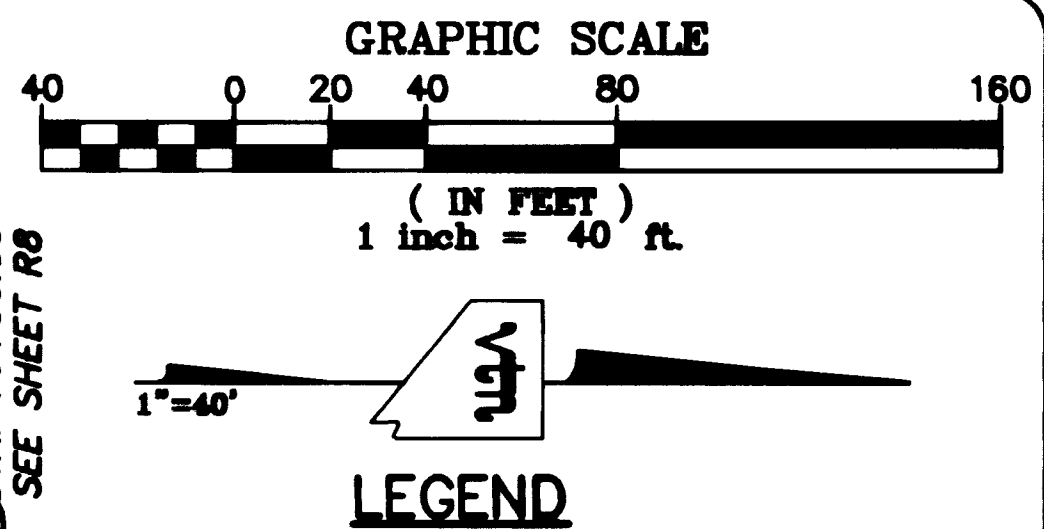


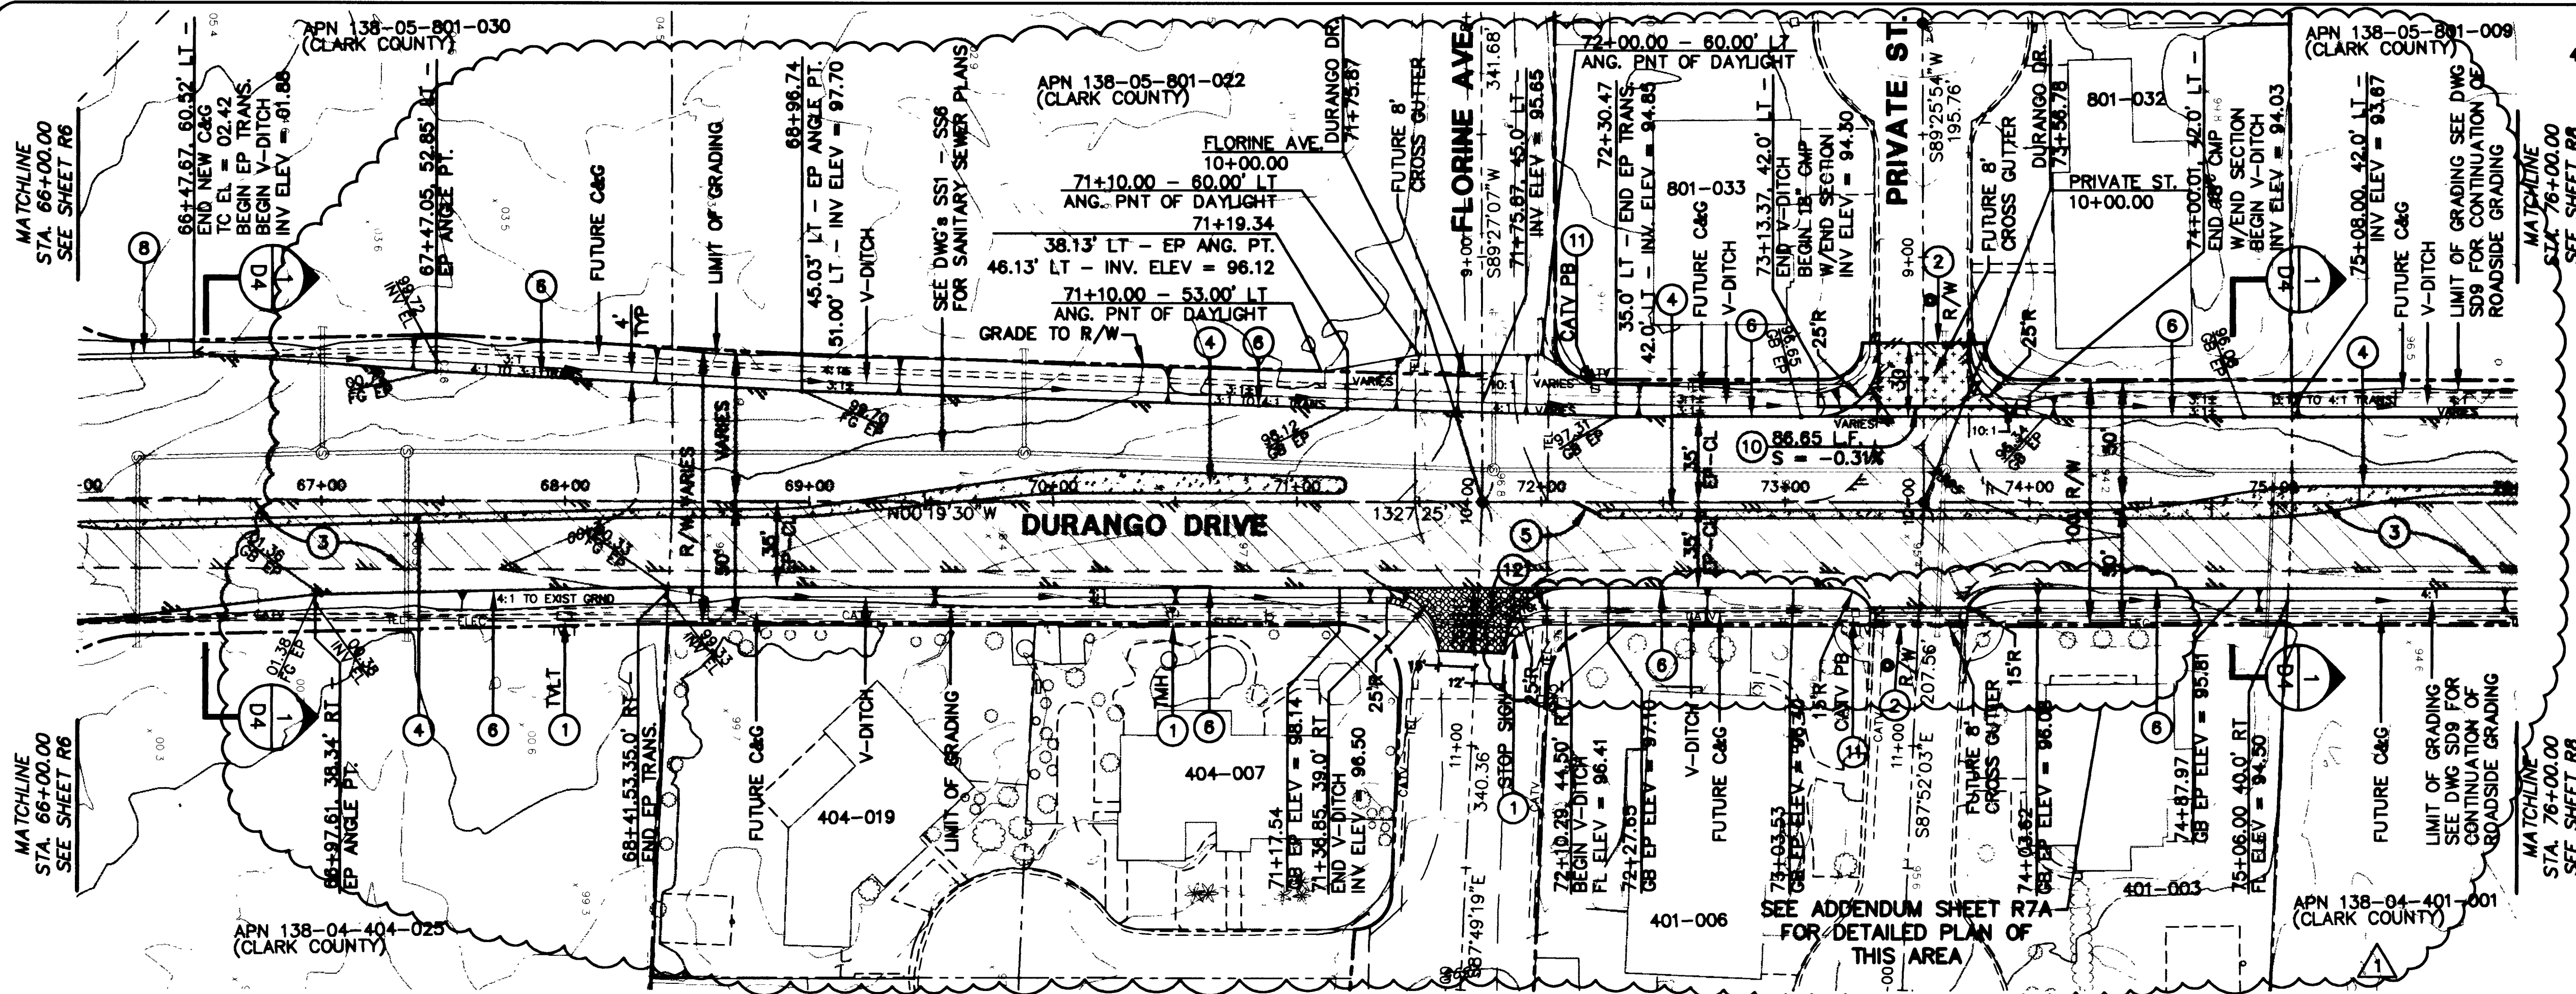

CONSTRUCTION NOTES

- PROTECT IN PLACE
- SAWCUT & MATCH
- REMOVE EXISTING A.C., AGGREGATE BASE AND/OR CONCRETE
- CONSTRUCT MEDIAN ISLAND SEE MEDIAN ISLAND GEOMETRICS AND IRRIGATION PLAN DWG'S R17 - R21
- CONSTRUCT PAVEMENT CROWN TRANSITION SEE MEDIAN ISLAND GEOMETRICS AND IRRIGATION PLAN DWG'S R17 - R21
- EDGE OF NEW A.C. PAVEMENT
- REMOVE A.C. WALKWAY
- CONSTRUCT "L" TYPE CURB AND GUTTER PER USD NO. 216
- CONSTRUCT CURB AND GUTTER AND SIDEWALK RAMP CASE II PER USD NO. 235
- 18" CMP
- ADJUST TO FINISH GRADE
- CONSTRUCT 6" TYPE II AGGREGATE BASE AT 95% COMPACTION
- RELOCATE
- CONSTRUCT MEDIAN ISLAND IRRIGATION FACILITIES FOR FUTURE CONNECTION SEE MEDIAN ISLAND GEOMETRICS AND IRRIGATION PLAN DWG'S R17 - R21
- REESTABLISH SURVEY MONUMENT TO FINISH GRADE PER STANDARD DWGS. AND STANDARD SPECS.
- ESTABLISH SURVEY MONUMENT TO FINISH GRADE PER STANDARD DWGS. AND STANDARD SPECS.
- CONSTRUCT CURB AND GUTTER AND MODIFIED SIDEWALK RAMP CASE II PER DETAIL 6 ON SHT D24
- CONSTRUCT GUARDRAIL SEE DWG SD13

FOR STRIPING, STREET LIGHTS
 AND TRAFFIC SIGNAL PLANS
 SEE DWG'S T1 - T15

TITLE ROADWAY PLAN AND PROFILE
 STA. 66+00.00 TO STA. 76+00.00
 DURANGO DRIVE

PROJECT DURANGO DRIVE IMPROVEMENTS
 CHEYENNE AVENUE TO LONE MOUNTAIN ROAD

DEPARTMENT OF PUBLIC WORKS
 CITY OF LAS VEGAS, NEVADA

CONSULTING ENGINEERS • PLANNERS • LAND SURVEYORS
 2727 SOUTH RAINBOW BOULEVARD
 LAS VEGAS, NEVADA 89102-5148 PHONE (702) 873-7550 FAX (702) 362-2597

NO. NO. 5249
 BY JL/TMM
 DATE 07/17/98
 SCALE HORIZ. 1"=40'
 VERT. 1"=10'
 DRAWING R7
 SHEET 37 OF 108