
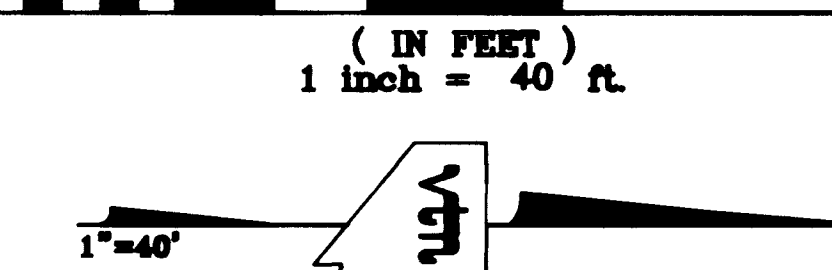


VIEWS: MS = "H", PS = "PLT"
I:\CAD\DWG\15248\15248-000

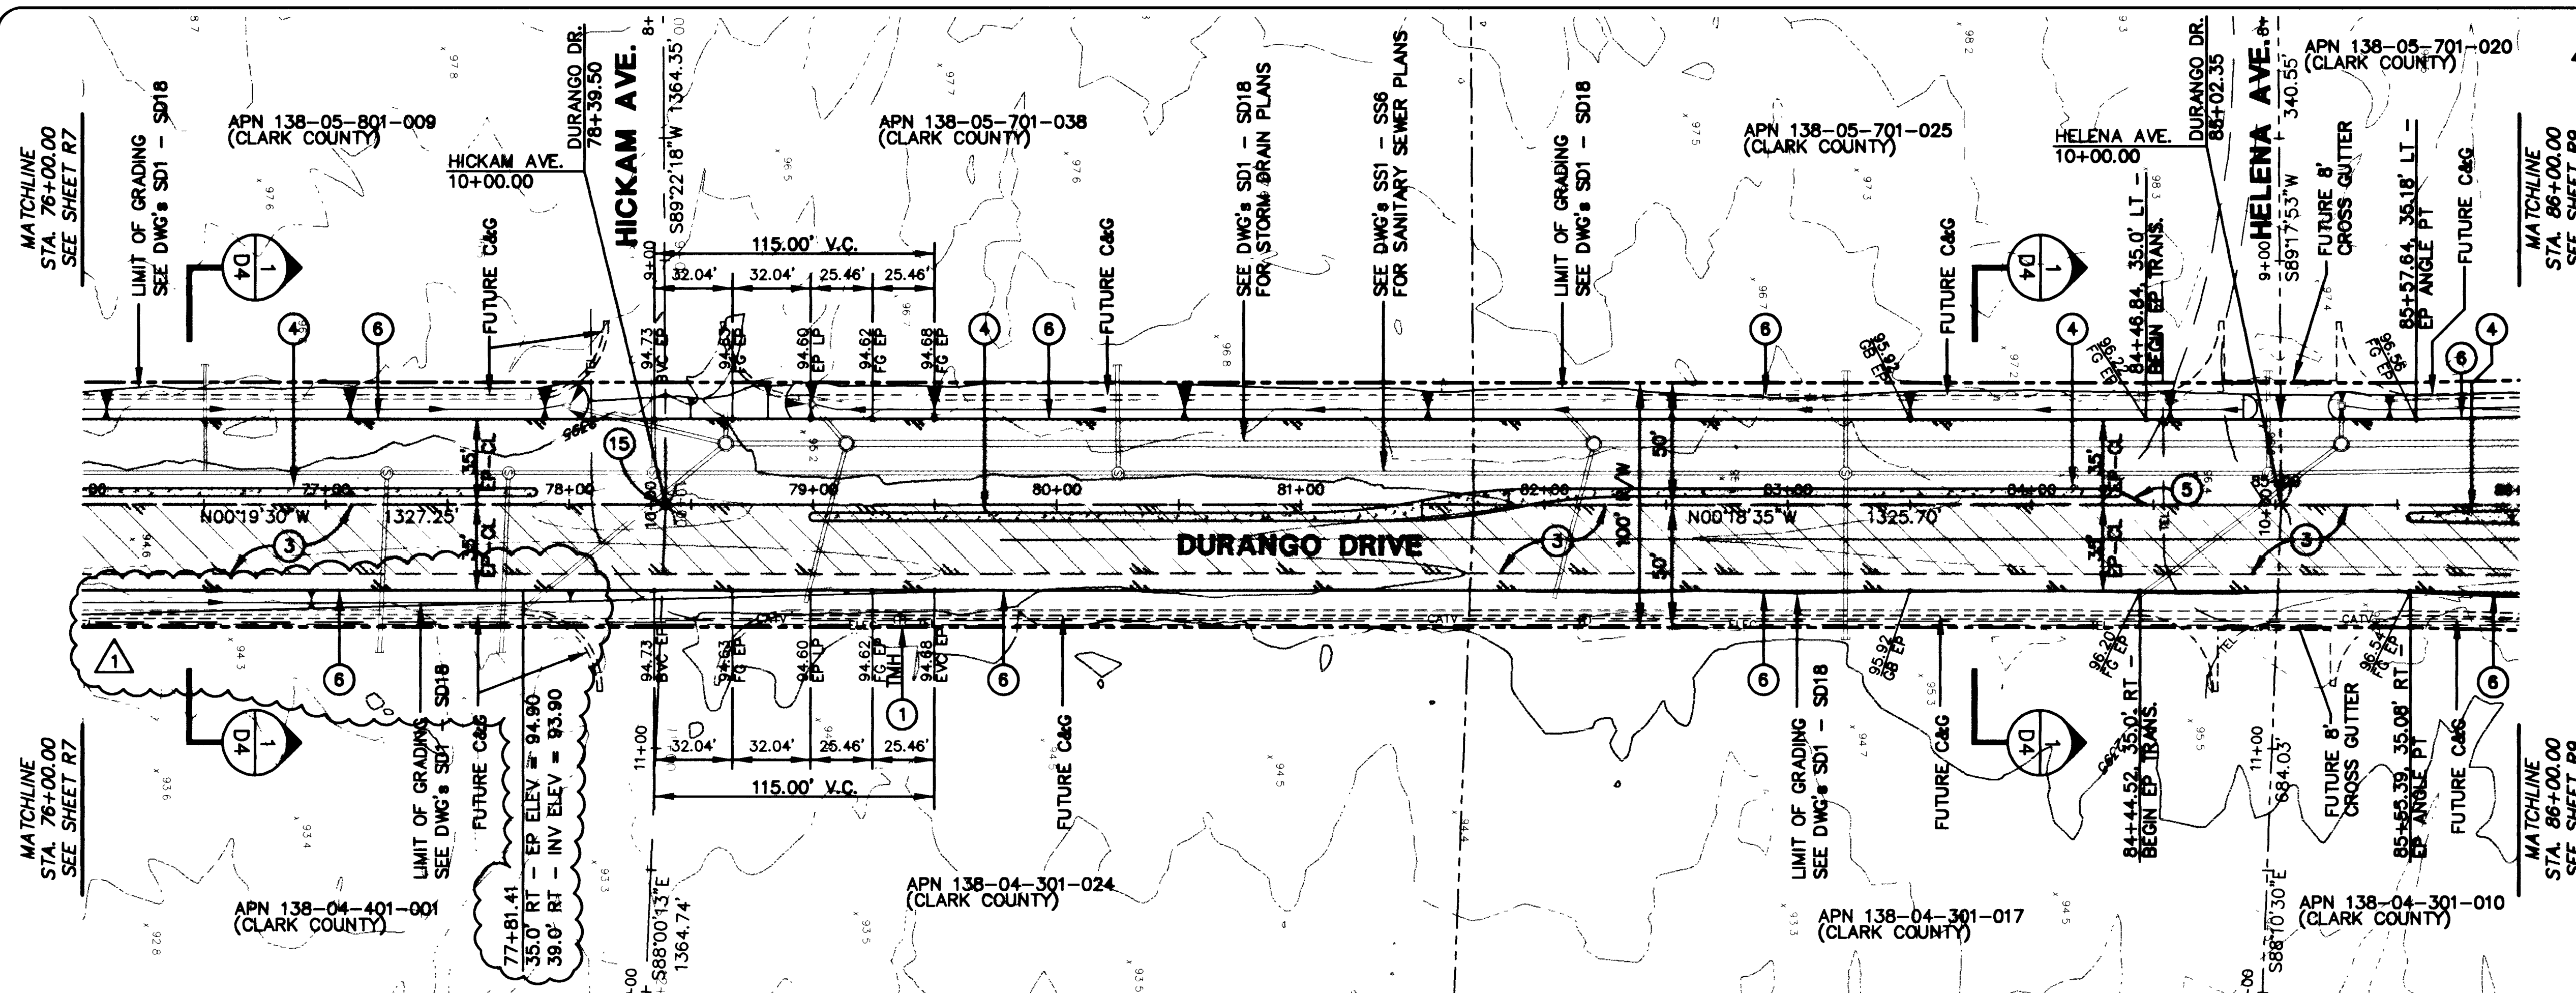

LEGEND

- NEW A.C. PAVEMENT (SEE TYPICAL X-SECTIONS)
- EXISTING A.C. PAVEMENT TO BE REMOVED
- EXISTING A.C. PAVEMENT TO REMAIN WITH NEW A.C. OVERLAY (SEE TYPICAL X-SECTIONS)
- NEW TEMPORARY A.C. (SEE TYPICAL X-SECTIONS)
- NEW CONCRETE MEDIAN

CONSTRUCTION NOTES

- PROTECT IN PLACE
- SAWCUT & MATCH
- REMOVE EXISTING A.C., AGGREGATE BASE AND/OR CONCRETE
- CONSTRUCT MEDIAN ISLAND SEE MEDIAN ISLAND GEOMETRICS AND IRRIGATION PLAN DWG'S R17 - R21
- CONSTRUCT PAVEMENT CROWN TRANSITION SEE MEDIAN ISLAND GEOMETRICS AND IRRIGATION PLAN DWG'S R17 - R21
- EDGE OF NEW A.C. PAVEMENT
- REMOVE A.C. WALKWAY
- CONSTRUCT "L" TYPE CURB AND GUTTER PER USD NO. 216
- CONSTRUCT CURB AND GUTTER AND SIDEWALK RAMP CASE II PER USD NO. 235
- 18" CMP
- ADJUST TO FINISH GRADE
- CONSTRUCT 6" TYPE II AGGREGATE BASE AT 95% COMPACTION
- RELOCATE
- CONSTRUCT MEDIAN ISLAND IRRIGATION FACILITIES FOR FUTURE CONNECTION SEE MEDIAN ISLAND GEOMETRICS AND IRRIGATION PLAN DWG'S R17 - R21
- REESTABLISH SURVEY MONUMENT TO FINISH GRADE PER STANDARD DWGS. AND STANDARD SPECS.
- ESTABLISH SURVEY MONUMENT TO FINISH GRADE PER STANDARD DWGS. AND STANDARD SPECS.
- CONSTRUCT CURB AND GUTTER AND MODIFIED SIDEWALK RAMP CASE II PER DETAIL 6 ON SHT D24
- CONSTRUCT GUARDRAIL SEE DWG SD13

FOR STRIPING, STREET LIGHTS
AND TRAFFIC SIGNAL PLANS
SEE DWG'S T1 - T15

TITLE ROADWAY PLAN AND PROFILE
STA. 76+00.00 TO STA. 86+00.00
DURANGO DRIVE
PROJECT DURANGO DRIVE IMPROVEMENTS
CHEYENNE AVENUE TO LONE MOUNTAIN ROAD

NO. NO.	5249
BY	JL/TMM
DATE	07/17/98
SCALE	HORIZ. 1"=40' VERT. 1"=4'
DRAWING	R8
SHEET	38
OF	106
SHEETS	

DEPARTMENT OF PUBLIC WORKS	CITY OF LAS VEGAS, NEVADA
CONSULTING ENGINEERS • PLANNERS • LAND SURVEYORS	2727 SOUTH RAINBOW BOULEVARD LAS VEGAS, NEVADA 89102-5148 PHONE (702) 873-7550 FAX (702) 362-2597