



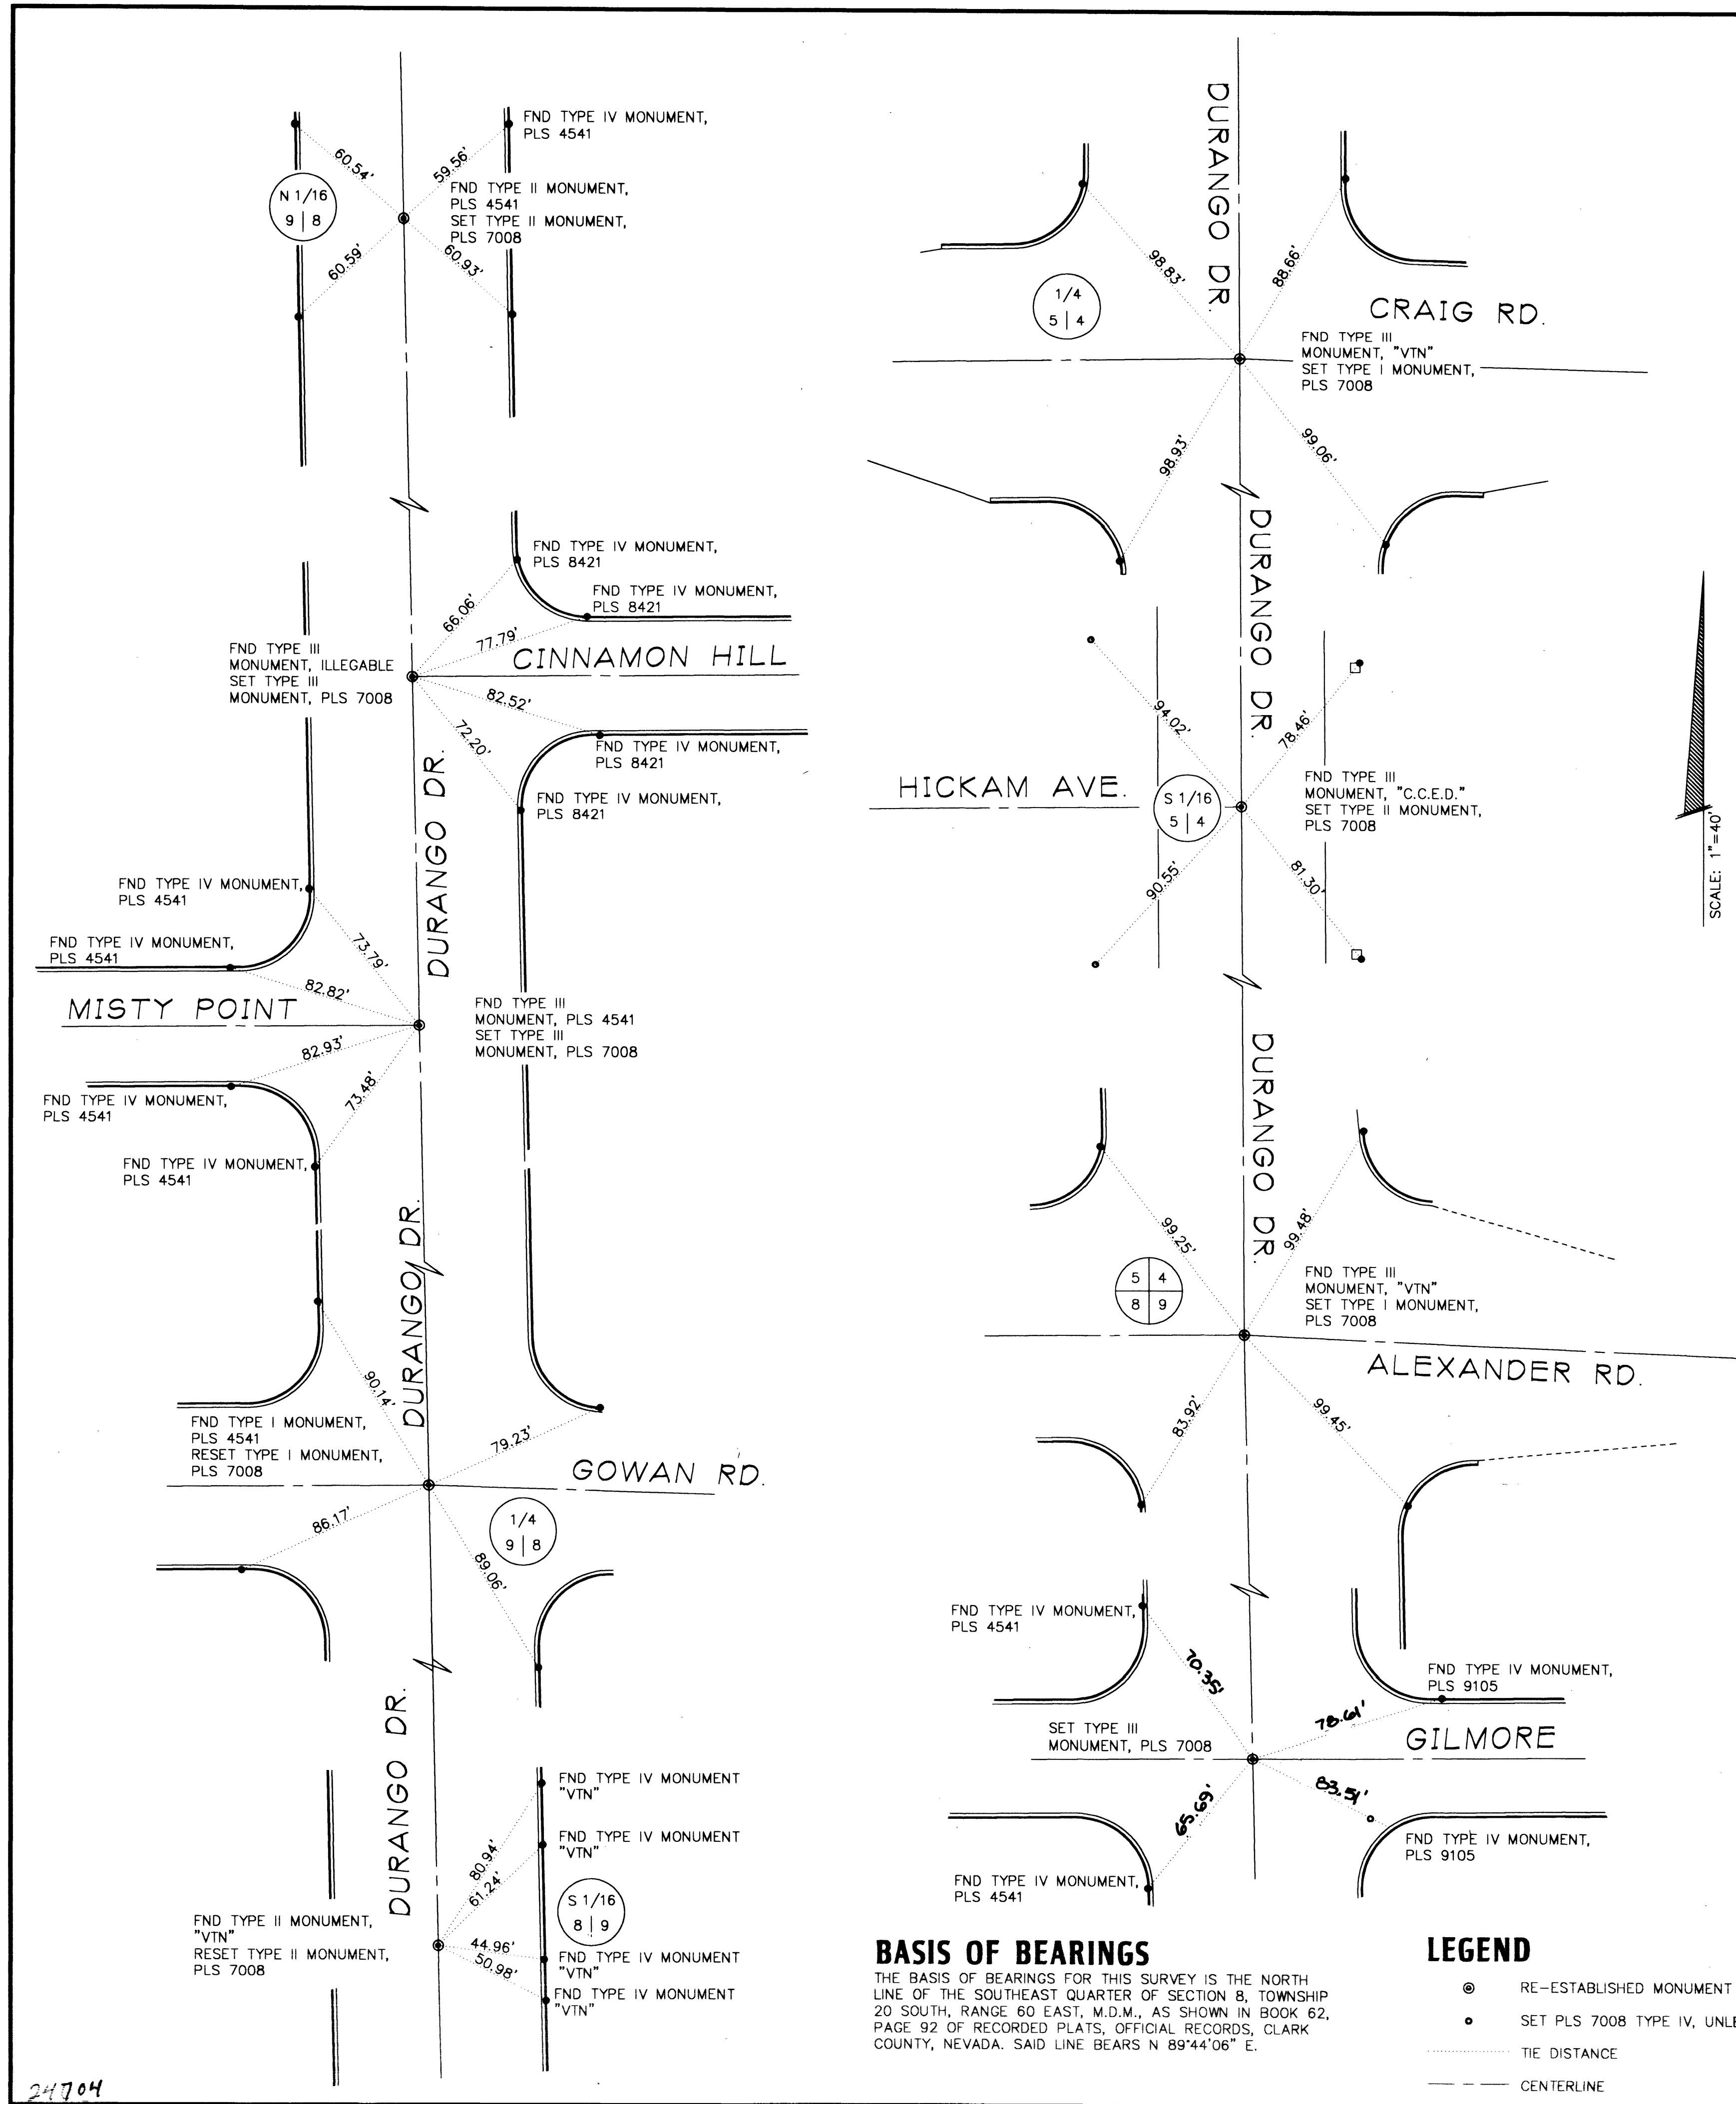


SURVEYOR'S CERTIFICATE

- I, GERALD L. WIRTHLIN, A PROFESSIONAL LAND SURVEYOR REGISTERED IN THE STATE OF NEVADA, CERTIFY THAT:
1. THE MONUMENTS HAVE BEEN SET AND THE TIE DISTANCES ESTABLISHED AS SHOWN HEREON.
 2. THE LANDS SURVEYED LIE WITHIN THE EAST 1/2 OF SECTIONS 5 and 8, TOWNSHIP 19 SOUTH, RANGE 60 EAST, and THE WEST 1/2 OF SECTIONS 4 and 8, TOWNSHIP 19 SOUTH, RANGE 60 EAST.
 3. THE MONUMENTS DEPICTED ON THE PLAT ARE OF THE CHARACTER SHOWN, and OCCUPY THE POSITIONS INDICATED.
 4. THIS SURVEY WAS COMPLETED ON 2/09/2000.

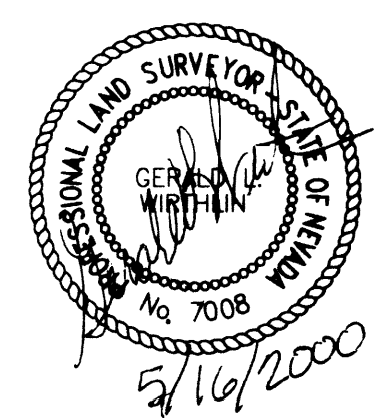

GERALD L. WIRTHLIN
PROFESSIONAL LAND SURVEYOR
NEVADA CERTIFICATE No. 7008

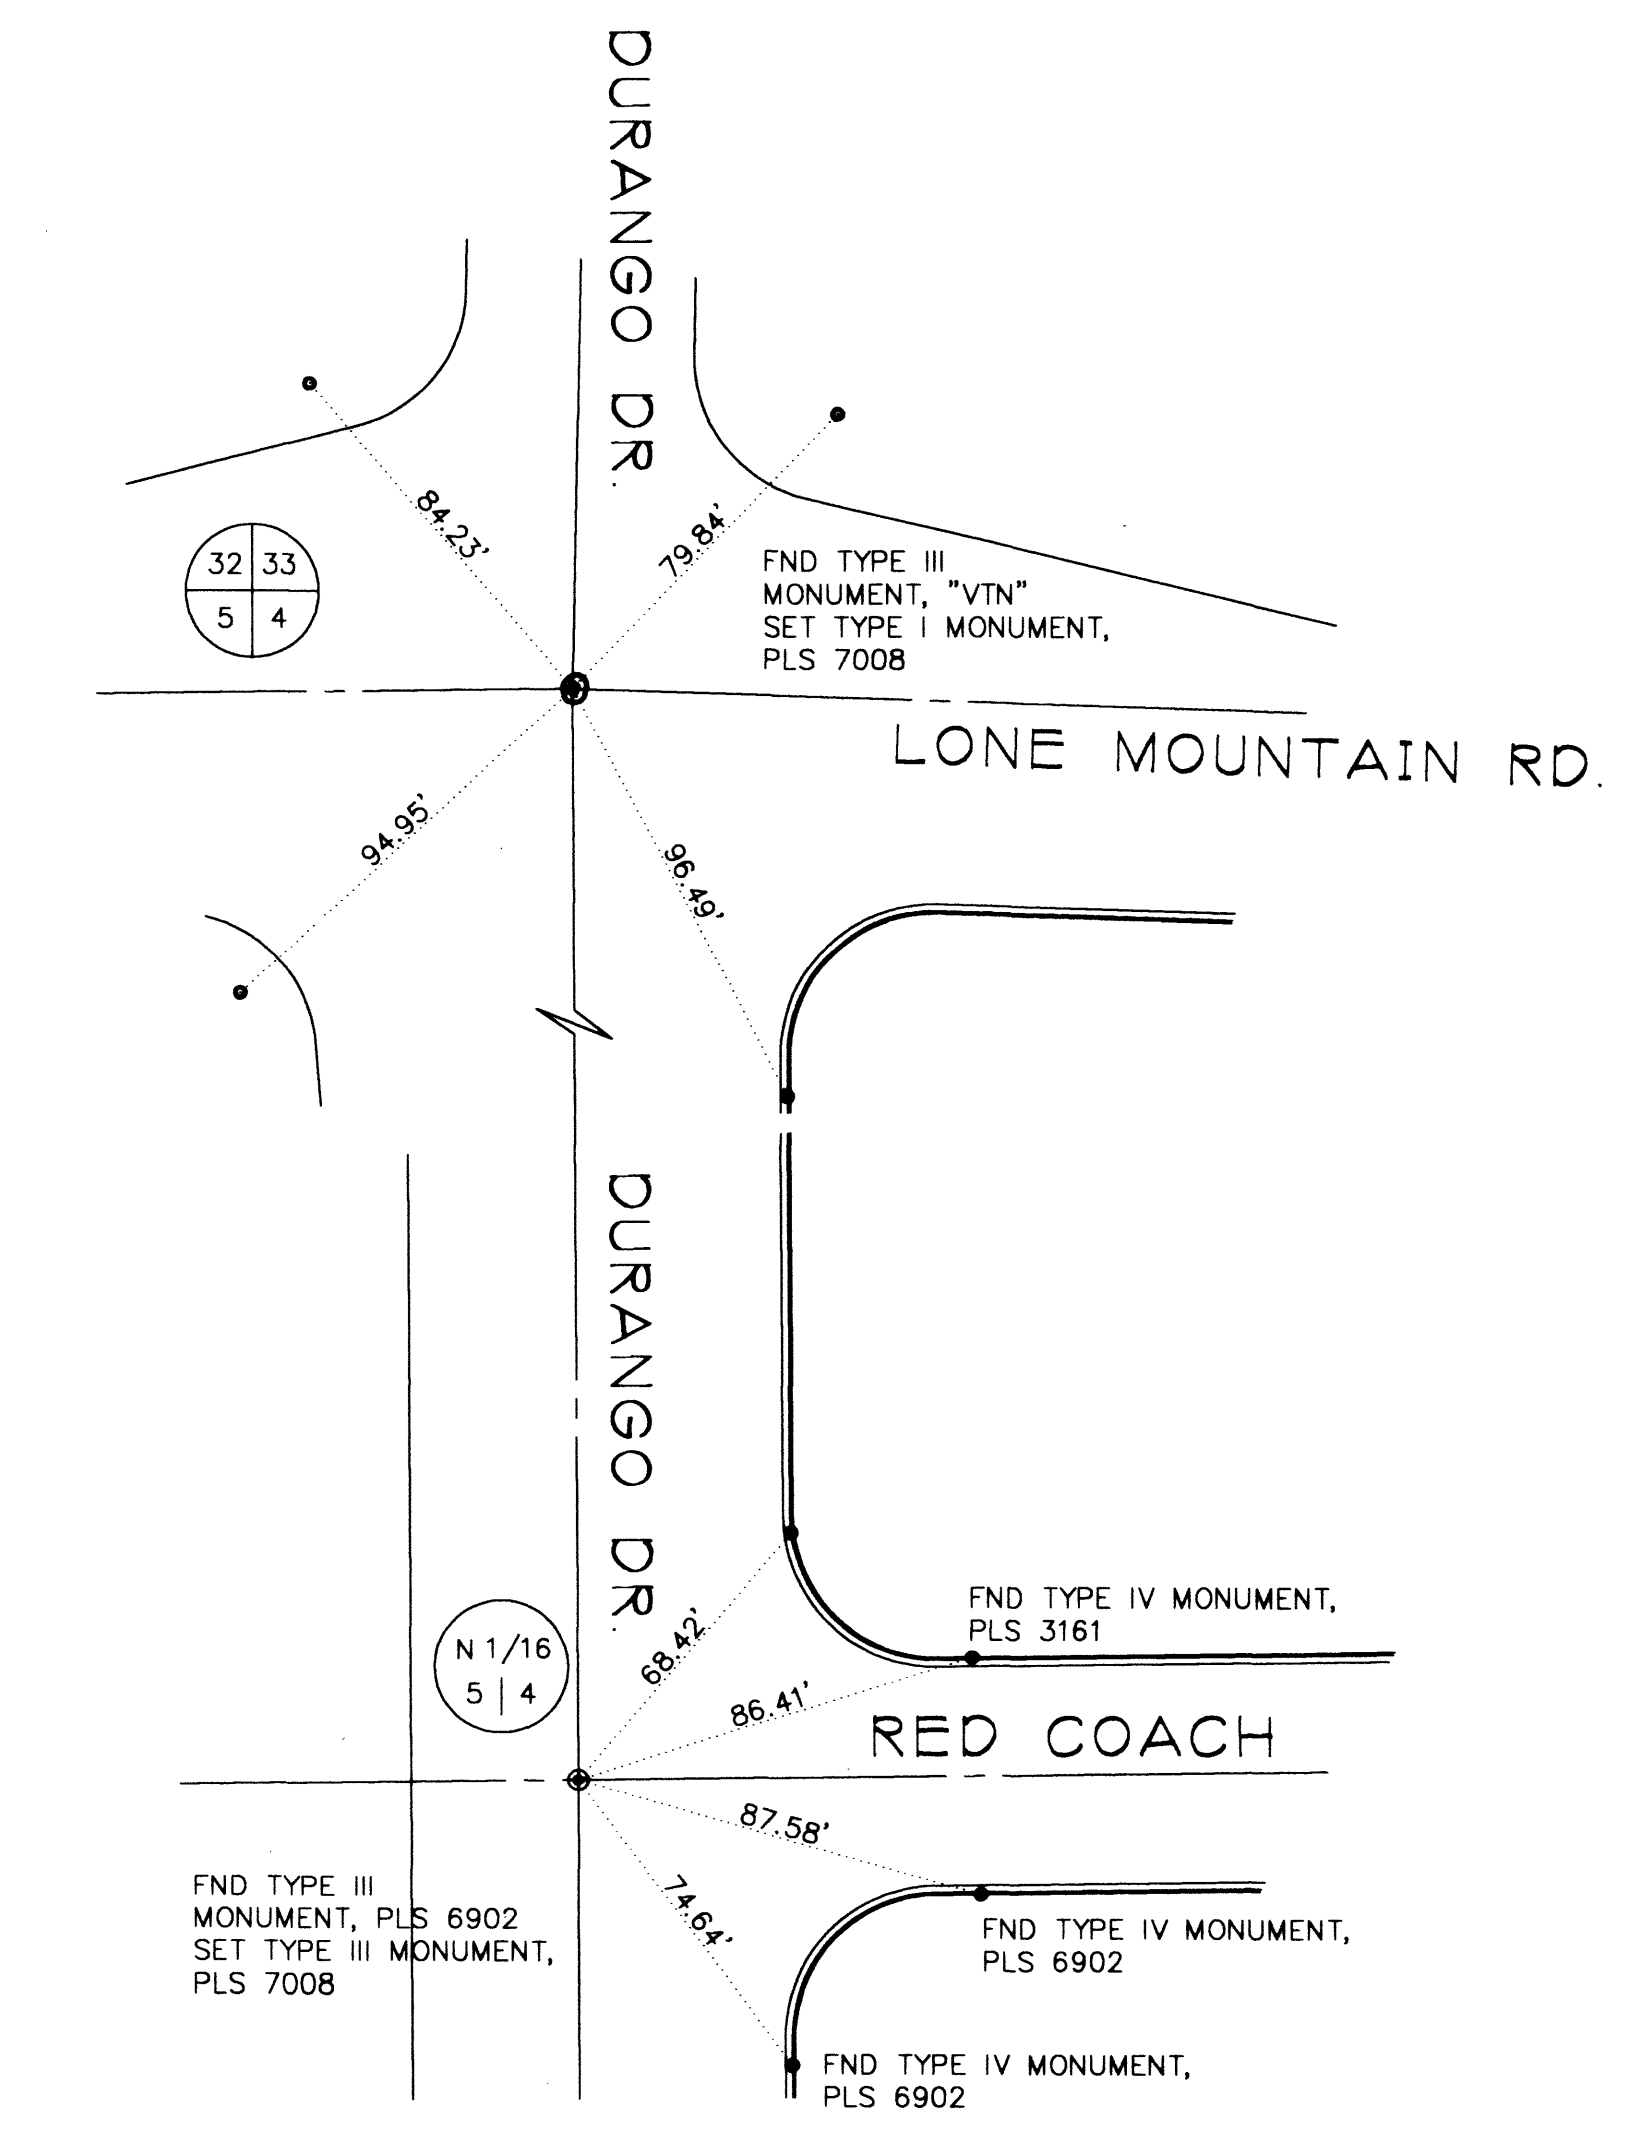

RECORDER'S NOTE

ANY SUBSEQUENT CHANGES TO THIS MAP SHOULD BE EXAMINED AND MAY BE DETERMINED BY REFERENCE TO THE COUNTY RECORDER'S CUMULATIVE MAP INDEX. N.R.S. 278.5695

RECORD OF SURVEY FOR A MONUMENTATION SURVEY OF DURANGO DRIVE, FROM CHEYENNE AVE. TO LONE MOUNTAIN RD. BEING A PORTION OF 1/2 OF SECTIONS 4 and 9, and A PORTION OF THE EAST 1/2 OF SECTIONS 5 and 8 OF TOWNSHIP 19 SOUTH, RANGE 60 EAST, M.D.M. CLARK COUNTY, NEVADA		No. 01075 FILED AT THE REQUEST OF: LAS VEGAS PAVING CORP. DATE: 7/11/2000 AT 2:10 P.M. FILE: 110 PAGE: 17 OF SURVEYS OFFICIAL RECORDS BOOK No. 20000711 CLARK COUNTY, NEVADA RECORDS JUDITH A. VANDEVER, RECORDER FEE: 17.00 DEPUTY: [Signature]
LAS VEGAS PAVING CORP. 251-5000 OFFICE 779-9362 MOBILE GERALD "CROCKETT" WIRTHLIN PLS #7008		

BASIS OF BEARINGS

THE BASIS OF BEARINGS FOR THIS SURVEY IS THE NORTH LINE OF THE SOUTHEAST QUARTER OF SECTION 8, TOWNSHIP 20 SOUTH, RANGE 60 EAST, M.D.M., AS SHOWN IN BOOK 62, PAGE 92 OF RECORDED PLATS, OFFICIAL RECORDS, CLARK COUNTY, NEVADA. SAID LINE BEARS N 89°44'08" E.

LEGEND

- RE-ESTABLISHED MONUMENT AS DESCRIBED
- SET PLS 7008 TYPE IV, UNLESS OTHERWISE NOTED
- TIE DISTANCE
- CENTERLINE

Ties for 107-V2884