




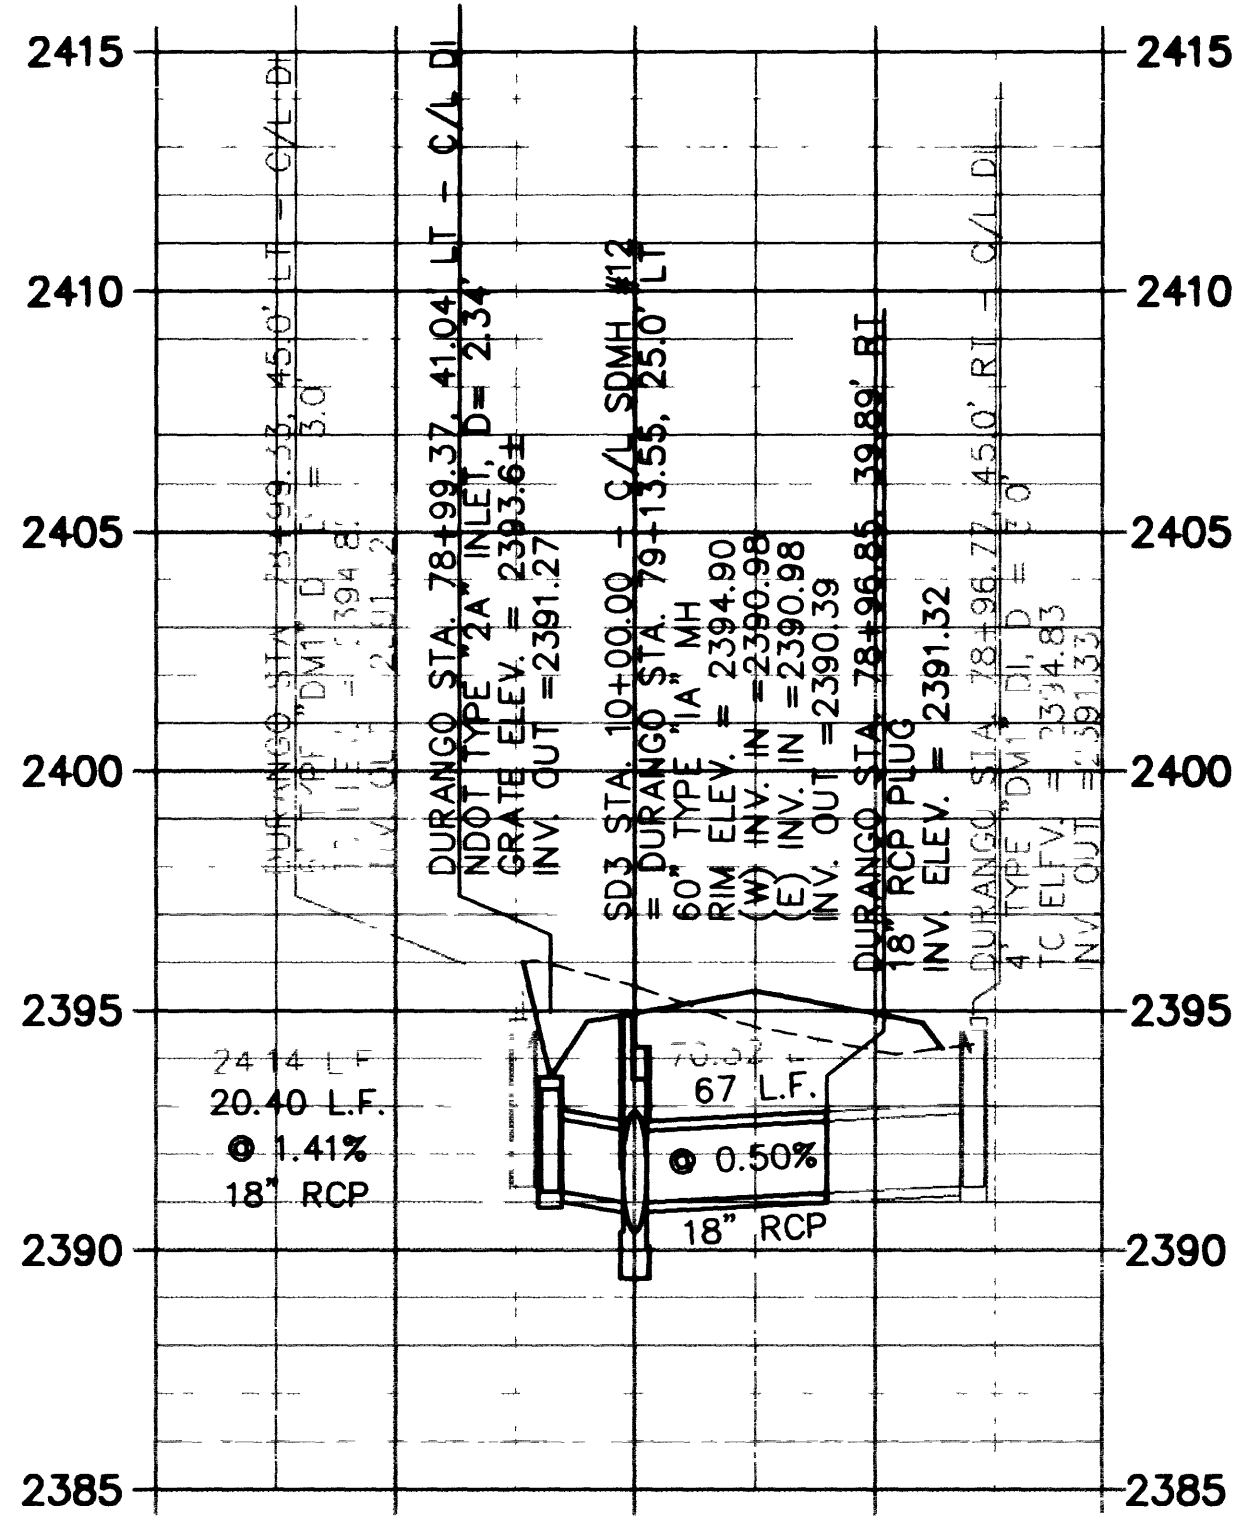


1
 STA. 79+13.55

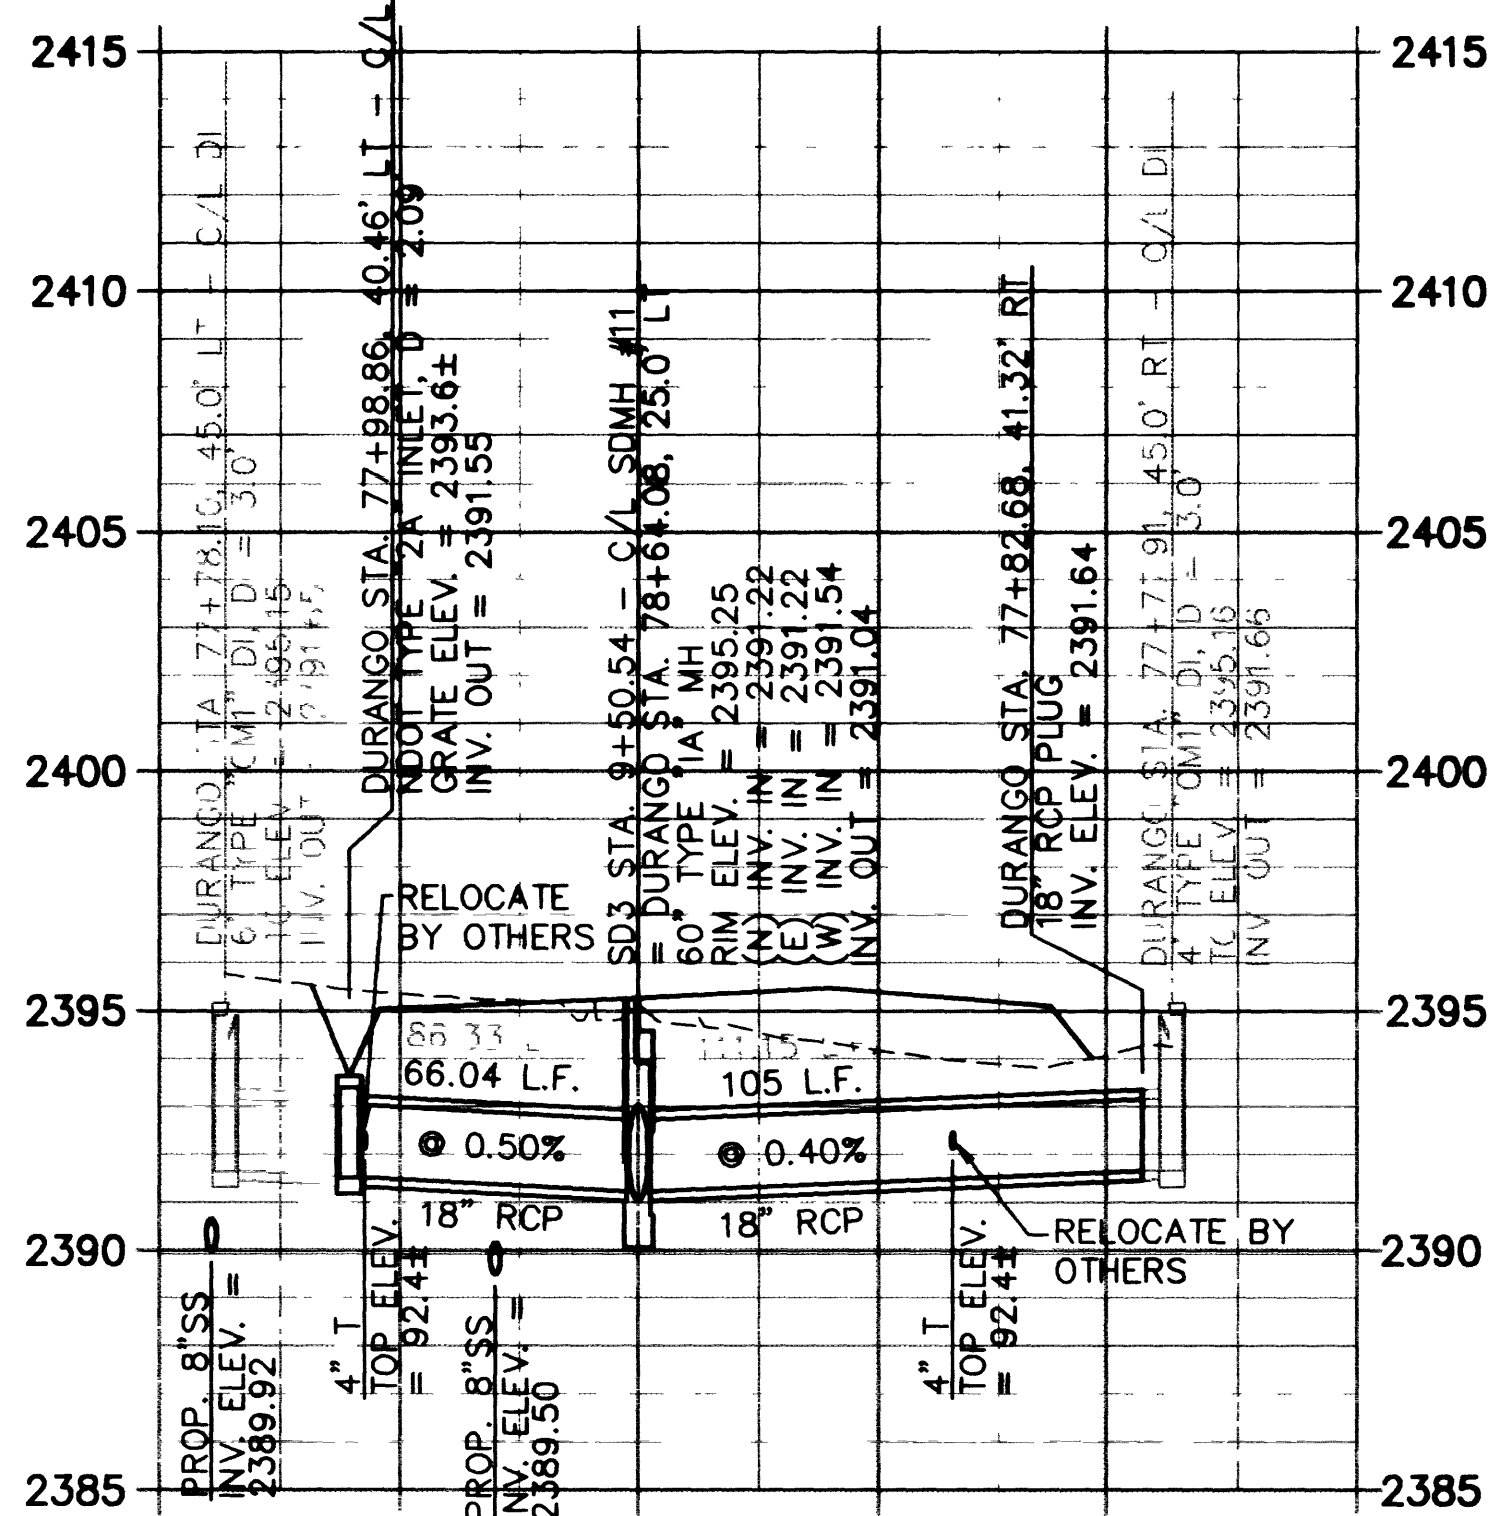


2
 STA. 78+64.08

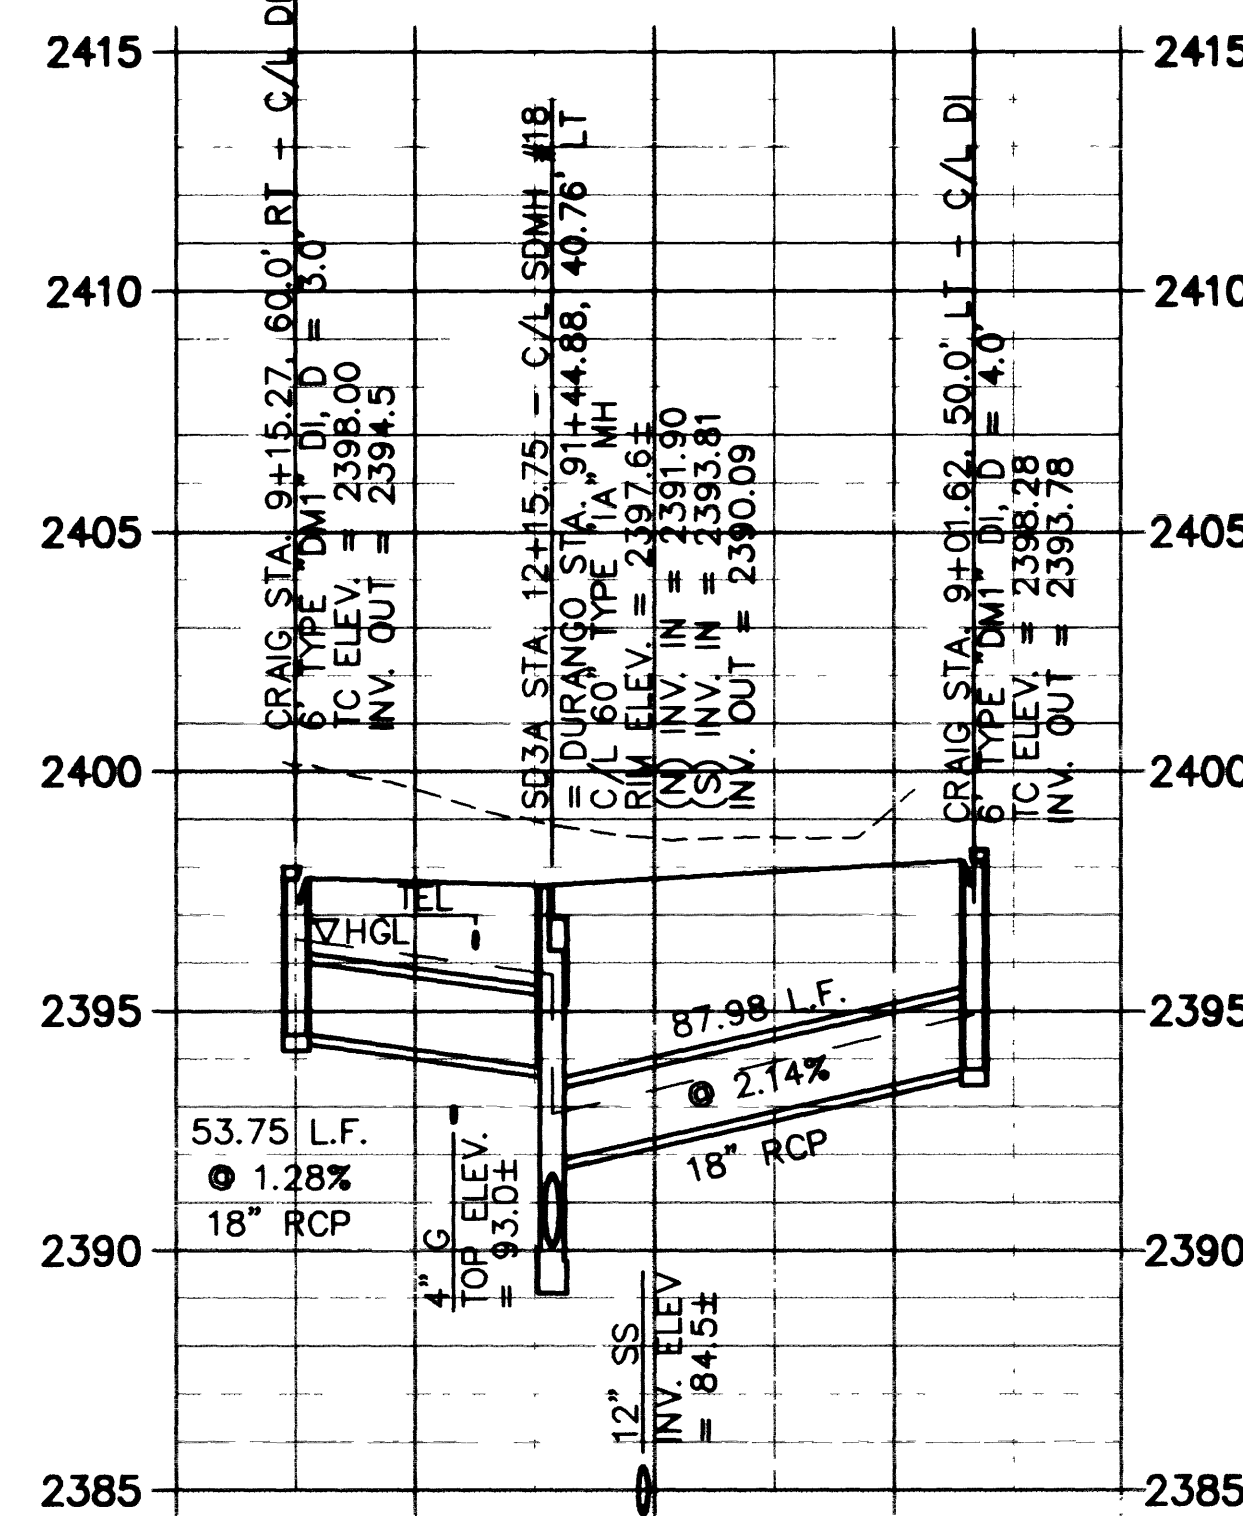


3
 STA. 91+44.88

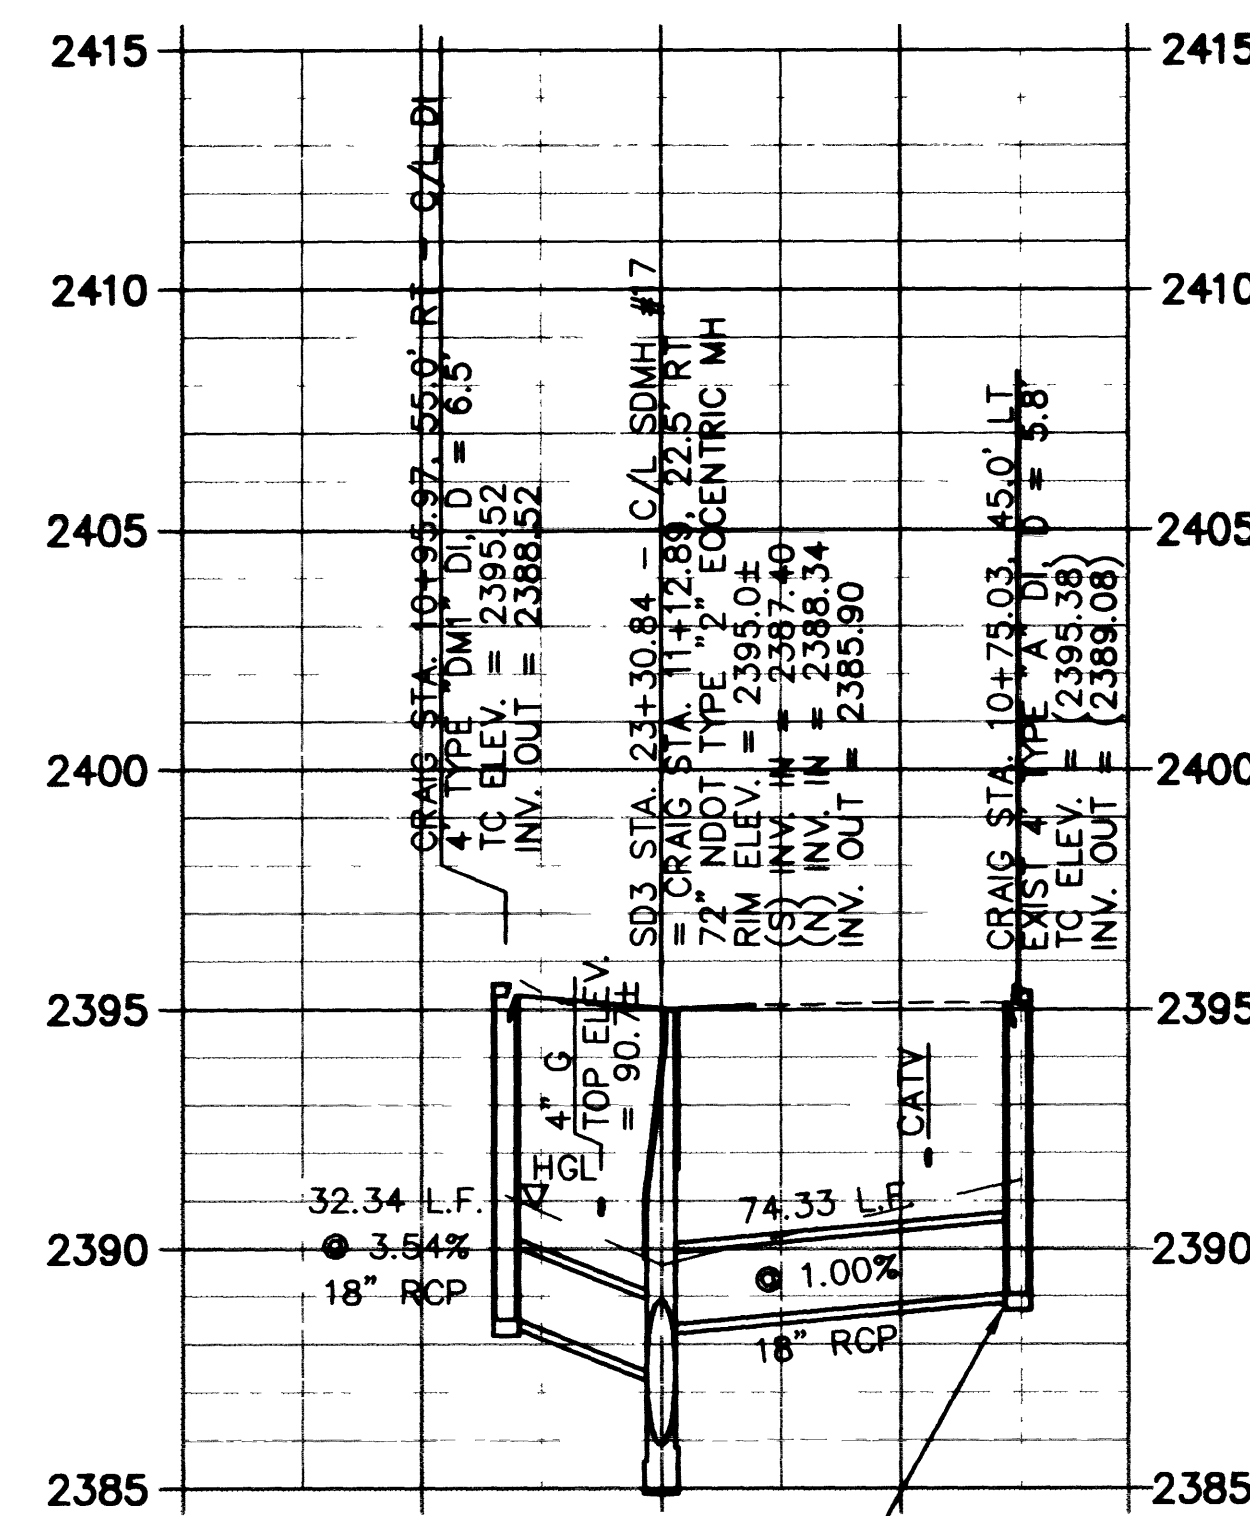


4
 CRAIG STA. 11+12.89

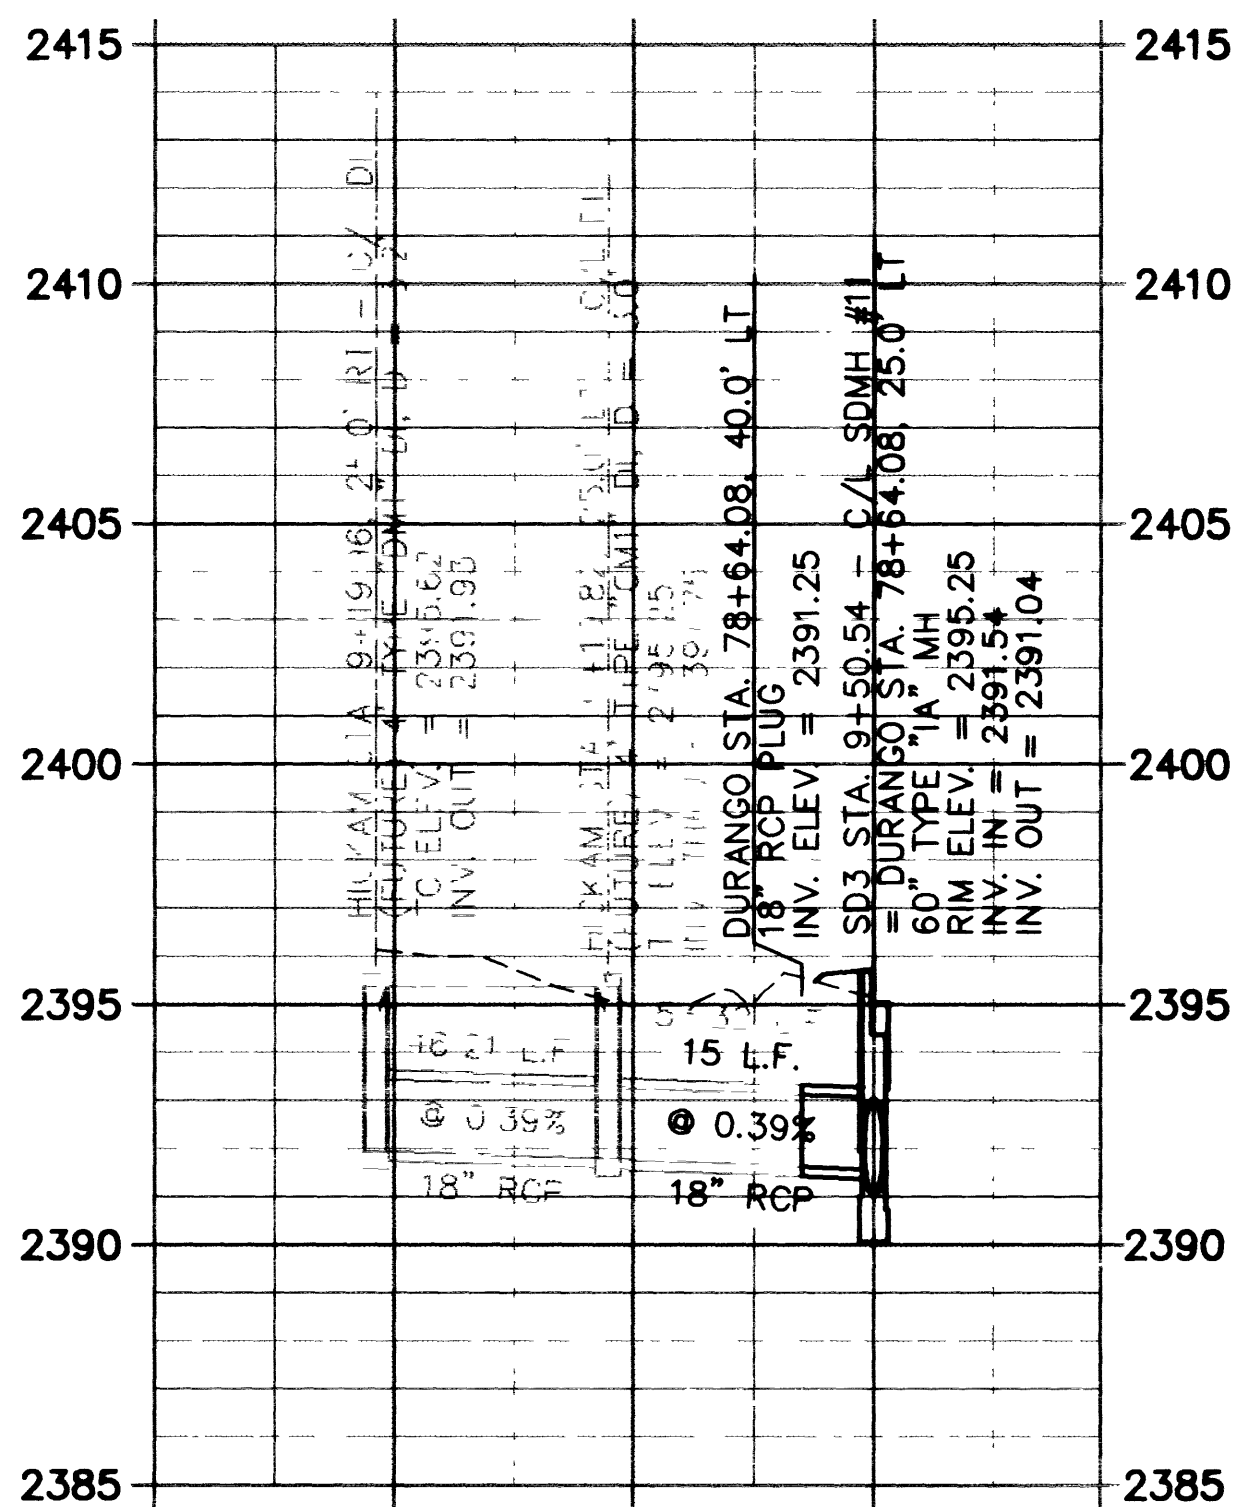

5
 STA. 78+64.08

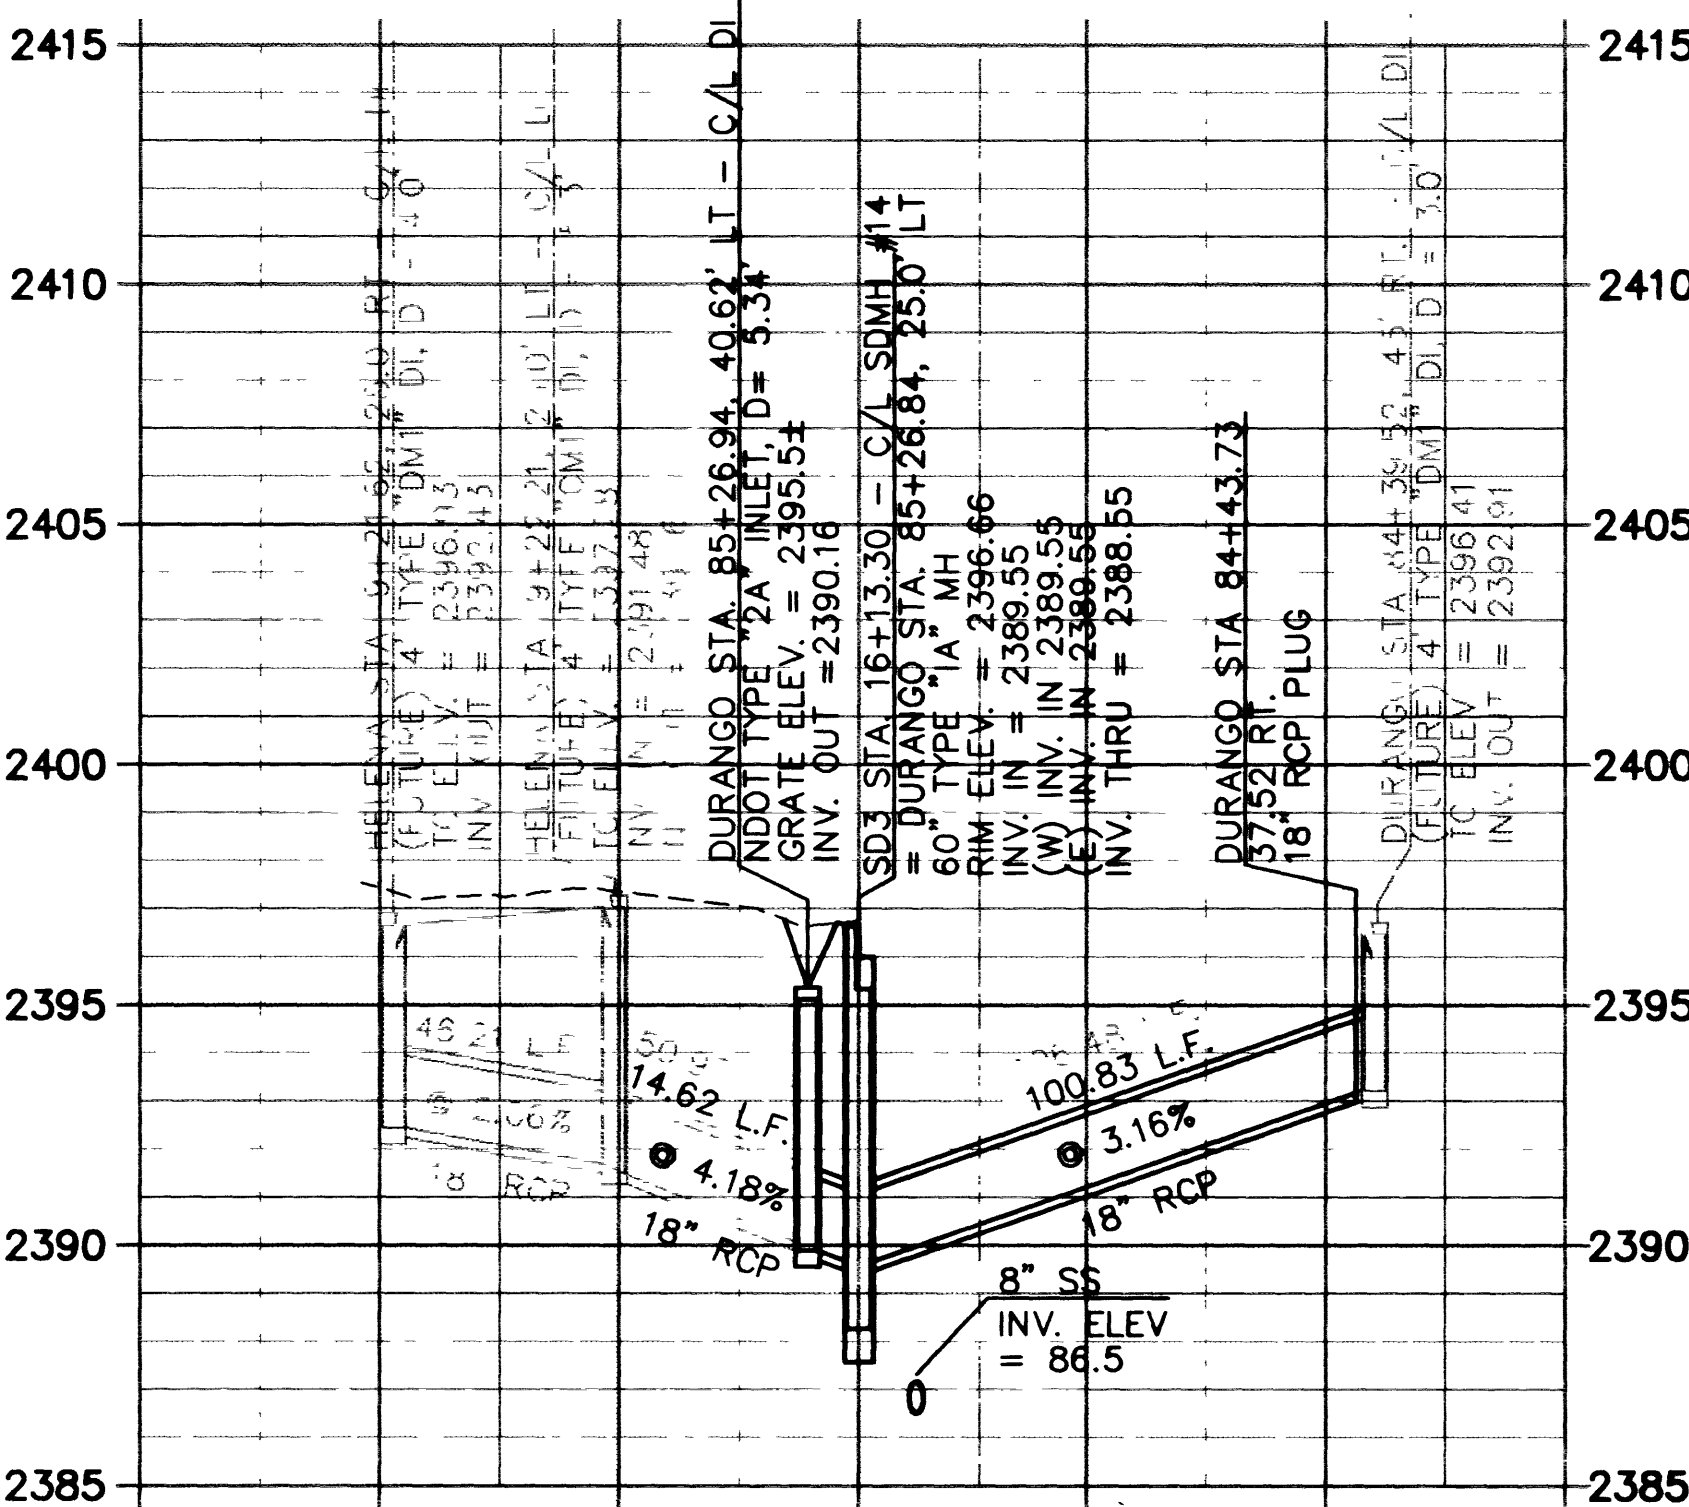


6
 STA. 85+26.84

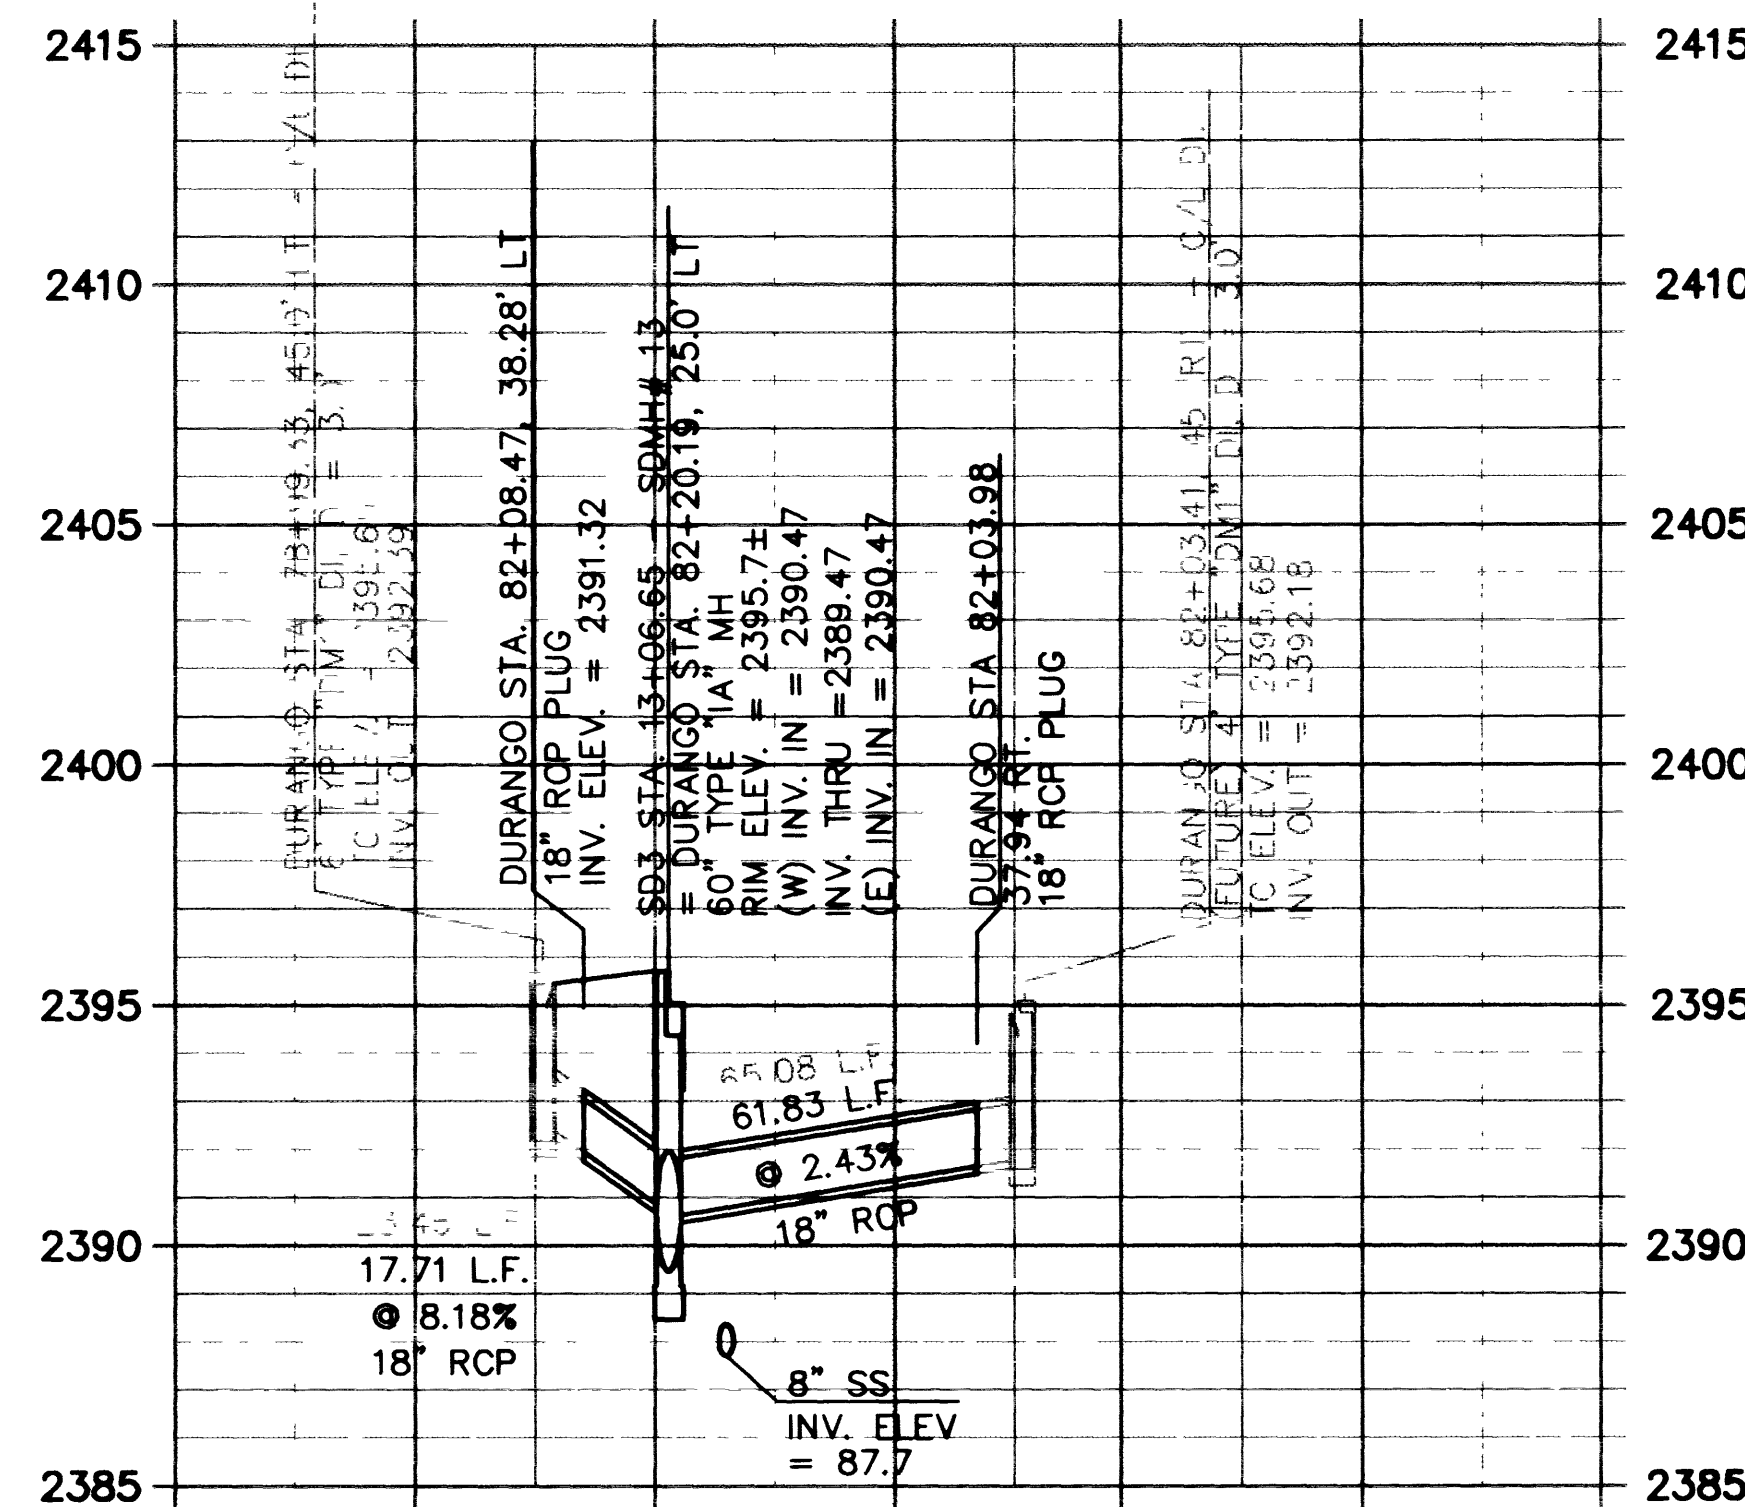

7
 STA. 82+06.09


- NOTES:
 1. FOR STORM DRAIN SEE SHT. SD9 AND SD10.
 2. ALL RCP IS TO BE CLASS III.

THE STORM DRAIN LATERAL DETAILS
 SD3 STA 9+50.54 TO TEMP DRAIN
 DURANGO DRIVE
 CHEYENNE AVENUE TO LONE MOUNTAIN ROAD

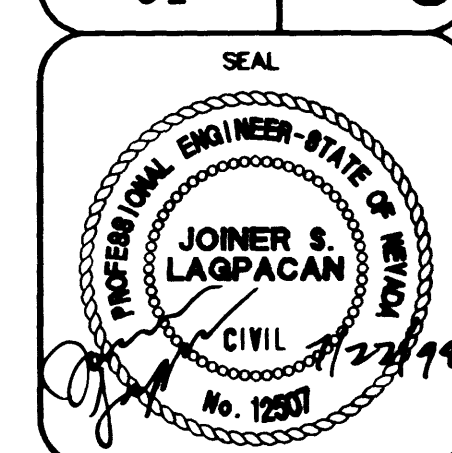

NO. NO.	5249
BY	JL/LMW
DATE	07/17/98
SCALE	HORIZ. 1"=40' VERT. 1"=4'
DRAWING	SHEET 67 OF 106

DEPARTMENT OF PUBLIC WORKS
 CITY OF LAS VEGAS, NEVADA

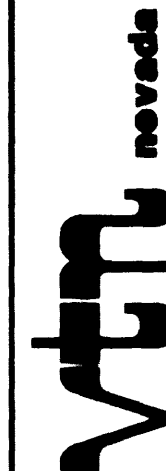

CONSULTING ENGINEERS • PLANNERS • LAND SURVEYORS
 2727 SOUTH RAINBOW BOULEVARD
 LAS VEGAS, NEVADA 89102-5148 PHONE (702) 873-7550 FAX (702) 362-2597