


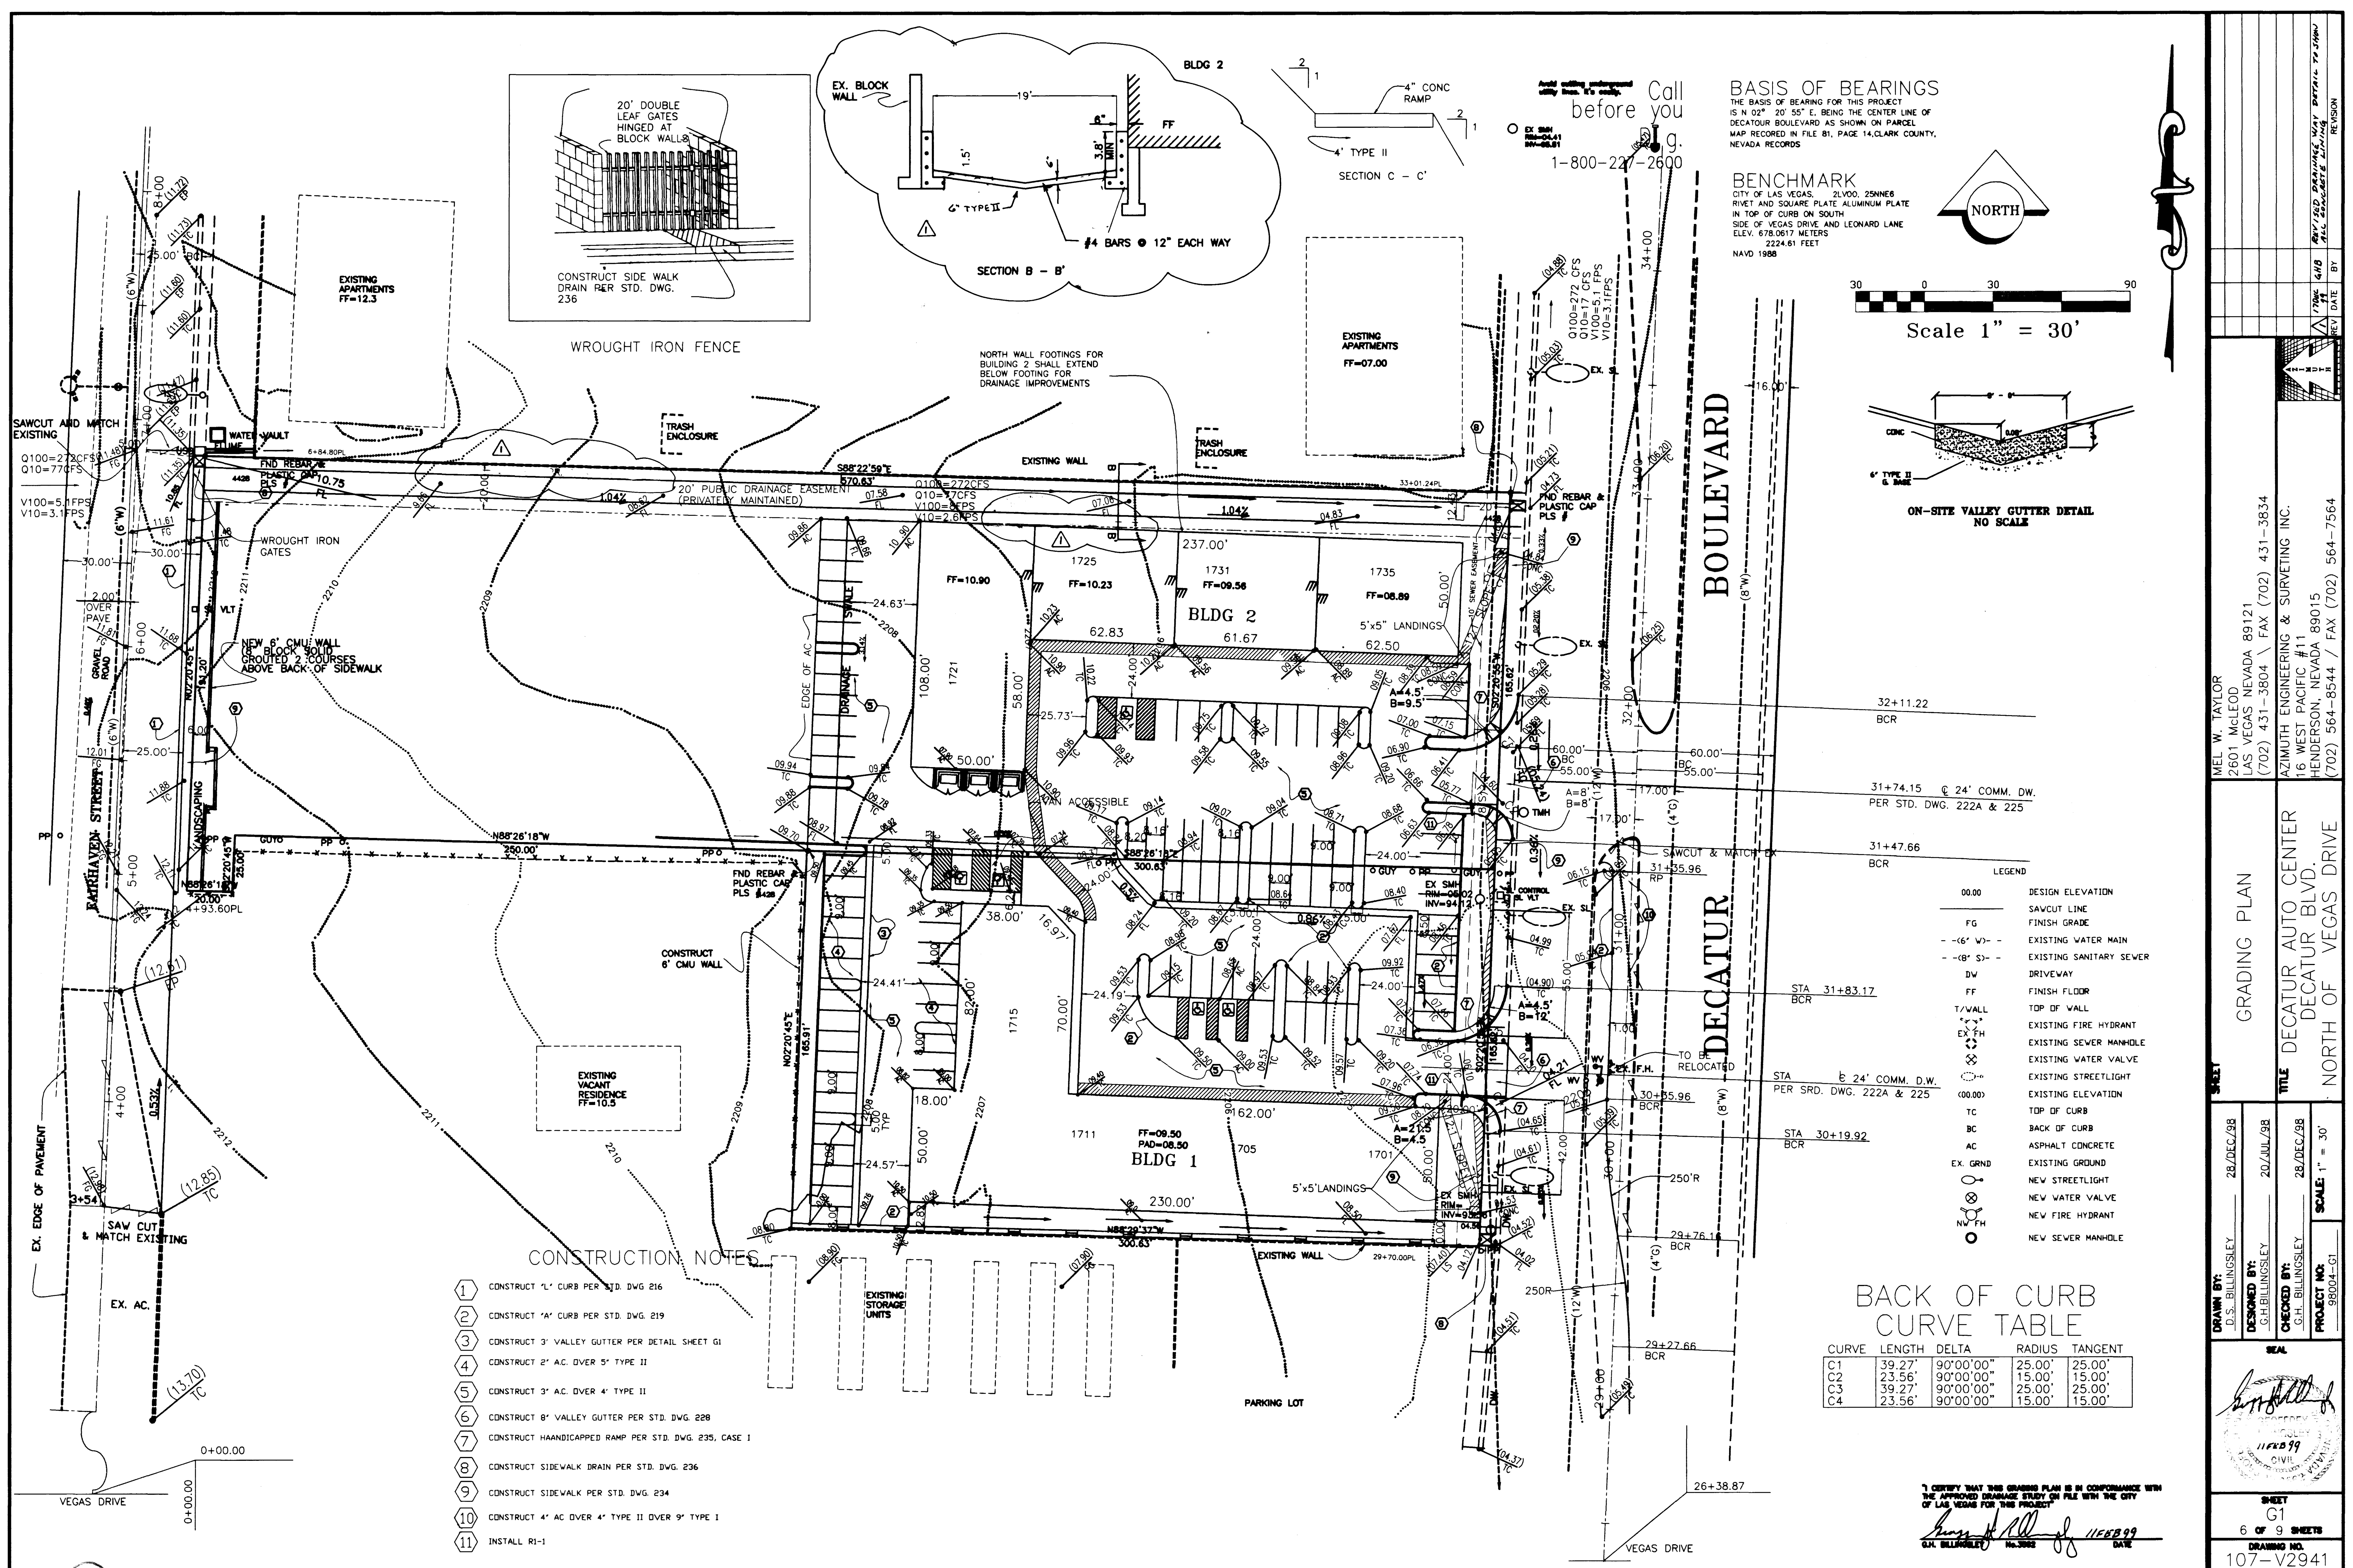

- CONSTRUCTION NOTES
- 1. CONSTRUCT "L" CURB PER STD. DWG. 216
 - 2. CONSTRUCT "A" CURB PER STD. DWG. 219
 - 3. CONSTRUCT 3" VALLEY GUTTER PER DETAIL SHEET G1
 - 4. CONSTRUCT 2" AC OVER 5" TYPE II
 - 5. CONSTRUCT 3" AC OVER 4" TYPE II
 - 6. CONSTRUCT 8" VALLEY GUTTER PER STD. DWG. 228
 - 7. CONSTRUCT HANDICAPPED RAMP PER STD. DWG. 235, CASE 1
 - 8. CONSTRUCT SIDEWALK DRAIN PER STD. DWG. 236
 - 9. CONSTRUCT SIDEWALK PER STD. DWG. 234
 - 10. CONSTRUCT 4" AC OVER 4" TYPE II OVER 9" TYPE I
 - 11. INSTALL R1-1

BACK OF CURB
CURVE TABLE

CURVE	LENGTH	DELTA	RADIUS	TANGENT
C1	39.27'	90°00'00"	25.00'	25.00'
C2	23.56'	90°00'00"	15.00'	15.00'
C3	39.27'	90°00'00"	25.00'	25.00'
C4	23.56'	90°00'00"	15.00'	15.00'

I CERTIFY THAT THIS GRADING PLAN IS IN CONFORMANCE WITH THE APPROVED DRAINAGE STUDY ON FILE WITH THE CITY OF LAS VEGAS FOR THIS PROJECT.

[Signature] 11/28/99
G.H. BILLINGSLEY No. 3003 DATE

DRAWN BY: D.S. BILLINGSLEY 28/DEC/98

DESIGNED BY: G.H. BILLINGSLEY 20/JUL/98

CHECKED BY: G.H. BILLINGSLEY 28/DEC/98

PROJECT NO: 98004-G1

GRADING PLAN

TITLE: DECATUR AUTO CENTER
DECATUR BLVD.
NORTH OF VEGAS DRIVE

SCALE: 1" = 30'

MEL W. TAYLOR
2601 McLEOD
LAS VEGAS, NEVADA 89121
(702) 431-3804 / FAX (702) 431-3834

AZIMUTH ENGINEERING & SURVEYING INC.
16 WEST PACIFIC #11
HENDERSON, NEVADA 89015
(702) 564-8544 / FAX (702) 564-7564

107-V2941

