
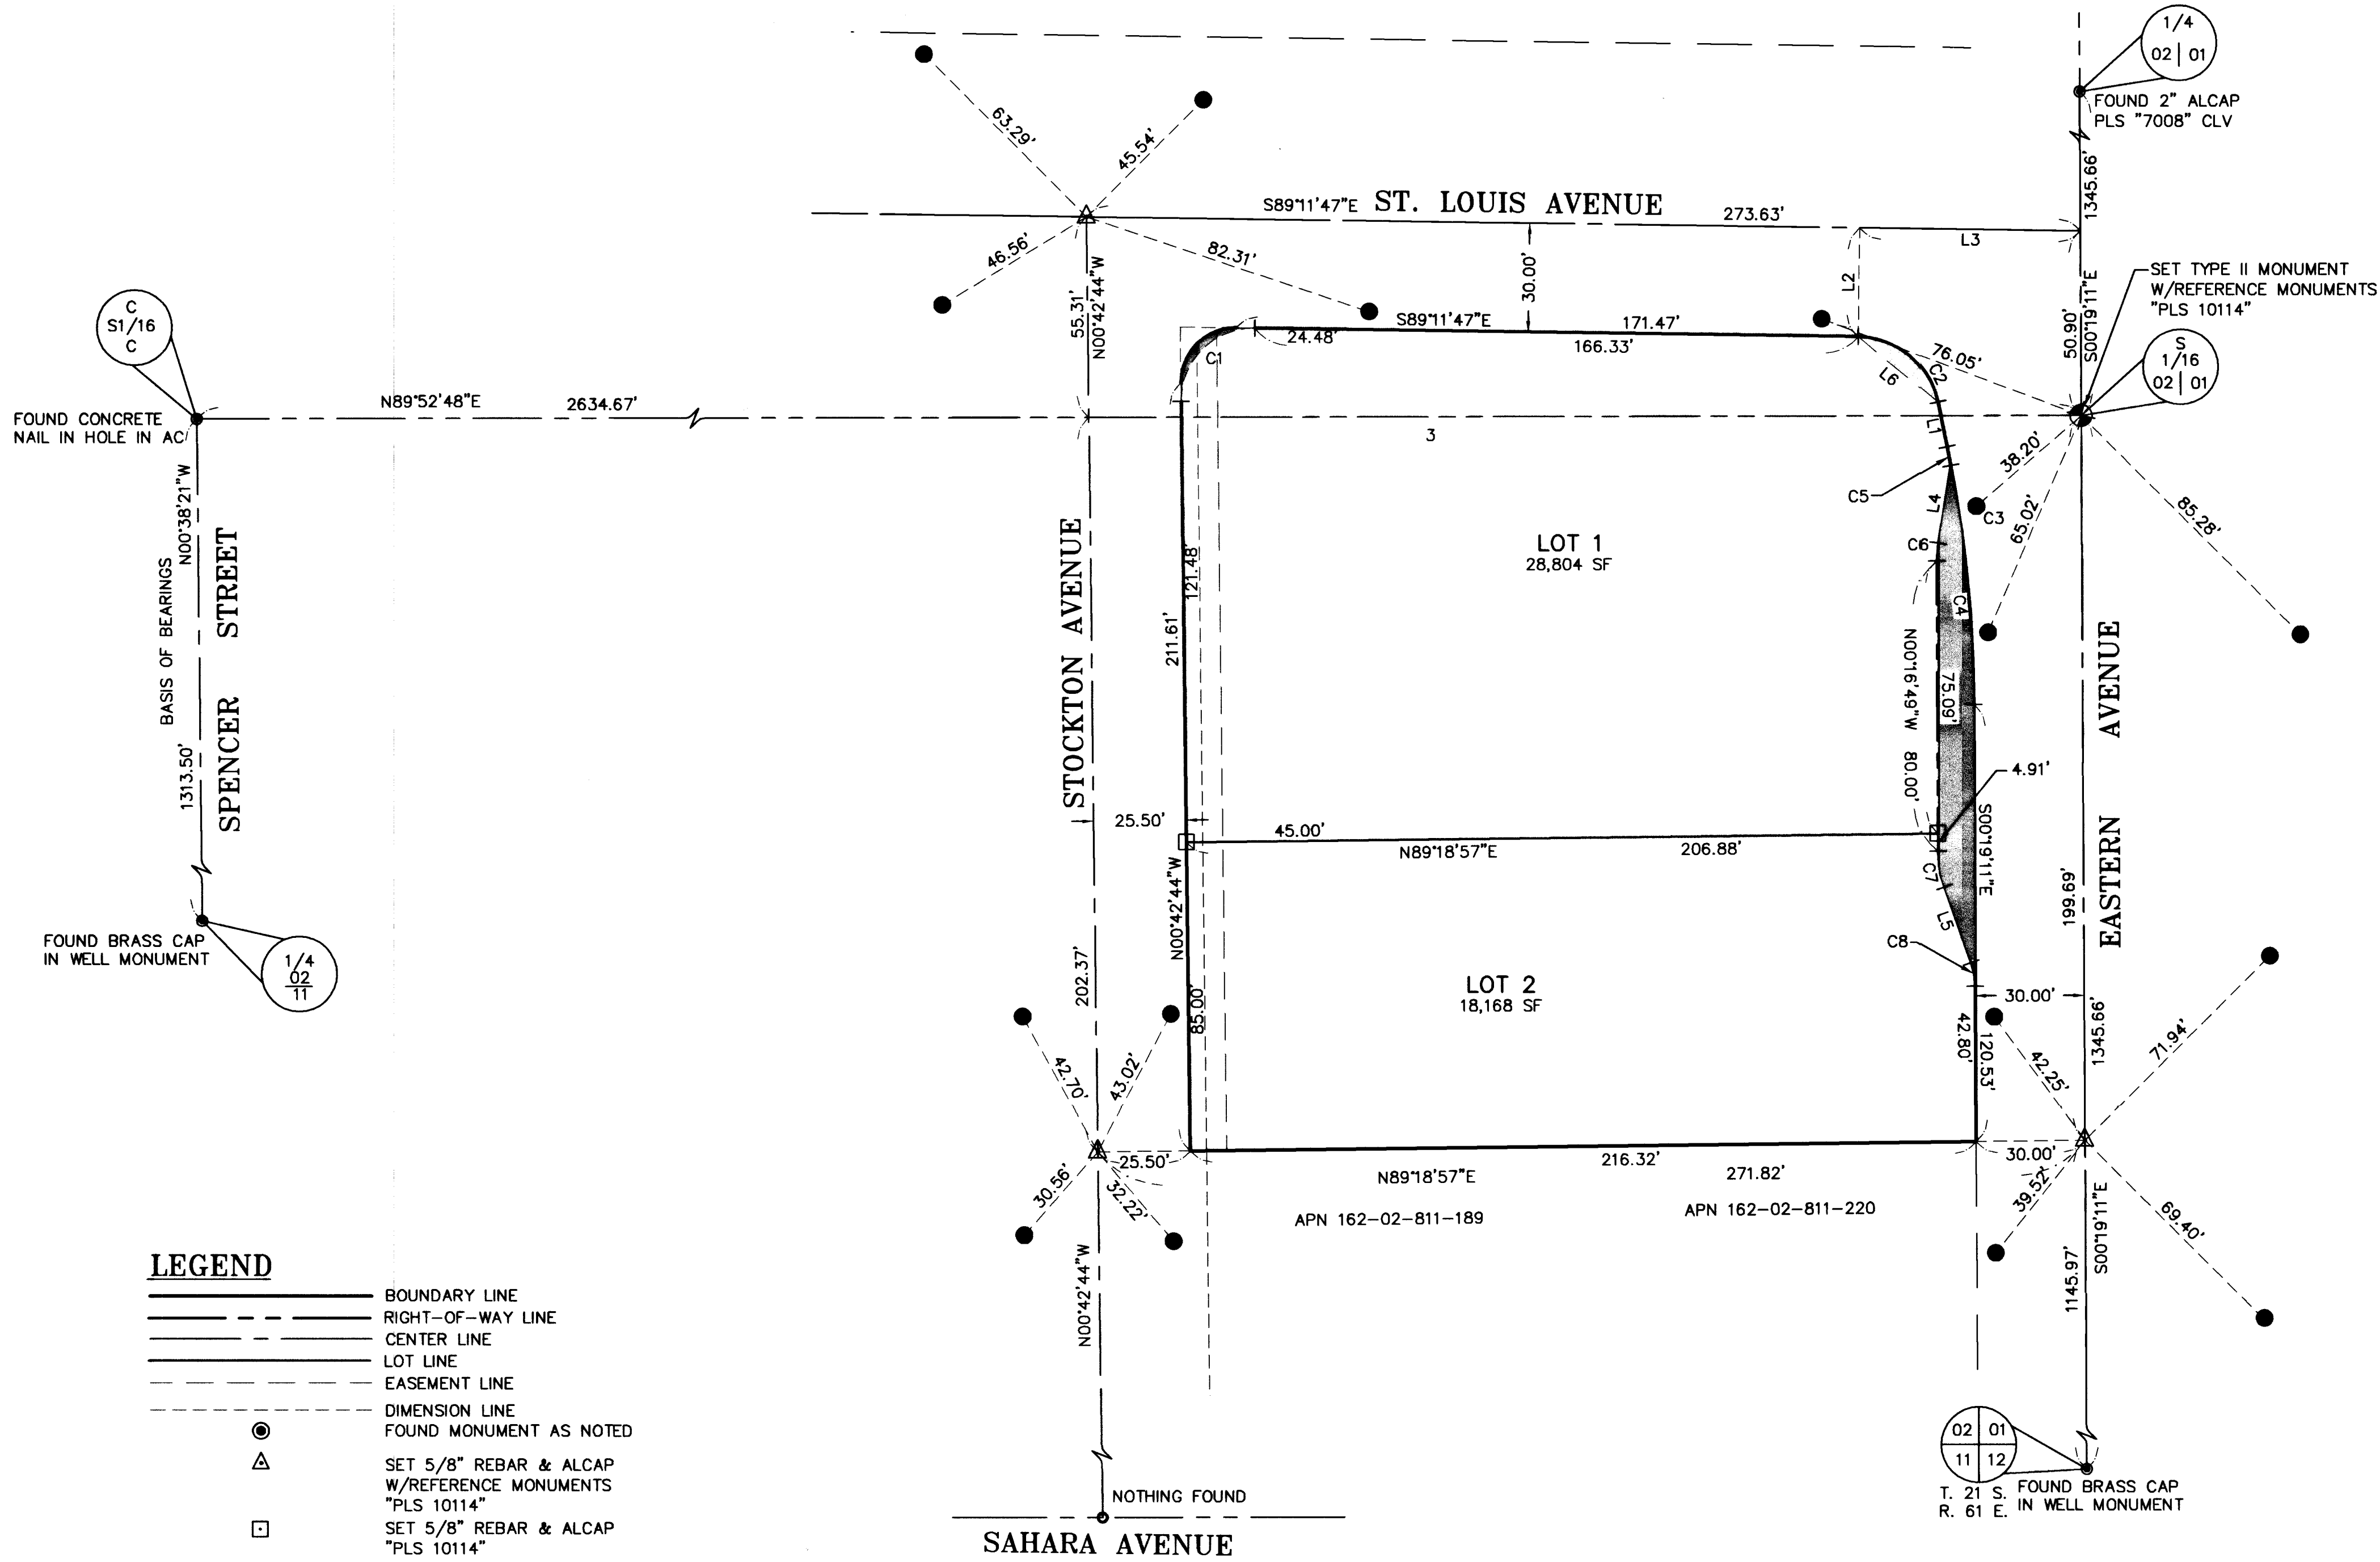


1. COPY TENT.....TM#.....
2. TITLE/REV. NAME REF.....
3. CONFORM. TO TENT.....
4. OWNER SIGN.....
5. SURVEYOR CERT.....
6. STREET NAMES(APPROV'D).....
7. LEGEND.....
8. NORTH ARROW.....
9. SCALE.....
10. VIC. MAP.....
11. LEGAL DESC.....
12. ACREAGE.....
13. APN #.....
14. LDT/BLOCK #.....
15. BEARINGS(INCL. RAD).....
16. DISTANCES.....
17. LINE/CURVE TAB.....
18. MON., MARGINS, B.O.B.....
19. ADJOINR-D-W/OWNER'S DRWN.
W/BROKEN LINE(NAP).....
20. SHEET #.....
21. CERTIFICATES:
CITY SURVEYOR.....
CITY CLERK.....
PLANNING.....
UTILITIES.....
TITLE CO.....
SURVEYOR.....
OWNER DED.....
OTHER.....

EASTERN PROPERTIES

MONUMENT TIE MAP

LOCATED IN THE SOUTHEAST QUARTER (SE 1/4) OF SECTION 02,
TOWNSHIP 21 SOUTH, RANGE 61 EAST, M.D.M., CITY OF LAS
VEGAS, CLARK COUNTY, NEVADA

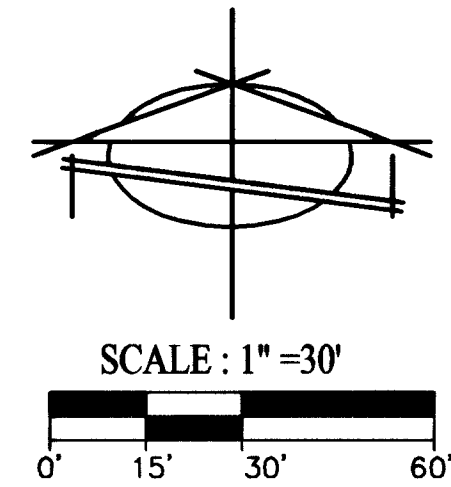

LEGEND

- BOUNDARY LINE
- RIGHT-OF-WAY LINE
- CENTER LINE
- LOT LINE
- EASEMENT LINE
- DIMENSION LINE
- FOUND MONUMENT AS NOTED
- SET 5/8" REBAR & ALCAP W/REFERENCE MONUMENTS "PLS 10114"
- SET 5/8" REBAR & ALCAP "PLS 10114"
- SET TYPE II MONUMENT W/REFERENCE MONUMENTS "PLS 10114"
- SET 1 1/2" REFERENCE MONUMENT
- SF SQUARE FEET

BASIS OF BEARING


BEING THE WEST LINE OF THE SOUTHEAST QUARTER (SE 1/4) OF SECTION 02,
TOWNSHIP 21 SOUTH, RANGE 61 EAST M.D.M., AS SHOWN ON RECORD OF
SURVEY IN FILE 111, PAGE 52, OFFICIAL RECORDS, CLARK COUNTY, NEVADA:
WHICH BEARS N00°38'21"W.

CURVE TABLE				
CURVE	LENGTH	RADIUS	DELTA	TANGENT
C1	31.95'	20.00'	91°30'57"	20.54'
C2	30.50'	22.50'	77°39'50"	18.11'
C3	71.51'	365.42'	11°12'46"	35.87'
C4	66.22'	365.42'	10°23'01"	33.20'
C5	5.29'	365.42'	0°49'45"	2.64'
C6	4.95'	30.00'	9°27'44"	2.48'
C7	10.08'	30.00'	19°14'53"	5.09'
C8	6.71'	20.00'	19°12'32"	3.38'


LINE TABLE		
LINE	LENGTH	BEARING
L1	12.50'	S11°31'57"E
L2	30.00'	N00°48'13"E
L3	60.46'	S89°11'47"E
L4	21.72'	S09°08'33"W
L5	21.99'	S19°31'42"E
L6	28.22'	S50°21'52"E

SURVEYOR'S CERTIFICATE

I, ROBERT C. JOHNSON, A PROFESSIONAL LAND SURVEYOR
LICENSED IN THE STATE OF NEVADA, DO HEREBY CERTIFY THAT
THE MONUMENTS HAVE BEEN SET AND THE TIE DISTANCES
ESTABLISHED AS SHOWN HEREON. THIS SURVEY WAS COMPLETED
ON JULY 21, 2006.

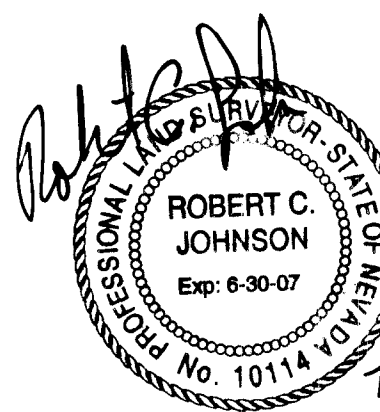

ROBERT C. JOHNSON, P.L.S.
NEVADA LICENSE NO. 10114

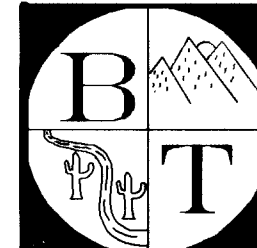

055-748
BAUGHMAN & TURNER, INC.
CIVIL ENGINEERS LAND SURVEYORS LAND PLANNERS
1210 HINSON STREET LAS VEGAS, NEVADA 89102
Ph. (702) 870-8771 Fax (702) 878-2695