


SEE SHEETS T6 & T8 FOR DELINEATION

POLE SCHEDULE

POLE	LOCATION STATION	TYPE	SIGNAL ARM		LUMINAIRE ARM		SIGNAL VEHICLES		PED. SIGNAL VEHICLES		PED. PUSH BUTTONS		REMARKS
			QUAD.	LENGTH	QUAD.	LENGTH	TYPE	QUAD.	TYPE	QUAD.	QUAD.	QUAD.	
(A)	104+00.00 77.00' LT.	XX-A			1	15'							
(B)	103+98.00 65.00' RT.	XX-A			4	15'							
(C)	102+68.00 76.00' RT.	XX-A			3	15'							
(D)	102+58.00 65.00' LT.	XX-A			2	15'							

POLE NOTES

- ALL POLE LOCATIONS ARE BASED FROM DURANGO DRIVE CENTERLINE STATIONING.
- POLES A, B, C, & D SHALL HAVE A TYPE "L" FOUNDATION PER STD. DWG. NO. 404.209.

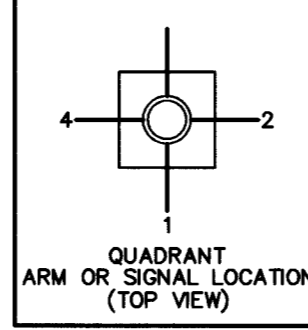

SHEET NOTES:

- CONDUIT LOCATIONS AS SHOWN ON THE DRAWINGS ARE FOR CLARITY OF RUNS ONLY. ALL CONDUIT RUNS, EITHER SINGLE OR MULTIPLE, SHALL RUN CORNER TO CORNER. MULTIPLE RUNS NOT TERMINATING IN THE SAME PULL BOX SHALL PASS UNDER THE PULL BOX USING 90° ELBOWS AND CONTINUE TO THE NEXT CORNER OR TERMINATING POINT. ALL MULTIPLE CONDUIT RUNS SHALL BE PLACED IN THE SAME TRENCH WHENEVER POSSIBLE. THE PLACEMENT OF POLES AND CABINETS SHALL BE AS INDICATED ON THE PLANS. ALL CHANGES SHALL BE APPROVED BY THE TRAFFIC ENGINEER.
- ALL PULLBOXES ARE NO. 5 UNLESS NOTED OTHERWISE.

DEPARTMENT OF PUBLIC WORKS
CITY OF LAS VEGAS

RECORD DRAWING INFORMATION PROVIDED BY MEADOW VALLEY CONSTRUCTION, INC.

REV	DATE	BY
12/15/03		DRF

CONSULTING ENGINEERS • PLANNERS • LAND SURVEYORS
2727 SOUTH RAINBOW BOULEVARD
LAS VEGAS, NEVADA 89146-5148 PHONE (702) 873-7550 FAX (702) 362-2597

VTN nevada

TITLE: **TRAFFIC SIGNAL UNDERGROUND PLAN DURANGO / ELKHORN**

PROJECT: **DURANGO DRIVE IMPROVEMENTS I-215 TO US 95**

SEAL
ORIGINAL CONSTRUCTION DRAWINGS ARE ON FILE WITH THE CITY OF LAS VEGAS.
THE DOCUMENTS WERE SEALED ON 12/17/02 BY ROBERT C. HOSEA III UNDER LICENSE NO. 10112

NO. NO. 5678
BY: RCH, LMW, WBM
DATE: 11/27/02
SCALE: HORIZ. 1"=20', VERT. NA
DRAWING: T11 SHEET 71 OF 80 SHEETS

I:\CAD\PUBLIC\5678\5678-SIG.DWG

63720

RECORD DRAWINGS INFORMATION SUPPLIED BY CONTRACTOR - DECEMBER 2003