


LENGTH OF FIBER CABLE IN CITY OF LAS VEGAS RIGHT-OF-WAY


UNDERGROUND IN CITY OF LAS VEGAS
RIGHT-OF-WAY
= 116.39± FEET

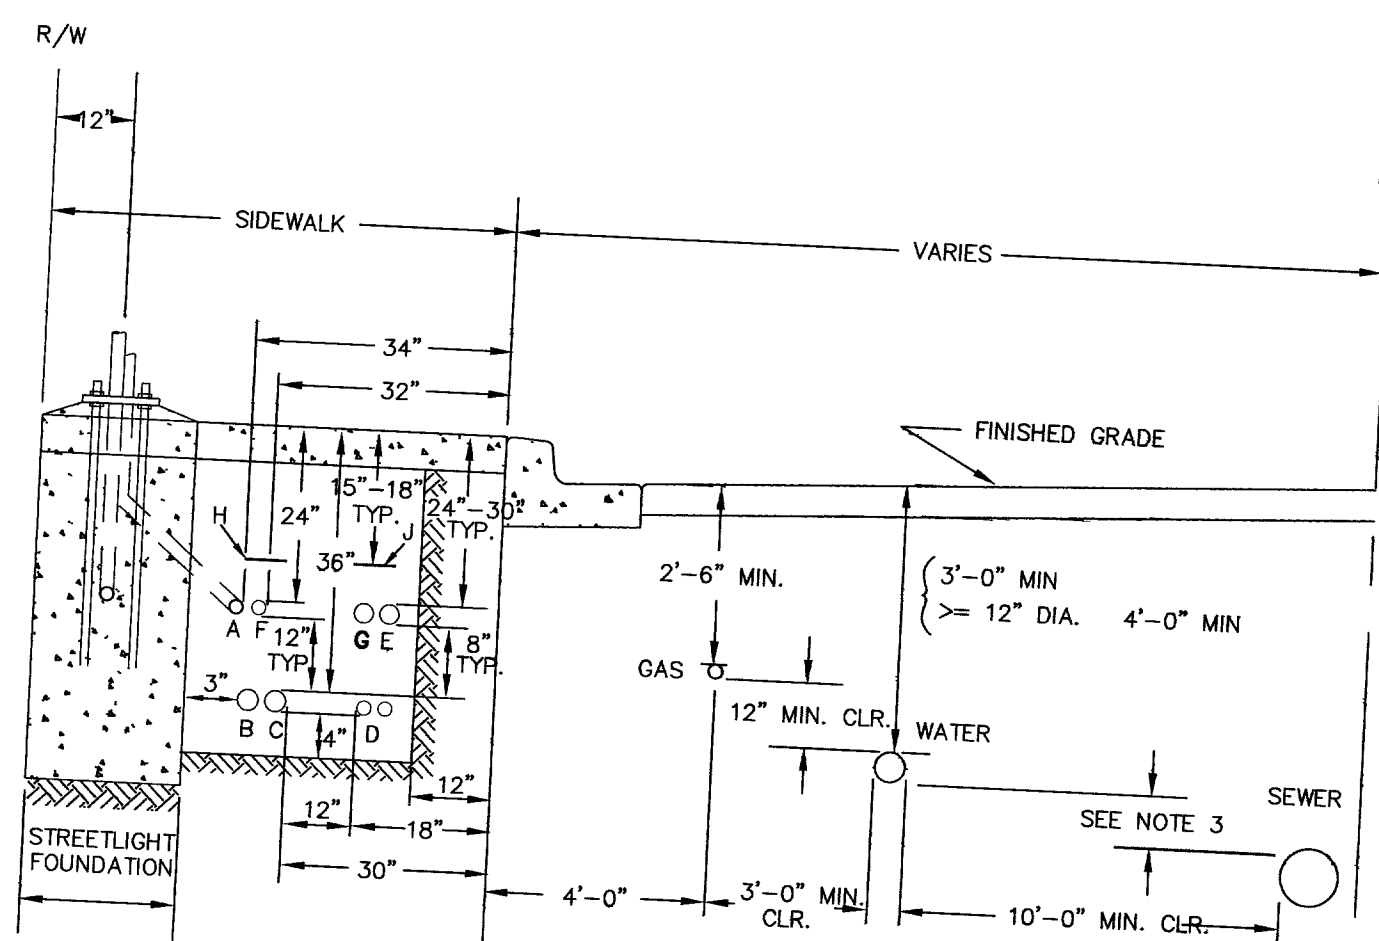



- A. STREETLIGHT CONDUIT
- B. POWER COMPANY SECONDARY
- C. POWER COMPANY PRIMARY
- D. TELEPHONE CONDUITS
- E. CABLE T.V. CONDUIT
- F. TRAFFIC SIGNAL CONDUIT
- G. OTHER COMMUNICATIONS CONDUIT
- H. POWER MARKING TAPE
- J. TELEPHONE MARKING TAPE

- NOTES:
- SEWER MAY BE LOCATED ON OTHER SIDE OF CENTERLINE AS TERRAIN DICTATES.
 - STREETLIGHT FOUNDATIONS SHALL BE LOCATED BEHIND SIDEWALK FOR SIDEWALK WIDTHS LESS THAN 5 FEET PER STANDARD DRAWING NO. 320.
 - SEPARATION DISTANCE SHALL CONFORM TO UTILITY STANDARDS ADOPTED BY THE GOVERNING AGENCY FOR SEWER AND WATER FACILITIES.

UNIFORM STANDARD DRAWING #501
DETAIL A-A
NO SCALE

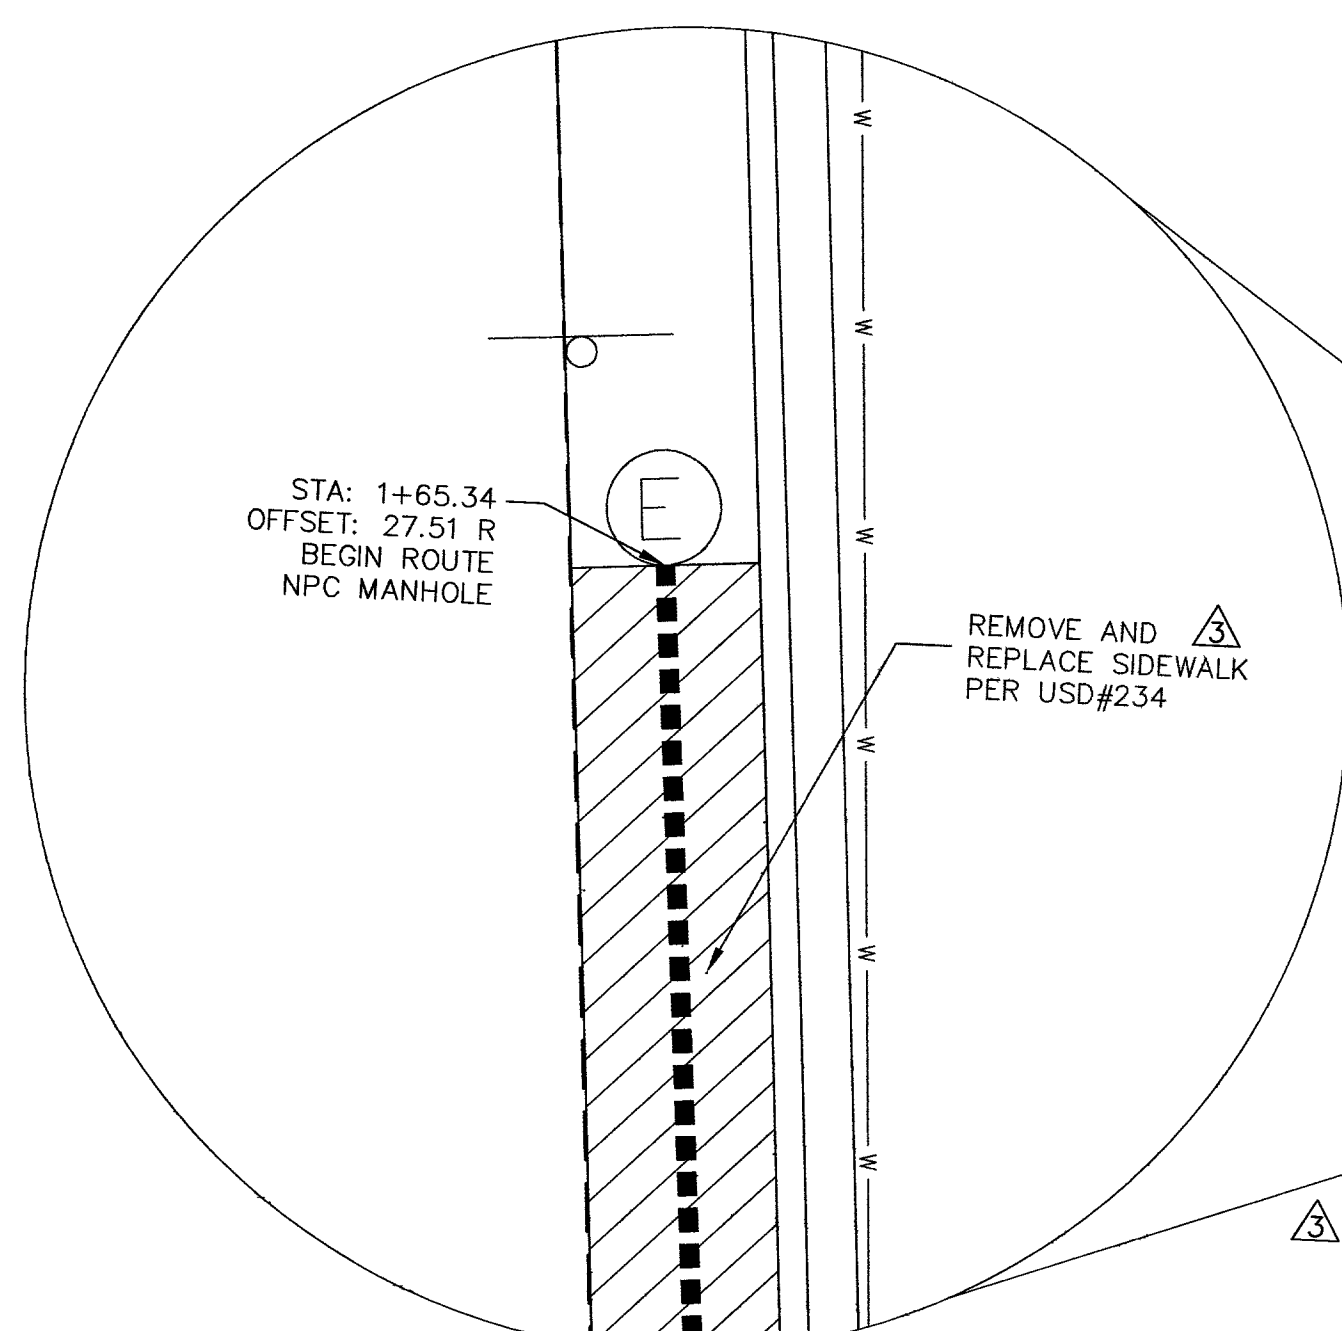

DETAIL
SCALE: 1"=5'

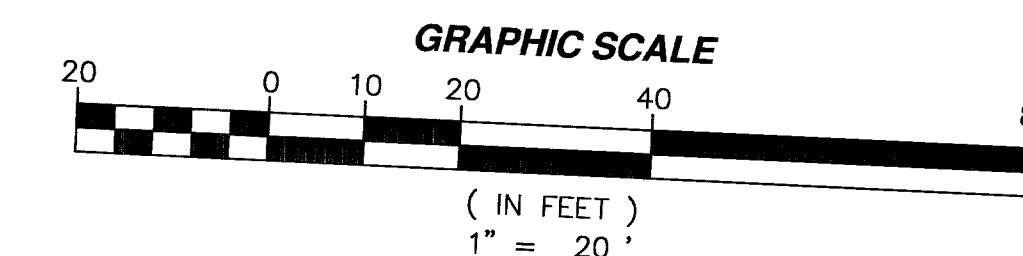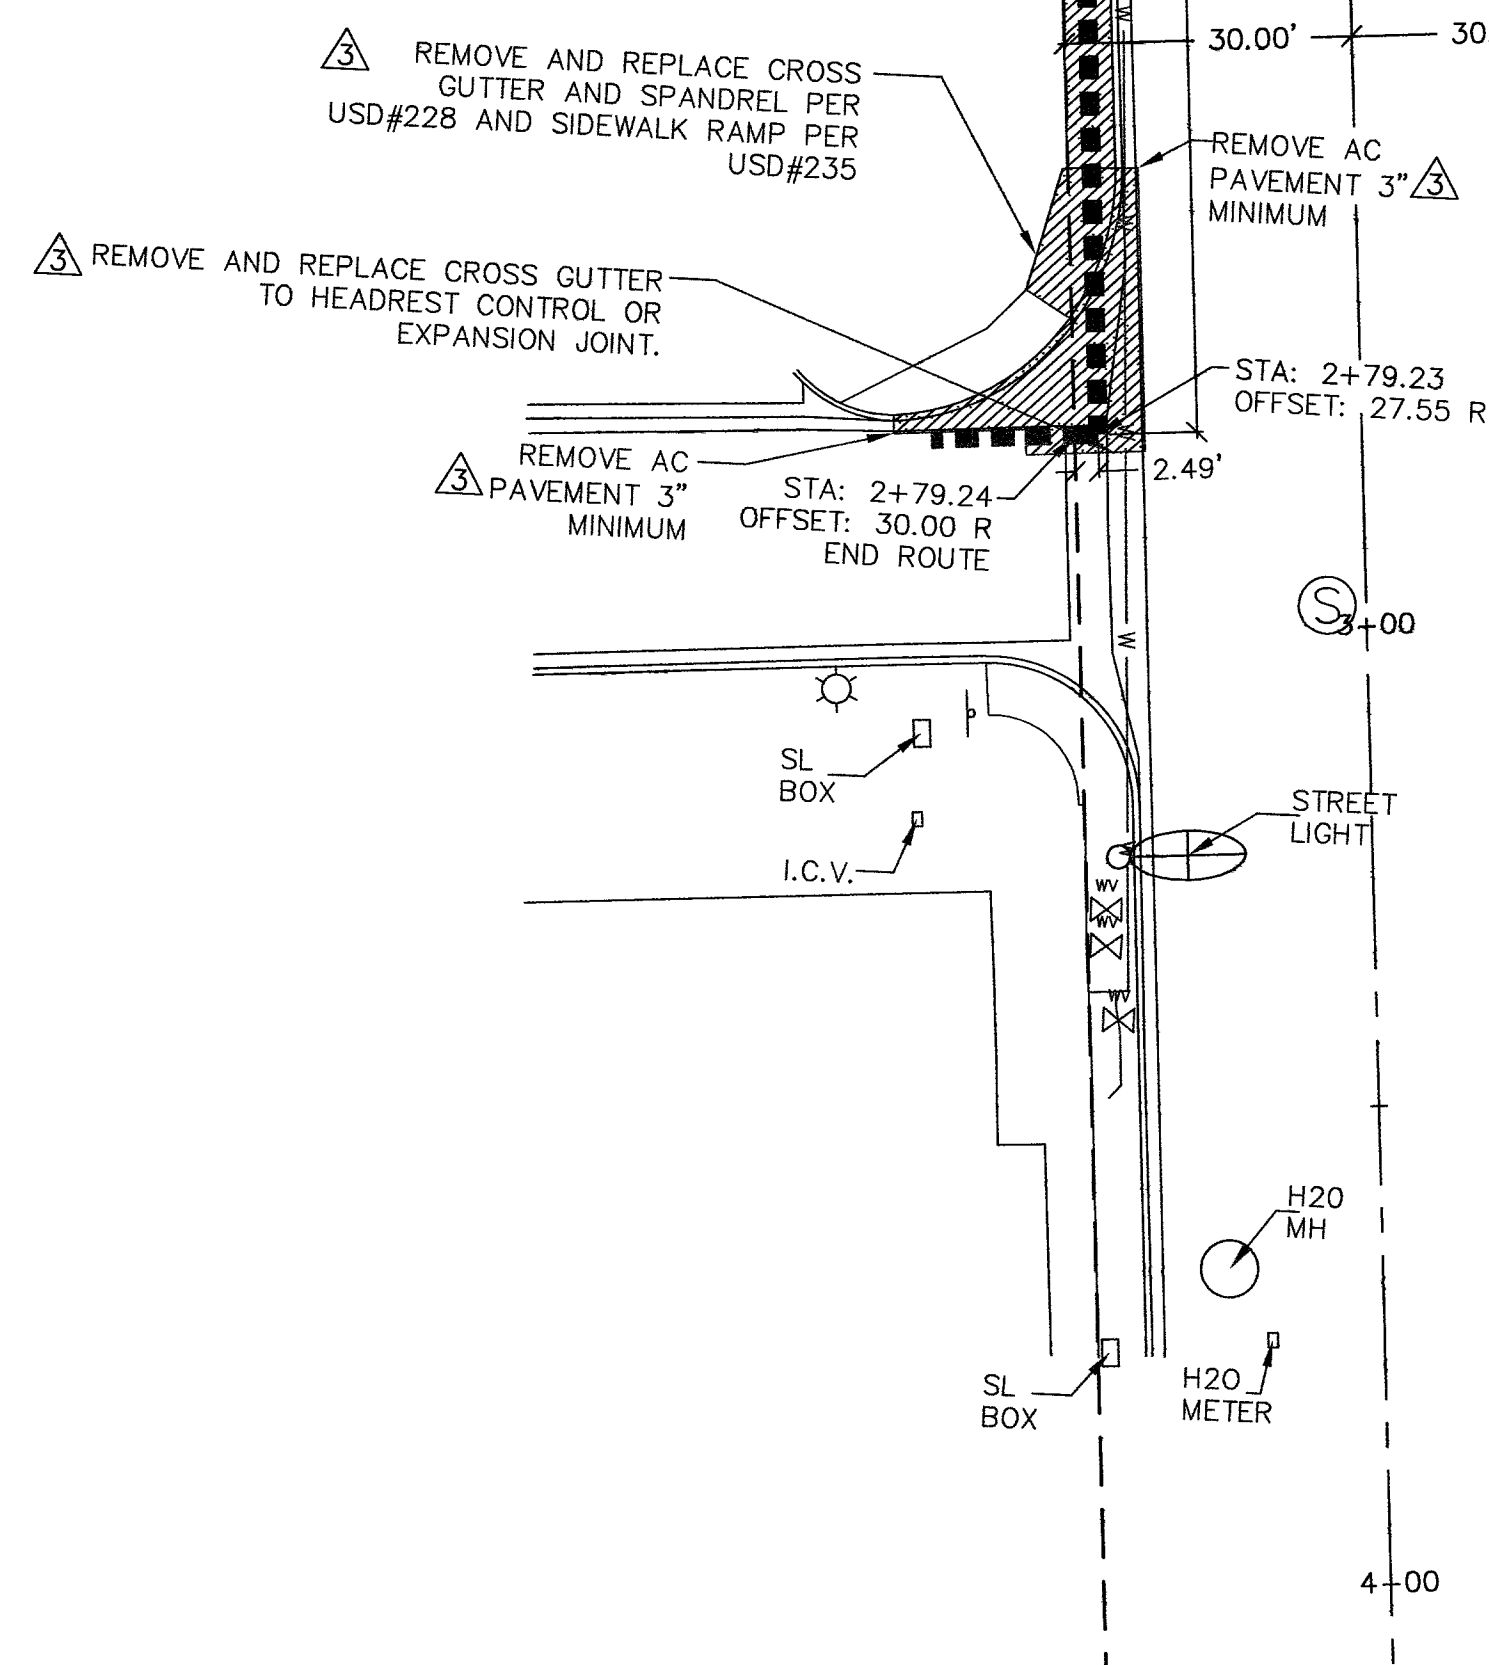

LEGEND

- STREET CENTERLINE
- RIGHT-OF-WAY LINE
- EXISTING WATER LINE
- CITY OF LAS VEGAS RIGHT-OF-WAY
- 24 CT FIBER TO BE LOCATED IN 4" PVC CONDUIT IN CITY OF LAS VEGAS RIGHT-OF-WAY (IN UNDERGROUND TRENCH)
- 24 CT FIBER TO BE LOCATED IN 4" PVC CONDUIT OUTSIDE OF CITY OF LAS VEGAS RIGHT-OF-WAY (IN UNDERGROUND TRENCH)
- AREA OF CONSTRUCTION
- SIGN
- WATER VALVE
- TELEPHONE MANHOLE
- NPC MANHOLE
- SANITARY SEWER MANHOLE
- LIGHT POLE
- IRRIGATION CONTROL VALVE

REVISIONS


NO.	REV.	BY	APPR.	DESCRIPTION	DATE
1		JC		NEW ROUTE LOC PER STD DWG 501	02/18/05
2		JC		ADD STD DWG 501 DETAIL	02/18/05
3		BMG		SHOW AREAS TO BE REMOVED	03/23/05

SPECTRUM
SURVEYING & ENGINEERING
7351 W. CHARLESTON BLVD., SUITE 120
LAS VEGAS, NEVADA 89117
OFFICE: (702) 367-7705
FAX: (702) 367-8733

IDACOMM
5860 SOUTH PECOS ROAD
BUILDING G, SUITE 100
LAS VEGAS, NEVADA 89120
PHONE: (702) 949-7931
FAX: (702) 949-7929

ENCROACHMENT PERMIT SURVEY

CHARLESTON / MERIALDO

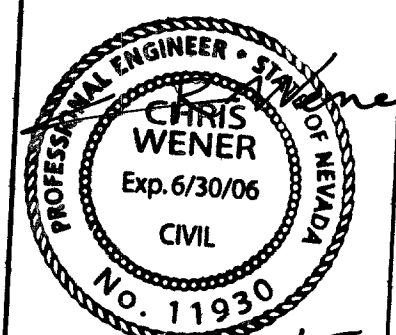

ENGINEER'S SEAL

WORK ORDER# 2062	DACOMM# 2004-02
DATE: 01/17/2005	JOB NO: CD04110
DRAWN BY: BMG	CHECKED BY: DE
SCALE: 1" = 20'	