

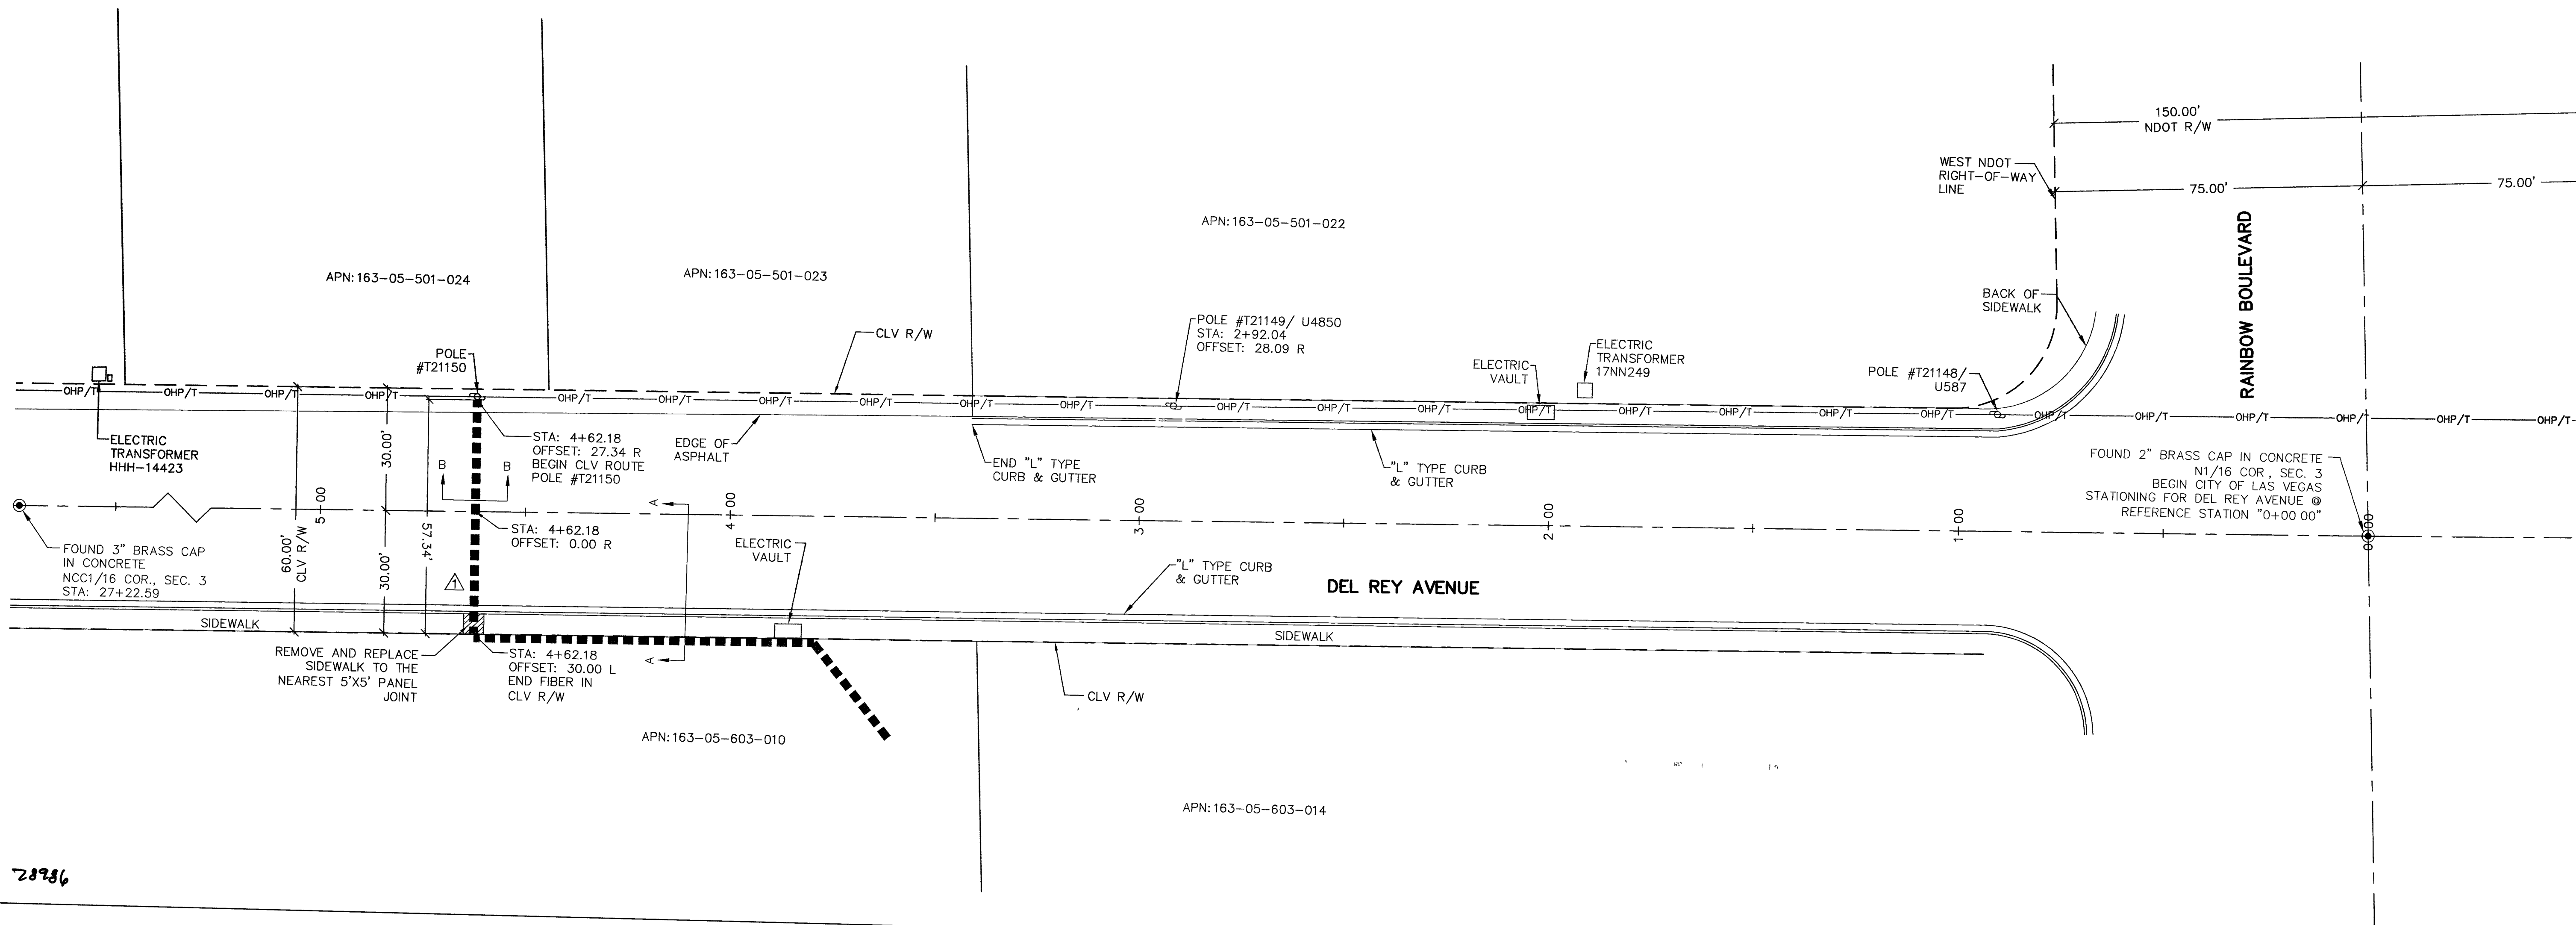


LENGTH OF FIBER CABLE IN CITY OF LAS VEGAS RIGHT-OF-WAY

UNDERGROUND IN CITY OF LAS VEGAS
RIGHT-OF-WAY
= 57.34 FEET

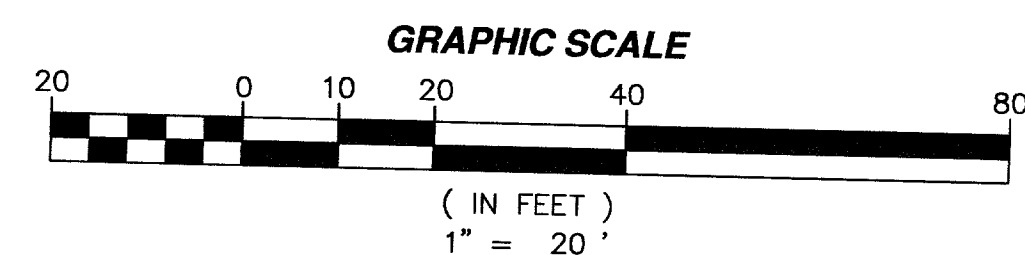

LEGEND

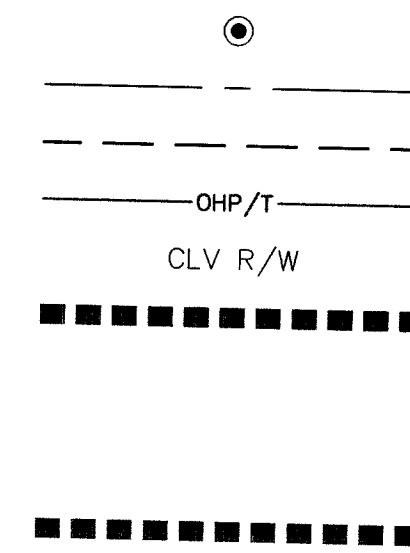

FOUND MONUMENT AS NOTED

STREET CENTERLINE


CITY OF LAS VEGAS RIGHT-OF-WAY LINE

EX. OVERHEAD UTILITY LINES

CITY OF LAS VEGAS RIGHT-OF-WAY

INSTALL 2" CONDUIT WITH 24 CT. FIBER IN 1" I.D. INNERDUCT IN CITY OF LAS VEGAS RIGHT-OF-WAY IN ACCORDANCE WITH UNIFORM STANDARD DRAWING #501

INSTALL 2" CONDUIT WITH 24 CT. FIBER IN 1" I.D. INNERDUCT OUTSIDE OF CITY OF LAS VEGAS RIGHT-OF-WAY.

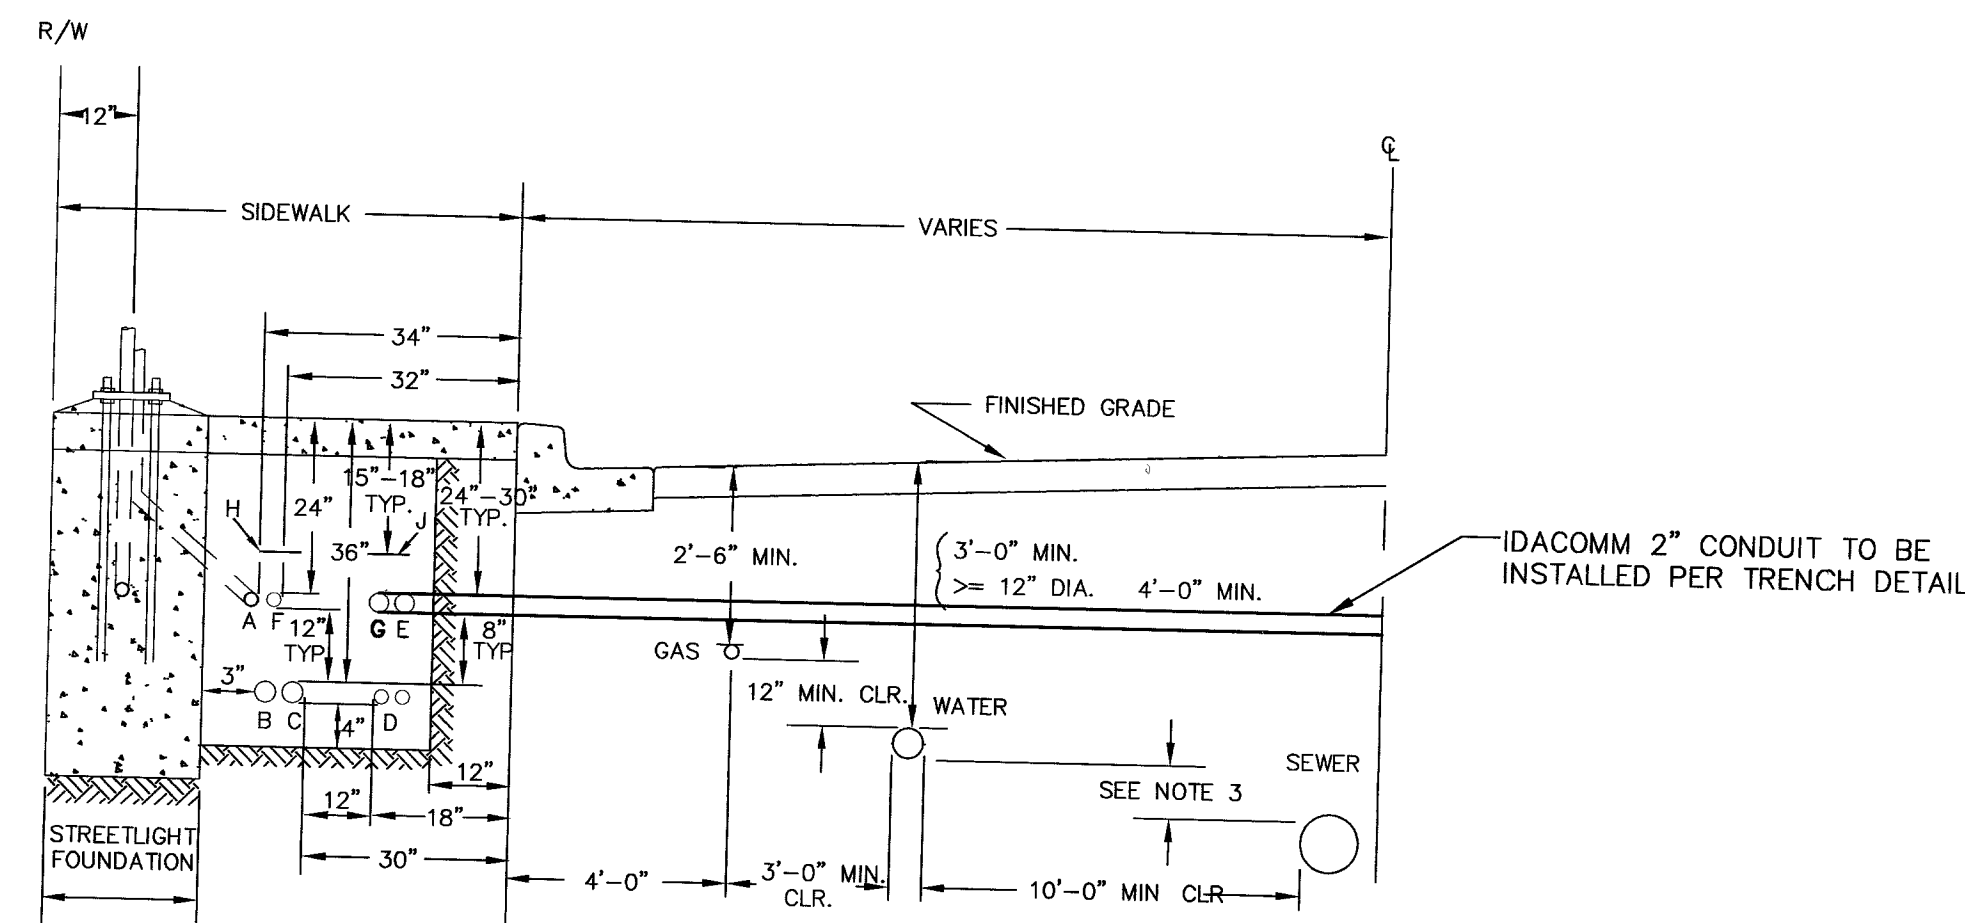


A. STREETLIGHT CONDUIT
B. POWER COMPANY SECONDARY
C. POWER COMPANY PRIMARY
D. TELEPHONE CONDUITS
E. CABLE T.V. CONDUIT
F. TRAFFIC SIGNAL CONDUIT
G. OTHER COMMUNICATIONS CONDUIT
H. POWER MARKING TAPE
J. TELEPHONE MARKING TAPE

NOTES:

- SEWER MAY BE LOCATED ON OTHER SIDE OF CENTERLINE AS TERRAIN DICTATES
- STREETLIGHT FOUNDATIONS SHALL BE LOCATED BEHIND SIDEWALK FOR SIDEWALK WIDTHS LESS THAN 5 FEET PER STANDARD DRAWING NO. 320
- SEPARATION DISTANCE SHALL CONFORM TO UTILITY STANDARDS ADOPTED BY THE GOVERNING AGENCY FOR SEWER AND WATER FACILITIES

DETAIL A-A
UNIFORM STANDARD DRAWING #501
NO SCALE

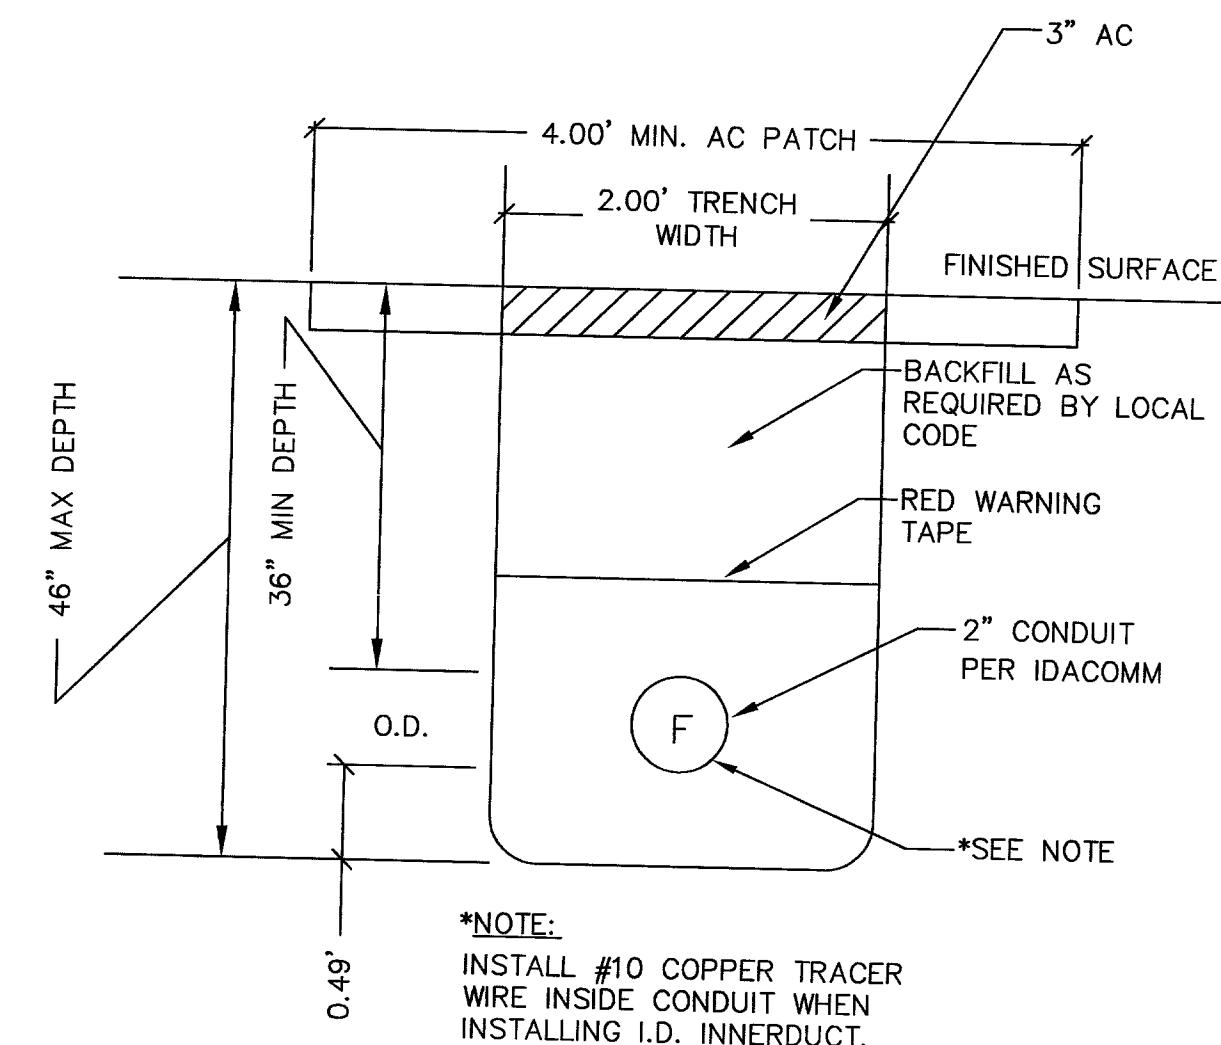

*NOTE:
INSTALL #10 COPPER TRACER WIRE INSIDE CONDUIT WHEN INSTALLING I.D. INNERDUCT.

TRENCH DETAIL
DETAIL B-B
NO SCALE

REVISIONS

REV	REV BY	APPR.	DESCRIPTION	DATE
1	BMG	DE	CHANGE FIBER PLACEMENT IN CLV R/W	03/29/05




SURVEYING & ENGINEERING
7351 W. CHARLESTON BLVD., SUITE 120
LAS VEGAS, NEVADA 89117
OFFICE: (702) 367-7705
FAX: (702) 367-8733



5860 SOUTH PECOS ROAD
BUILDING G, SUITE 100
LAS VEGAS, NEVADA 89120
PHONE: (702) 948-7831
FAX: (702) 948-7929

ENCROACHMENT PERMIT SURVEY

DEL REY AVENUE WEST OF
RAINBOW BOULEVARD
CITY OF LAS VEGAS
RIGHT-OF-WAY

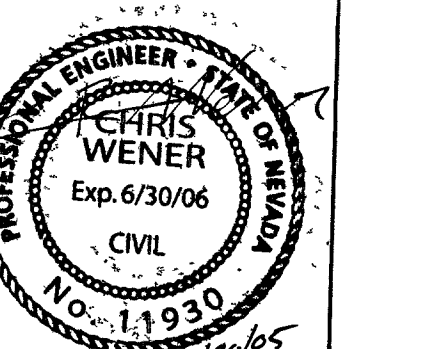

ENGINEER'S SEAL

WORK ORDER# 2062	DATE: 02/19/2005	CHECKED BY: DE
IDACOMM # 2005-06	DRAWN BY: JC	SCALE: 1" = 20'
ENTITY LOC.: CLV	JOB NO: CD005016	