


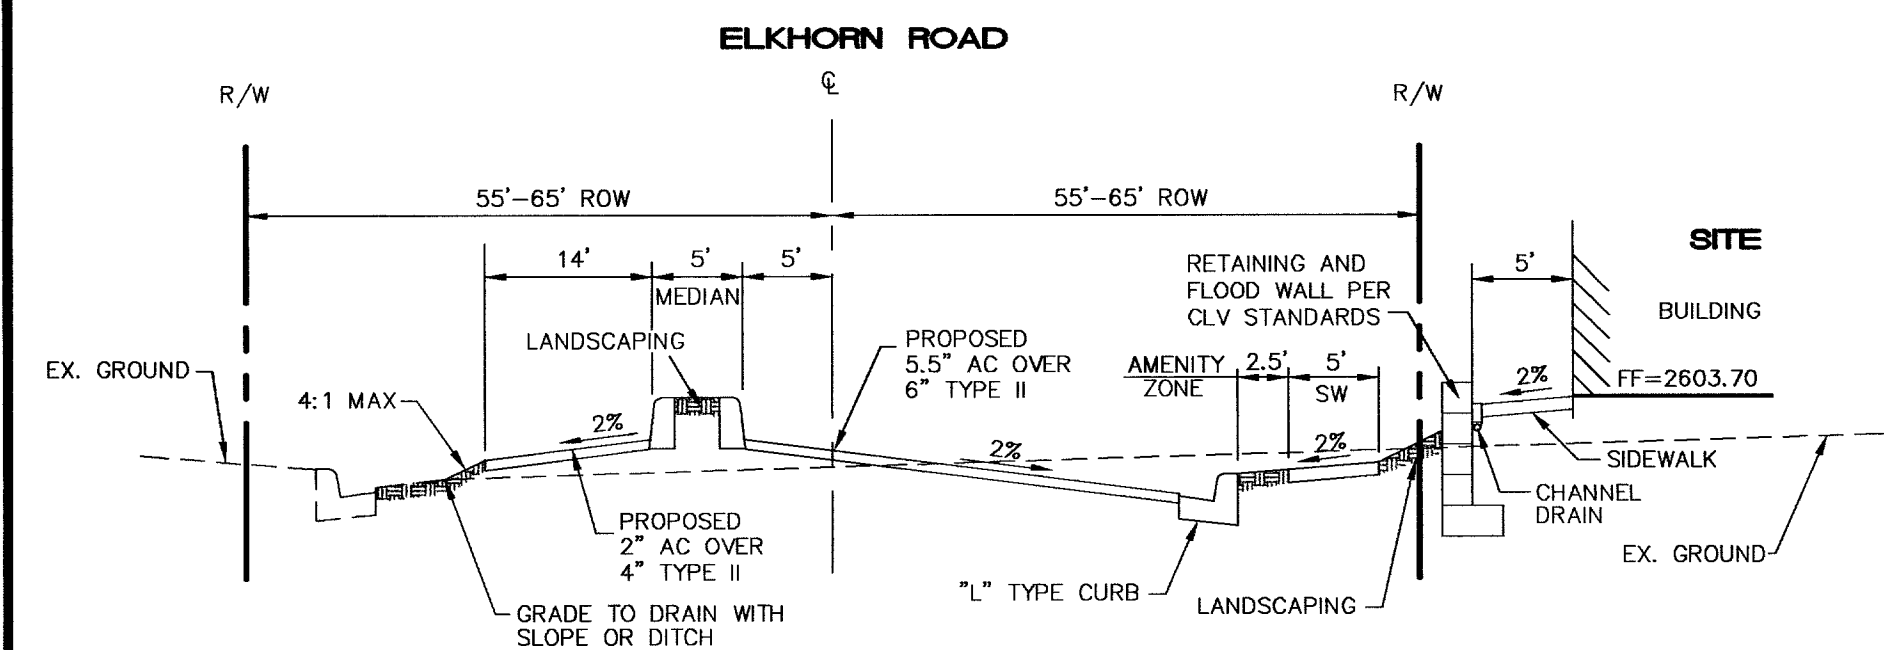

ELKHORN ROAD
TYPICAL SECTION

LINE TABLE		
LINE	LENGTH	BEARING
L1	1.07	S89°42'02"E
L2	177.30	S88°56'47"E
L3	5.63	N00°07'03"W
L4	252.21	S89°42'02"E
L5	252.21	S89°42'02"E


CURVE TABLE				
CURVE	RADIUS	LENGTH	TANGENT	DELTA
C1	25.00	39.14	24.87	89°42'02"
C2	25.00	39.73	25.46	91°03'13"
C3	25.00	39.32	25.05	90°07'03"
C5	2.00	6.28	INFINITE	180°00'00"

CONSTRUCTION NOTES

1. CONSTRUCT "L" TYPE CURB PER CCAUSD No. 216
2. CONSTRUCT "A" TYPE CURB PER CCAUSD No. 219
3. CONSTRUCT CONCRETE SIDEWALK PER CCAUSD DWG. No. 234
4. CONSTRUCT 8 FT CROSS GUTTER PER CCAUSD DWG. No. 228
5. CONSTRUCT SIDEWALK RAMP PER CCAUSD #235 CASE II (REF. TOWN CENTER PER DETAIL ON SHEET C6.02)
6. CONSTRUCT AC PAVEMENT (ELKHORN RD.) PER CROSS SECTION DETAIL ON LEFT

STORM DRAIN CONSTRUCTION NOTES

1. STUB AND CAP 18" RCP FOR FUTURE USE.
2. INSTALL 17.5" TYPE "CM" WITH "6 NUMBER GRATES" PER CLV STANDARDS SEE DETAIL ON SHEET C6.01
3. INSTALL TYPE I MANHOLE PER CCAUSD #403.

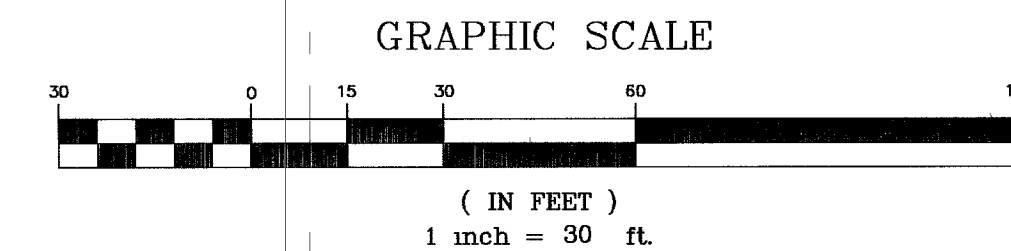



BENCHMARK

LAS VEGAS VERTICAL CONTROL v.2003 POINT # 6LV90 17SSE6, BEING A RIVET & ROUND PLATE IN CONCRETE CYLINDER AT THE +/-38' NORTH OF ELKHORN ROAD CENTERLINE AT THE INTERSECTION OF EL CAPITAN WAY.
ELEVATION: 2564.67 (FEET)
781.713 (METERS)


NORTH AMERICAN VERTICAL DATUM OF 1988 (NAVD'88)

BASIS OF BEARING

NORTH 00°07'03" WEST, BEING THE CENTERLINE OF EL CAPITAN WAY AS PER RECORD FILE 118 PAGE 0098 OF OFFICIAL RECORDS, CLARK COUNTY, NEVADA

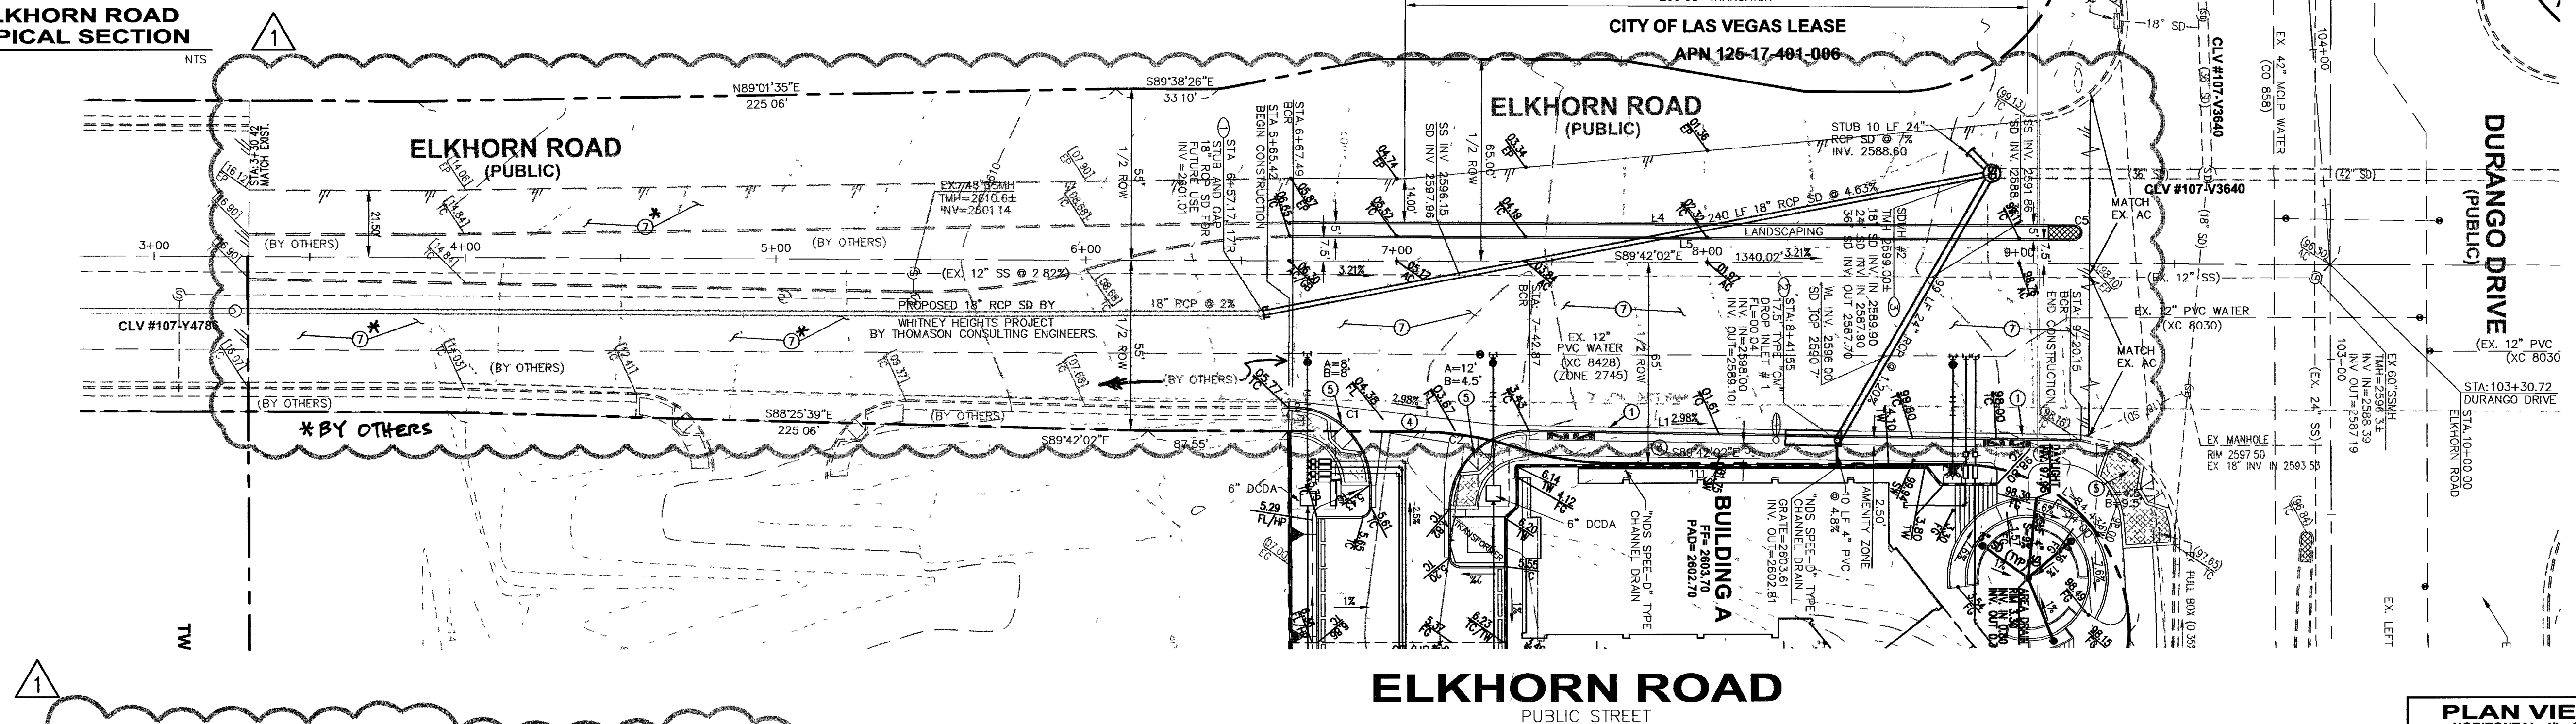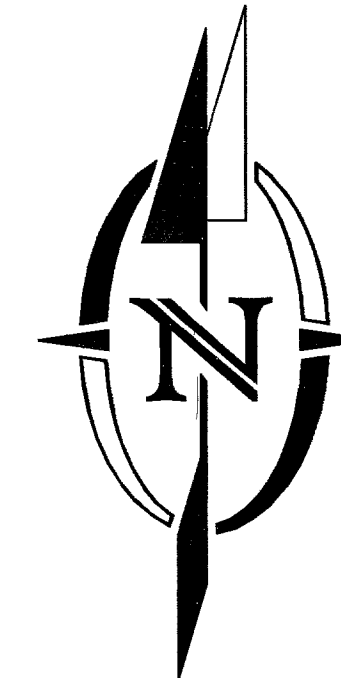

PLAN VIEW
HORIZONTAL: 1" = 30'
VERTICAL: NONE

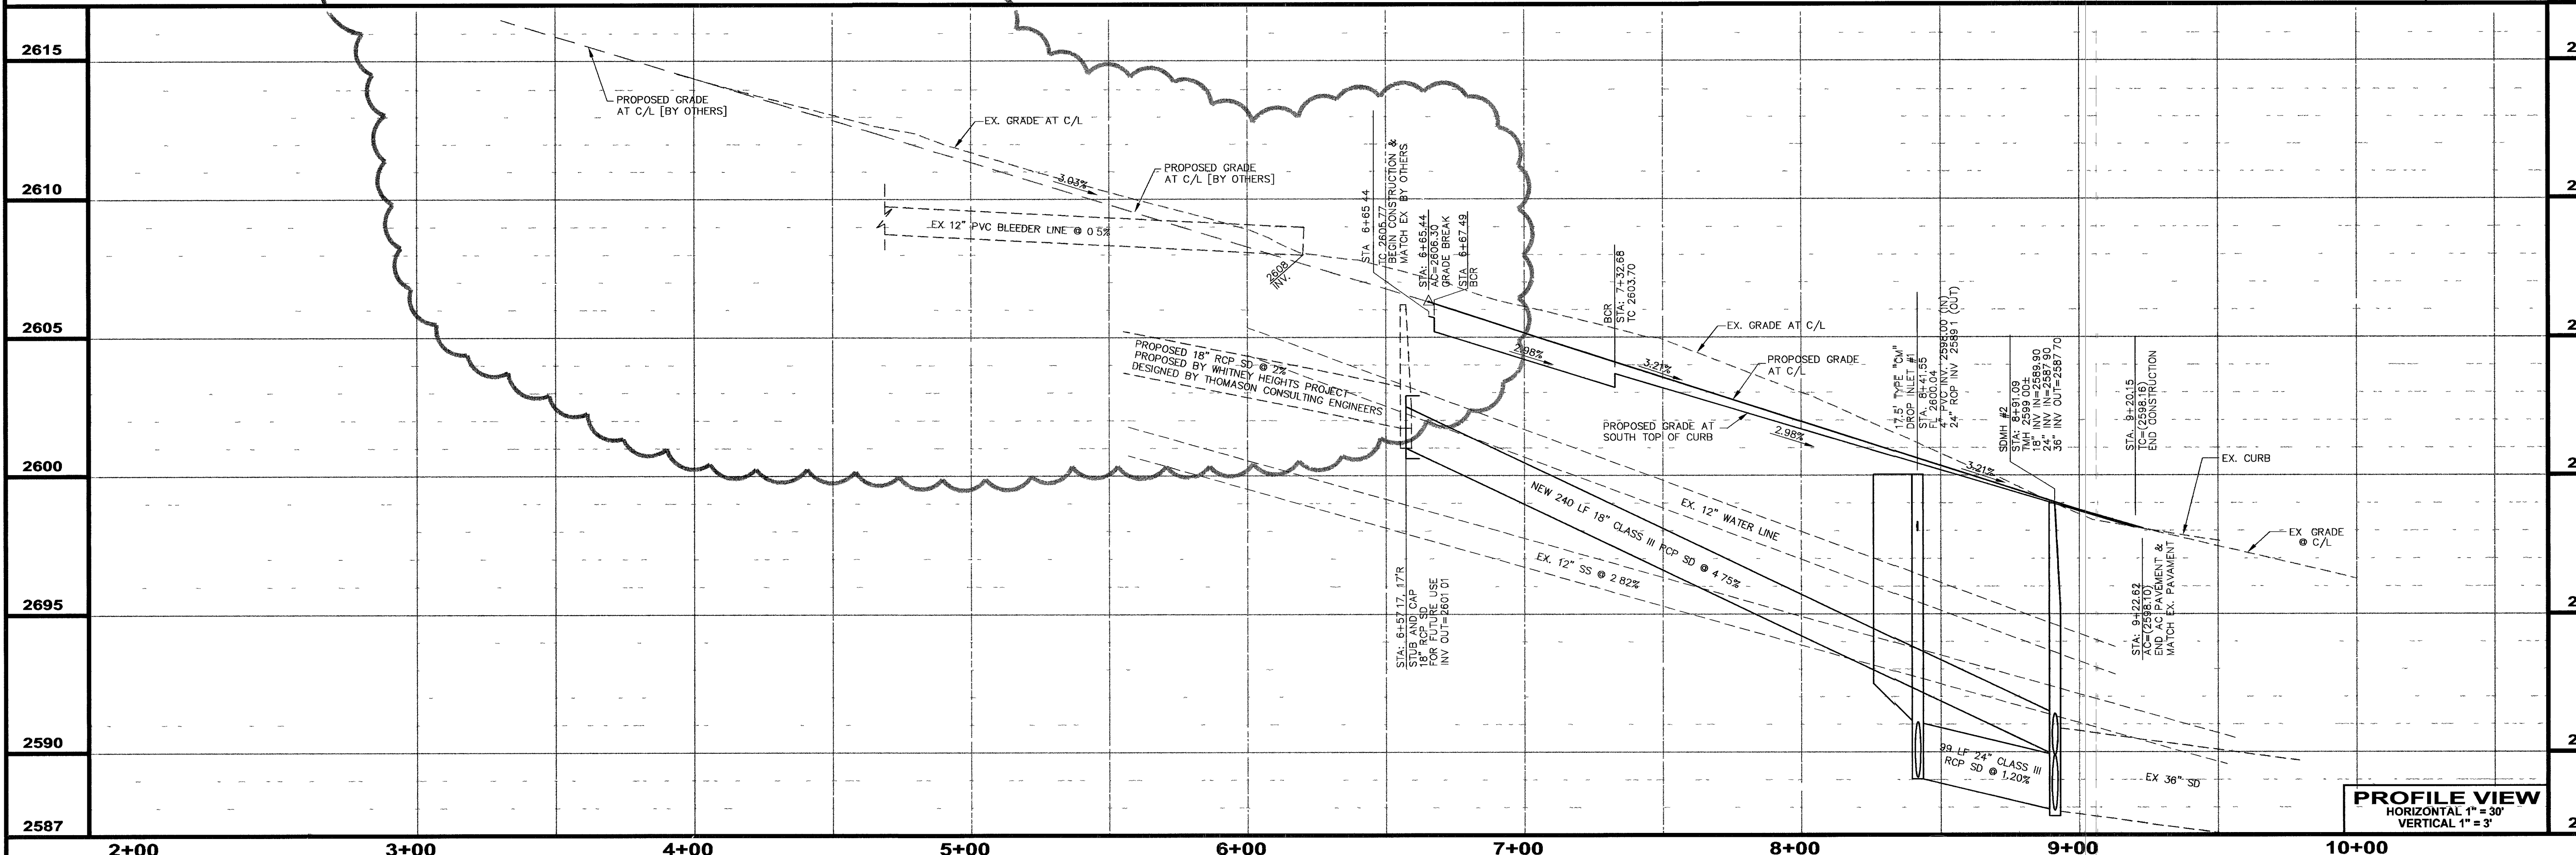

PROFILE VIEW
HORIZONTAL: 1" = 30'
VERTICAL: 1" = 3'

Call before you UnderGround
1-702-455-7511
CLARK COUNTY TRAFFIC OPERATIONS AND
1-702-229-6611
FREEMAN AND ARTERIAL SYSTEMS OF TRANSPORTATION

Call before you Dig.
1-800-227-2600
UNDERGROUND SERVICE (USA)

Call before you CRANE
1-702-227-2929

TITLE:
DURANGO / ELKHORN COMMERCIAL CENTER
(AKA TOWN CENTER PLAZA)

SHEET:
PLAN AND PROFILE
ELKHORN ROAD



SHEET
C3.02

6 OF 14 SHEETS

DRAWING NO.

107V4343

REVISED