


LEGEND


- SET 5/8" REBAR AND ALUM. CAP, MARKED "PLS 11175"
- SET ALUM. CAP REFERENCE MONUMENT IN CURB MARKED "PLS 11175"
- ⬢ BLOCK NUMBER, TYPICAL
- 1 LOT NUMBER, TYPICAL

MONUMENTATION TIE MAP of
ELKHORN - CIMARRON ESTATES
UNIT 2-B

A COMMON INTEREST COMMUNITY
A PORTION OF THE NORTHEAST QUARTER (NE 1/4) OF THE NORTHWEST QUARTER (NW 1/4)
OF SECTION 21, TOWNSHIP 19 SOUTH, RANGE 60 EAST, M.D.M.,
CITY OF LAS VEGAS, CLARK COUNTY, NEVADA.

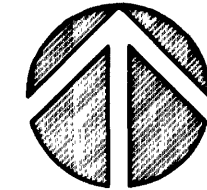


GRAPHIC SCALE

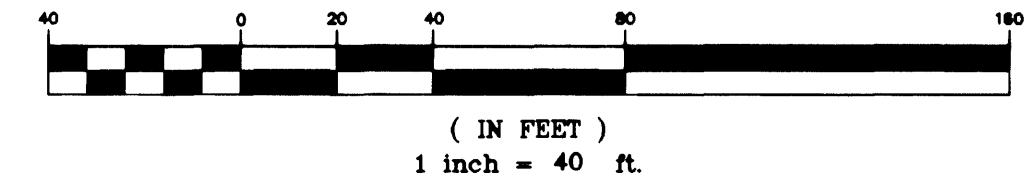

ELKHORN - CIMARRON ESTATES UNIT 2-A
BOOK 80, PAGE 95 OF PLATS
NOT A PART

APN 125-21-102-001
BOOK 1079, INST. 1038297
NOT A PART

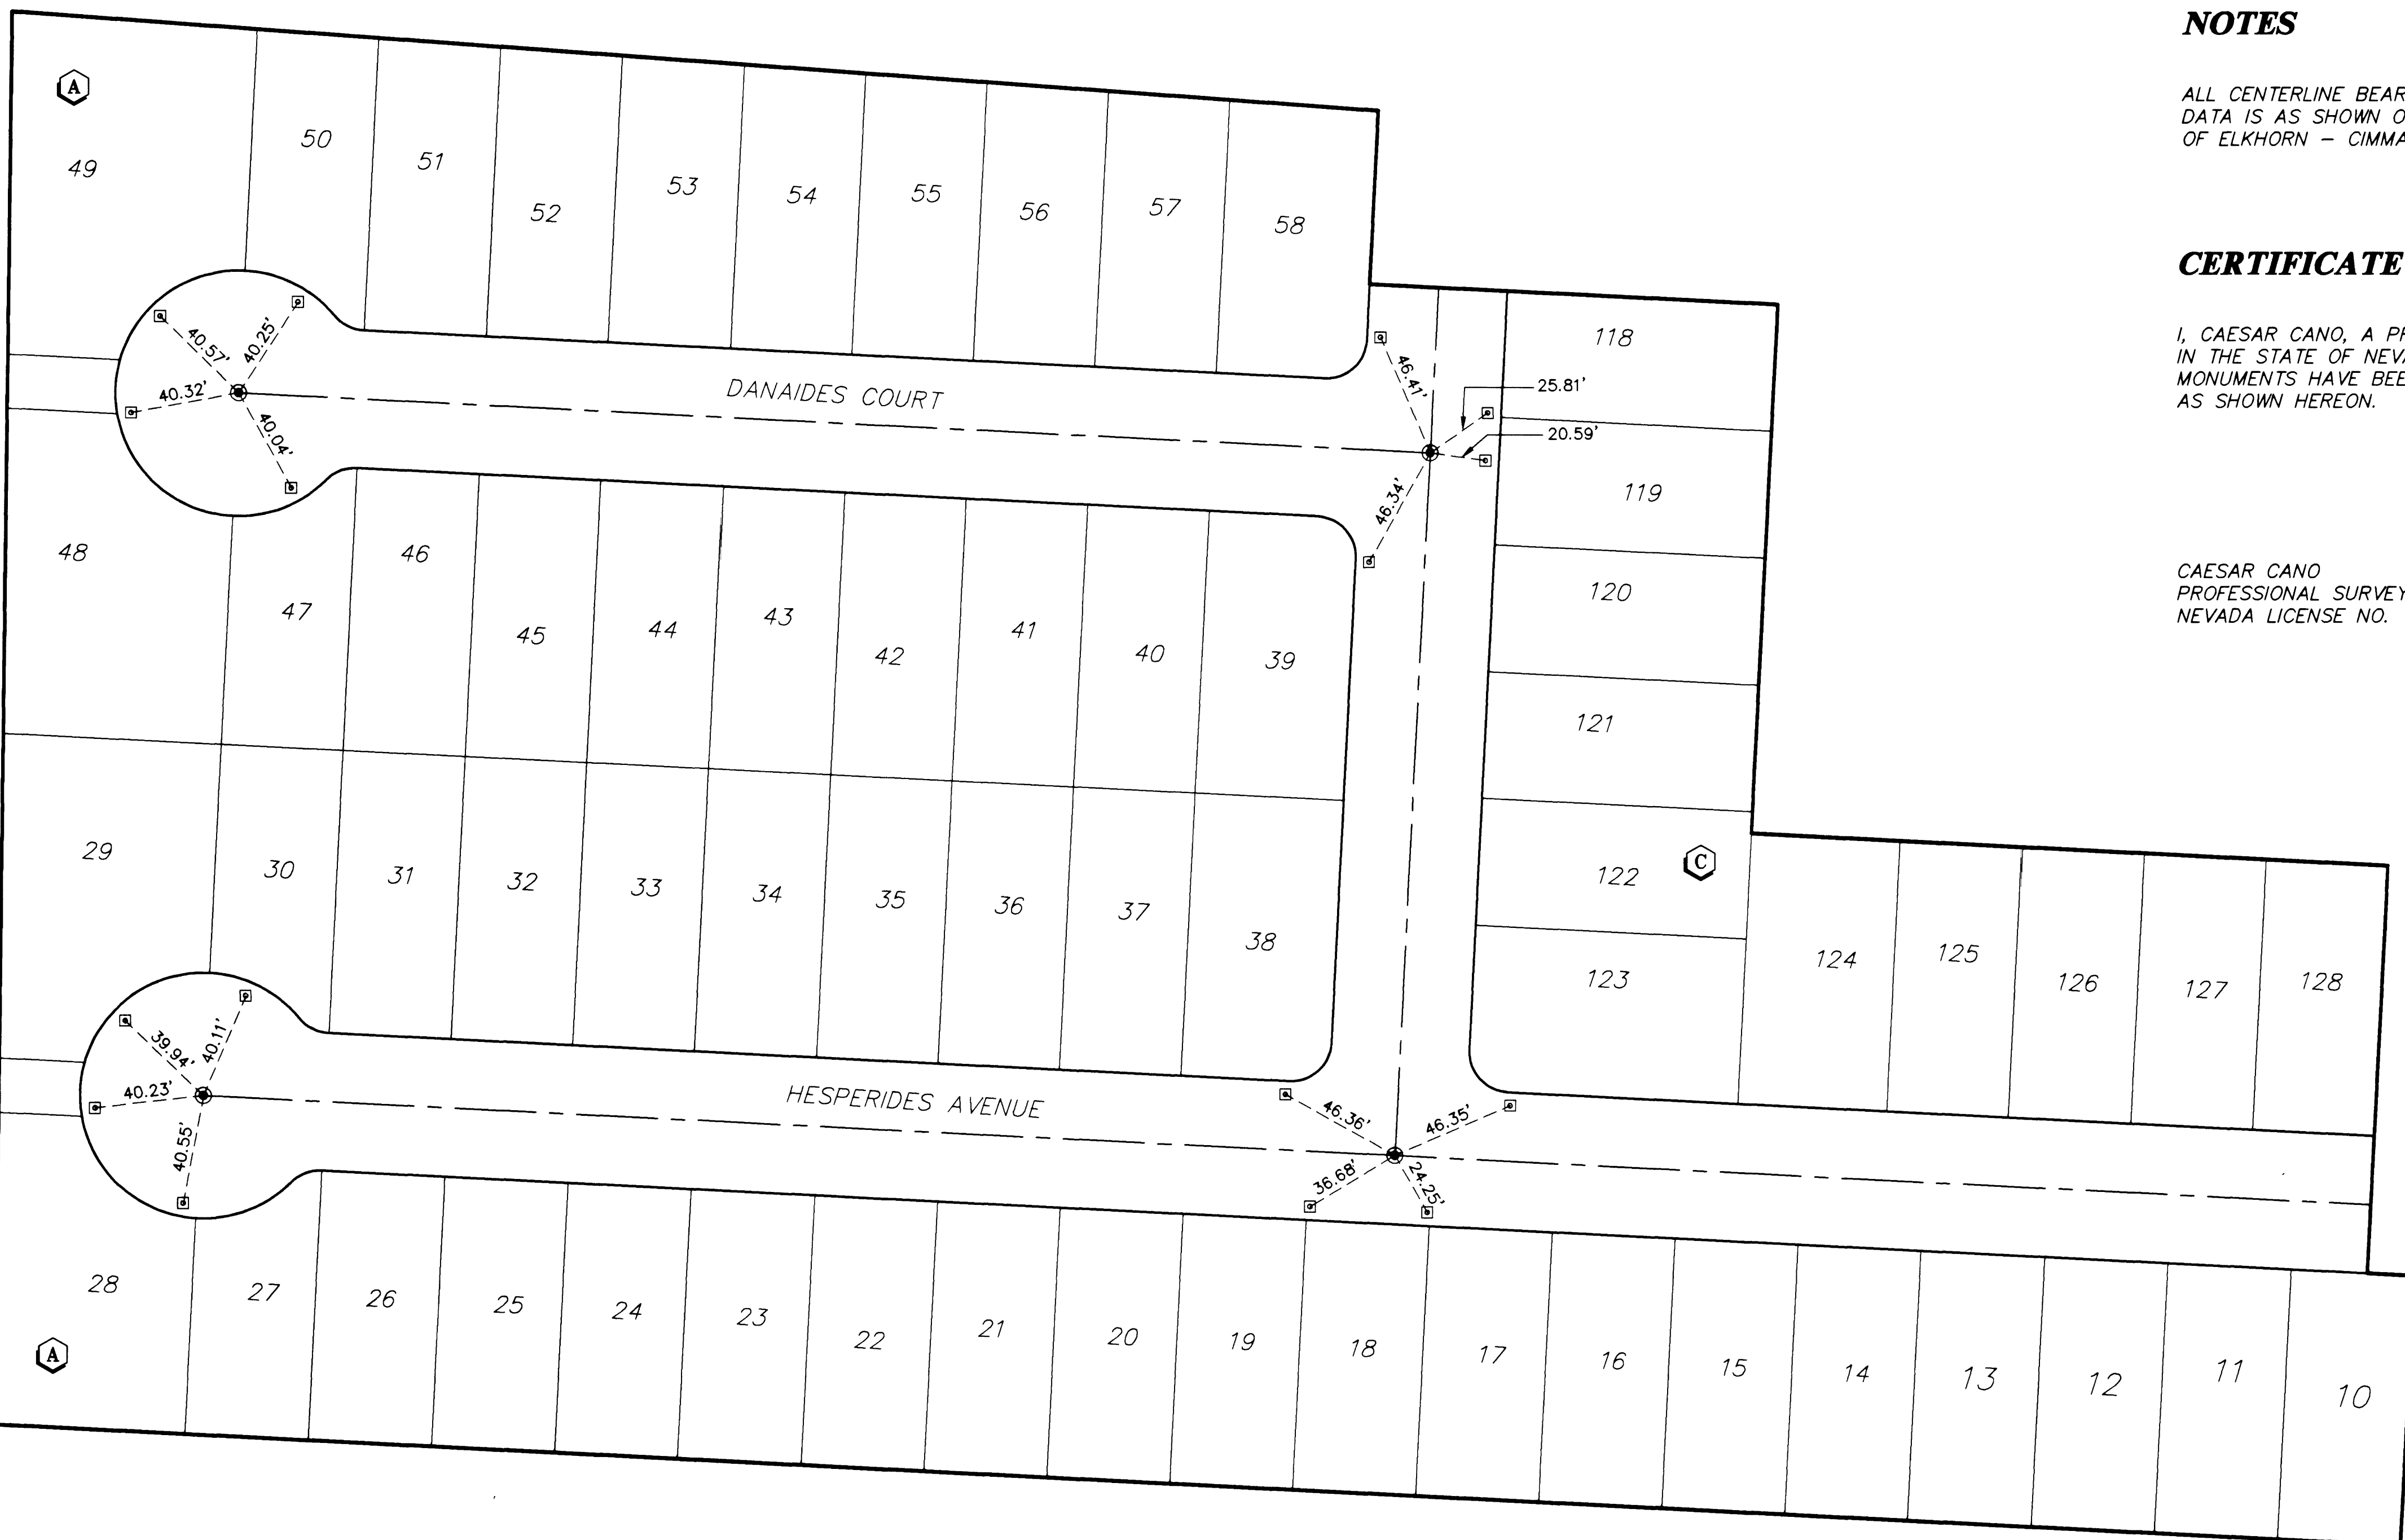

A PORTION OF LOT LD 70-79
BOOK 890324, INST. 01038
NOT A PART

NOTES

ALL CENTERLINE BEARINGS, DISTANCES, AND CURVE DATA IS AS SHOWN ON THE RECORDED FINAL MAP OF ELKHORN - CIMARRON ESTATES UNIT 2-B

CERTIFICATE

I, CAESAR CANO, A PROFESSIONAL LAND SURVEYOR, LICENSED IN THE STATE OF NEVADA, DO HEREBY CERTIFY THAT THE MONUMENTS HAVE BEEN SET AND THE TIES ESTABLISHED AS SHOWN HEREON.

CAESAR CANO
PROFESSIONAL SURVEYOR
NEVADA LICENSE NO. 11175



ELKHORN - CIMARRON ESTATES UNIT 1-B
BOOK 81, PAGE 04 OF PLATS
NOT A PART

DESIGNED BY:	
DRAWN BY:	SCS
CHECKED BY:	C. CANO
PROJECT DATE:	
BY DATE APP. DATE	
REVISION	
1	
2	
ELKHORN - CIMARRON ESTATES
NEVADA
CITY OF LAS VEGAS
MONUMENTATION TIE MAP
ELKHORN - CIMARRON UNIT 2-B
PLATS BK 81, PG 07

DEVELOPER
SEAL

6280 S. Valley View Blvd
Suite 200
Las Vegas, NV 89118
Tel: (702) 368-3008
Fax: (702) 368-0047
CVL
CONSULTANTS, INC.
ENGINEERING · PLANNING · LAND SURVEYING

SHEET
2 OF 2
AGENCY DWG. NO.