
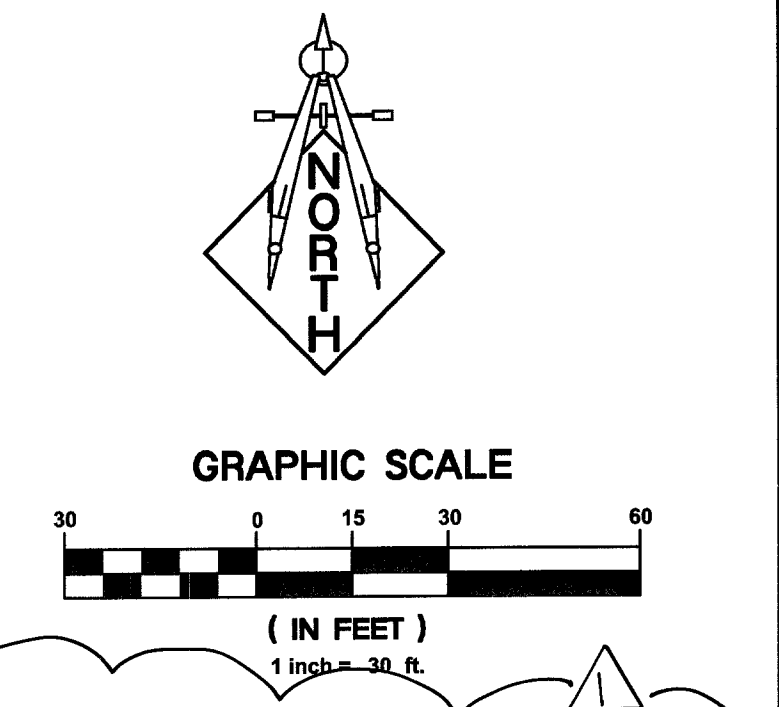
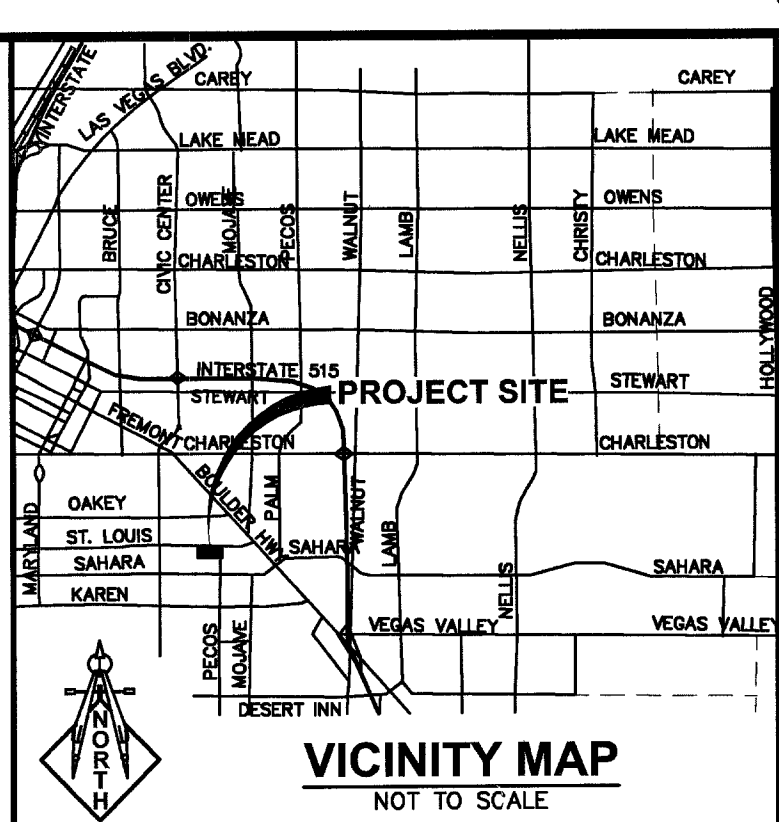


J:\CAD\7112\dwg\7112-602-TC.dwg, 9/23/2005 2:19:39 PM, 1:30, Lochsa Civil

LEGEND	CL OR SURVEY LINE	EASEMENT LINE	HEAVY AC P.W.M.	DESCRIPTION:	CONTOUR LINES	EDGE OF PAVEMENT	"A" TYPE CURBS	"L" TYPE CURBS	WALLS	FENCES	AC PAVEMENT	CONCRETE	SPOT ELEVATIONS	SIGNS	MANHOLE W/ DESCRIPTION	MANHOLE DESCRIPTIONS	FIRE HYDRANTS	GATE VALVES	REDUCERS	CLEAN OUTS	UTILITY BOX OR VAULT	100w HPS STREETLIGHTS	150w HPS STREETLIGHTS	200w HPS STREETLIGHTS	250w HPS STREETLIGHTS
	PROPERTY LINE	SAWCUT LINE	LIGHT AC P.W.M.	EXISTING:	(2210)					X-X-X-X			(12.34) 8C		⊙	⊙ = SANITARY SEWER ⊙ = STORM DRAIN ⊙ = ELECTRICAL ⊙ = TELEPHONE	⊙	⊙	▶	○	□	○	○	○	○
	ROW LINE	SCARP LINE	CONCRETE P.W.M.	PROPOSED:	(2210)					X-X			(12.34) 8C		⊙										

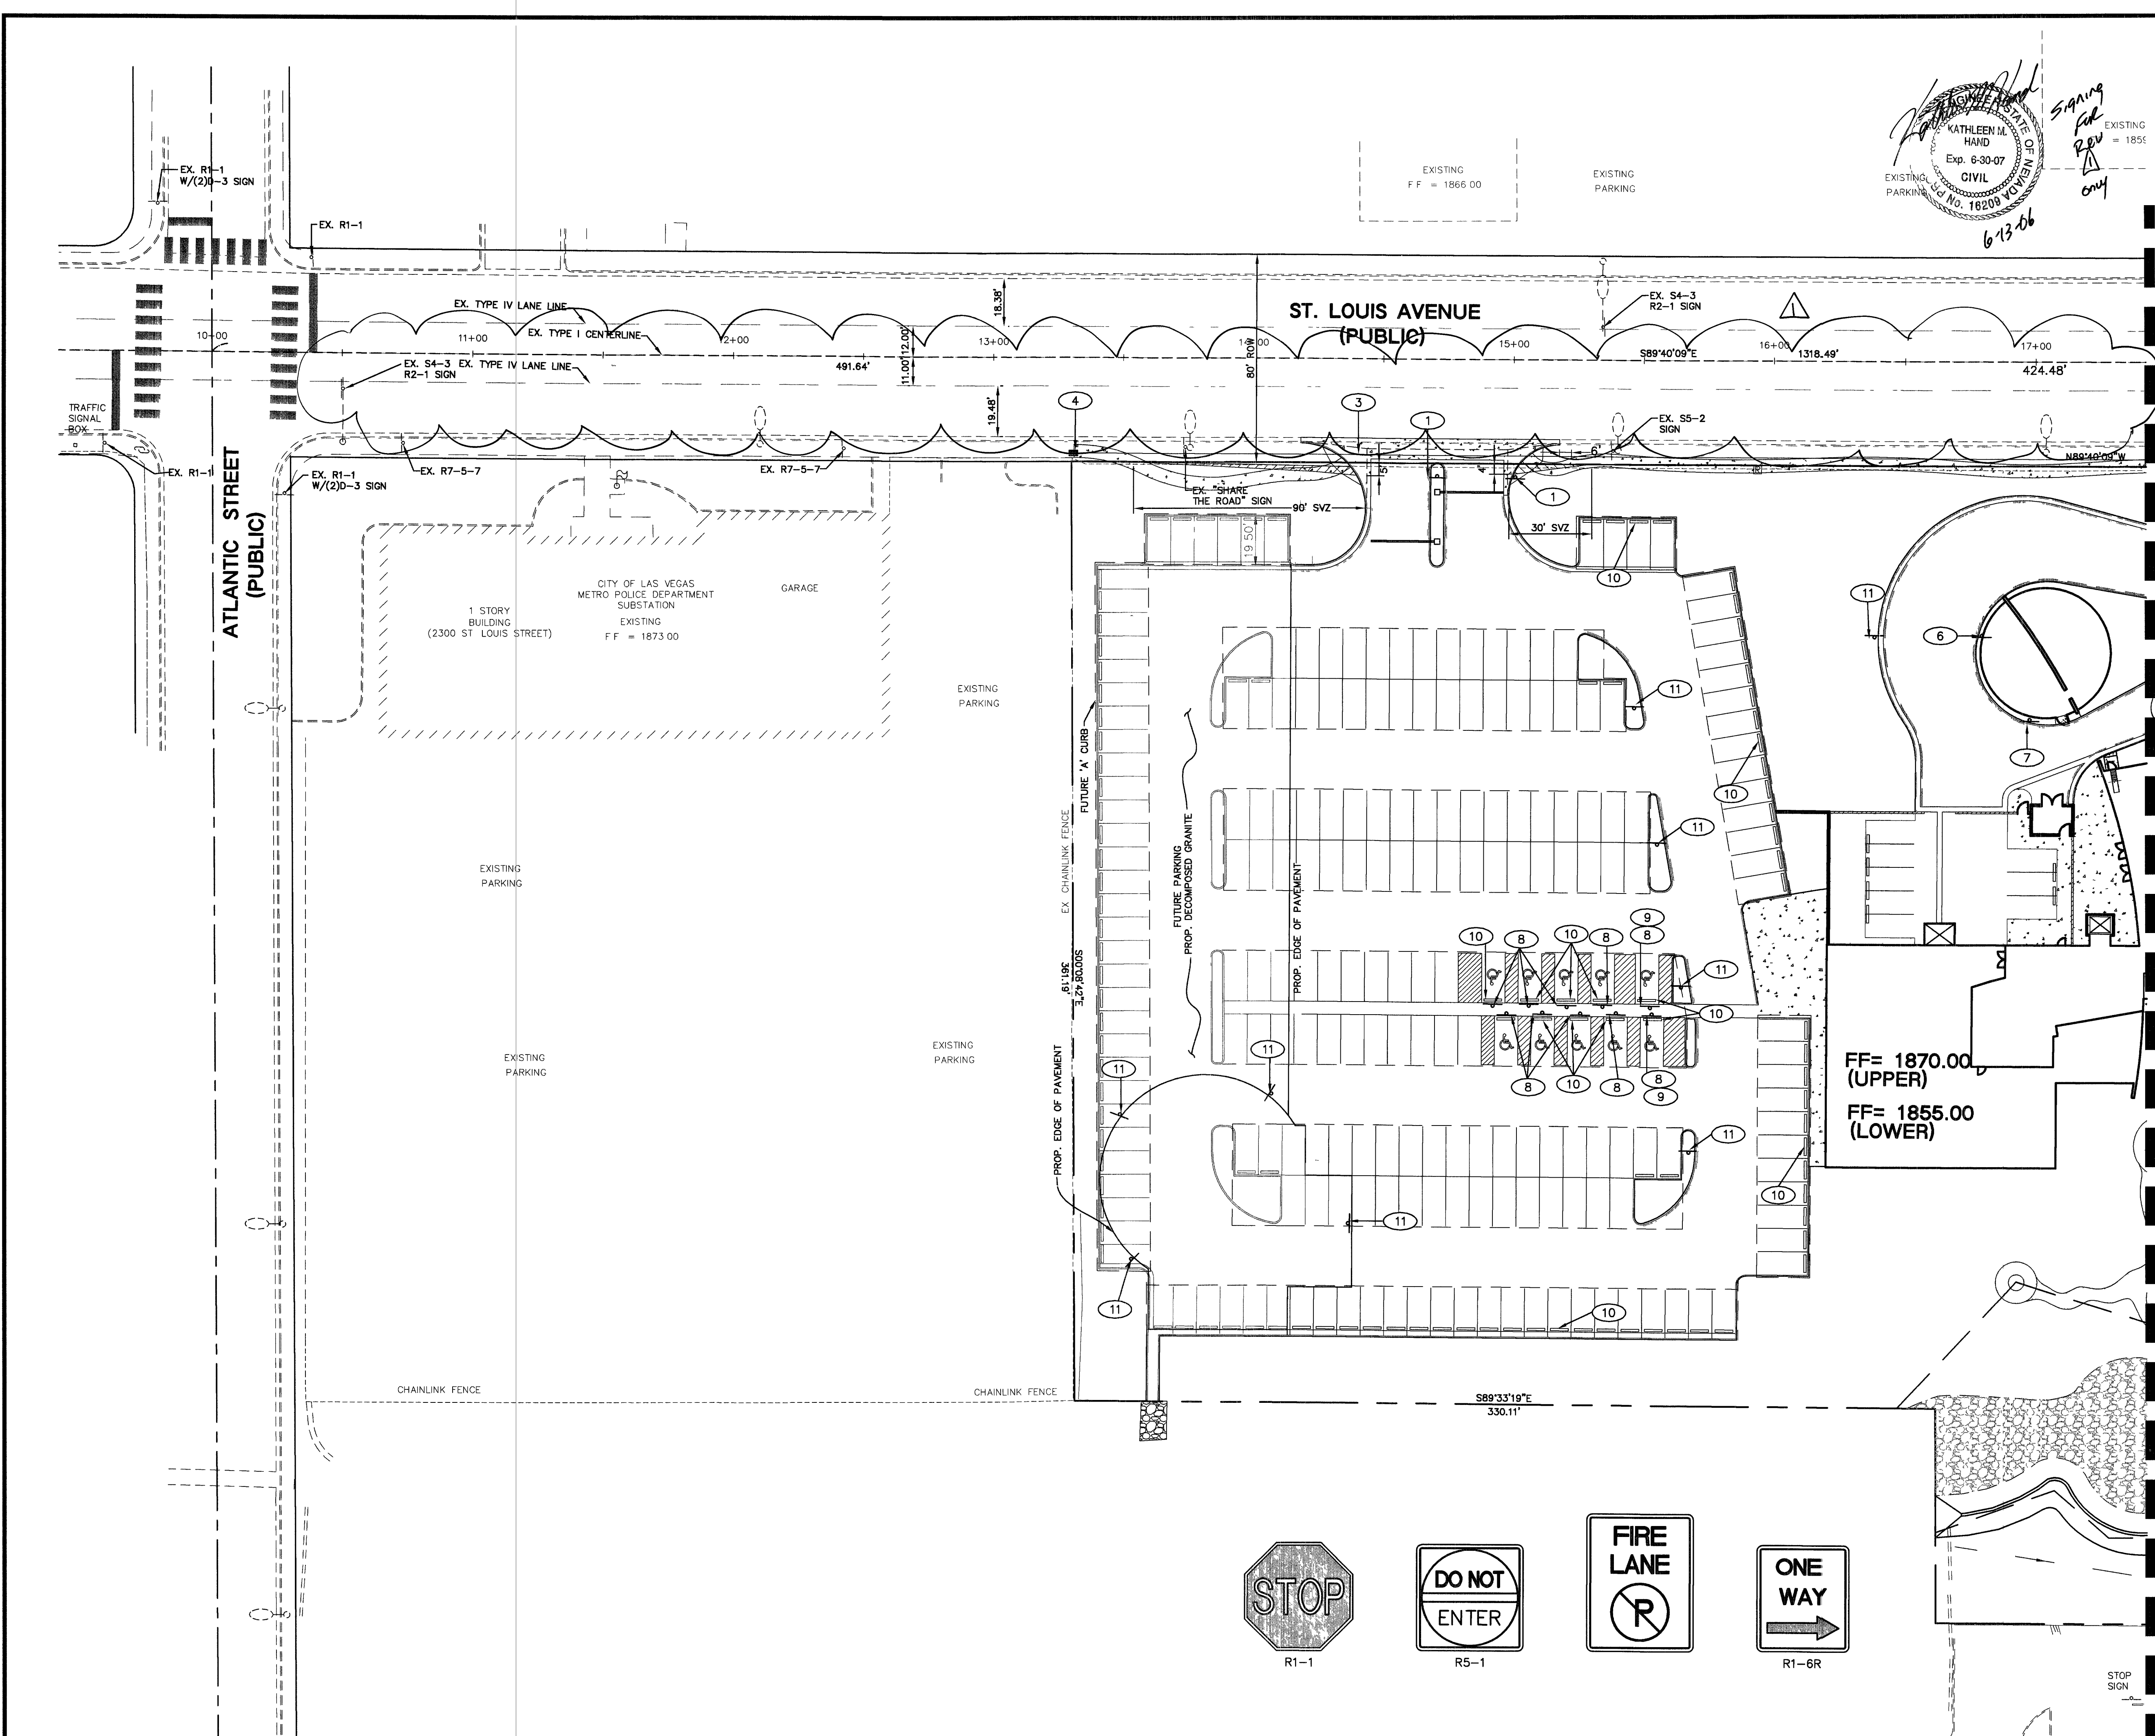

NOTE:
IN THE EVENT THAT EXISTING STRIPING IS OBLITERATED OR DAMAGED DURING THE CONSTRUCTION OF OFF-SITE IMPROVEMENTS, CONTRACTOR SHALL BE RESPONSIBLE FOR REPLACING THE STRIPING.

TRAFFIC CONTROL NOTES:

1. INSTALL 30" R1-1 "STOP" SIGN
2. INSTALL 2" PVC F.A.S.T. CONDUIT W/ #8 BARE OR GREEN CONDUCTORS PER C.C.U.S.S. 6236.03.01
3. INSTALL 3" PVC F.A.S.T. CONDUIT W/ #8 BARE OR GREEN CONDUCTORS PER C.C.U.S.S. 6236.03.01
4. INSTALL "P30" PULLBOX W/ "FIBER OPTIC" INSCRIBED ON LID PER C.C.U.S.S. 6236.03.01
5. INSTALL "TYPE 200" SPLICE VAULT W/ "FIBER OPTIC" INSCRIBED ON LID PER C.C.U.S.S. 6236.03.01
6. INSTALL R5-1 "DO NOT ENTER" SIGN
7. INSTALL R1-6R "ONEWAY" SIGN
8. INSTALL R7-8 "HANDICAP" SIGN
9. INSTALL R7-8P5 "VAN ACCESSIBLE" SIGN
10. INSTALL PRECAST BUMPER BLOCK PER C.C.A.U.S.D. DWG. # 238
11. INSTALL "FIRE LANE-NO PARKING" SIGN

NOTE:
LOCHSA ENGINEERING ASSUMES NO RESPONSIBILITY FOR EXISTING UTILITY LOCATIONS AND ELEVATIONS. THE UTILITIES SHOWN ON THIS PLAN ARE FROM THE BEST AVAILABLE INFORMATION. IT IS THE CONTRACTOR'S RESPONSIBILITY TO FIELD VERIFY THE LOCATION AND ELEVATION OF ALL UTILITIES, INCLUDING BUT NOT LIMITED TO, THE WATER, FIRE, SANITARY SEWER, STORM SEWER, TELEPHONE, POWER, GAS, AND IRRIGATION LINES PRIOR TO THE COMMENCEMENT OF CONSTRUCTION. IF CONFLICT EXISTS IN THE FIELD, THE CONTRACTOR IS TO NOTIFY THE PROJECT ARCHITECT, OWNER'S REPRESENTATIVE AND THE PROJECT ENGINEER IMMEDIATELY.

A.P.N.:
162-01-402-006

BASIS OF BEARINGS:
THE BASIS OF BEARINGS FOR THIS SURVEY IN THE NORTH LINE OF THE SOUTHEAST QUARTER (SE 1/4) OF THE SOUTHWEST QUARTER (SW 1/4) OF SECTION 1, TOWNSHIP 21 SOUTH, RANGE 61 EAST, M.D.M., CITY OF LAS VEGAS, CLARK COUNTY, NEVADA, AS SHOWN BY THAT RECORD OF SURVEY ON FILE IN FILE 09 OF SURVEYS, PAGE 06 IN THE CLARK COUNTY RECORDER'S OFFICE, CLARK COUNTY, NEVADA.

SAID LINE BEARS NORTH 89°40'09" WEST.

BENCHMARK:
CLV BM 6C11 154
BEING A RIVET AND PLATE IN TOP OF CURB @ NE CORNER OF SAHARA AND MCLEOD
ELEVATION: 1853.32 FEET / 564.8927 METERS
(NAVD '88 DATUM)

Avoid cutting underground utility lines. It's costly.

SAFETY ALERT
Call before you Dig
1-800-227-2600
Call before you Overheat
1-702-227-2929

		SHEET No C6.02 SHEET 10 of 16		DRAWING No 102-4481	
PROJECT No. 7112		SCALE 1"=30'		DATE 08-15-05	
PROJECT No. 7112		DATE 07/20/05		DATE 07/20/05	
CHECKED BY EZ		DATE 07/20/05		DATE 07/20/05	
DESIGNED BY EZ		DATE 07/20/05		DATE 07/20/05	
SSY		DATE 07/20/05		DATE 07/20/05	
DRAWN BY		DATE 07/20/05		DATE 07/20/05	
SHEET		DATE 07/20/05		DATE 07/20/05	
TITLE STATE OF NEVADA-SPWB#01-E01		DATE 07/20/05		DATE 07/20/05	
TRAFFIC CONTROL, SIGNAGE AND STRIPING		DATE 07/20/05		DATE 07/20/05	
		DATE 07/20/05		DATE 07/20/05	
LOCHSA ENGINEERING		DATE 07/20/05		DATE 07/20/05	
6345 SOUTH JONES BOULEVARD, SUITE 100 LAS VEGAS, NV 89118 PHONE: (702) 365-9312, FAX: (702) 365-9317		DATE 07/20/05		DATE 07/20/05	
REV		DATE		BY	
DESCRIPTION		DATE		BY	
PHASE II CONSTRUCTION FOR IMPROVEMENTS		DATE		BY	
ON ST. LOUIS & McLEOD ST.		DATE		BY	
△		DATE		BY	