


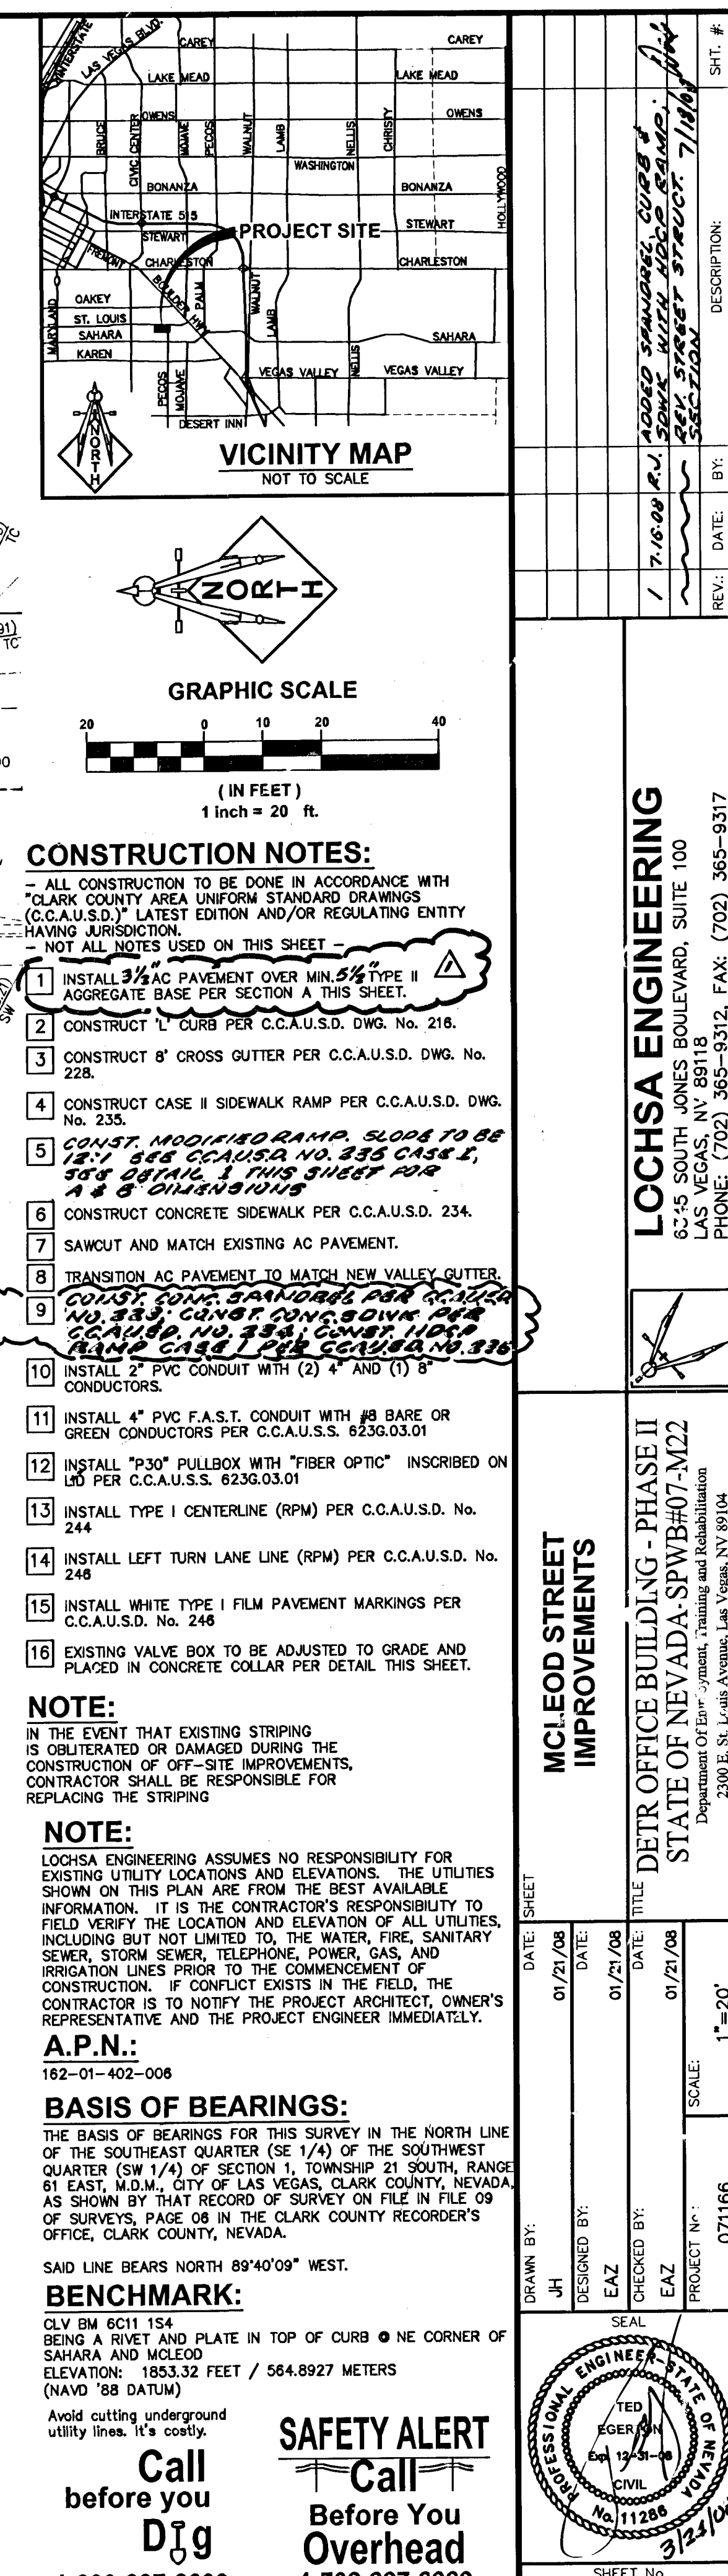

1-800-227-2600																									1-800-227-2929					C3.01	
CONTRACTOR TO ENSURE BASE IS A MINIMUM OF 4".																															
LEGEND	CL OR SURVEY LINE	EASEMENT LINE	HEAVY AC P.V.M.T.	DESCRIPTION:	CONTOUR LINES	EDGE OF PAVEMENT	"A" TYPE CURBS	"L" TYPE CURBS	WALLS	FENCES	AC PAVEMENT	CONCRETE	SPOT ELEVATIONS	SIGNS	MANHOLE W/ DESCRIPTION	MANHOLE DESCRIPTIONS	FIRE HYDRANTS	GATE VALVES	REDUCERS	CLEAN OUTS	UTILITY BOX OR VAULT	100w HPS STREETLIGHTS	150w HPS STREETLIGHTS	200w HPS STREETLIGHTS	250w HPS STREETLIGHTS	SHEET 4 OF 4					
	PROPERTY LINE	SAWTOOTH LINE	LIGHT AC P.V.M.T.	EXISTING:	(2210)								(12.34) BC		⑤	① = SANITATION ② = STORM DRAIN ③ = ELECTRICAL ④ = TELEPHONE	☼	⊗	▶	○	□	○	○	○	○	CLV DRAWING NO. 26202					
	ROW LINE	SCARP LINE	CONCRETE P.V.M.T.	PROPOSED:	(2210)								(12.34) BC		⑤		☼	⊗	▶	○	□	○	○	○	○	2					