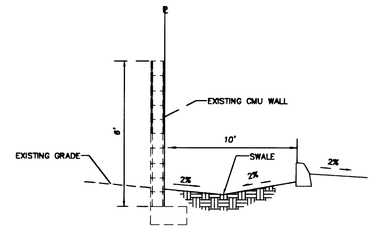

A EXISTING CMU WALL
SEE DETAIL F
N.T.S.

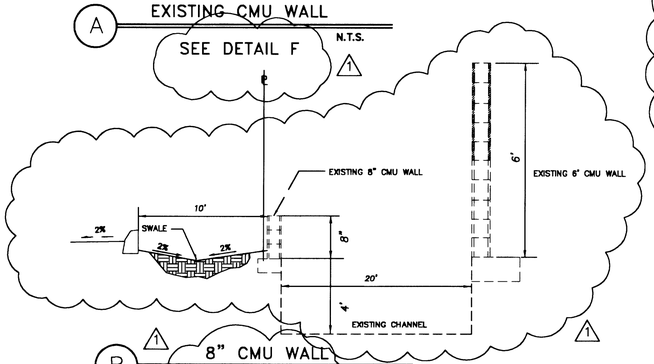

B 8" CMU WALL
SEE DETAIL F
N.T.S.

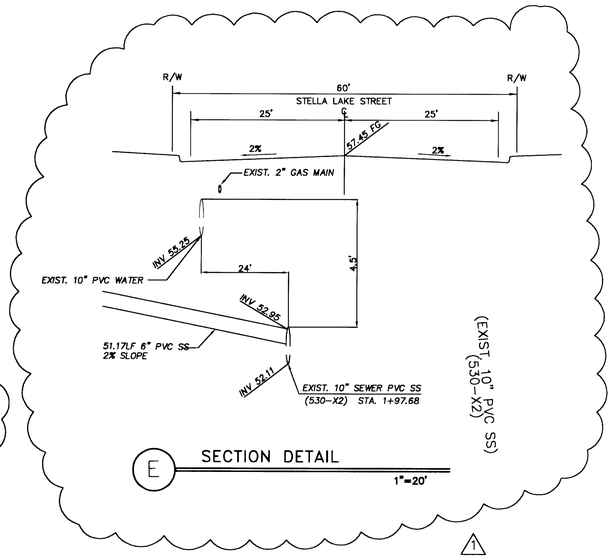

E SECTION DETAIL
1"=20'

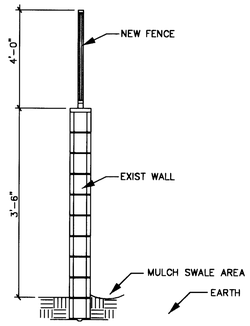

F FENCE
ABOVE WALL DETAIL
SCALE: NOT TO SCALE

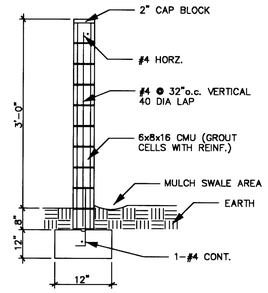

EXISTING PERIMETER
WALL DETAIL
SCALE: NOT TO SCALE

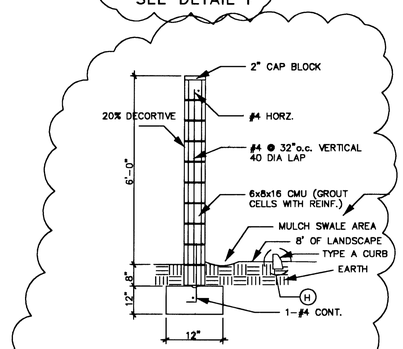

PROPOSED PERIMETER
WALL DETAIL
C SCALE: NOT TO SCALE

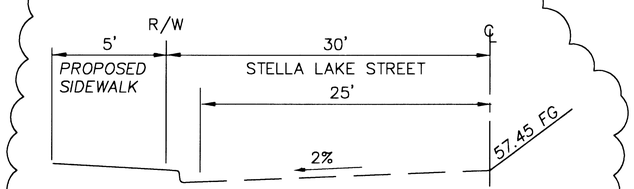

D SECTION DETAIL
1"=20'

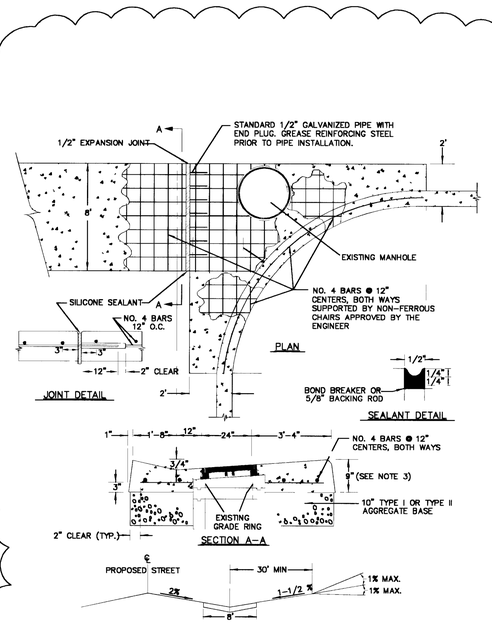

G MODIFIED #228
1"=20'

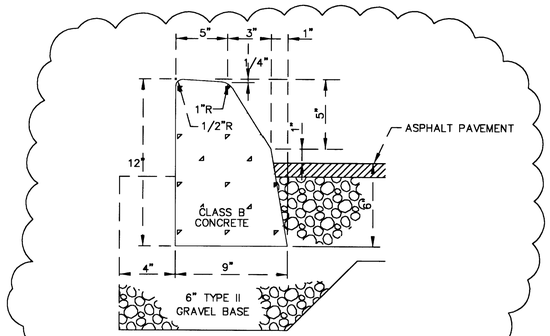

H MODIFIED "A" TYPE CURB
ON SITE ONLY
N.T.S.

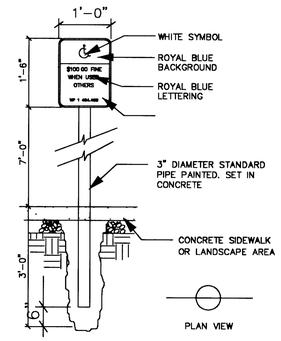

DISABLED
PARKING SIGN
SCALE: NOT TO SCALE

APPROVED FOR CONSTRUCTION

LAS VEGAS VALLEY WATER DISTRICT — DATE 2-24-06
PROJECT # 111844 — SHEETS C1.01. C1.02, C1.04, C1.05 — ESN.018

Call before you UnderGround
1-702-455-7511
1-702-229-6611

AVOID HITTING OVERHEAD POWER LINES. ITS COSTLY
CALL BEFORE YOU DO OVERHEAD
1-702-227-2929

Call Before You Dig.
1-800-227-2600
AVOID DAMAGING UTILITY LINES. ITS COSTLY

NO.	DESCRIPTION	DRAWN BY	APPROVAL	DATE
1	Add Drainage Modifications Remove Details	KC		3/7/06

SCALE (H): 1" = 30'
SCALE (V): N/A
DRAWN BY: R. WONDERS
SEC 21, T 20 S, R 16 E, M.D.M.

DETAIL SHEET
EXPERTISE BEAUTY SCHOOL
EARNEST PATTON P.E. CIVIL ENGINEERING
CITY OF LAS VEGAS — CLARK COUNTY — NEVADA

PROFESSIONAL ENGINEER - STATE OF NEVADA
EARNEST PATTON
No 13211
CIVIL
Exp 12/31/07

DWG: BEAUTY SCHOOL
DATE: 02/06/06
JOB NUMBER 012005
SHEET C1.05

88712 11 111441