




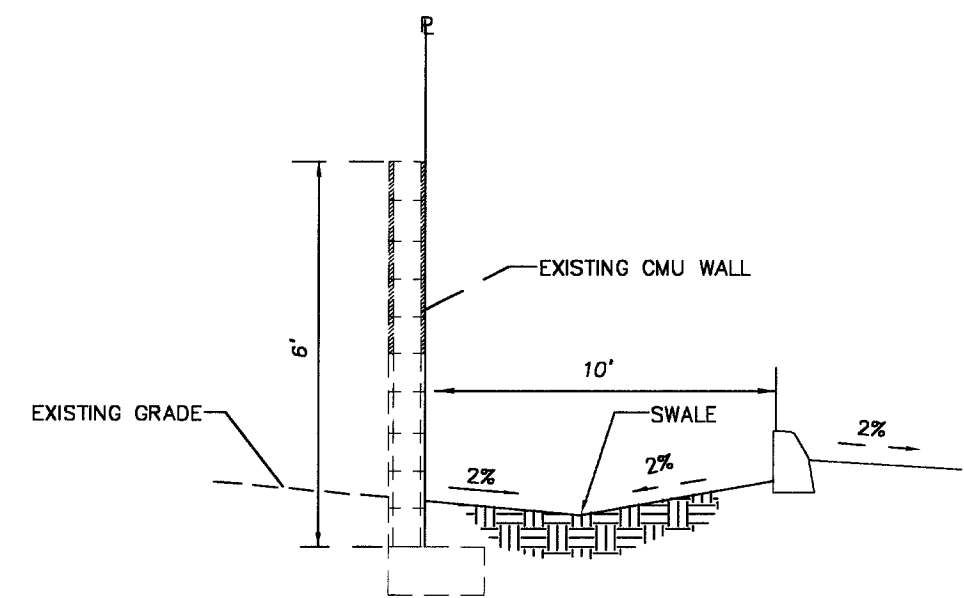


A EXISTING CMU WALL
SEE DETAIL F
N.T.S.

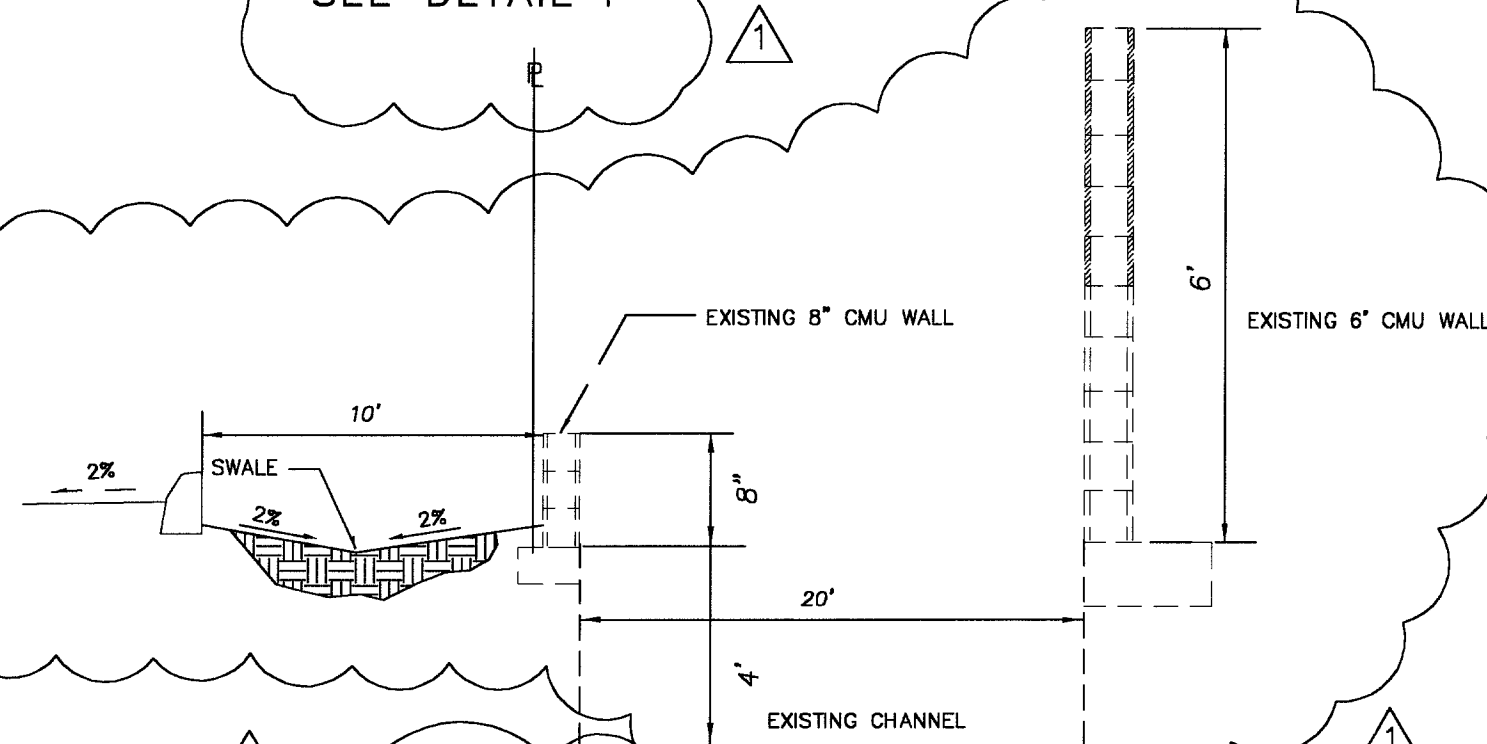


B 8" CMU WALL
SEE DETAIL F
N.T.S.

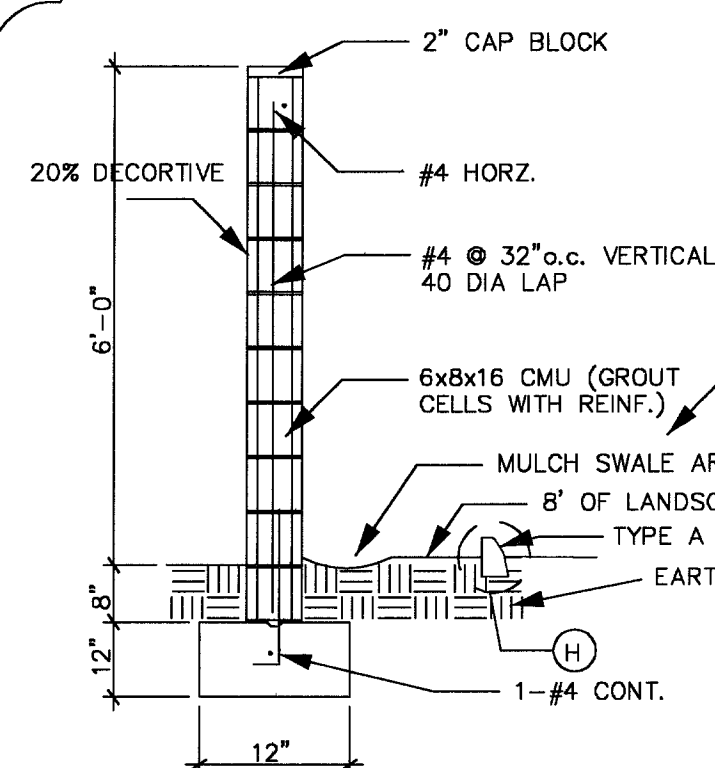


C PROPOSED PERIMETER WALL DETAIL
SCALE: NOT TO SCALE

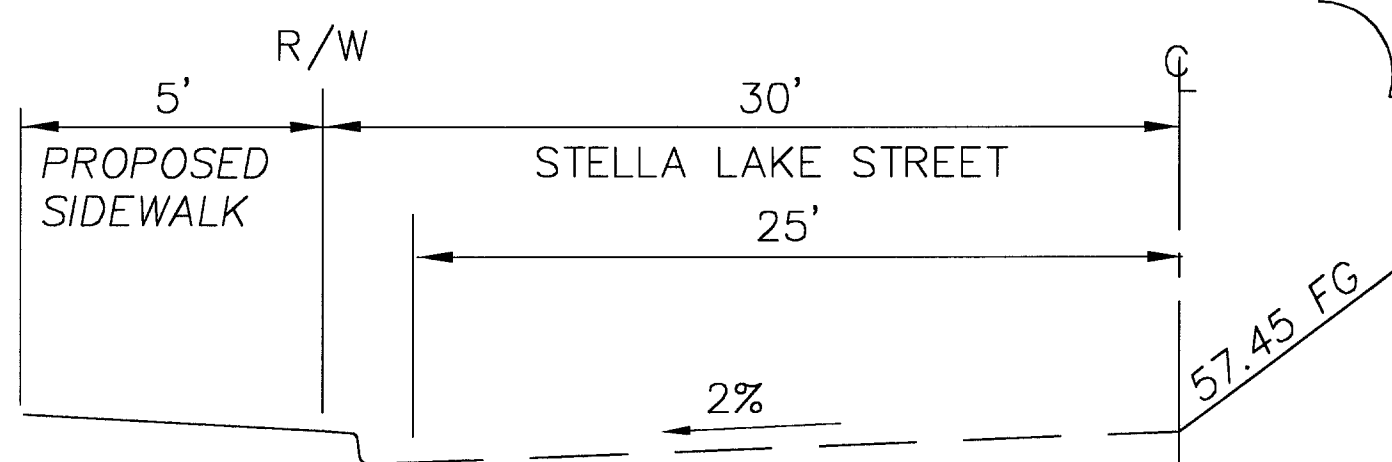


D SECTION DETAIL
1"=20'

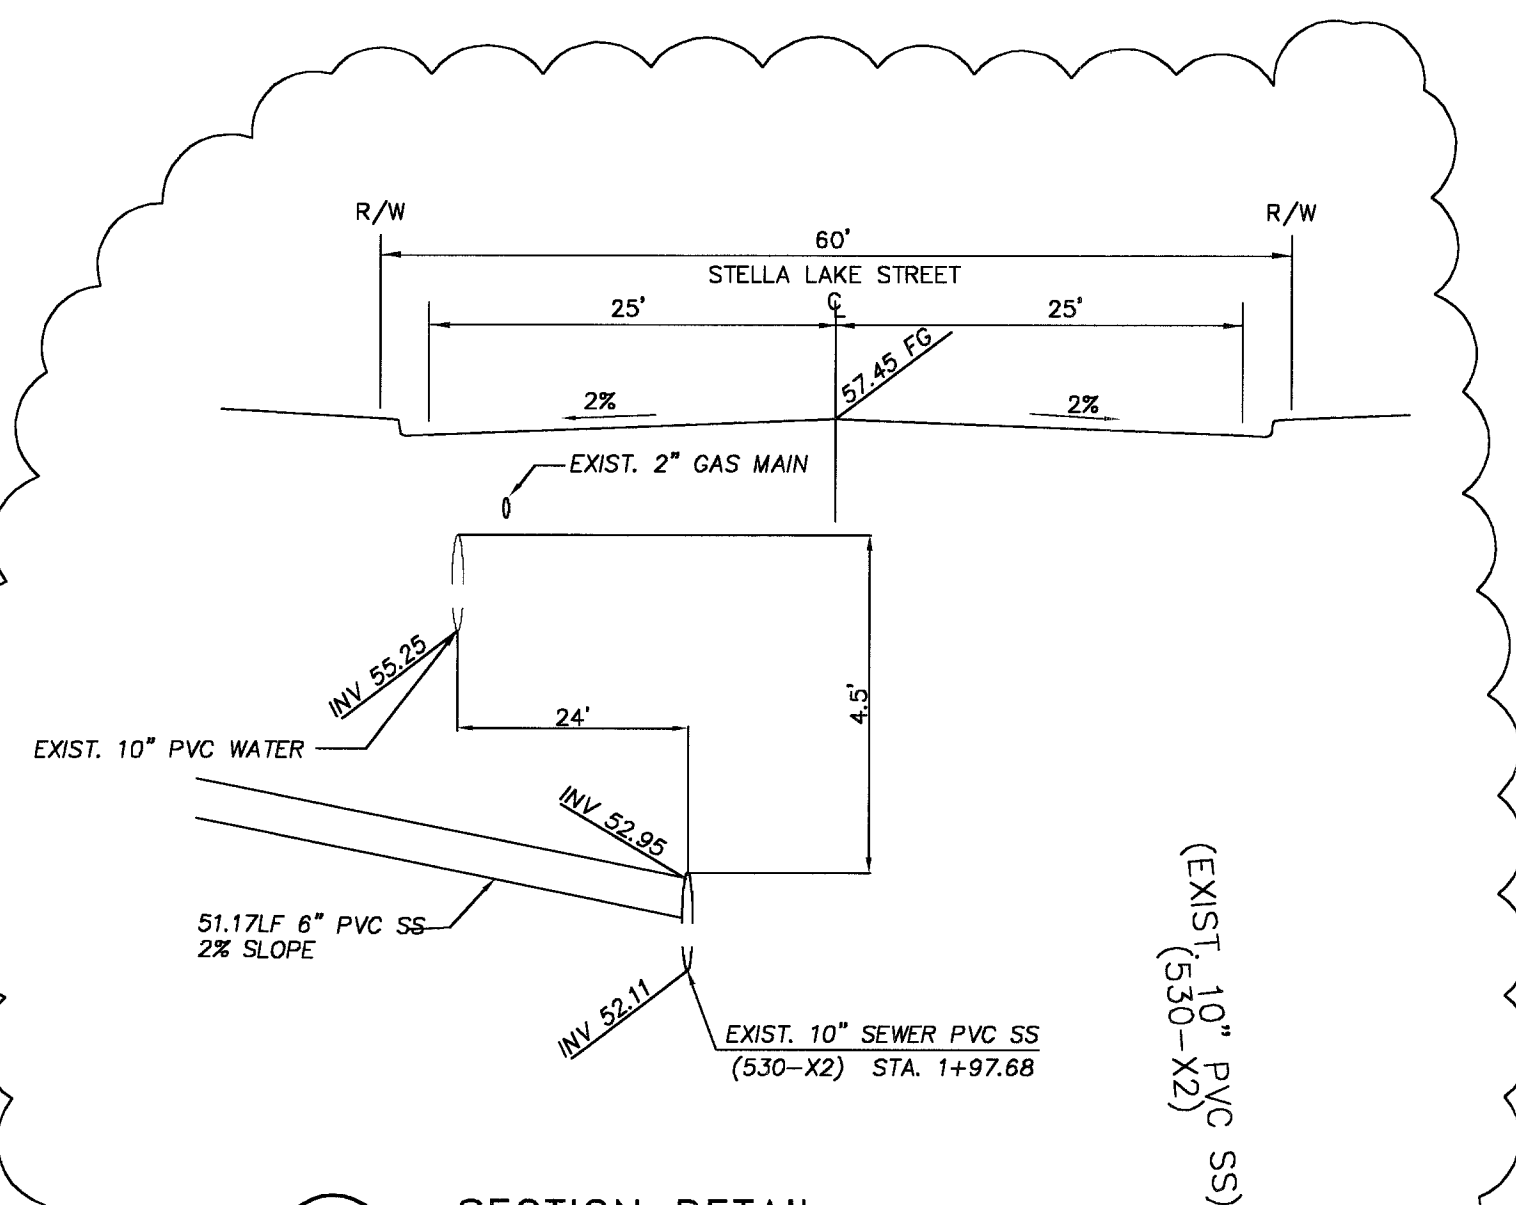


E SECTION DETAIL
1"=20'

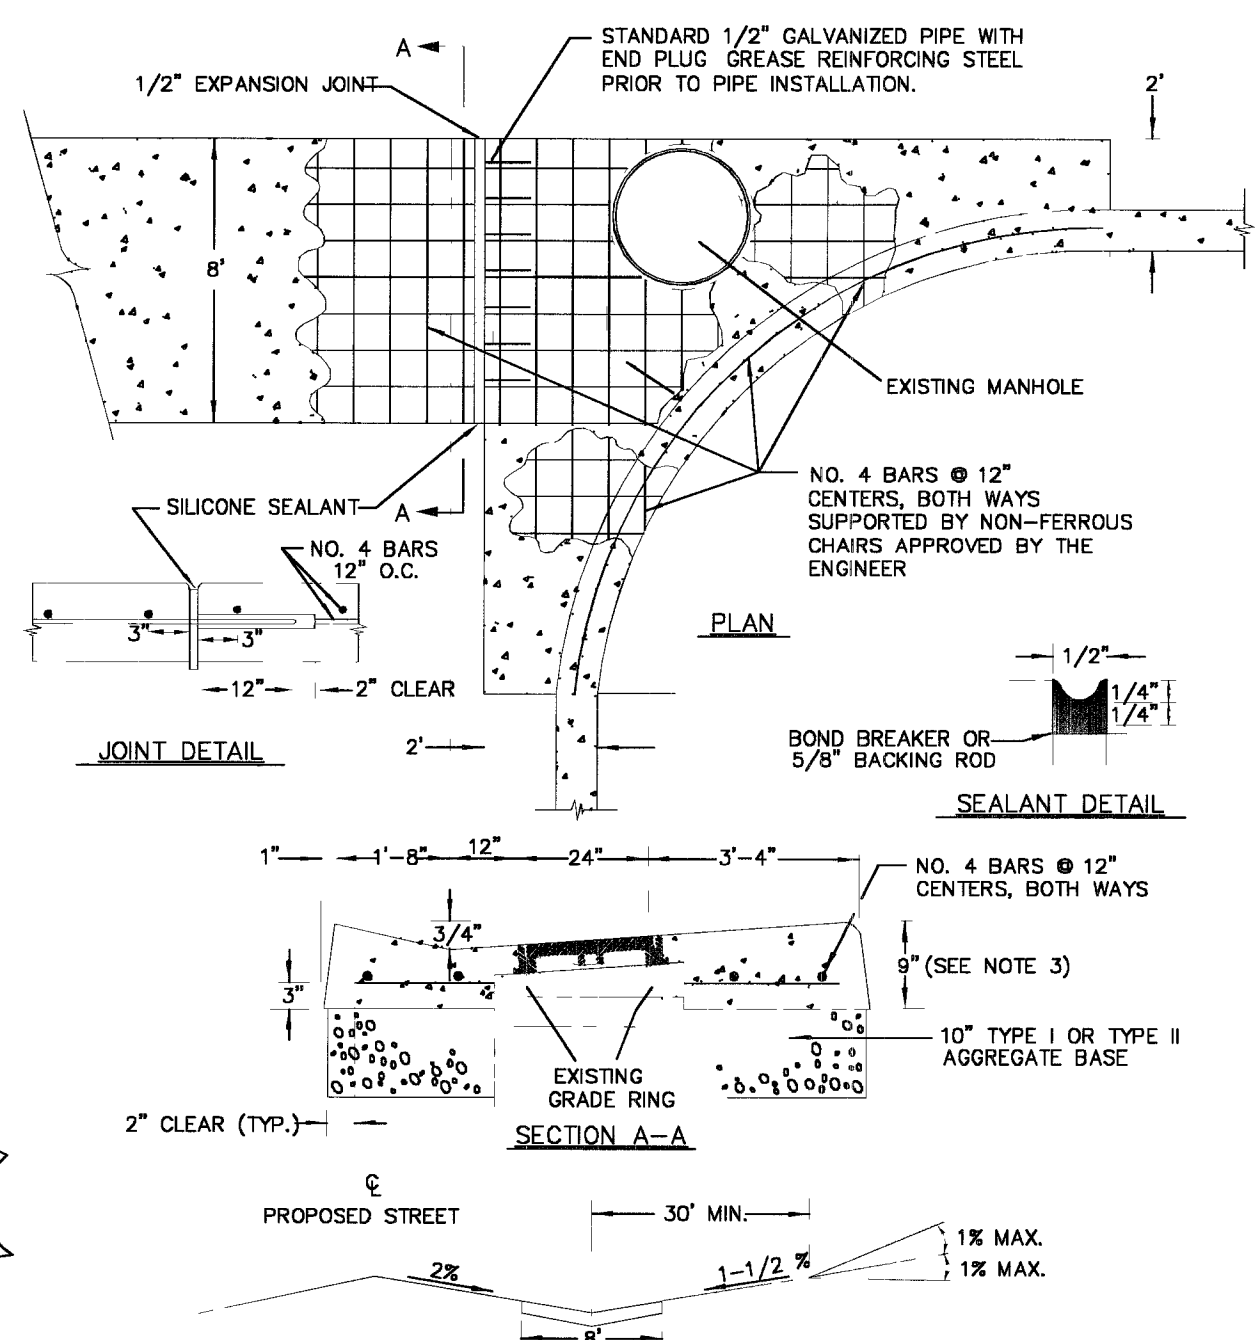


G MODIFIED #228
1"=20'

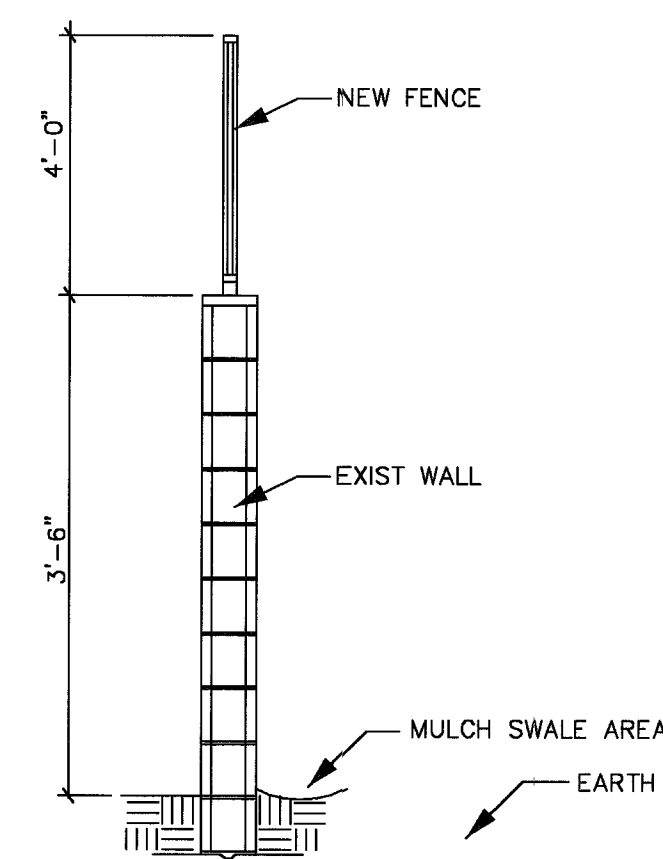


F FENCE ABOVE WALL DETAIL
SCALE: NOT TO SCALE

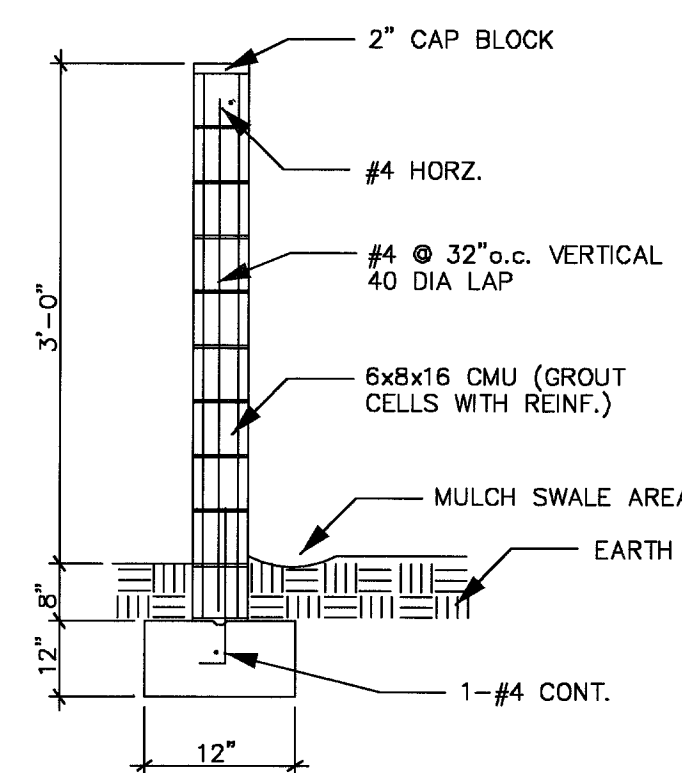

H EXISTING PERIMETER WALL DETAIL
SCALE: NOT TO SCALE

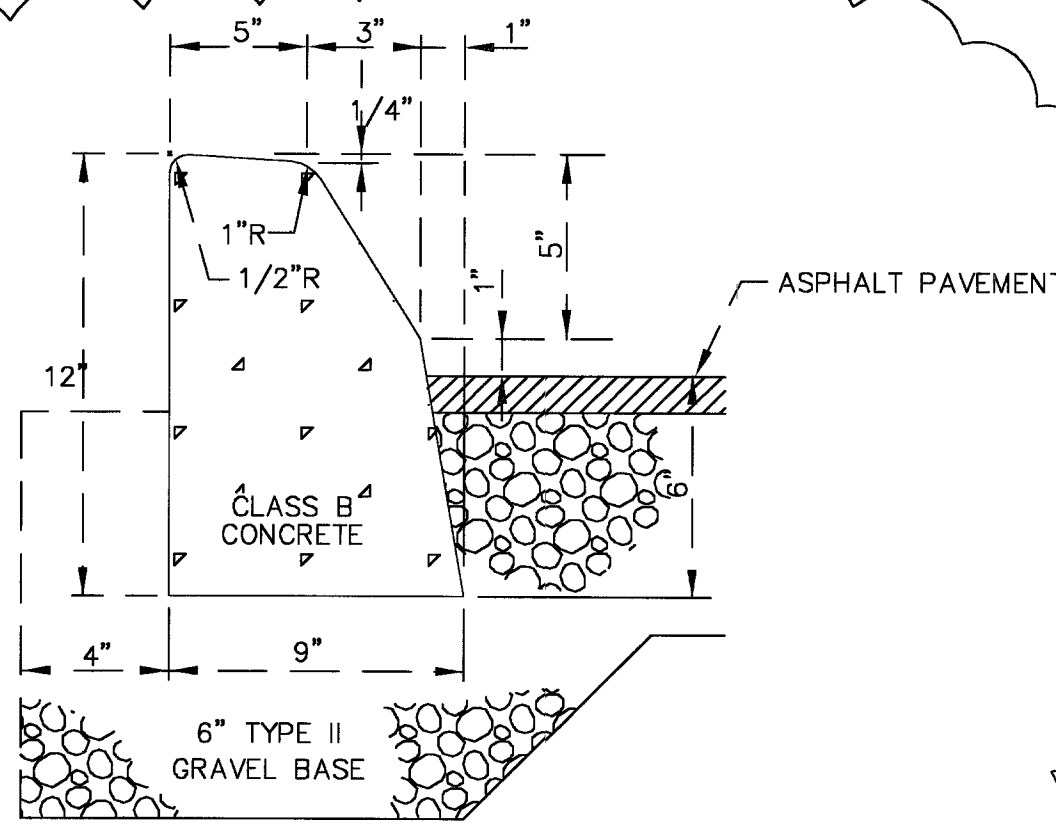


H MODIFIED "A" TYPE CURB ON SITE ONLY
N.T.S.

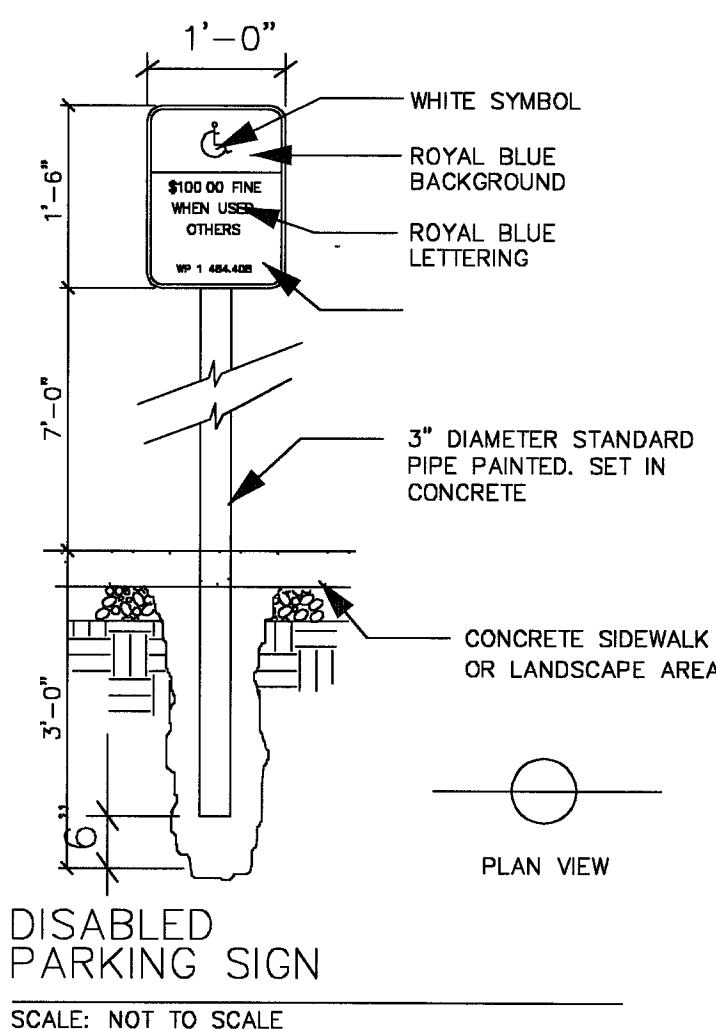


I DISABLED PARKING SIGN
SCALE: NOT TO SCALE

APPROVED FOR CONSTRUCTION

[Signature] 2-24-06
LAS VEGAS VALLEY WATER DISTRICT DATE ESN.018
PROJECT # 111844 SHEETS C1.01, C1.02, C1.04, C1.05

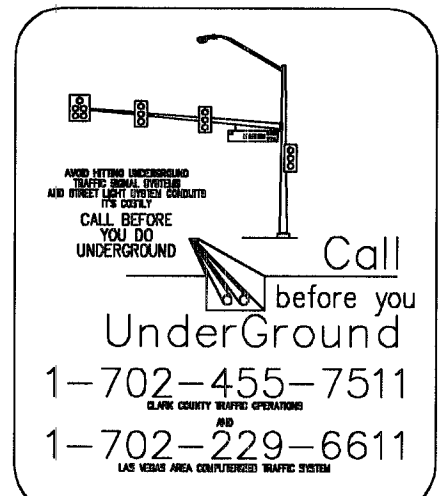

Call Before You Dig.
1-800-227-2600
AVOID DAMAGING UTILITY LINES. ITS COSTLY

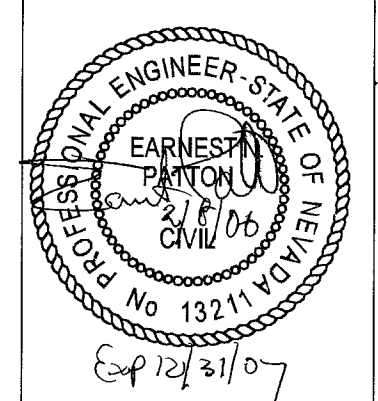

DWG: BEAUTY SCHOOL
DATE: 02/06/06
JOB NUMBER 012005
SHEET C1.05

SCALE (H):	1" = 30'
SCALE (V):	N/A
DRAWN BY:	R. WONDERS
SEC 21, T 20 S, R 16 E, M.D.M.	
DATE	3/7/06
APPROVED	<i>[Signature]</i>

DETAIL SHEET
EXPERTISE BEAUTY SCHOOL
EARNEST PATTON P.E. CIVIL ENGINEERING
CITY OF LAS VEGAS
CLARK COUNTY
NEVADA