



BASIS OF BEARINGS

THE BASIS OF BEARINGS FOR THIS SURVEY IS THE NORTH LINE OF THE NORTHEAST QUARTER (NE 1/4) OF THE NORTHWEST QUARTER (NW 1/4) OF SECTION 21, TOWNSHIP 20 SOUTH, RANGE 61 EAST, M.D.M., CITY OF LAS VEGAS, CLARK COUNTY, NEVADA, AS SHOWN BY THAT MAP ON FILE IN FILE 05 OF PARCEL MAPS, PAGE 94 IN THE CLARK COUNTY RECORDER'S OFFICE, CLARK COUNTY, NEVADA.

SAID LINE BEARS NORTH 89°15'24" EAST.

RECORD OF SURVEY
MONUMENT TIE MAP
OF

EARLY CHILDHOOD DEVELOPMENT
PARCEL 1 AS SHOWN BY THAT MAP ON FILE IN FILE 110 OF PARCEL
MAPS, PAGE 33 IN THE CLARK COUNTY RECORDER'S OFFICE, CLARK
COUNTY, NEVADA, LYING WITHIN THE NORTHWEST QUARTER (NW 1/4) OF
SECTION 21, TOWNSHIP 20 SOUTH, RANGE 61 EAST, M.D.M., CITY OF LAS
VEGAS, CLARK COUNTY, NEVADA.

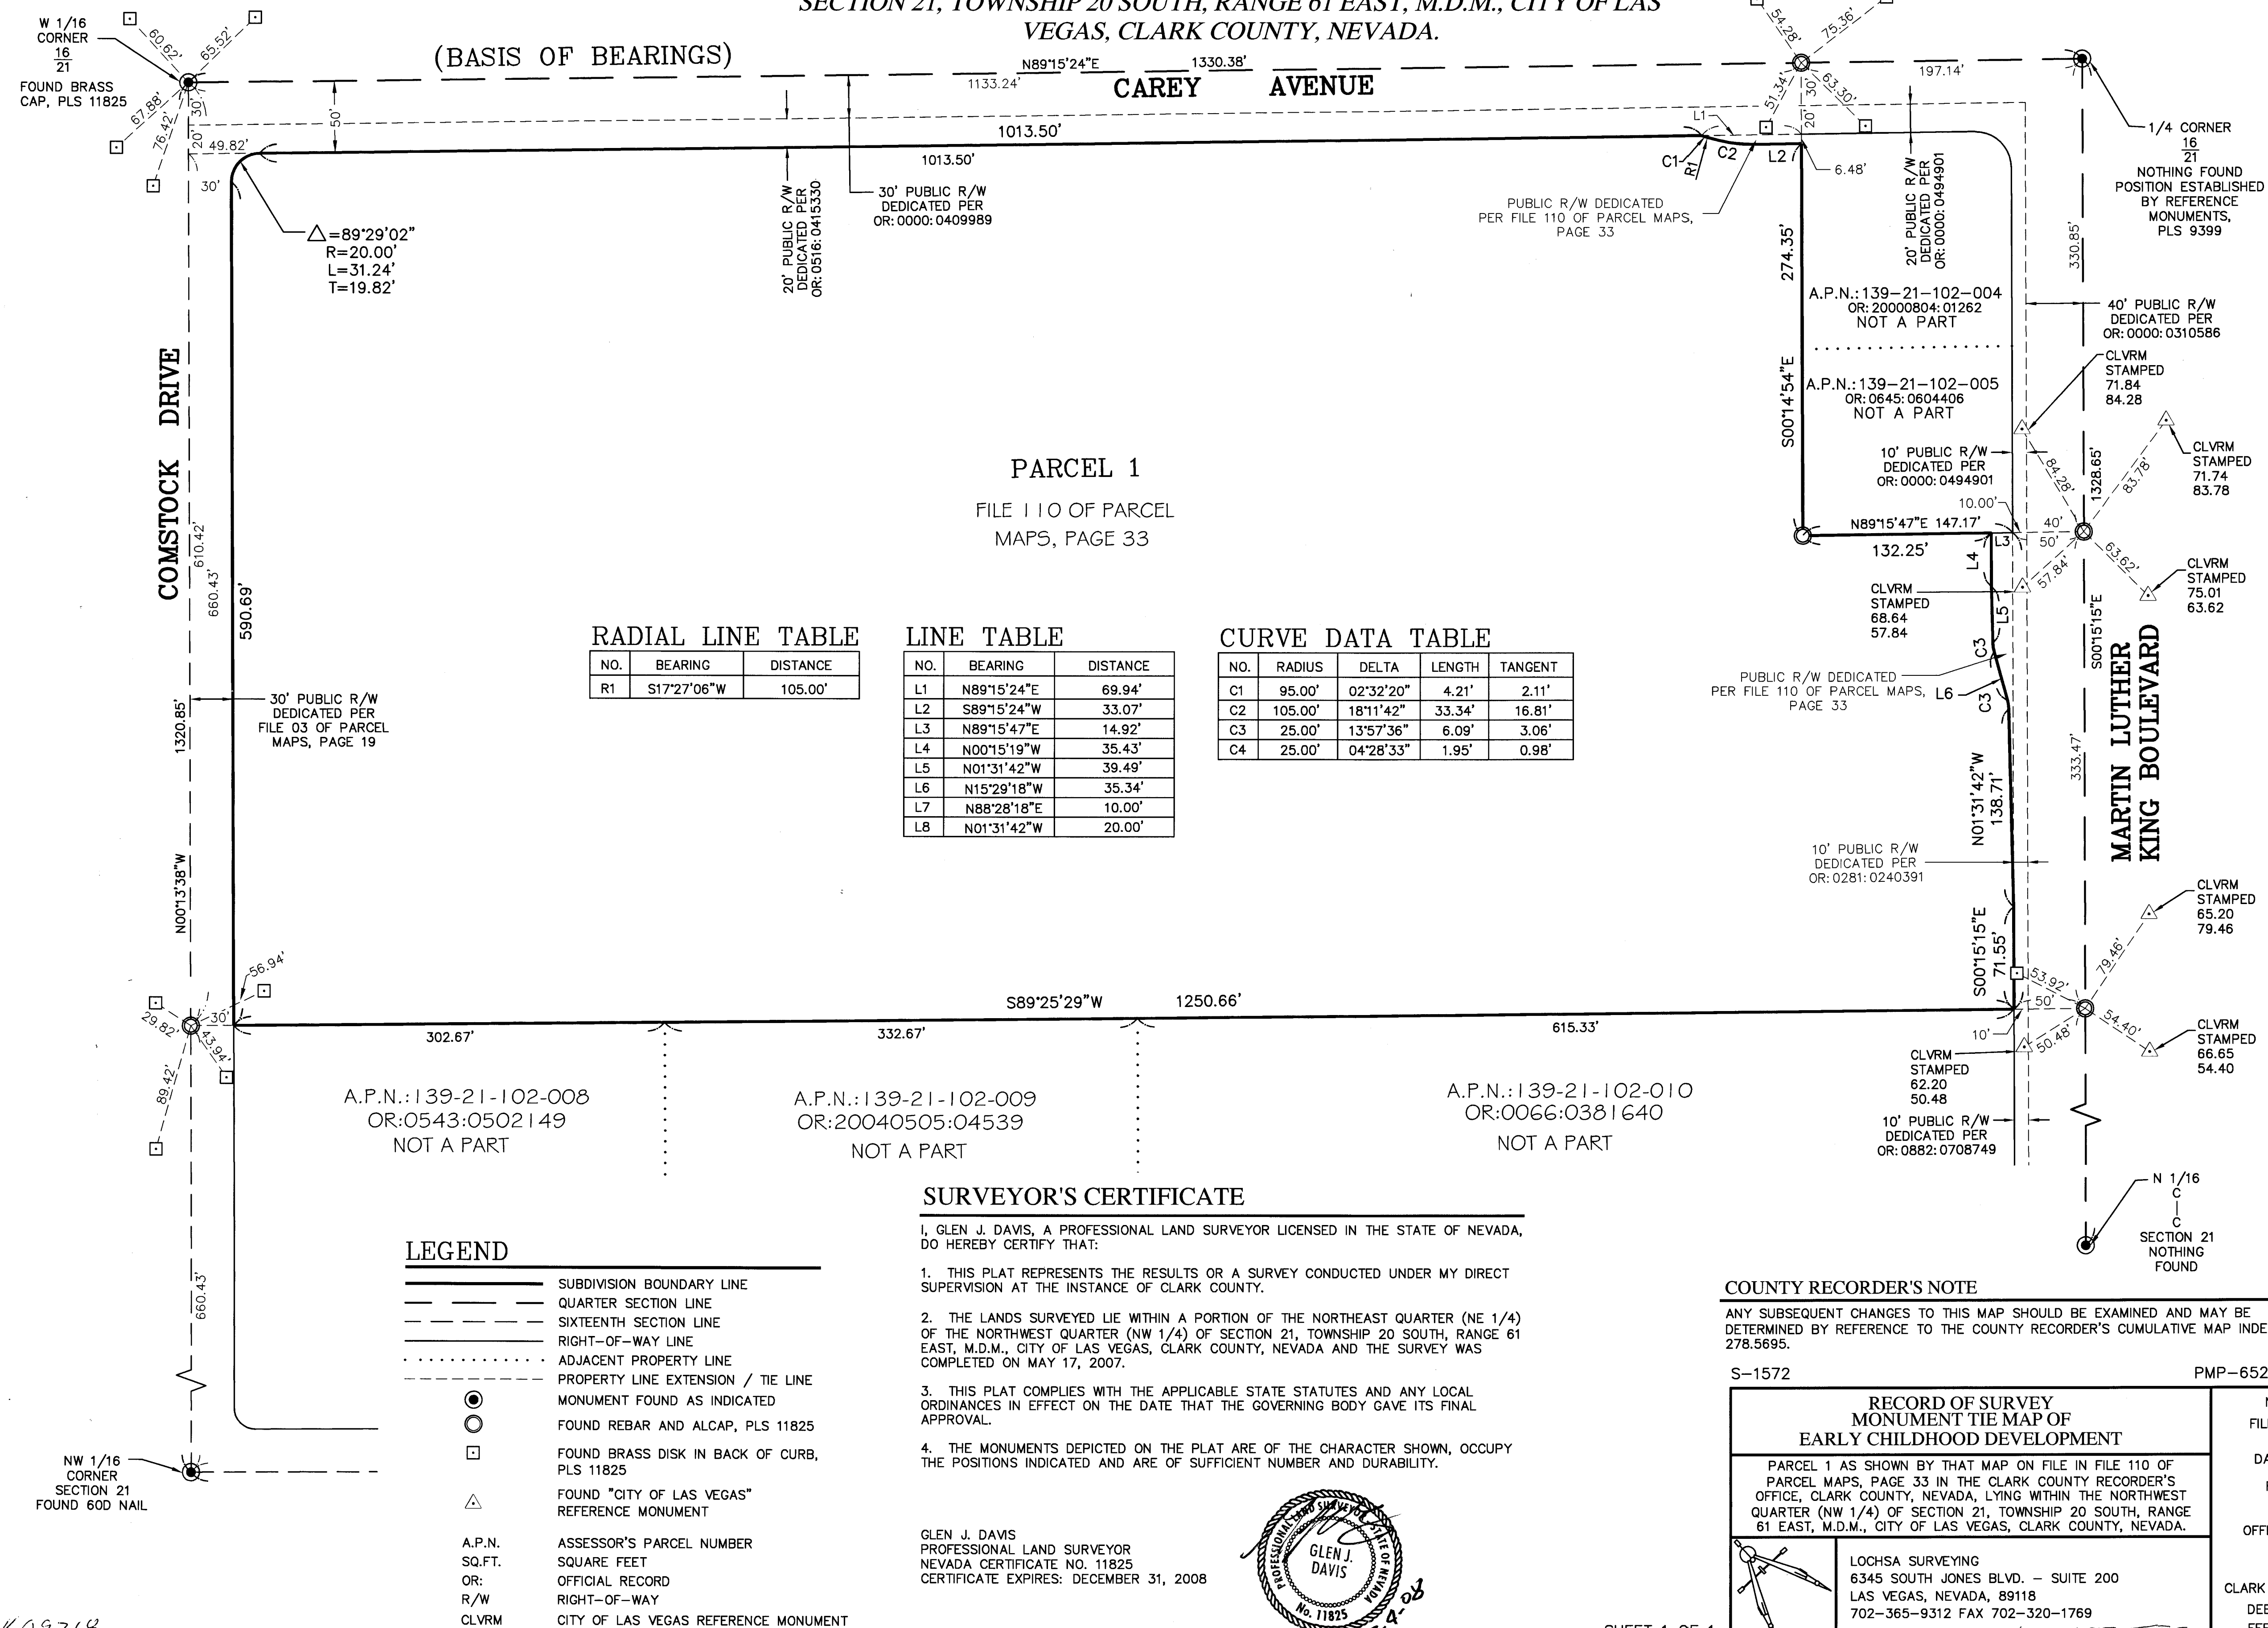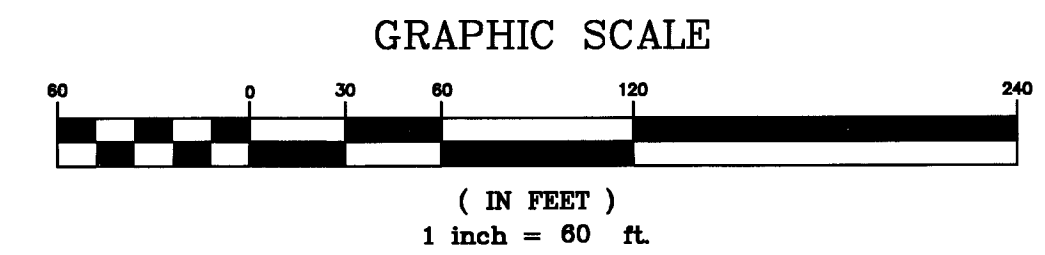

109218

SHEET 1 OF 1

107V4517-TIE