

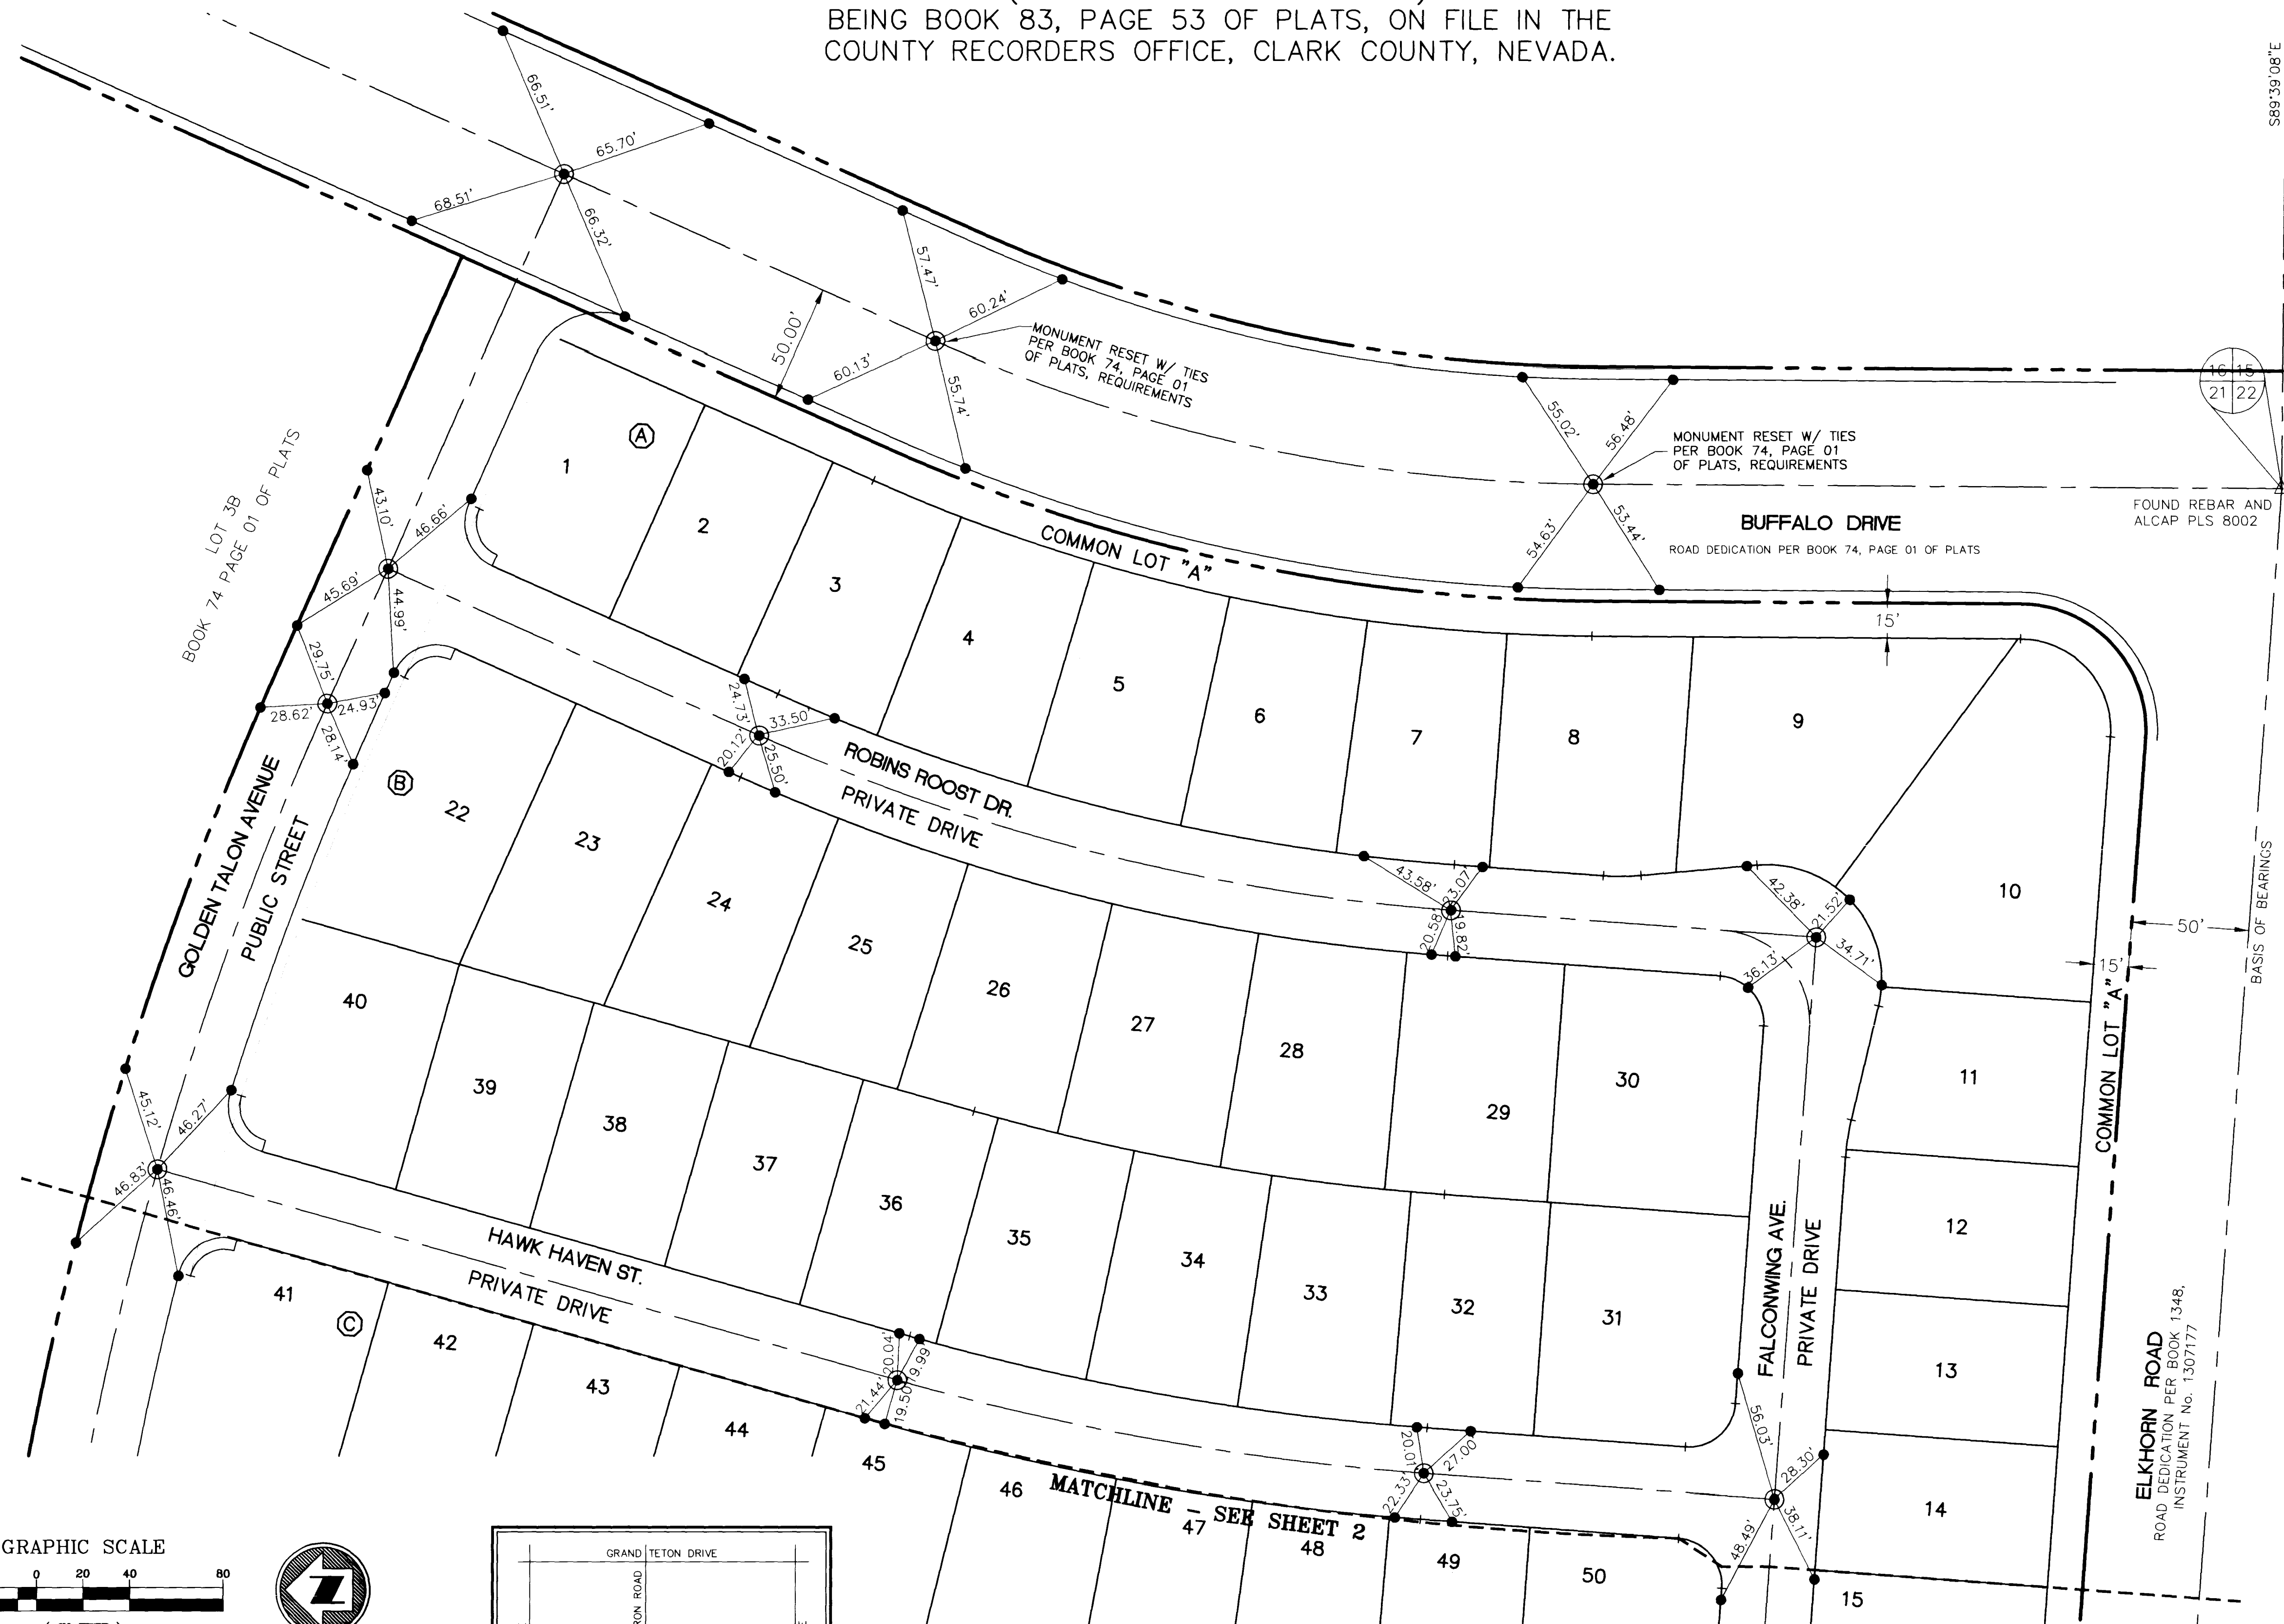


BEING BOOK 83, PAGE 53 OF PLATS, ON FILE IN THE
COUNTY RECORDERS OFFICE, CLARK COUNTY, NEVADA.

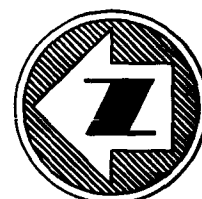


GRAPHIC SCALE

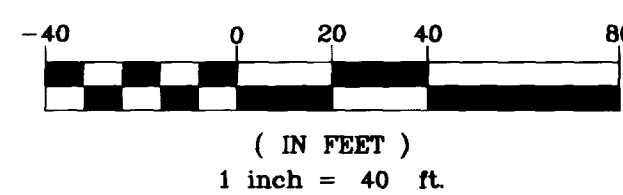

LEGEND

- _____ PROPERTY LINE
 _____ RIGHT-OF-WAY LINE
 _____ CENTERLINE
 _____ LOT LINE
 _____ CURB LINE
 _____ R.M. DIMENSION LINE
 - - - - - ADJACENT PROPERTY
- SET ALCAP PLS 13288
 W/R.M.'S UNLESS INDICATED
 ● SET R.M./PLS13288

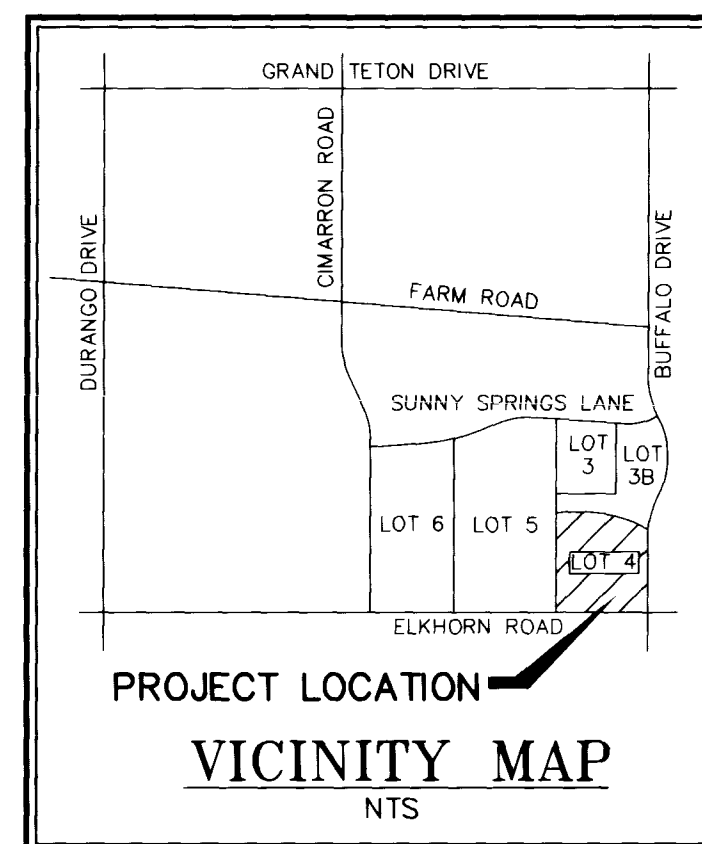


SURVEYOR'S CERTIFICATE

I, RICHARD M. CUMMOCK, A PROFESSIONAL LAND SURVEYOR IN THE STATE OF NEVADA, DO HEREBY CERTIFY THAT THE MONUMENTS HAVE BEEN SET AND THE TIE DISTANCES WERE ESTABLISHED AS SHOWN HEREON.

THIS SURVEY WAS COMPLETED ON DECEMBER 3, 1999.

Richard M. Cummock
RICHARD M. CUMMOCK, PLS 13288

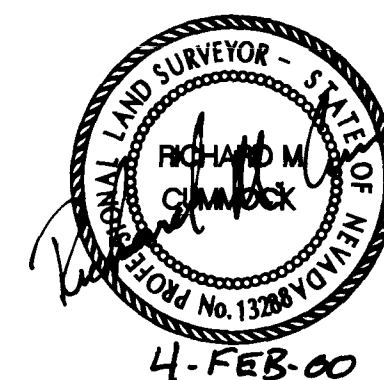

SUMMIT **ENGINEERING CORPORATION**
CONSULTING ENGINEERS AND SURVEYORS
3684 S. HIGHLAND LAS VEGAS, NEVADA 89103
(702) 252-3236 FAX: 252-3247

MONUMENT TIE MAP
OF
EAGLE HEIGHTS

ELKHORN PARTNERS LP
BOOK 83, PAGE 53 OF PLATS
COUNTY RECORDERS OFFICE
CITY OF LAS VEGAS, CLARK COUNTY, NEVADA

SCALE: 1"=40'

JOB NO. 71992