

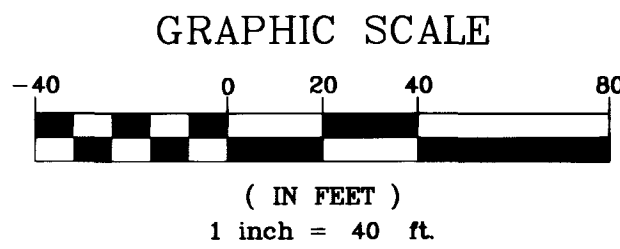


EAGLE HEIGHTS
(A PRIVATE COMMUNITY)
BEING BOOK 83, PAGE 53 OF PLATS, ON FILE IN THE
COUNTY RECORDERS OFFICE, CLARK COUNTY, NEVADA.

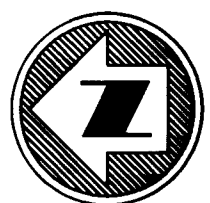

- LEGEND**
- PROPERTY LINE
 - RIGHT-OF-WAY LINE
 - CENTERLINE
 - LOT LINE
 - CURB LINE
 - R.M. DIMENSION LINE
 - ADJACENT PROPERTY
 - SET ALCAP PLS 13288
 - W/R.M.'S UNLESS INDICATED
 - SET R.M./PLS13288

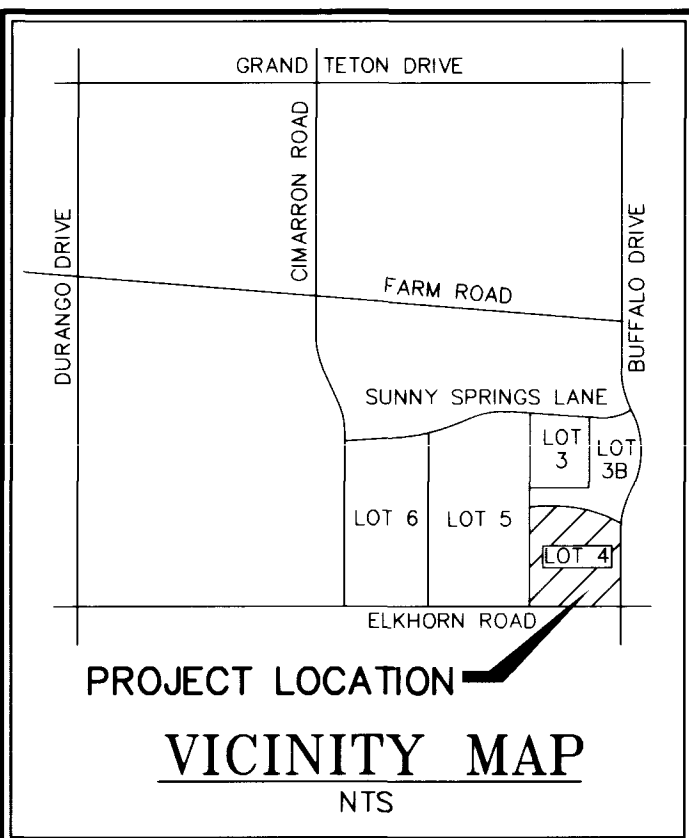


SURVEYOR'S CERTIFICATE

I, RICHARD M. CUMMOCK, A PROFESSIONAL LAND SURVEYOR IN THE STATE OF NEVADA, DO HEREBY CERTIFY THAT THE MONUMENTS HAVE BEEN SET AND THE TIE DISTANCES WERE ESTABLISHED AS SHOWN HEREON.

THIS SURVEY WAS COMPLETED ON DECEMBER 3, 1999.

Richard M. Cummock
RICHARD M. CUMMOCK, PLS 13288

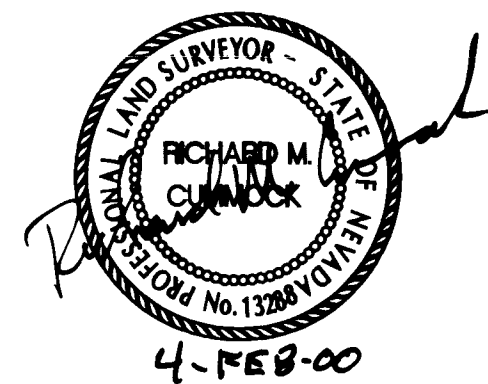

SUMMIT ENGINEERING CORPORATION CONSULTING ENGINEERS AND SURVEYORS 3684 S. HIGHLAND LAS VEGAS, NEVADA 89103 (702) 252-3236 FAX: 252-3247	SHEET 2
	OF 2
MONUMENT TIE MAP OF EAGLE HEIGHTS	
ELKHORN PARTNERS LP BOOK 83, PAGE 53 OF PLATS COUNTY RECORDERS OFFICE CITY OF LAS VEGAS, CLARK COUNTY, NEVADA	
SCALE: 1"=40'	JOB NO. 71992

20877

P:\DWGS\J71992\EAGLEHTS\EAGLE HTS TIE.DWG

058-4533