




**A SECTION**  
SCALE: NTS

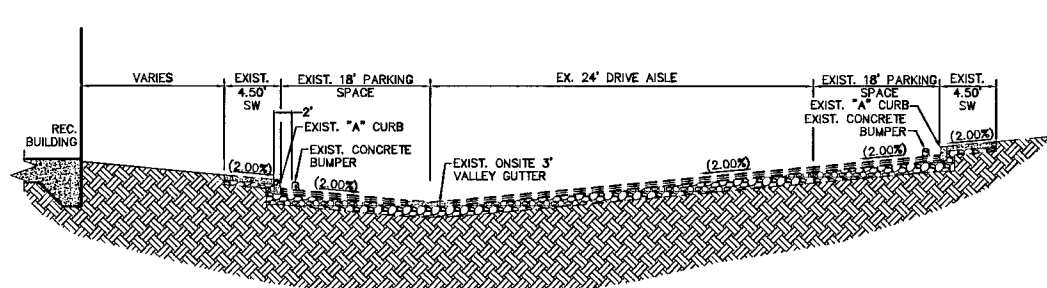


**B SECTION**  
SCALE: NTS

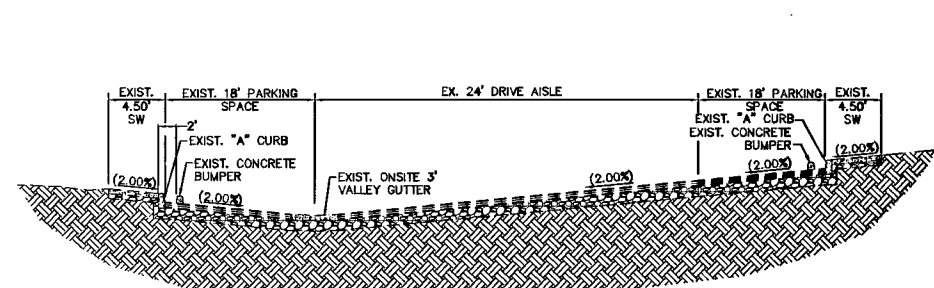


**C SECTION**  
SCALE: NTS

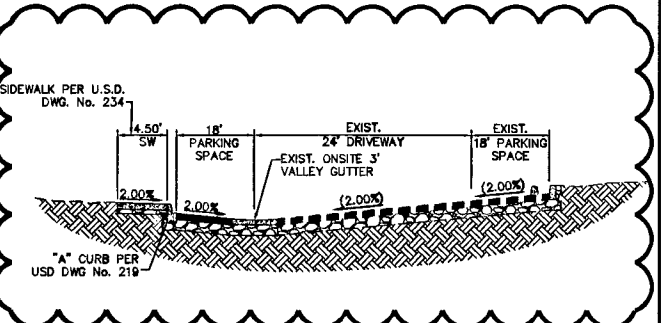


**D SECTION**  
SCALE: NTS

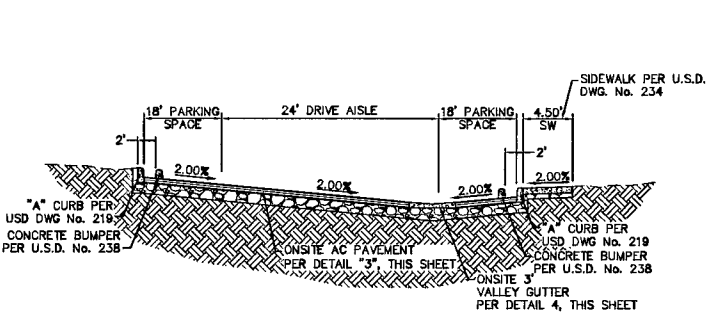


**E SECTION**  
SCALE: NTS

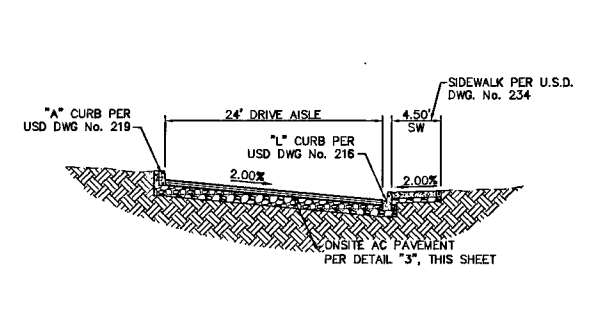


**F SECTION**  
SCALE: NTS

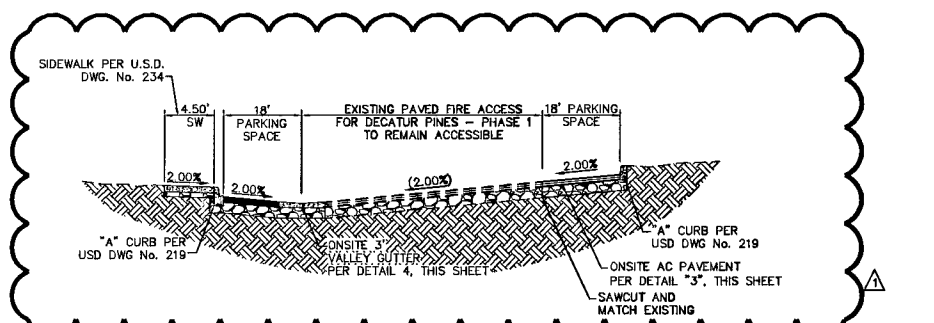


**G SECTION**  
SCALE: NTS

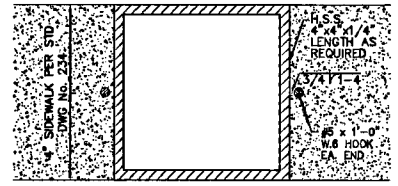


**1 SIDEWALK UNDERDRAIN**  
(ONSITE) SCALE: NTS

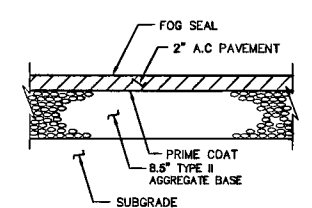


**2 ON-SITE A.C. PAVEMENT SECTION**  
SCALE: NTS

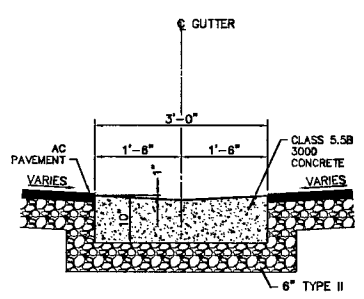

**3 3' VALLEY GUTTER SECTION**  
SCALE: NTS

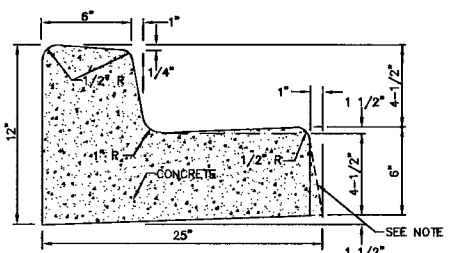

**4 'L' TYPE CURB AND GUTTER DETAIL**  
PER USD DWG. No. 216 SCALE: NTS

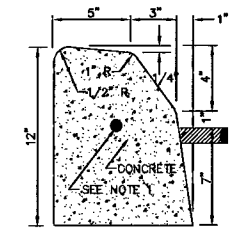

**5 'A' TYPE CURB DETAIL**  
PER USD DWG. No. 219 SCALE: NTS

REV	NO	REVISION DESCRIPTION	DATE
1	1	REVISED PER NEW PARKING LAYOUT	1/15/15


**NEVADA HAND.**  
285 EAST WALK SPRINGS ROAD SUITE 101  
LAS VEGAS, NEVADA 89119-4212  
TEL: (702) 738-3345 CONTACT: ROBERT FELDMAN

**L.R. NELSON CONSULTING ENGINEERS, INC.**  
6785 West Russell Road Suite 200  
Las Vegas, Nevada 89118  
TEL: (702) 491-2296 FAX (702) 491-2296

**DETAILS SHEET**

**TITLE**  
DECATUR PINES - REC. BLDG  
DEER SPRINGS WAY AND DECATUR BLVD  
CITY OF LAS VEGAS

**DRAWN BY:** J.P. JED. '10  
**DESIGNED BY:** J.P. JED. '10  
**CHECKED BY:** J.P. JED. '10  
**PROJECT NO.:** 1527-001-071  
**SCALE:** N/A

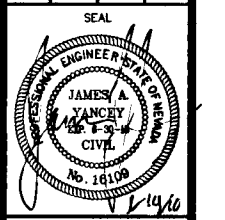

**SHEET**  
DT1  
8 OF 14 SHEETS  
CLV DRAWING NO.  
107V4842-REC