


# MONUMENT TIE MAP

## EAGLE CREEK II - PHASE 1

### FOR BOOK 91, PAGE 50

A.P.N. 125-25-101-018  
(NOT A PART)

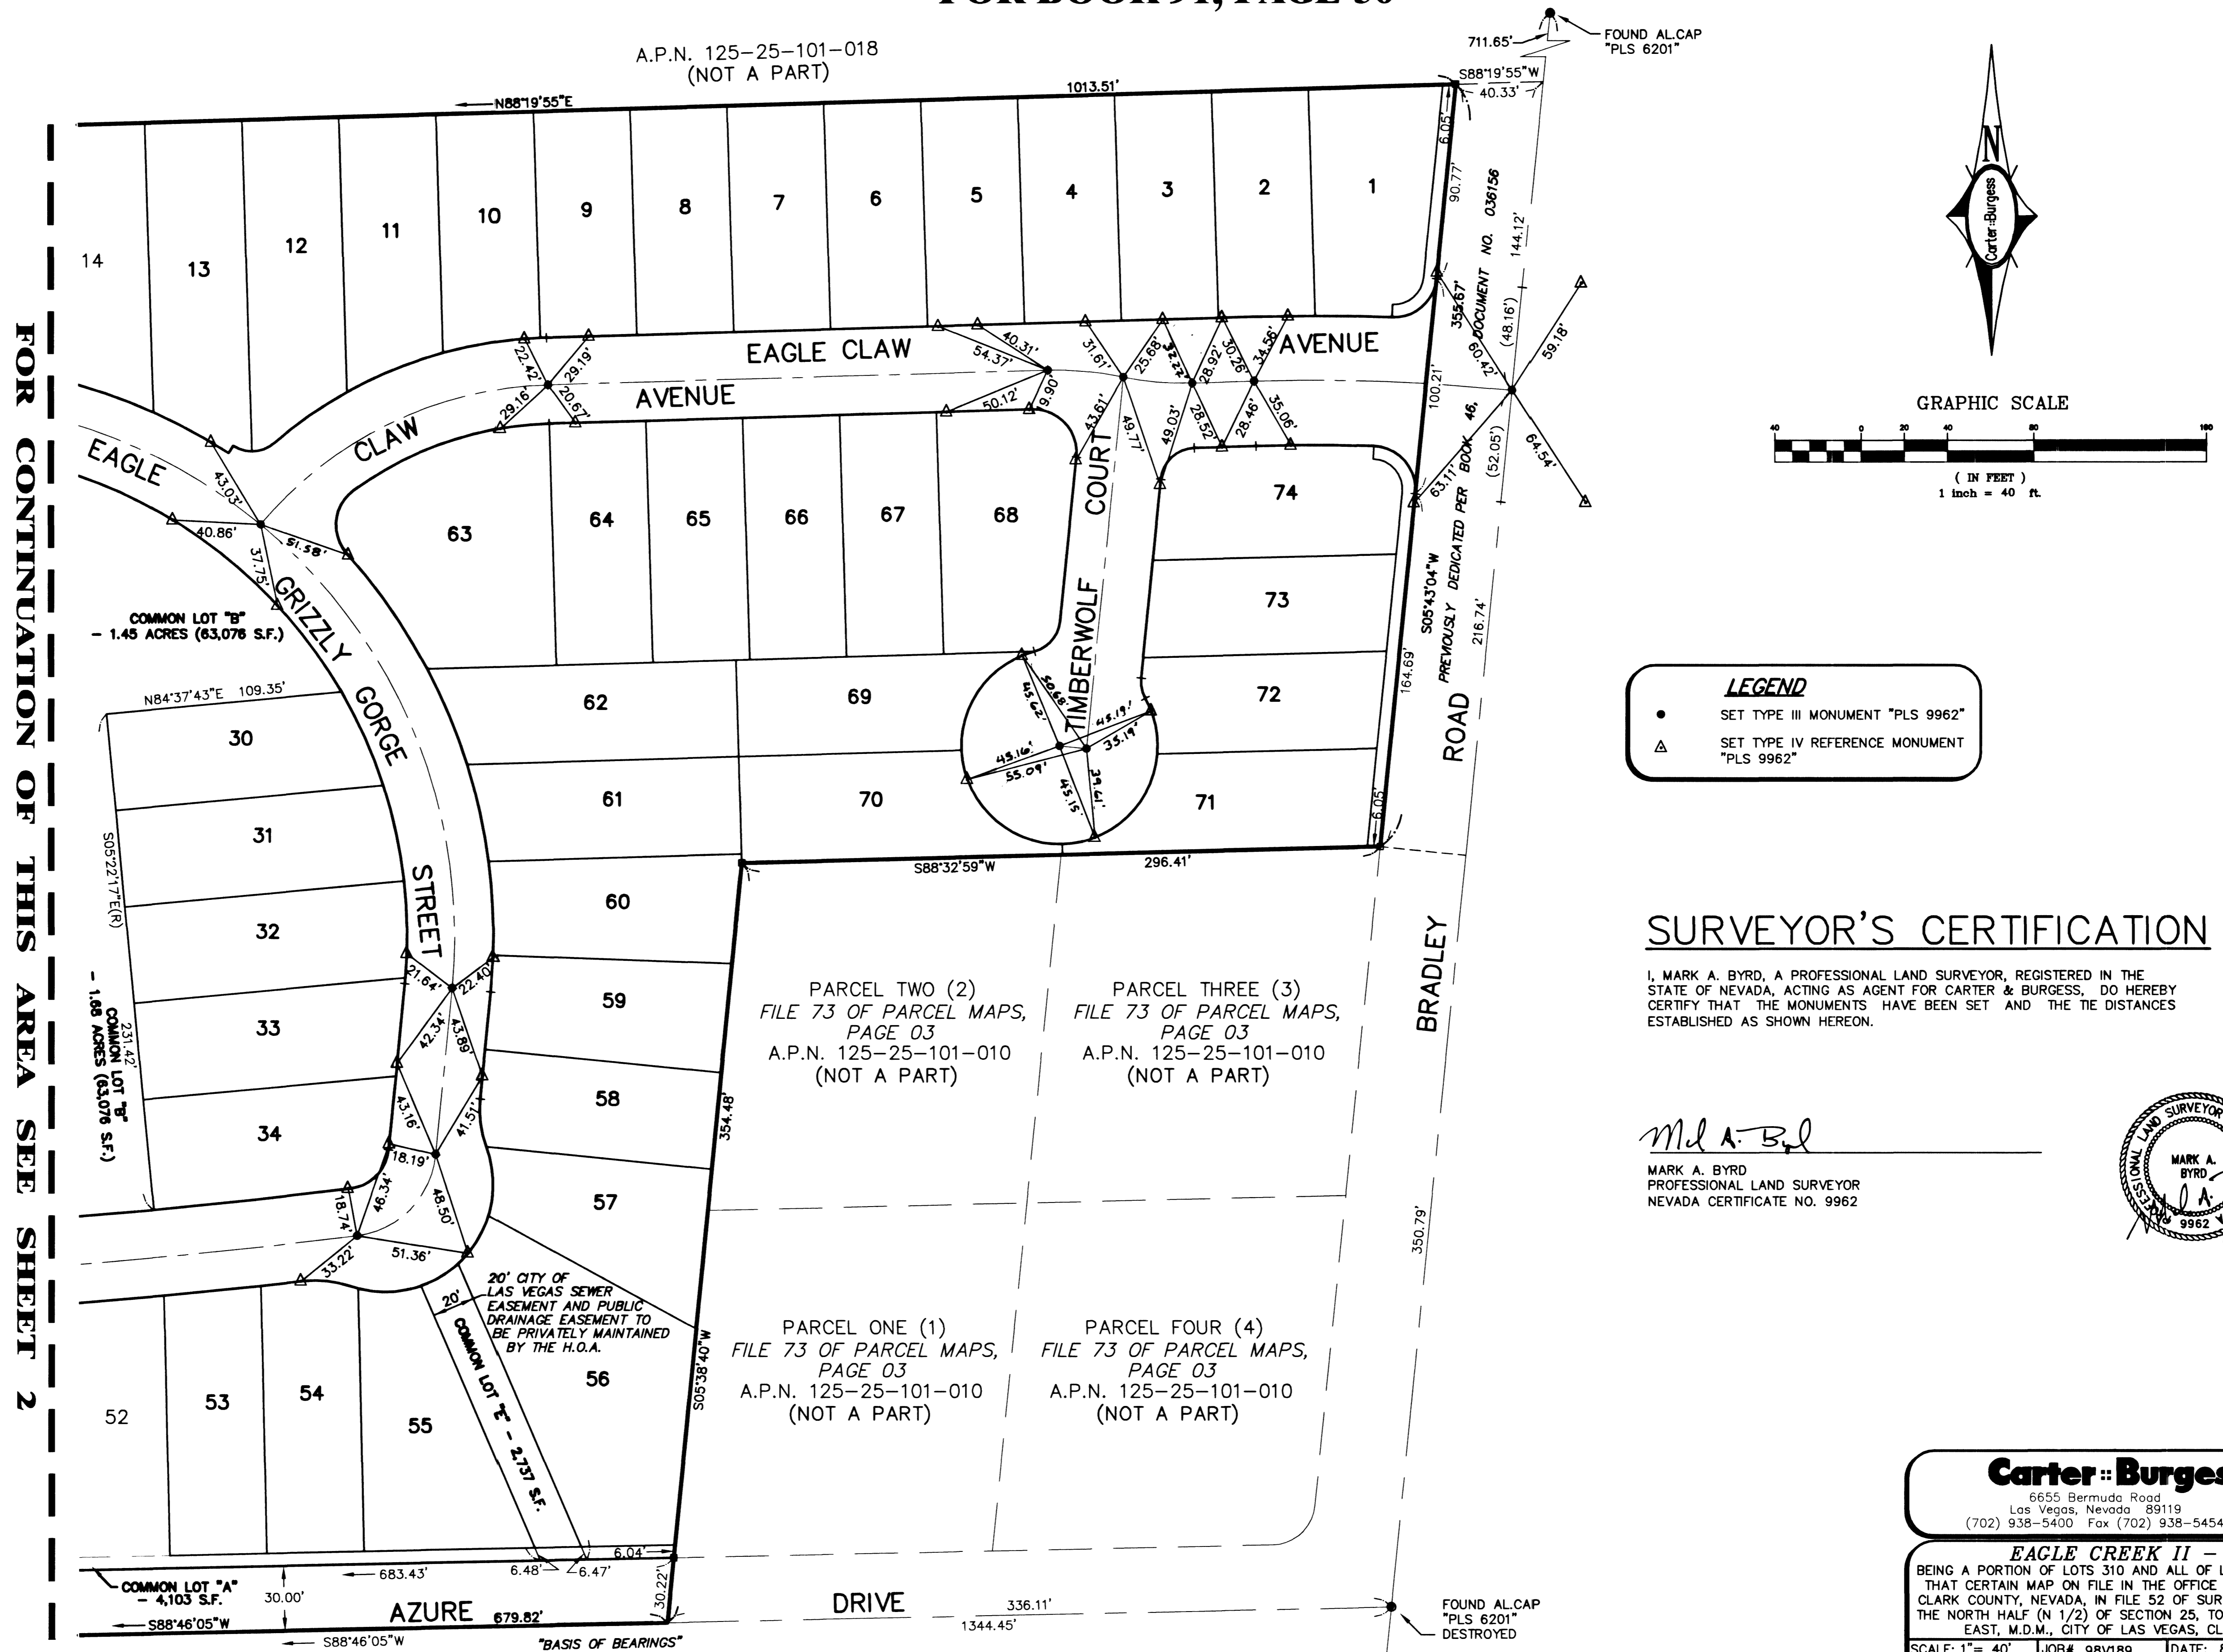


**LEGEND**

- SET TYPE III MONUMENT "PLS 9962"
- ▲ SET TYPE IV REFERENCE MONUMENT "PLS 9962"

### SURVEYOR'S CERTIFICATION

I, MARK A. BYRD, A PROFESSIONAL LAND SURVEYOR, REGISTERED IN THE STATE OF NEVADA, ACTING AS AGENT FOR CARTER & BURGESS, DO HEREBY CERTIFY THAT THE MONUMENTS HAVE BEEN SET AND THE TIE DISTANCES ESTABLISHED AS SHOWN HEREON.

*Mark A. Byrd*  
 MARK A. BYRD  
 PROFESSIONAL LAND SURVEYOR  
 NEVADA CERTIFICATE NO. 9962

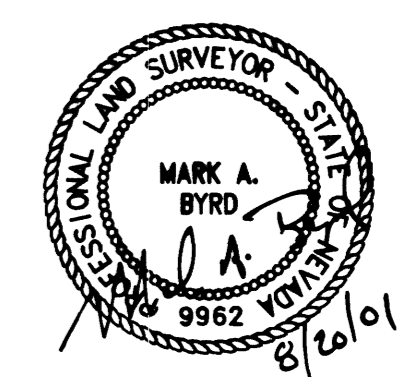

**Carter Burgess** Consultants in Planning, Engineering, Architecture, Construction Management, and Related Services  
 6655 Bermuda Road  
 Las Vegas, Nevada 89119  
 (702) 938-5400 Fax (702) 938-5454

**EAGLE CREEK II - PHASE 1**

BEING A PORTION OF LOTS 310 AND ALL OF LOTS 311 AND 313 AS SHOWN THAT CERTAIN MAP ON FILE IN THE OFFICE OF THE COUNTY RECORDER, CLARK COUNTY, NEVADA, IN FILE 52 OF SURVEYS, PAGE 70 LYING WITHIN THE NORTH HALF (N 1/2) OF SECTION 25, TOWNSHIP 19 SOUTH, RANGE 60 EAST, M.D.M., CITY OF LAS VEGAS, CLARK COUNTY, NEVADA

SCALE: 1" = 40'	JOB# 98V189	DATE: 8/16/01	SHEET	OF
FILE: 8189MON	DRN. BY: AFR	REV.:	1	2
	CKD. BY: MAB	058-4614-1		

41469