


MONUMENTATION TIE MAP of
ELKHORN - LEON
UNIT ONE

A COMMON INTEREST COMMUNITY

A PORTION OF THE SOUTHWEST QUARTER (SW 1/4) OF SECTION 13,
 TOWNSHIP 19 SOUTH, RANGE 60 EAST, M.D.M., CITY OF LAS VEGAS, CLARK COUNTY, NEVADA.



NORTH
 GRAPHIC SCALE

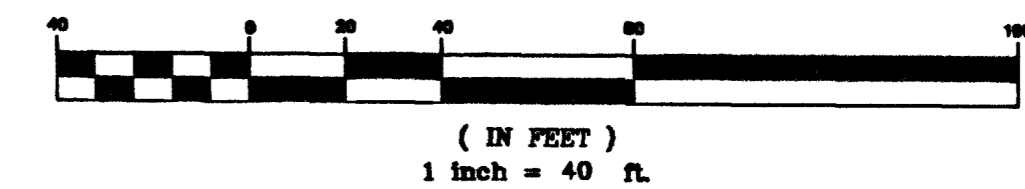

DESIGNED BY:	
DRAWN BY:	SCS
CHECKED BY:	C. CANO
PROJECT DATE:	
BY DATE/APP. DATE:	
NO.	REVISION
1	
2	
3	
4	
5	
6	

LEGEND

- SET 5/8" REBAR AND ALUM. CAP, MARKED "PLS 11175"
- SET ALUM. CAP REFERENCE MONUMENT IN CURB MARKED "PLS 11175"
- ① BLOCK NUMBER, TYPICAL
- 1 LOT NUMBER, TYPICAL

NOTES

ALL CENTERLINE BEARINGS, DISTANCES, AND CURVE DATA IS AS SHOWN ON THE RECORDED FINAL MAP OF ELKHORN - LEON, UNIT ONE

CERTIFICATE

I, CAESAR CANO, A PROFESSIONAL LAND SURVEYOR, LICENSED IN THE STATE OF NEVADA, DO HEREBY CERTIFY THAT THE MONUMENTS HAVE BEEN SET AND THE TIES ESTABLISHED AS SHOWN HEREON.

CAESAR CANO
 PROFESSIONAL SURVEYOR
 NEVADA LICENSE NO. 11175




ELKHORN - LEON, UNIT ONE
 MONUMENTATION TIE MAP
 ELKHORN - LEON, UNIT ONE
 PLATS BK 92, PG 69

DEVELOPER

SEAL

6280 S. Valley View Blvd
 Suite 200
 Las Vegas, NV 89118
 Tel: (702) 368-3008
 Fax: (702) 368-0047

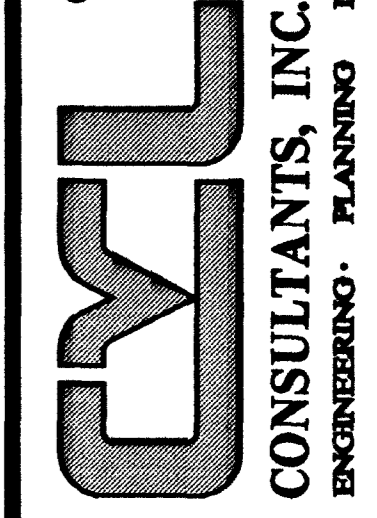

SHEET
 2 OF 2
 AGENCY DWG. NO.
 058-4619-1

