

# DIAMOND CREEK UNIT 2

A COMMON INTEREST COMMUNITY

SITUATE IN THE CITY OF LAS VEGAS, CLARK COUNTY, NEVADA LYING WITHIN THE SOUTHEAST ONE-QUARTER OF SECTION 13, TOWNSHIP 19 SOUTH, RANGE 60 EAST, M.D.M.




KUMUKO PRIMA  
BOOK 20000427 O.R. INST. 01850

JAMES J. & KAZUMI H. KUBRIDE  
BOOK 870728 O.R. INST. 00140

### SURVEYOR'S CERTIFICATE

I, J EDWARD LEAVITT, A PROFESSIONAL LAND SURVEYOR IN THE STATE OF NEVADA, DO HEREBY CERTIFY THAT THE MONUMENTS HAVE BEEN SET AND THE TIE DISTANCES WERE ESTABLISHED AS SHOWN HEREON.

THIS SURVEY WAS COMPLETED ON NOVEMBER 26, 2003

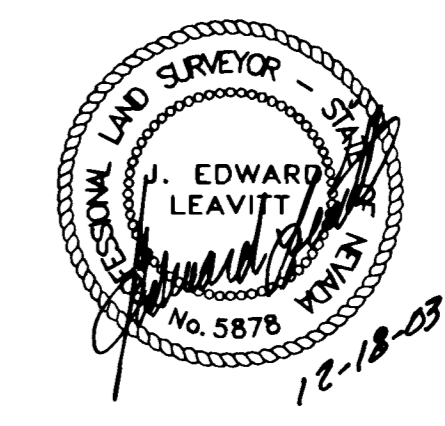

J EDWARD LEAVITT, PLS 5878  
MY LICENSE EXPIRES DECEMBER 31, 2003

#### LEGEND

- SET 5/8" REBAR W/ ALUM. CAP PLS 5878
- SET REFERENCE MONUMENT TIED TO ALUMINUM CAP - PLS 5878
- SET 5/8" REBAR W/ ALUM. CAP & TIES PLS 5878
- FOUND MONUMENT AS INDICATED
- OVERALL PARCEL BOUNDARY LINE
- INTERIOR PROPERTY OR RIGHT-OF-WAY LINE
- STREET CENTERLINE
- LOT 22
- CE-A

**ALPHA ENGINEERING INC.**  
50 So. Jones Blvd. #202, Las Vegas, NV, 89107 Telephone: (702) 877-1300

### MONUMENT TIE MAP

FOR  
THE PLAT OF DIAMOND CREEK UNIT 2 PER BOOK 102, PAGE 34.  
SITUATE IN THE CITY OF LAS VEGAS, CLARK COUNTY, NEVADA LYING  
WITHIN THE SOUTHEAST ONE-QUARTER OF SECTION 13,  
TOWNSHIP 19 SOUTH, RNGE 60 EAST, M.D.M.

058-4658-2

DRAWN: FHL	DESIGN: JEL	CHKD: JEL	DATE: 12-17-03
JOB: 007624	H.SCALE: 1"=40'	V.SCALE:	SHEET 1 OF 1

62352