


# EL CAPITAN / O'HARE - UNIT 1 MONUMENTATION TIE MAP

(A COMMON INTEREST COMMUNITY)  
BEING A PORTION OF THE NORTHEAST QUARTER (NE 1/4) OF THE SOUTHWEST QUARTER (SW 1/4) OF SECTION 5, TOWNSHIP 19 SOUTH, RANGE 60 EAST, M.D.M., CITY OF LAS VEGAS, CLARK COUNTY, NEVADA




FOR CONTINUATION SEE SHEET 2

I, ANTHONY ZICARI, A PROFESSIONAL LAND SURVEYOR LICENSED IN THE STATE OF NEVADA, DO HEREBY CERTIFY THAT THE MONUMENTS HAVE BEEN SET AND THE TIE DISTANCES ESTABLISHED AS SHOWN HEREON. THIS SURVEY WAS COMPLETED ON JUNE 4, 2004.

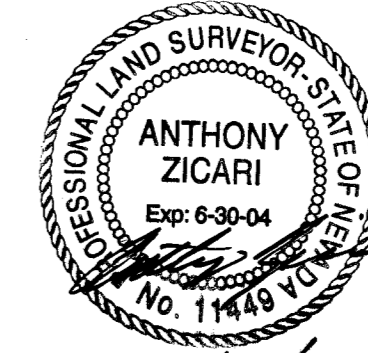

ANTHONY ZICARI, P.L.S.  
NEVADA LICENSE NO. 11449

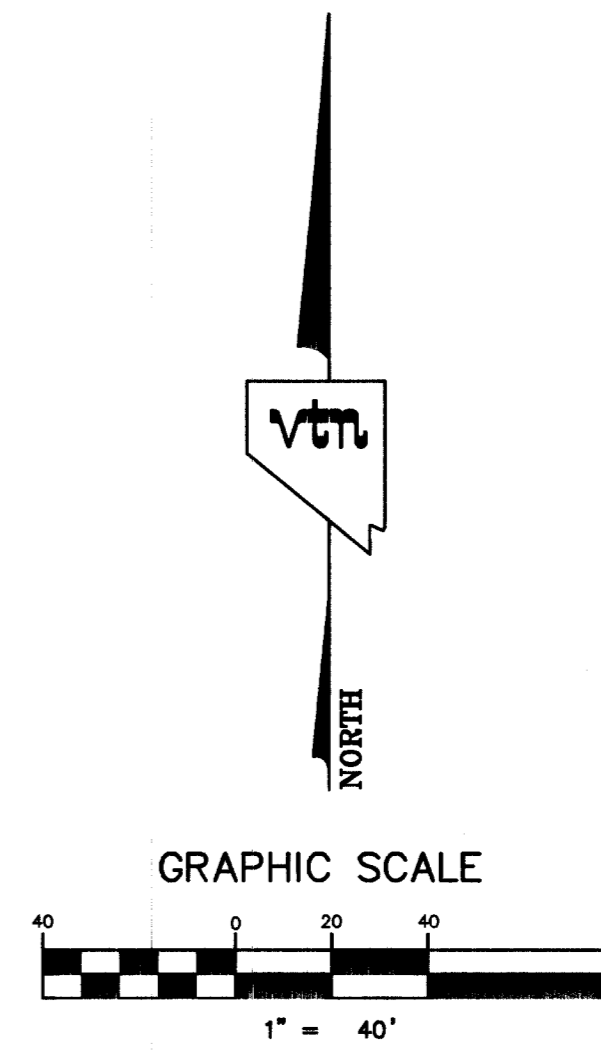

### NOTES

SEE FINAL MAP FOR BEARING AND DISTANCES.  
BOOK 107, PAGE 55

### LEGEND

- 2** LOT NUMBER
- (X)** BLOCK NUMBER
- LOT LINES
- - - STREET CENTERLINE
- - - BACK OF CURB LINE
- FOUND TYPE II MONUMENT - 2" BRASS CAP IN CONCRETE STAMPED "VTN PLS 12649" - PER IRON MOUNTAIN ESTATES - UNIT 2 BOOK 92, PAGE 17
- SET TYPE IV-A REFERENCE MONUMENTS - NON-FERROUS CAP STAMPED "VTN PLS 11449" IN TOP OF CURB
- SET TYPE III MONUMENT - 5/8" REBAR AND AL. CAP STAMPED "VTN PLS 11449" WITH REFERENCE MONUMENTS IN TOP OF CURB
- ▲ FOUND TYPE II MONUMENT "VTN PLS 12469" PER "IRON MOUNTAIN ESTATES - UNIT 2" BOOK 92, PAGE 17

SHEET 1 OF 2