


EL CAPITAN / O'HARE - UNIT 2

MONUMENTATION TIE MAP

(A COMMON INTEREST COMMUNITY)
BEING A PORTION OF THE NORTHEAST QUARTER (NE 1/4) OF THE SOUTHWEST QUARTER (SW 1/4)
OF SECTION 5, TOWNSHIP 19 SOUTH, RANGE 60 EAST, M.D.M., CITY OF LAS VEGAS, CLARK COUNTY, NEVADA

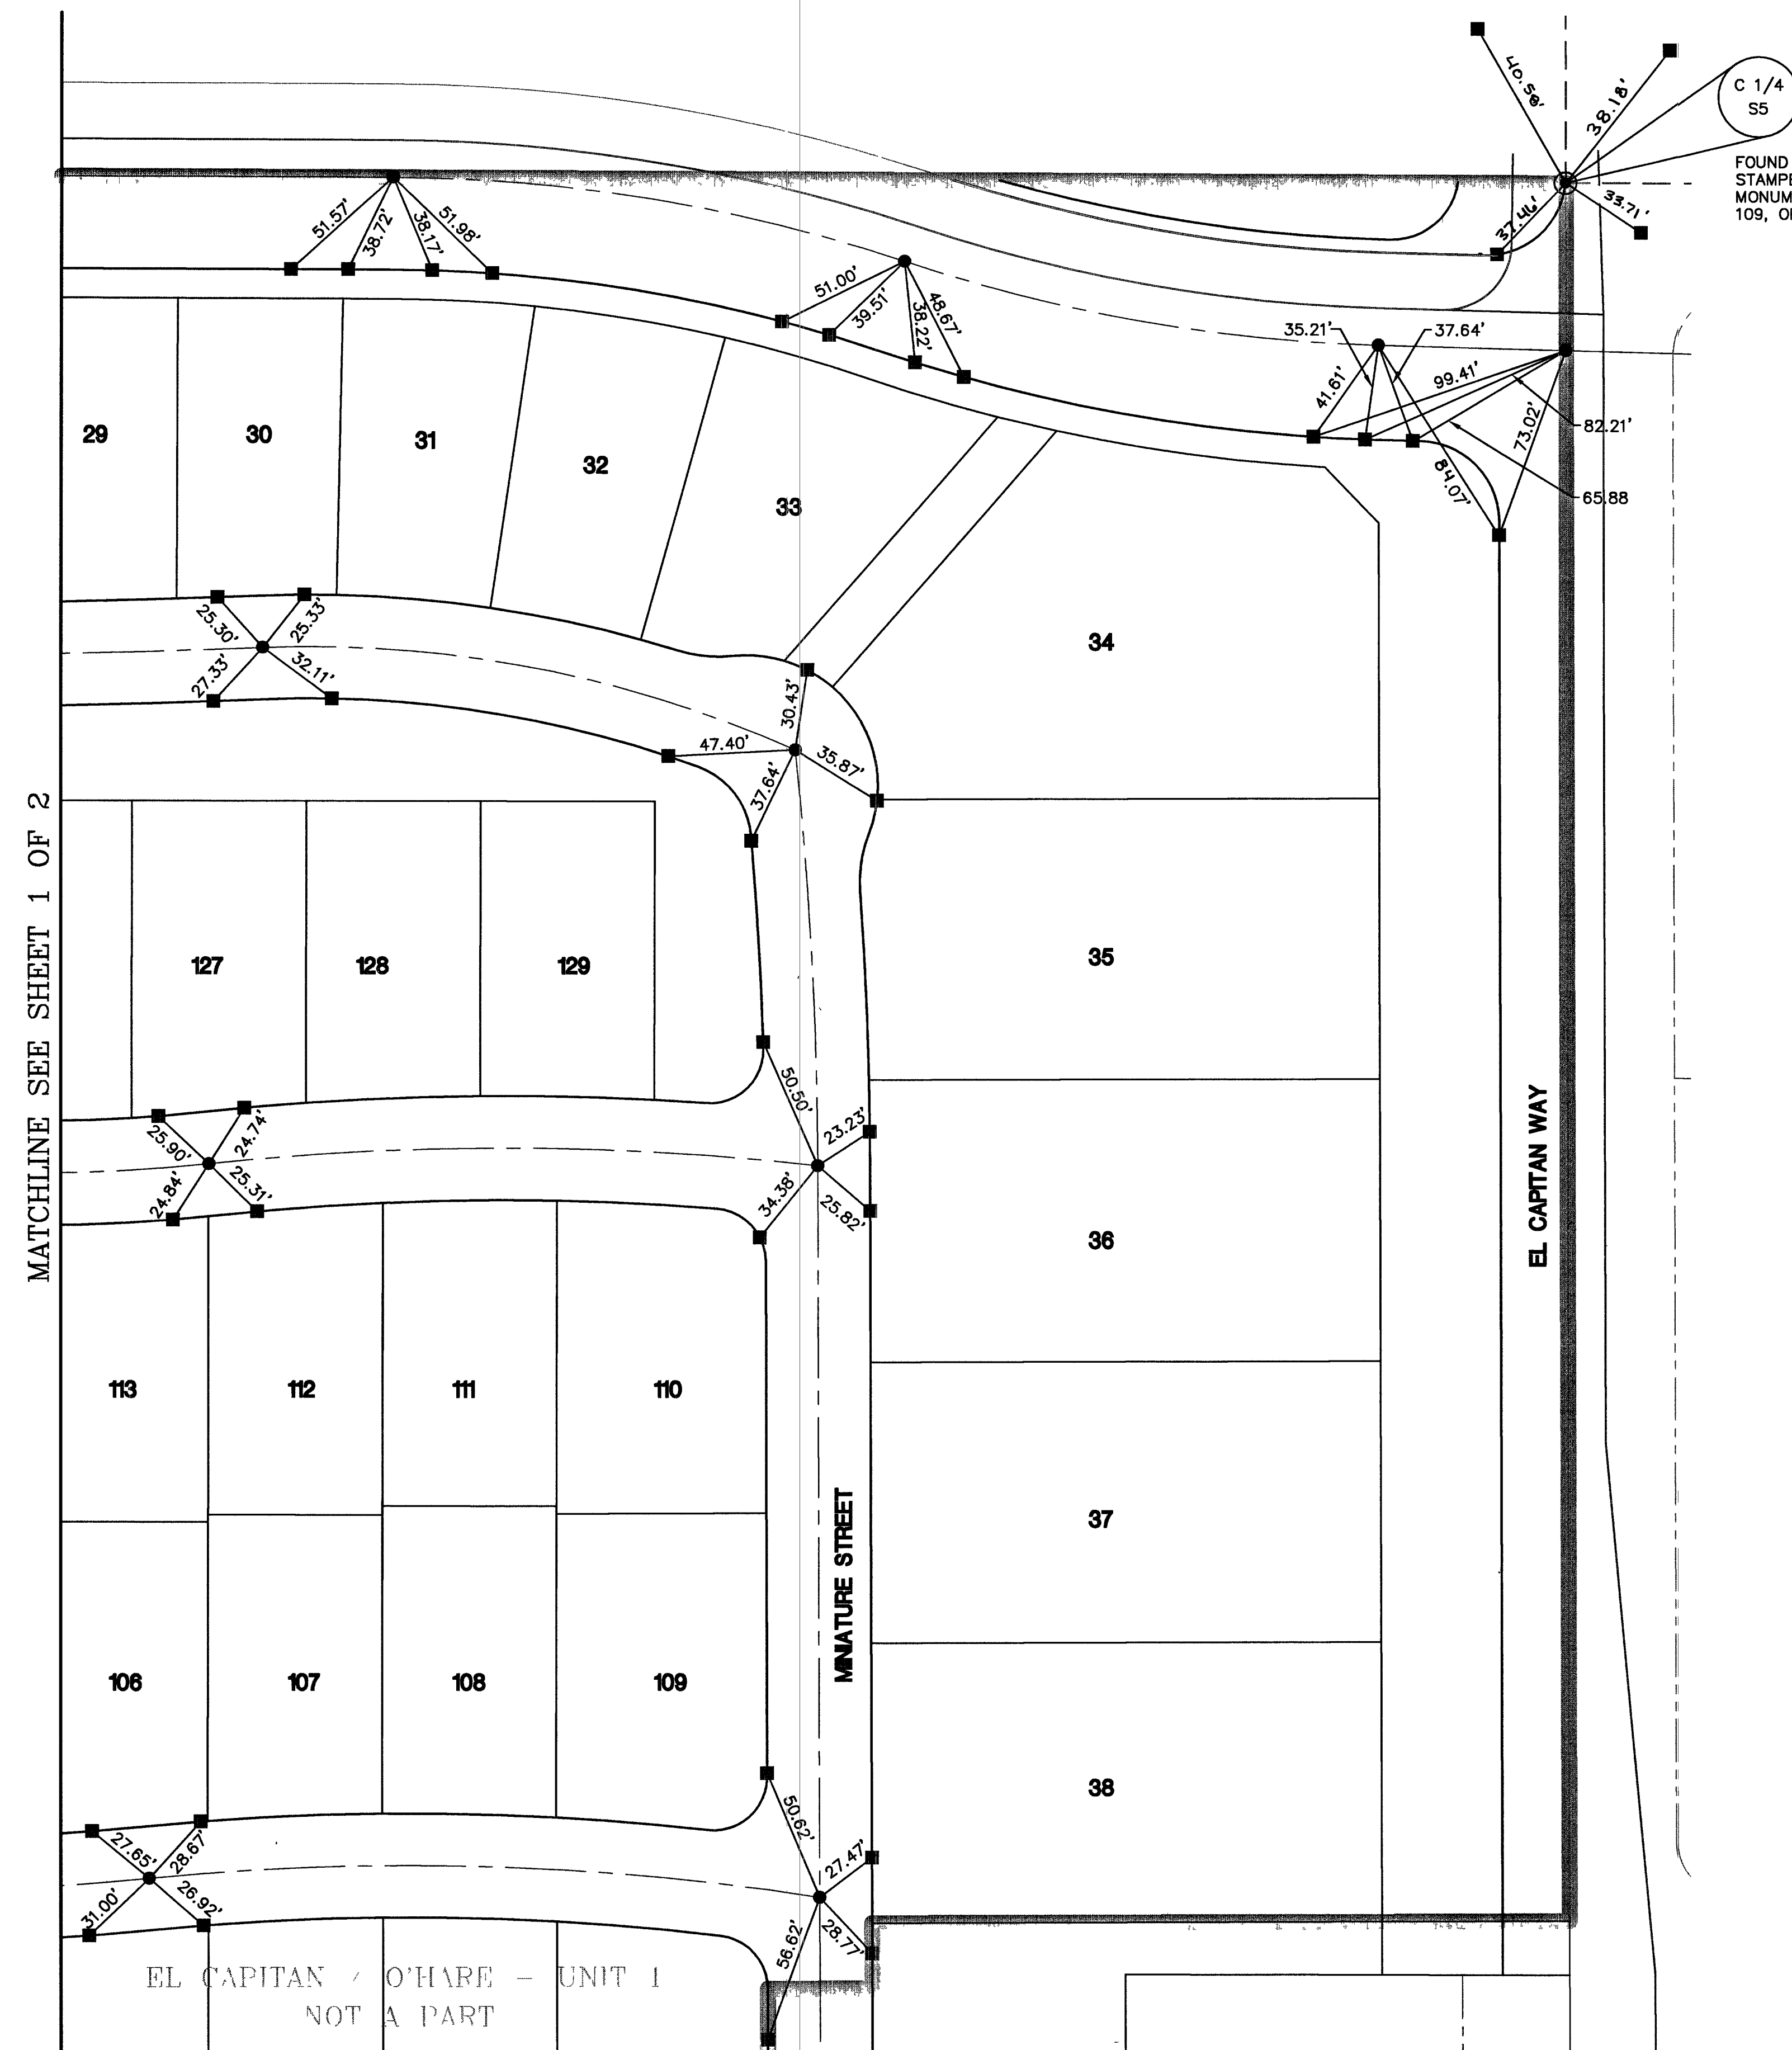

NOTES

SEE FINAL MAP FOR BEARING AND DISTANCES.
(BOOK 109, PAGE 0042)

LEGEND

- 2 LOT NUMBER
- (X) BLOCK NUMBER
- SUBDIVISION BOUNDARY LINE
- RIGHT OF WAY
- LOT LINES
- SUBDIVISION BOUNDARY LINE
- STREET CENTERLINE
- BACK OF CURB LINE
- SET TYPE III MONUMENT - 5/8" REBAR AND AL. CAP STAMPED "VTN PLS 11449" WITH REFERENCE MONUMENTS IN TOP OF CURB
- SET TYPE IV-A REFERENCE MONUMENTS STAMPED "VTN PLS 11449" IN TOP OF CURB
- FOUND MONUMENT AS NOTED

SHEET 2 OF 2