DAY DAWN ESTATES UNIT 2

BOOK 116, PAGE 38 OF PLATS, ON FILE IN THE COUNTY RECORDER'S OFFICE, CLARK COUNTY, NEVADA.

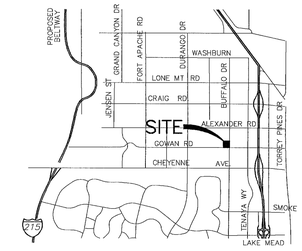

VICINITY MAP
NTS

GRAPHIC SCALE

-40 0 20 40 80

(IN FEET)
1 inch = 40 ft.

LEGEND

- PROPERTY/R.O.W. LINE
- CENTERLINE
- LOT LINE
- CURB LINE
- R.M. DIMENSION LINE
- ADJACENT PROPERTY
- SET TYPE III MONUMENT STAMPED PLS 11194
- SET REFERNCE MONUMENT STAMPED PLS 11194

SURVEYOR'S CERTIFICATE

I, ERIC SNYDER, A PROFESSIONAL LAND SURVEYOR LICENSED IN THE STATE OF NEVADA, DO HEREBY CERTIFY THAT THE MONUMENTS HAVE BEEN SET AND THE TIE DISTANCES WERE ESTABLISHED AS SHOWN HEREON.

THIS SURVEY WAS COMPLETED ON NOV. 4, 2004

ERIC SNYDER — PLS 11194

PROFESSIONAL LAND SURVEYOR ERIC SNYDER Exp: 06/30/06 No. 11194 STATE OF NEVADA

11/04/04

SUMMIT ENGINEERING CORPORATION
1421 E. SUNSET, SUITE 17, LAS VEGAS, NV. 89119
PHONE: (702) 252-3236 FAX: (702) 252-3247

SHEET 1 OF 1

MONUMENT TIE MAP
OF
DAY DAWN ESTATES UNIT 2

BOOK 116, PAGE 38 OF PLATS
COUNTY RECORDER'S OFFICE
CITY OF LAS VEGAS, CLARK COUNTY, NEVADA

SCALE: 1"=40' | JOB NO. 72499

79803

058-4748-2

P:\DWGS\J72499\SURVEY\FIELD\72499TIE-UNIT2.dwg

FILE _____ PAGE _____