

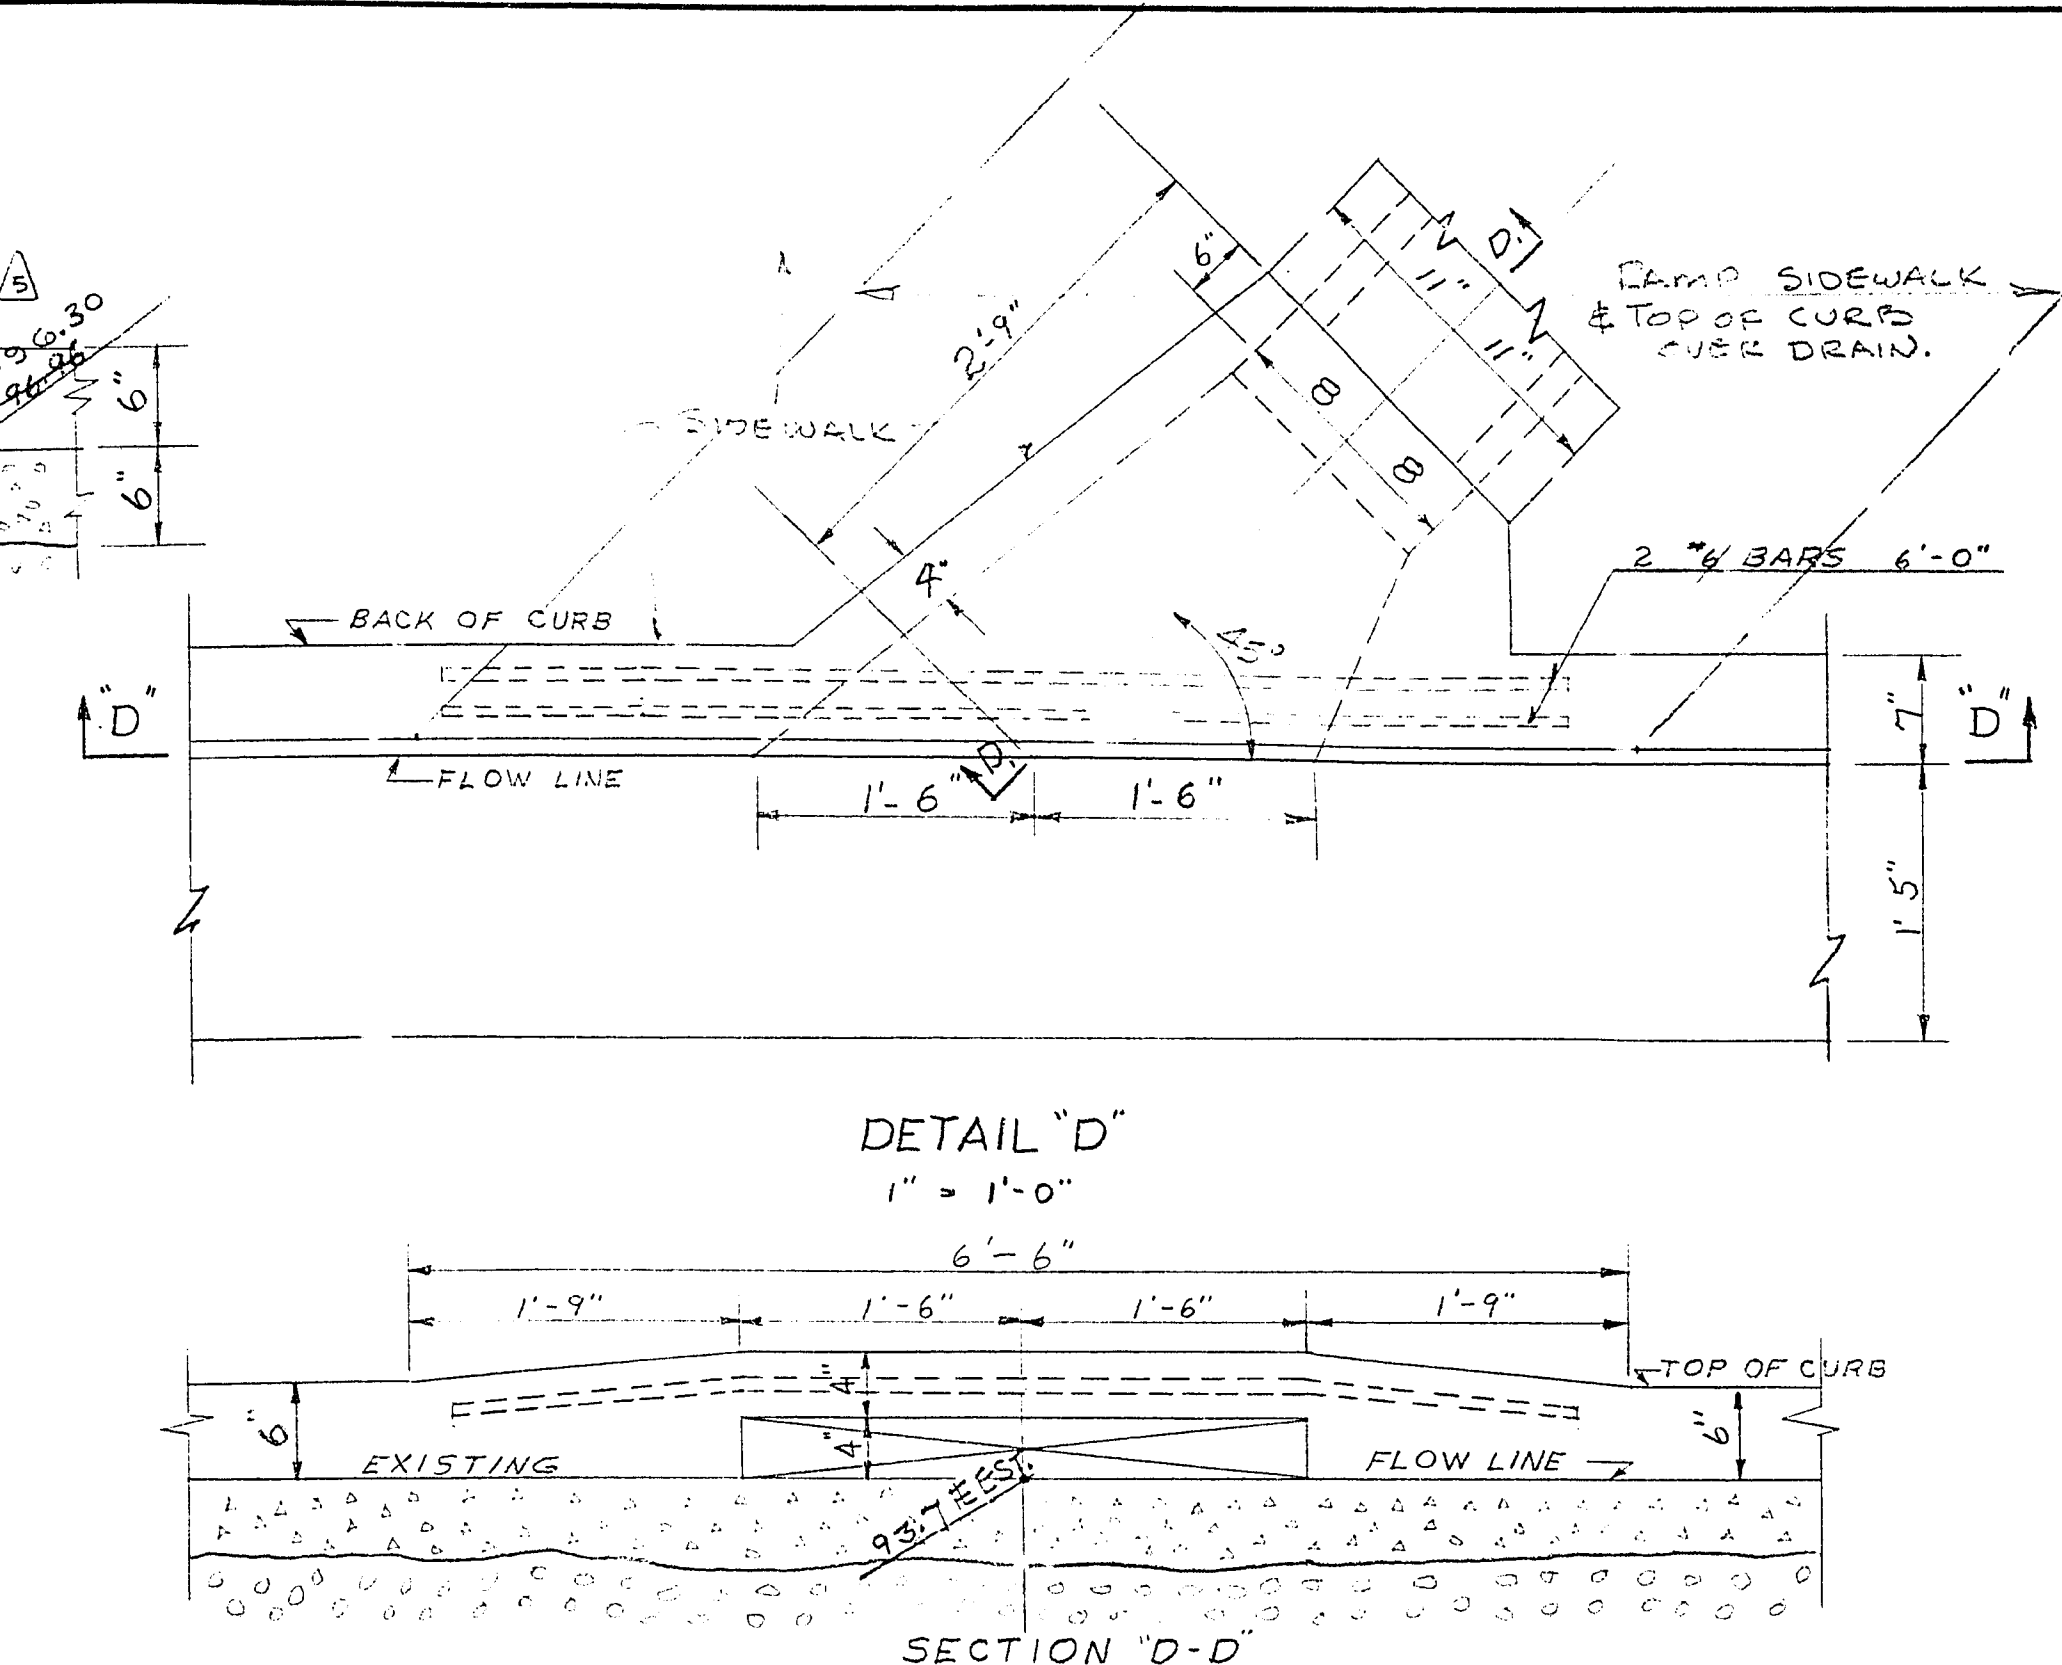
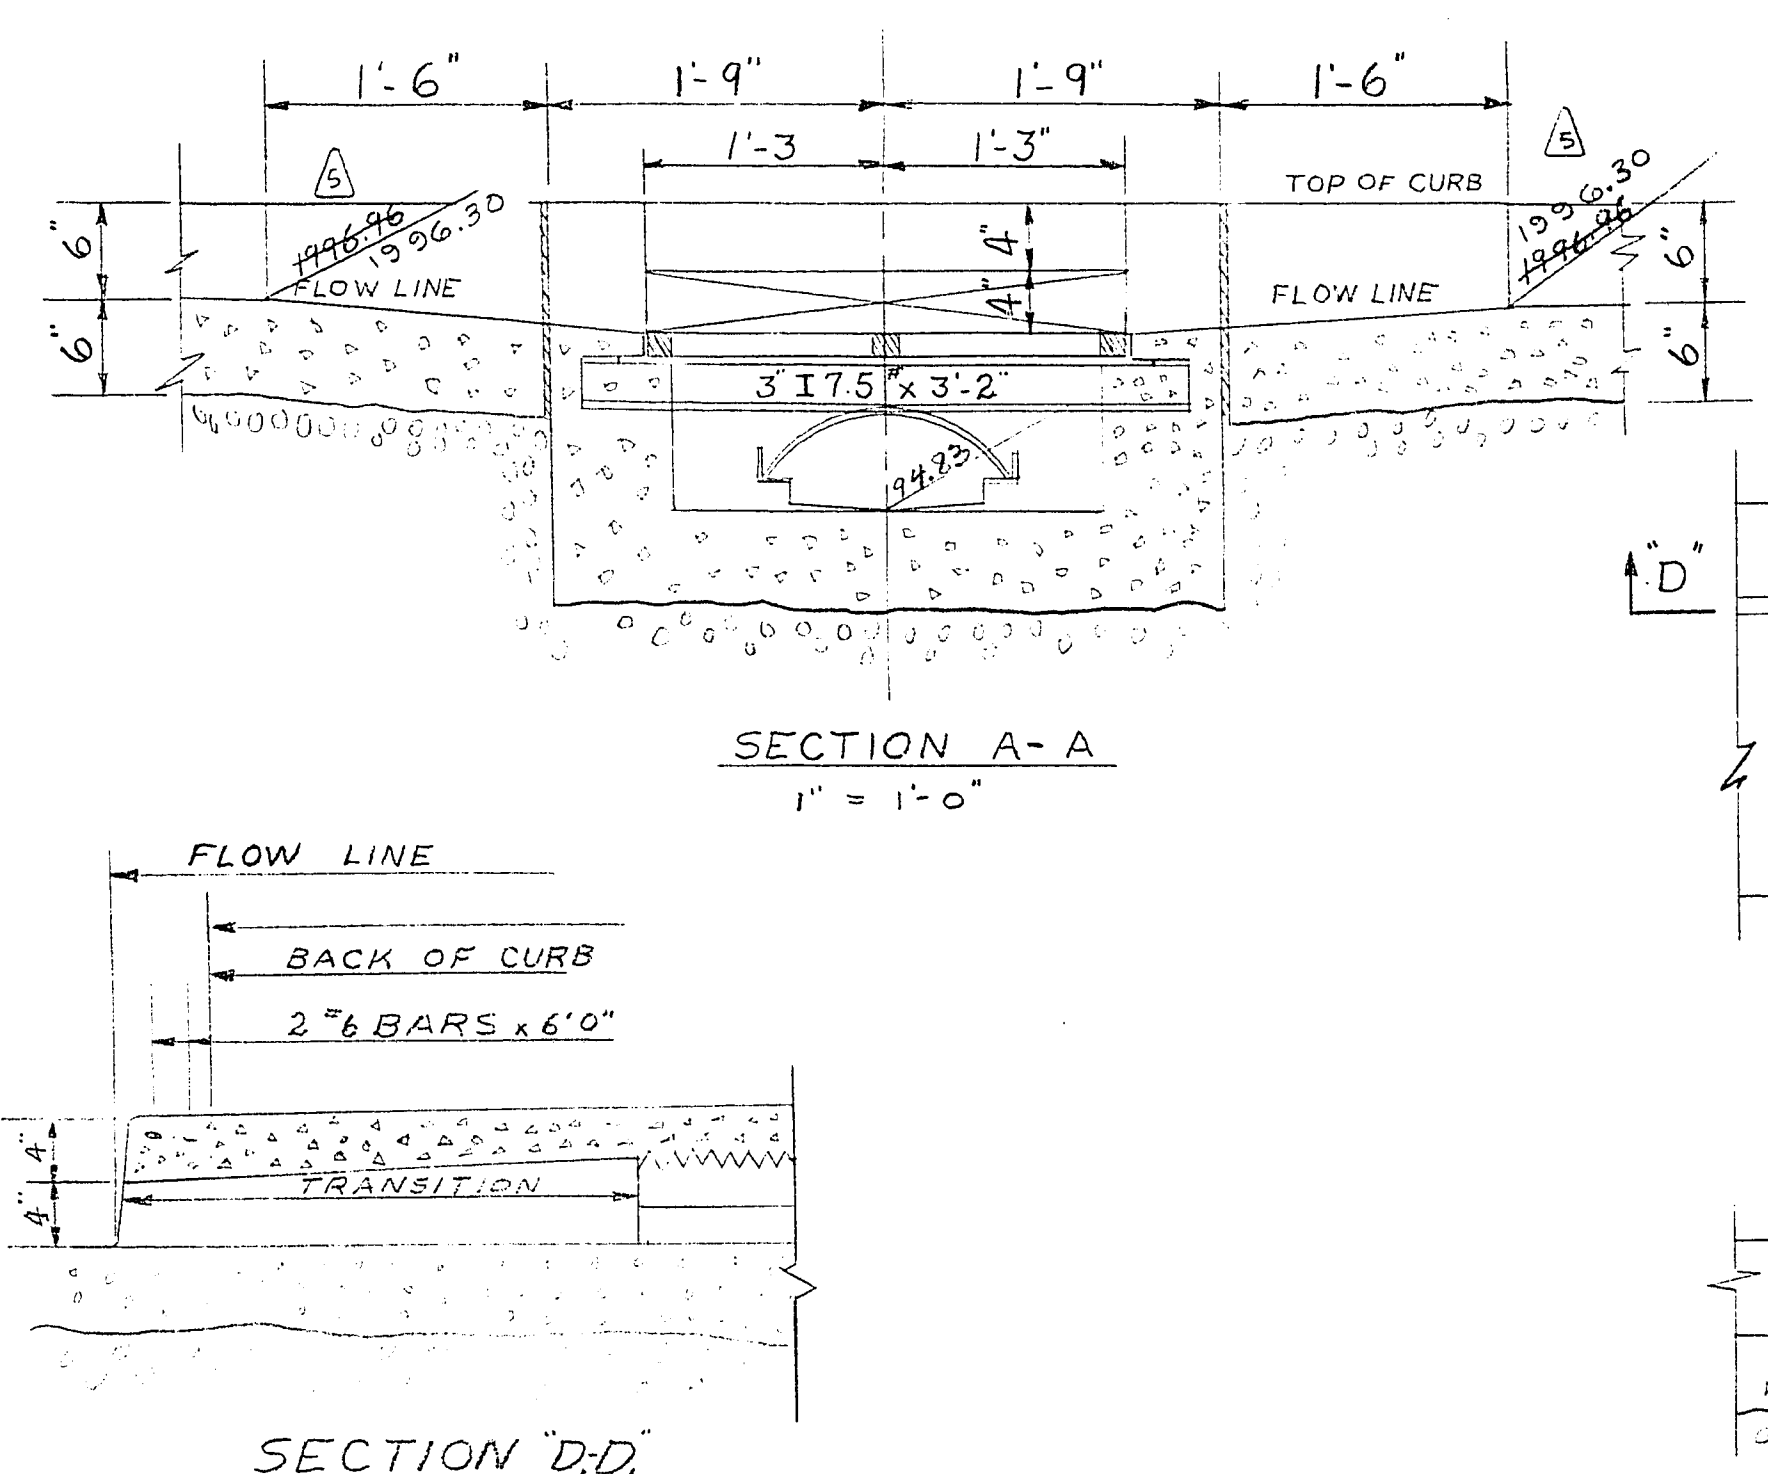
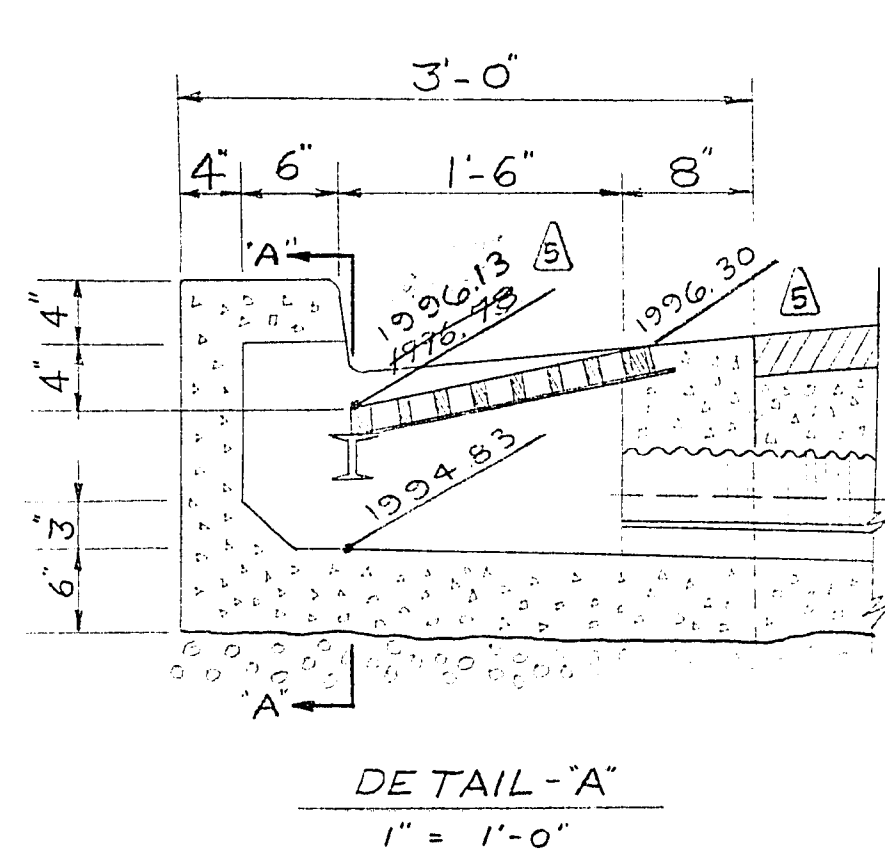
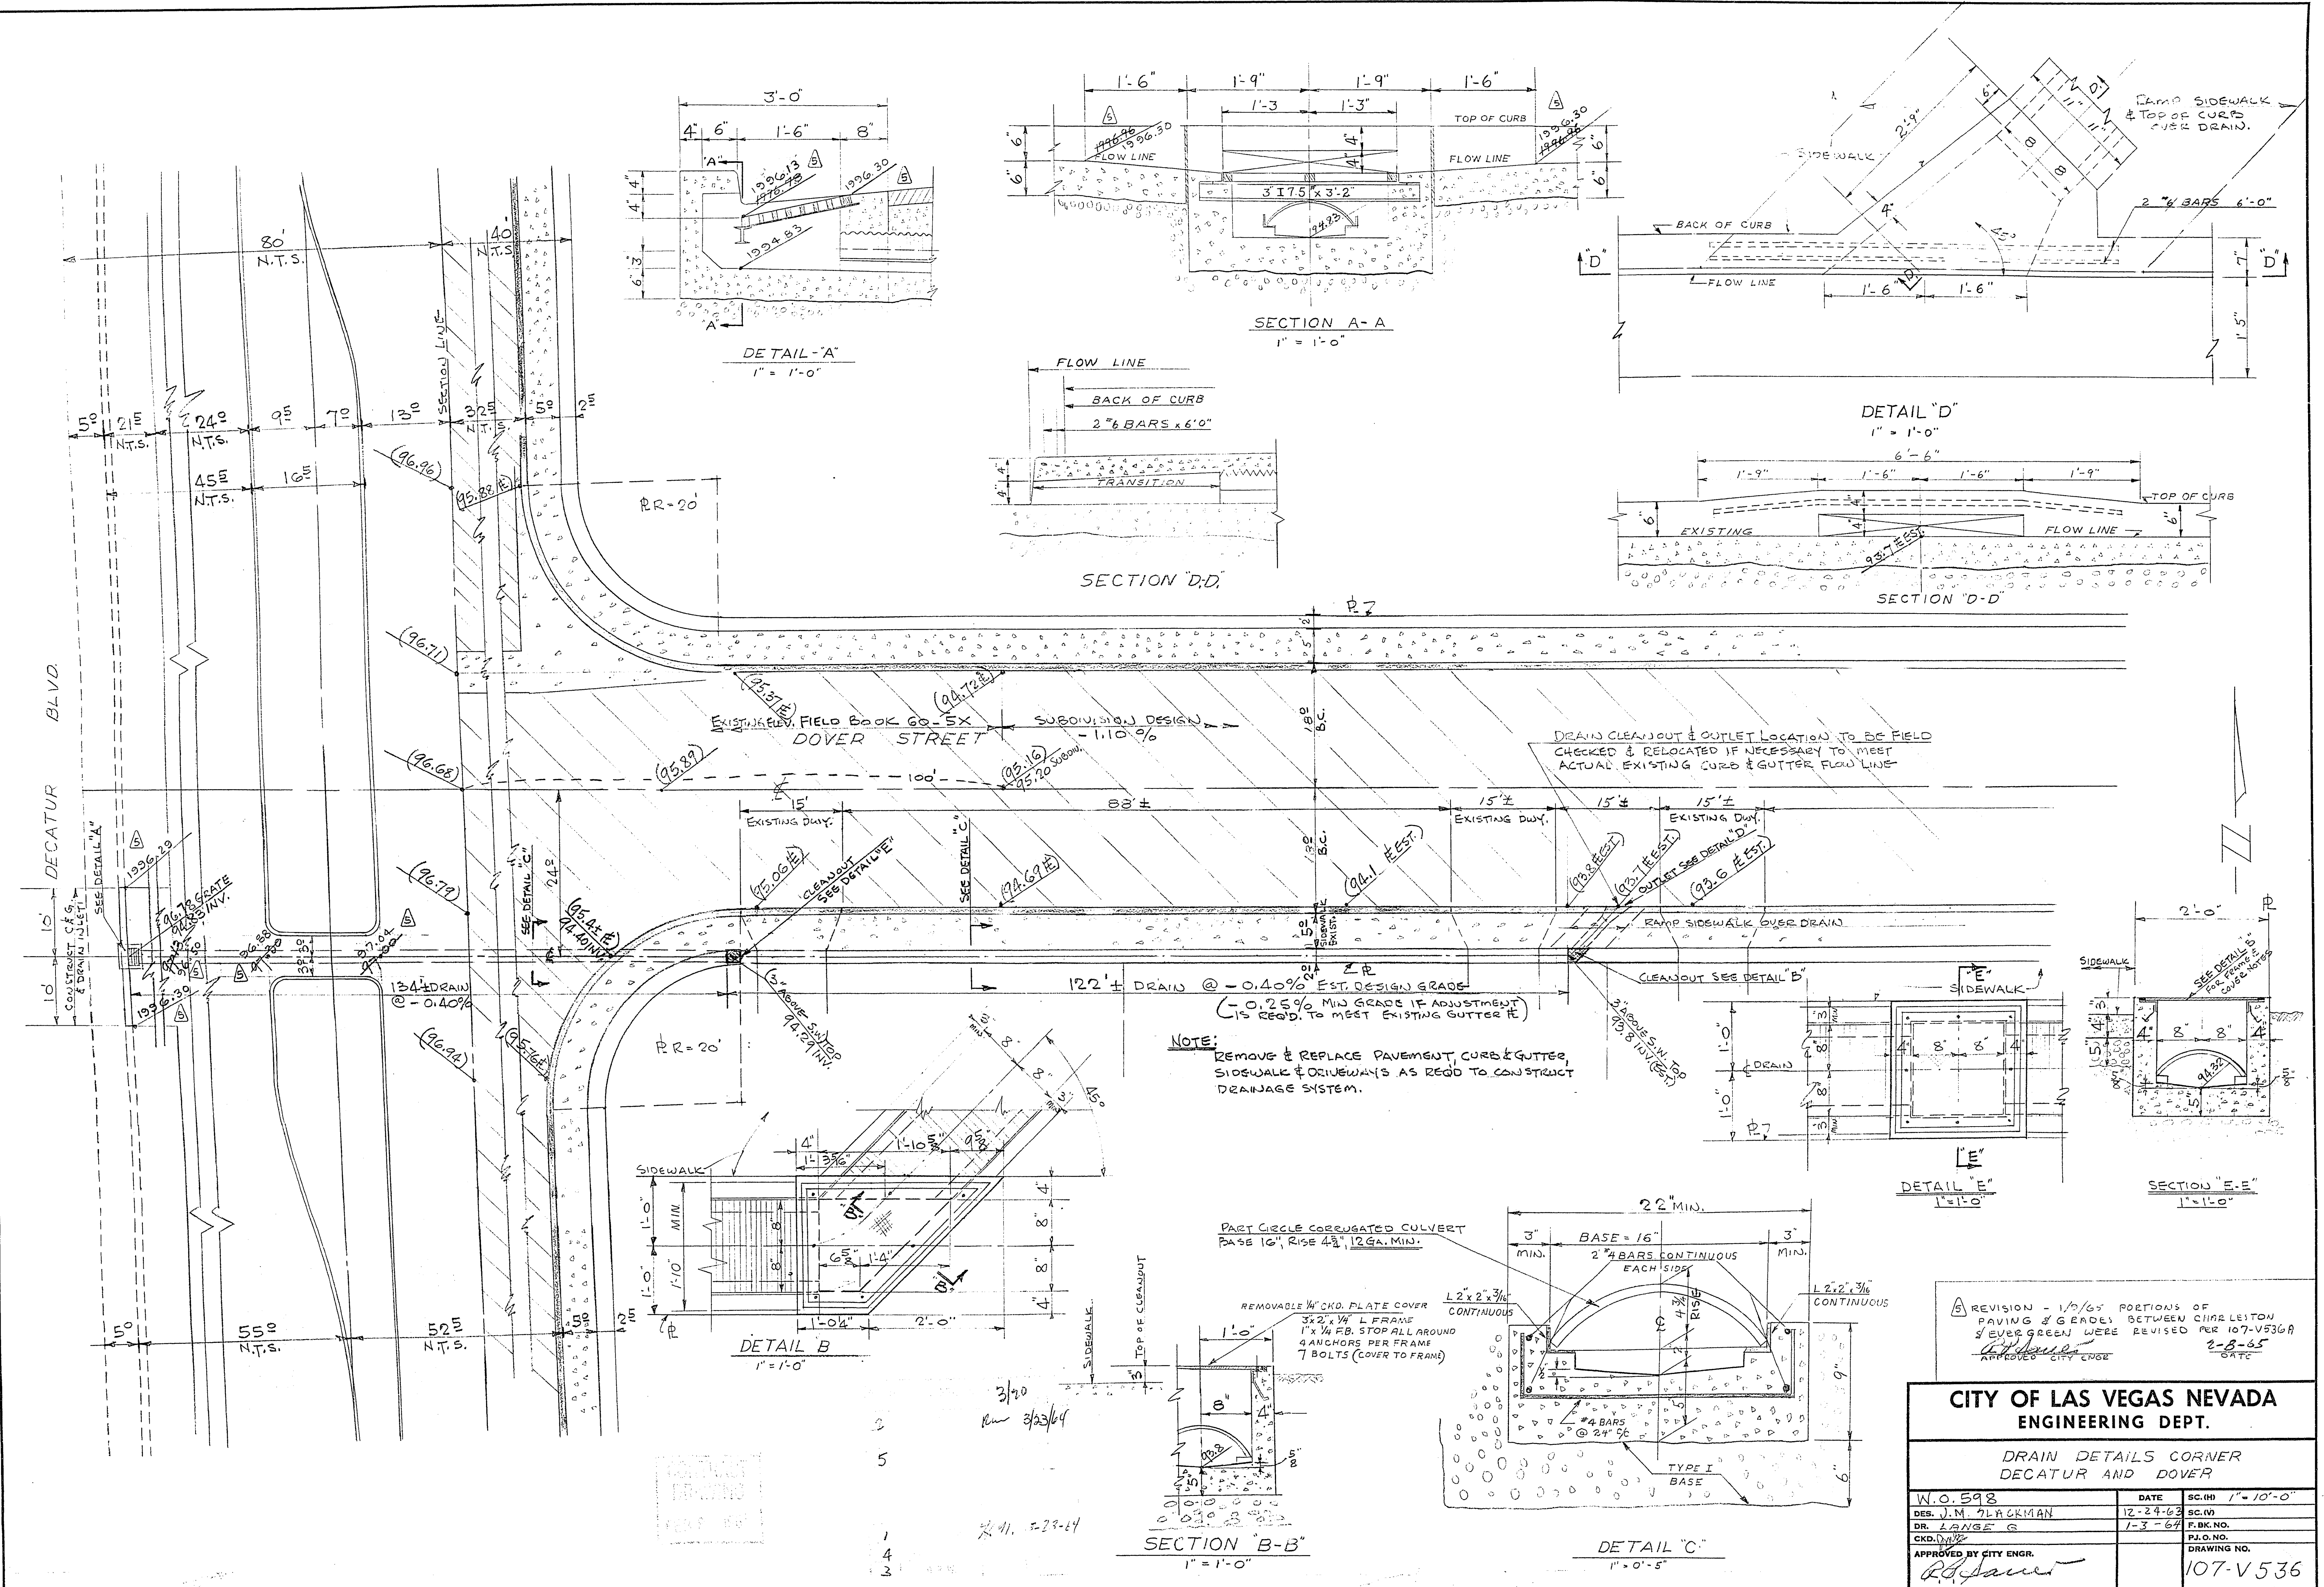
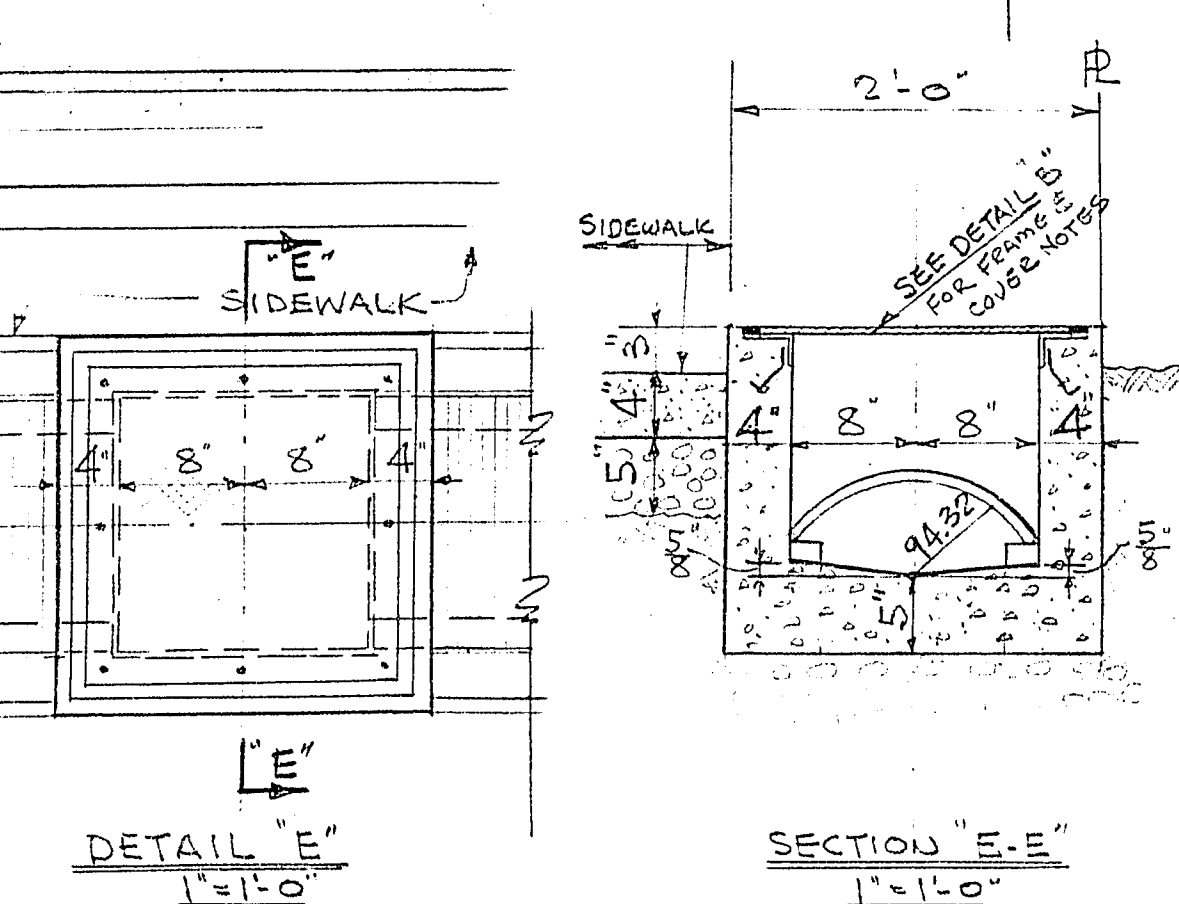
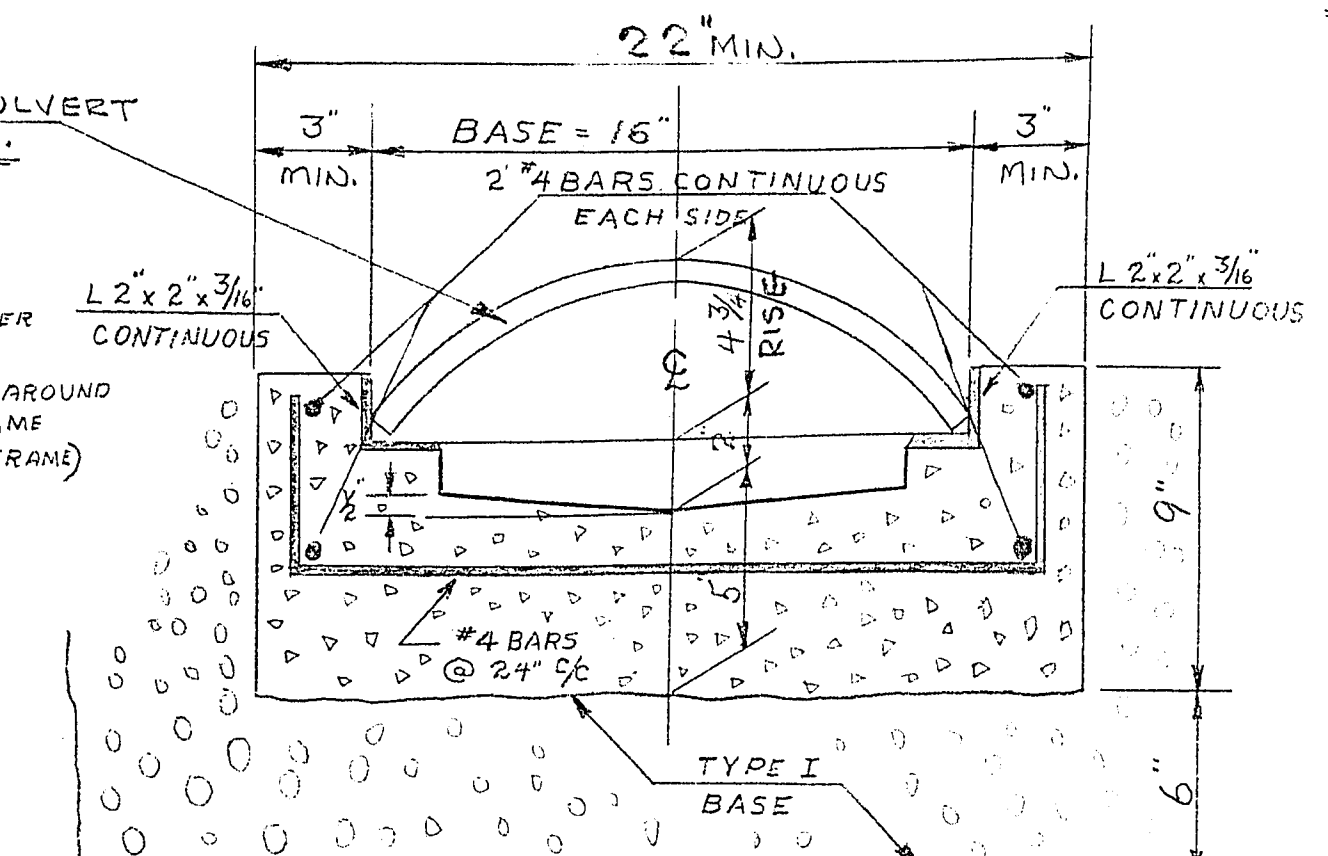


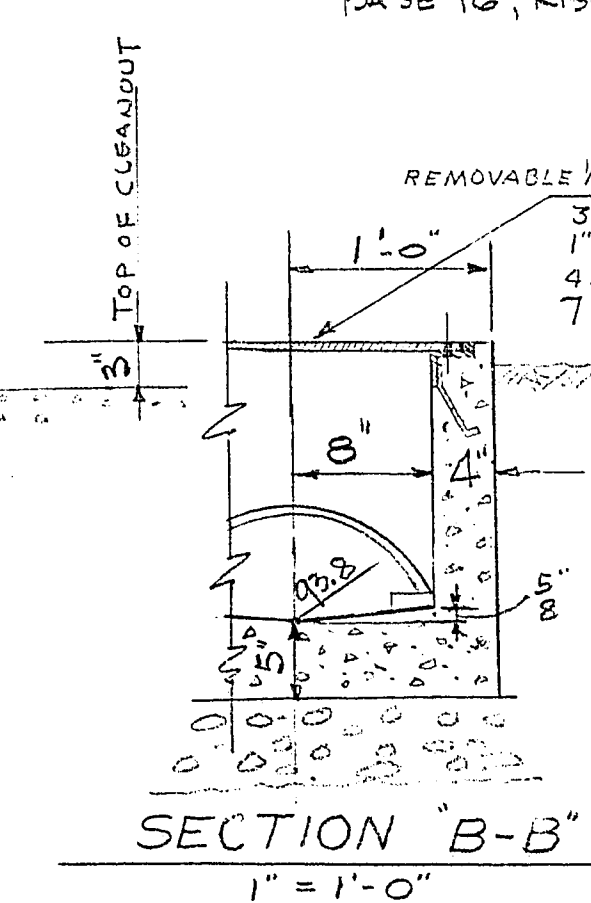

NOTE: REMOVE & REPLACE PAVEMENT, CURB & GUTTER, SIDEWALK & DRIVEWAYS AS REQD TO CONSTRUCT DRAINAGE SYSTEM.

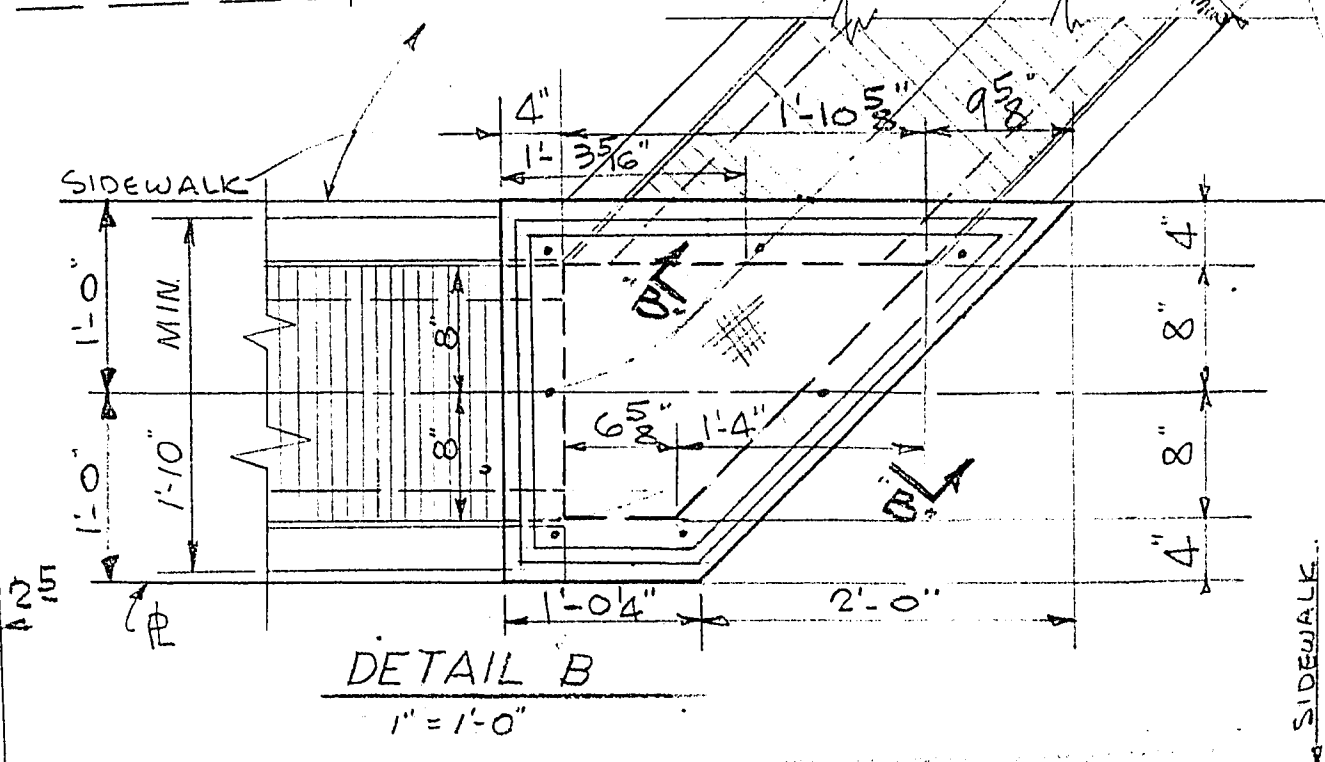

REVISION - 1/3/65 PORTIONS OF PAVING & GRADES BETWEEN CHARLESTON & EVERGREEN WERE REVISED PER 107-V536A
APPROVED CITY ENGR

CITY OF LAS VEGAS NEVADA ENGINEERING DEPT.			
DRAIN DETAILS CORNER DECATUR AND DOVER			
W.O. 598	DATE	SC. (H) 1" = 10'-0"	
DES. J.M. GLACKMAN	12-24-63	SC. (V)	
DR. LANGE	1-3-64	F.B.K. NO.	
CKD. [Signature]		P.J.O. NO.	
APPROVED BY CITY ENGR.		DRAWING NO.	
		107-V536	