


06-5-17

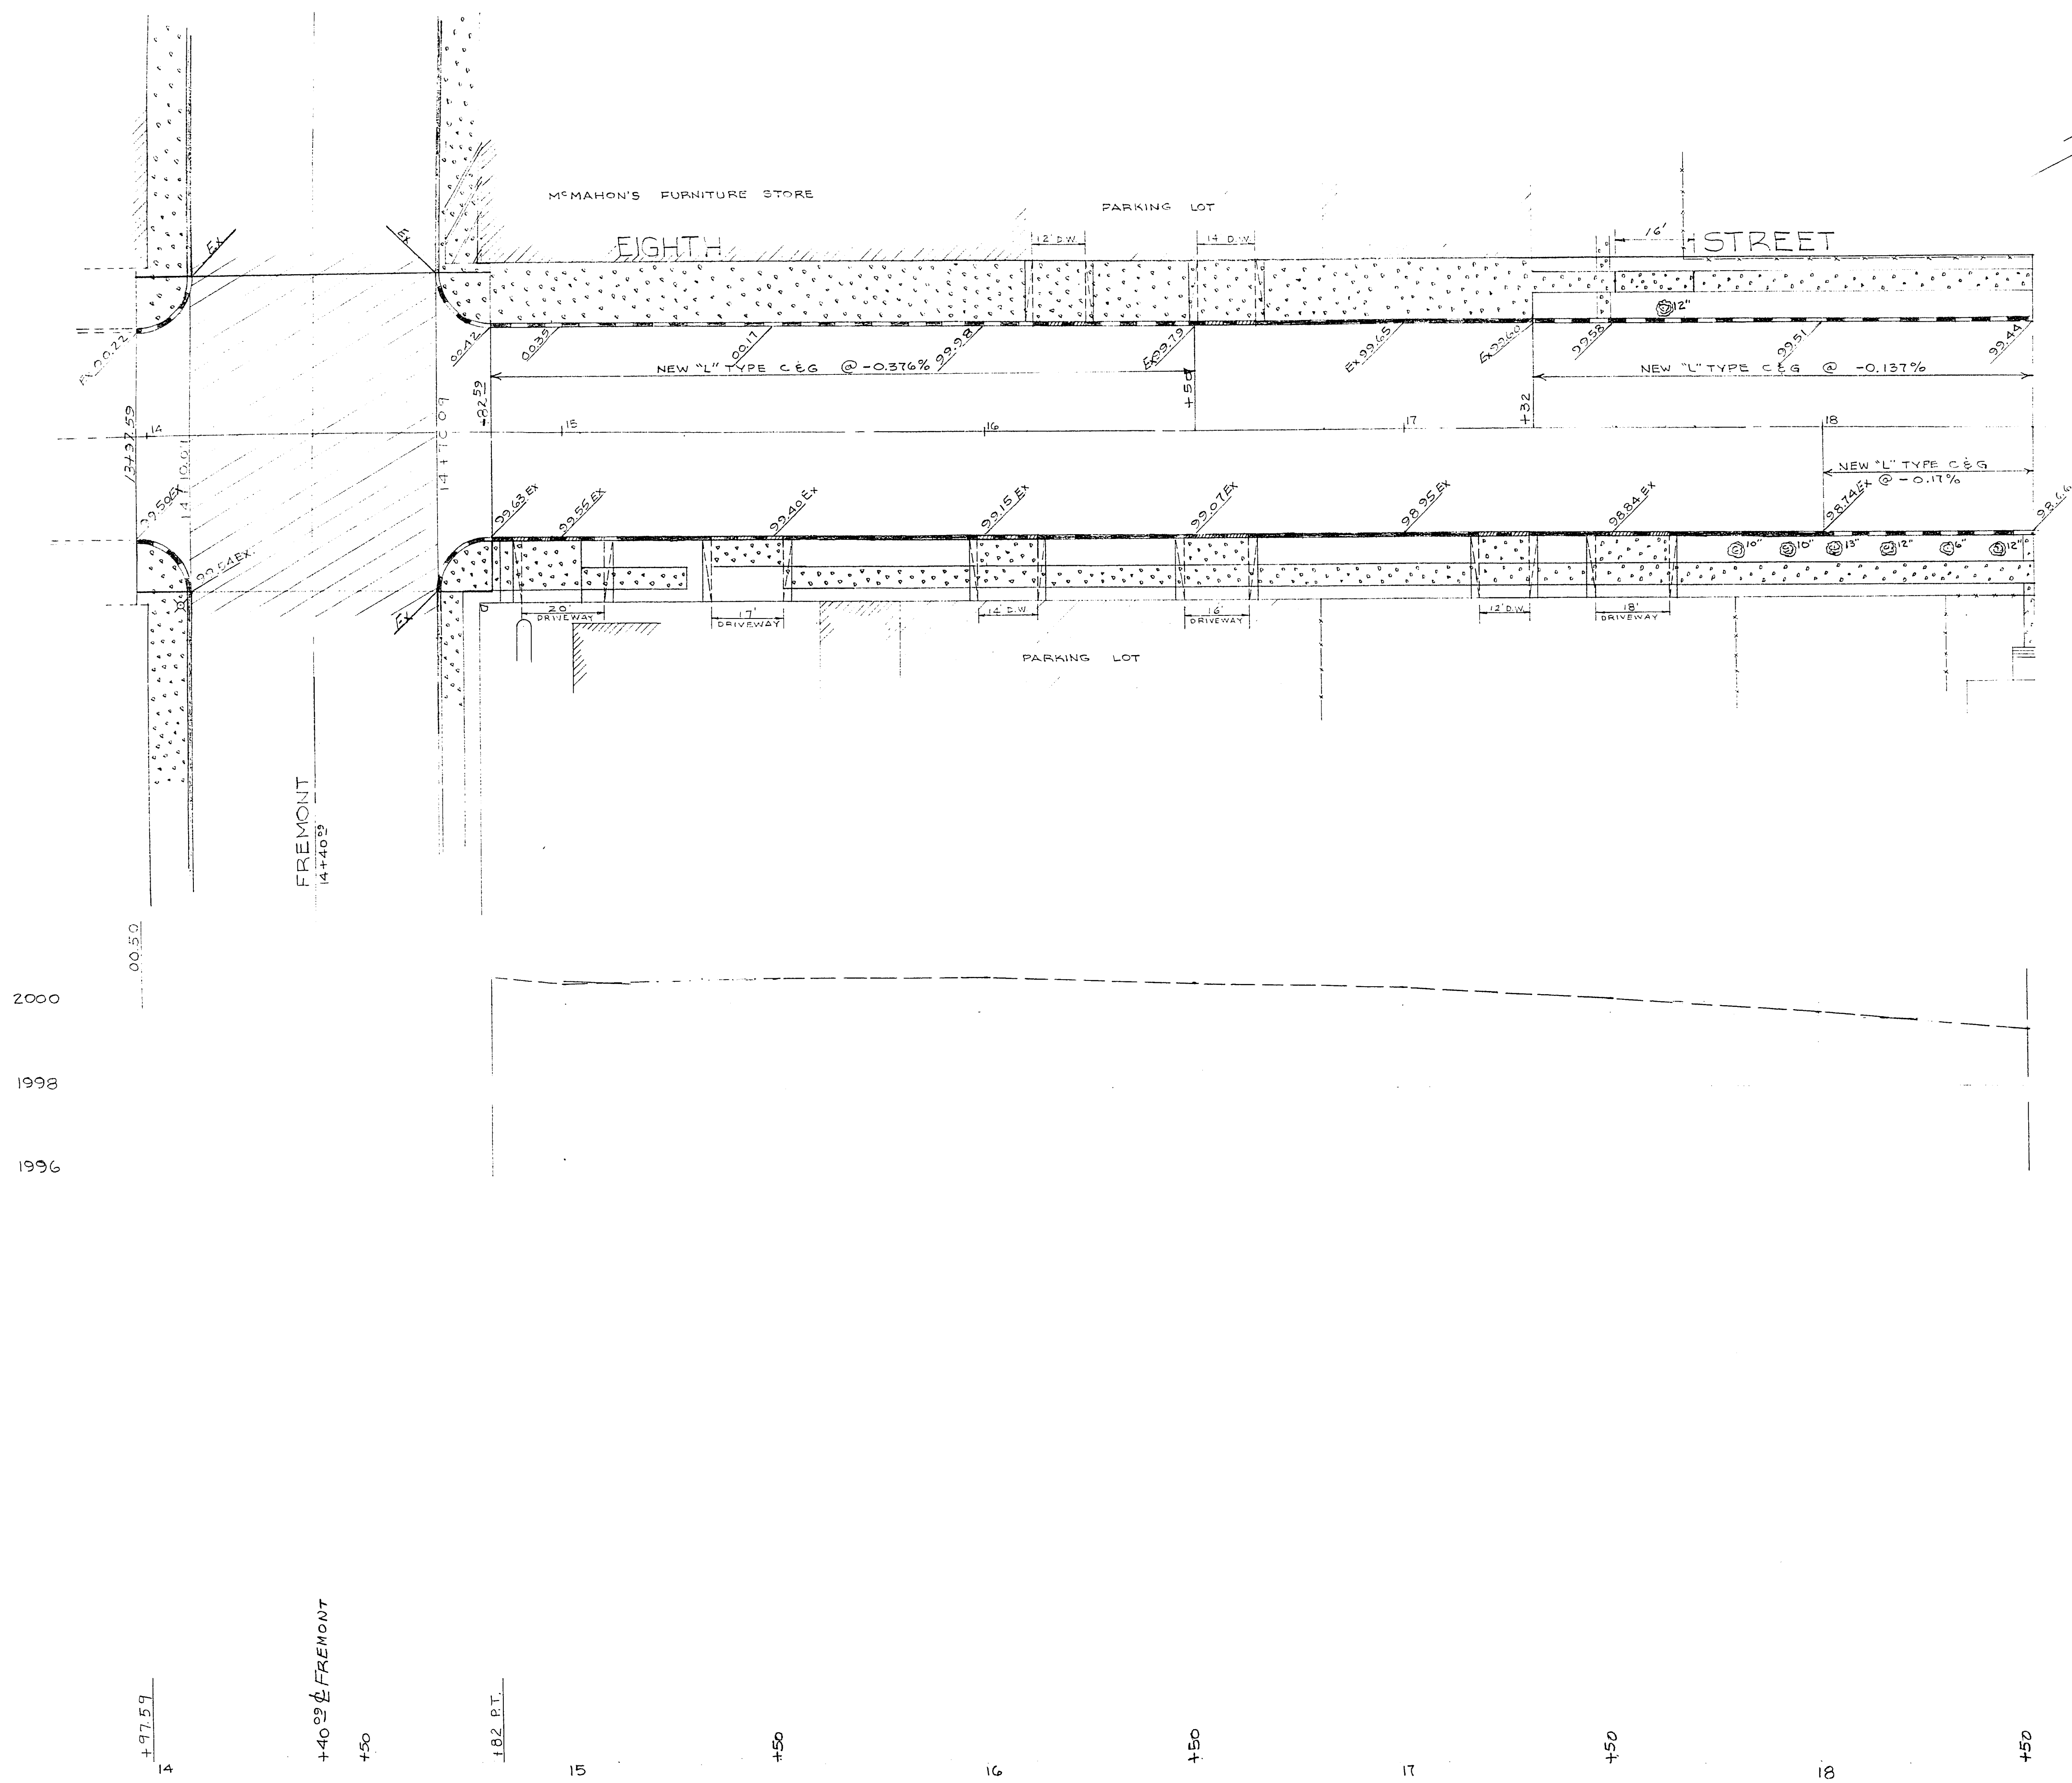

REV. 11-3-61 - REM. & REPL. 16' SW. WEST SIDE

S.A.D. 100-45

CITY OF LAS VEGAS NEVADA		
ENGINEERING DEPT.		
EIGHTH STREET- BRIDGER TO STEWART		
STA. 14+00 TO 18+50		
DES. <i>R.R. Patterson</i>	DATE 3-12-61	SC. 1/4" = 20'
DR. PATTERSON	1-30-61	SC. 1/4" = 2'
CHKD.		F.B.K. NO. 100-45-BK.5
APPROVED BY CITY ENGR.		P.J.O. NO. W 101
		DRAWING NO. 107-V6