


MONUMENT TIE MAP OF ESCALA UNIT NO. 1

A COMMON INTEREST COMMUNITY


BEING A SUBDIVISION OF A PORTION OF LOT 7, BLOCK B OF "SUMMERLIN VILLAGE 23A UNIT NO. 1" AS SHOWN IN BOOK 108, PAGE 29 OF PLATS, SITUATE IN SECTION 34, TOWNSHIP 20 SOUTH, RANGE 59 EAST, M.D.M., CITY OF LAS VEGAS, CLARK COUNTY, NEVADA

SURVEYOR'S CERTIFICATE

I, WILLIAM G. STOUT, A PROFESSIONAL LAND SURVEYOR LICENSED IN THE STATE OF NEVADA, DO HEREBY CERTIFY THAT THE MONUMENTS HAVE BEEN SET AND THE TIE DISTANCES ESTABLISHED AS SHOWN HEREON. THIS SURVEY WAS COMPLETED ON JANUARY 22, 2005.

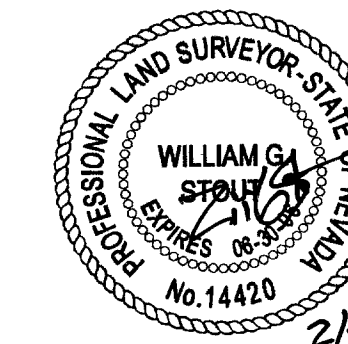

WILLIAM G. STOUT
PROFESSIONAL LAND SURVEYOR
NEVADA LICENSE NO. 14420

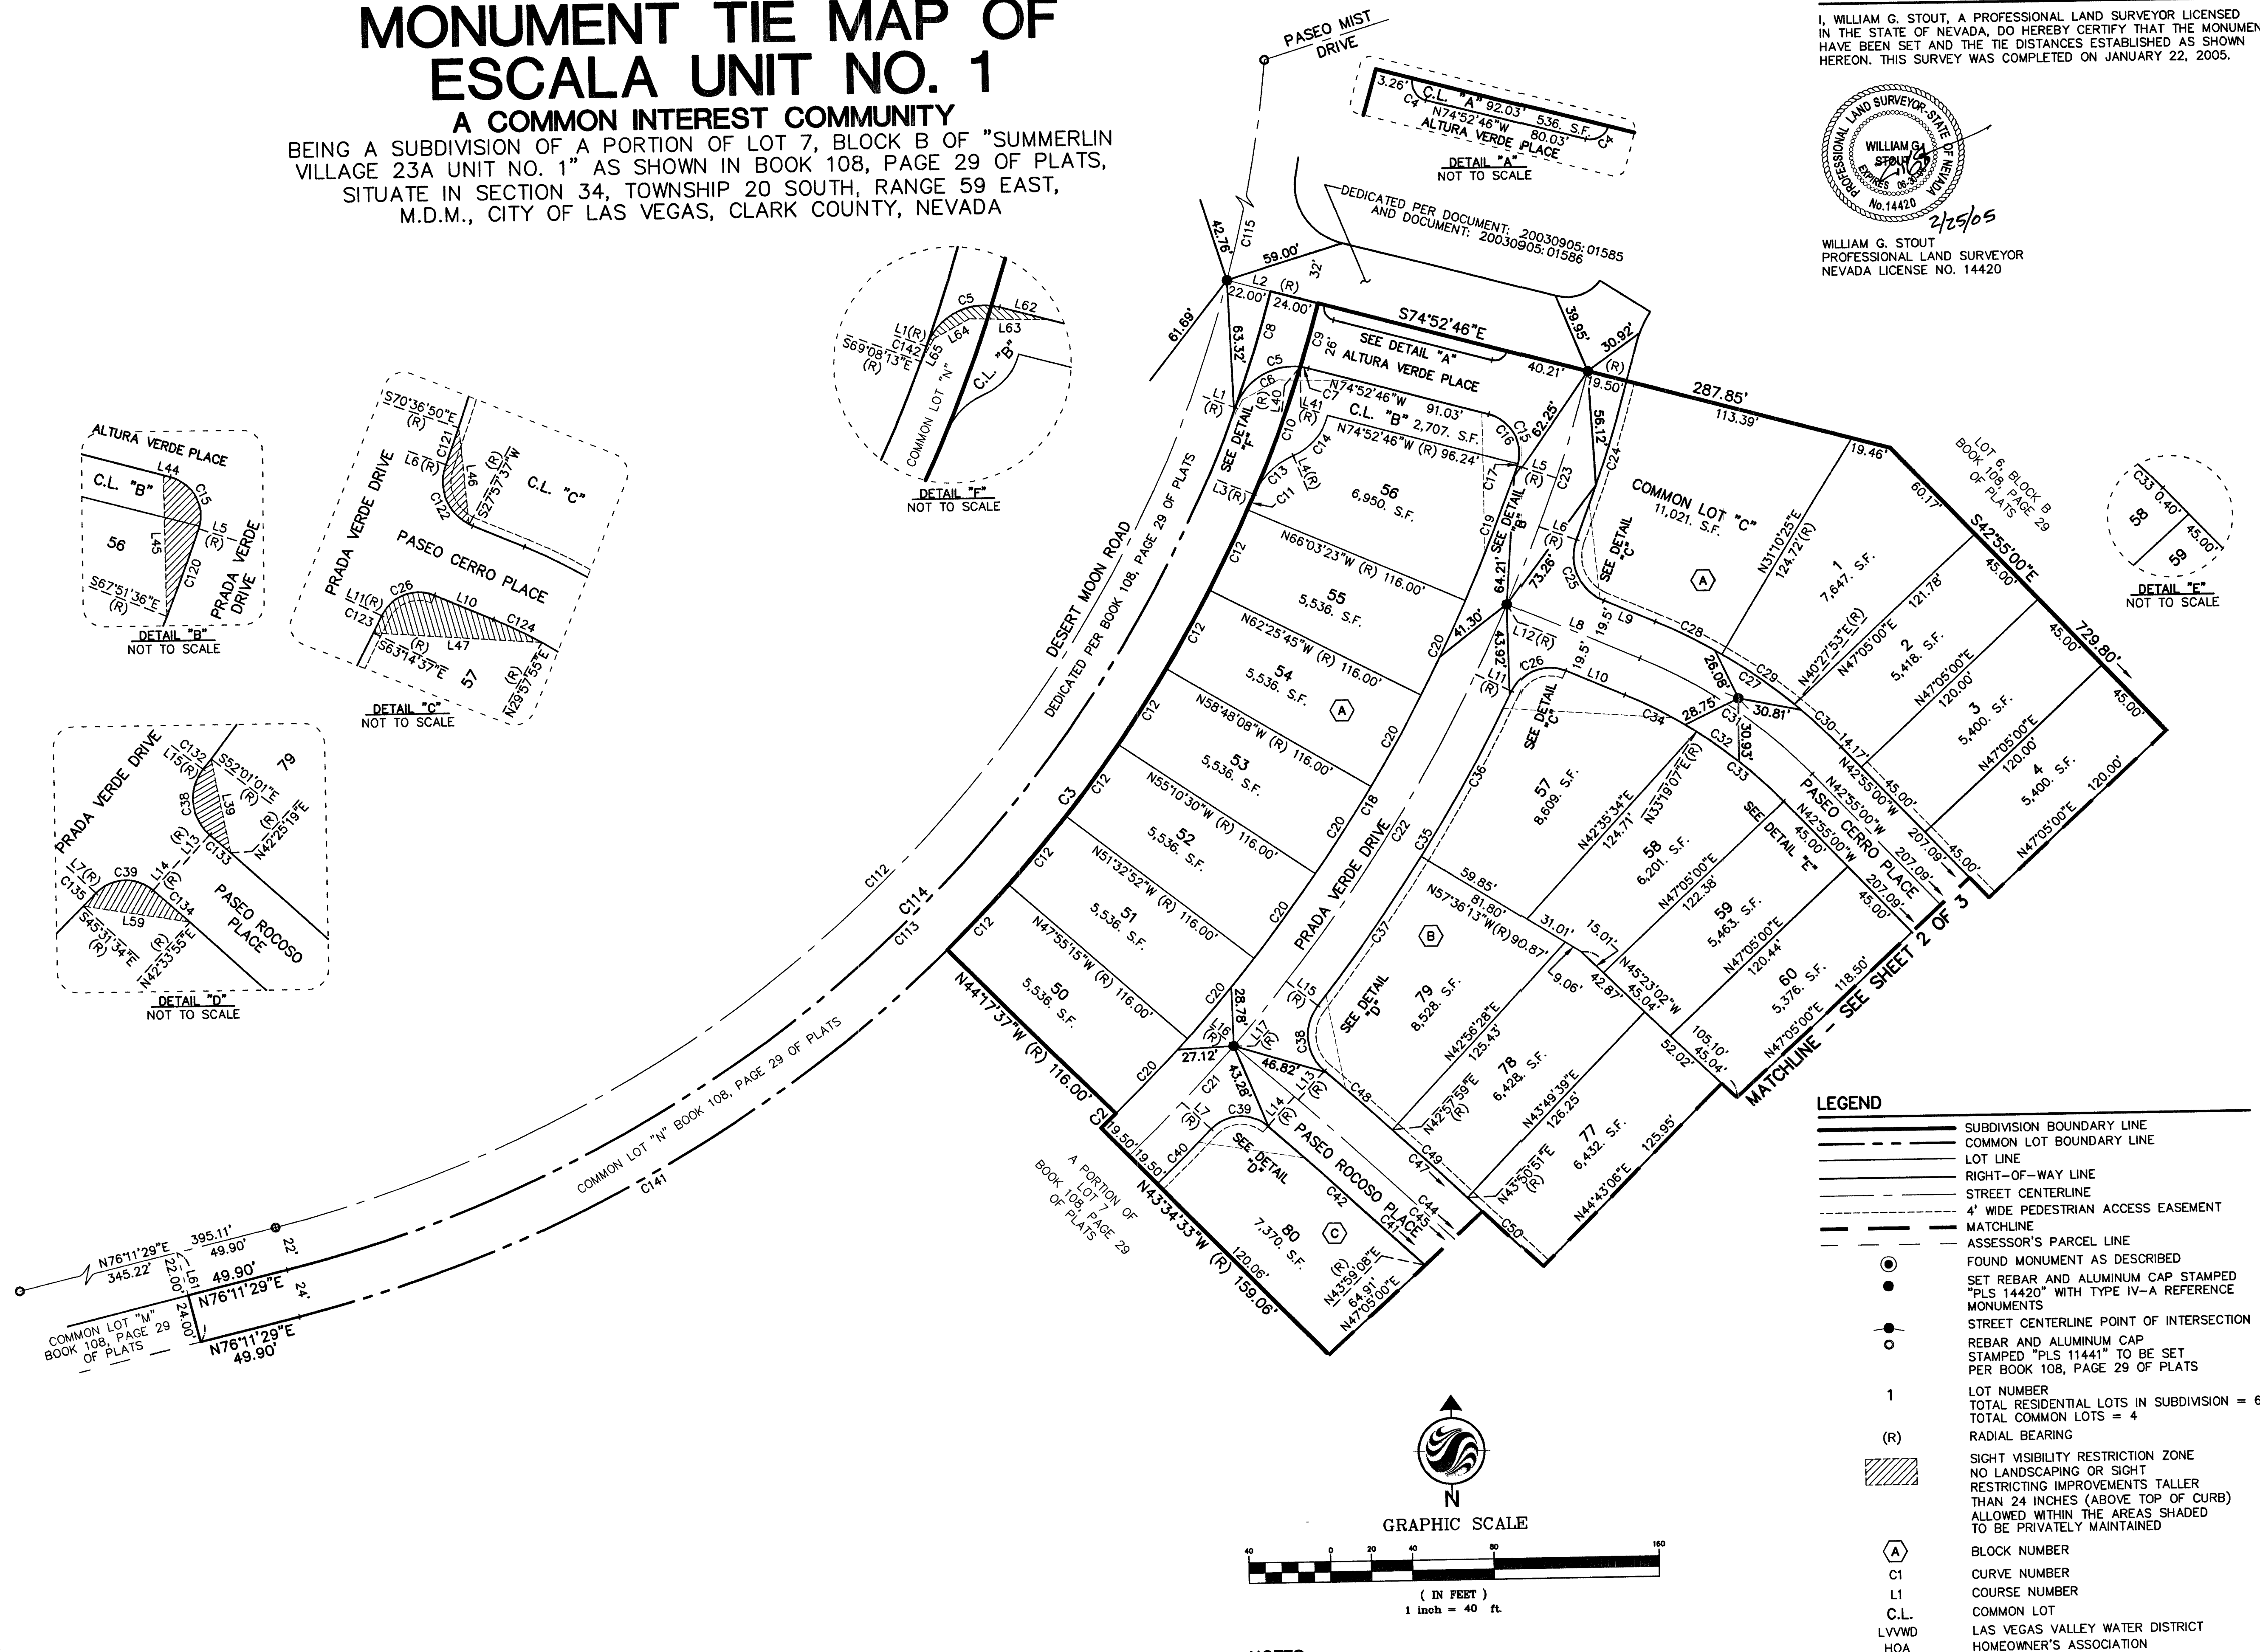

058-4770-1

PD/SLD

SHEET 1 OF 3

BOOK 112, PAGE 98 OF PLATS

15 FEBRUARY 2005

JOB# 80947090

81560