MONUMENT TIE MAP
ELKHORN / JONES

IN BOOK 114 PAGE 14 OF PLATS, IN THE CLARK COUNTY RECORDER'S OFFICE, CLARK COUNTY, NEVADA. LYING WITHIN THE EAST HALF (E 1/2) OF THE SOUTHEAST QUARTER (SE 1/4) OF SECTION 14, TOWNSHIP 19 SOUTH, RANGE 60 EAST, M.D.M., CITY OF LAS VEGAS, CLARK COUNTY, NEVADA

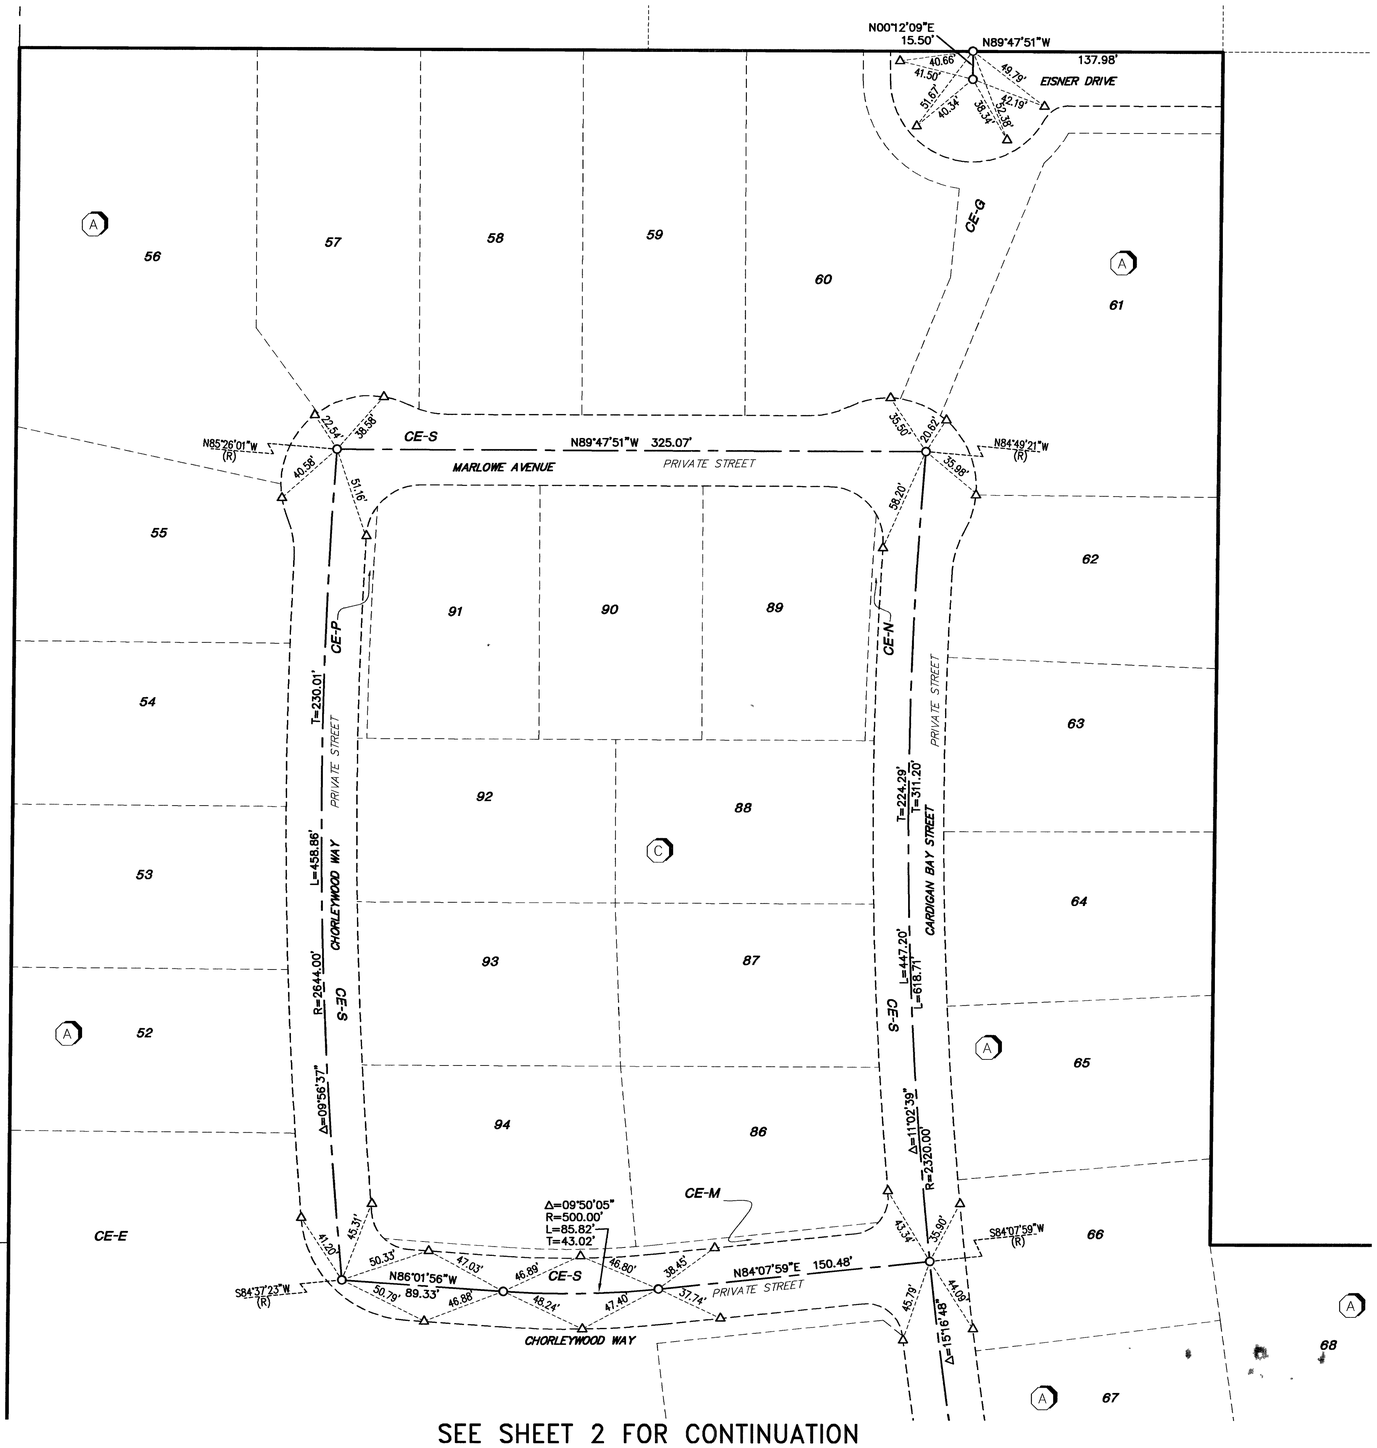

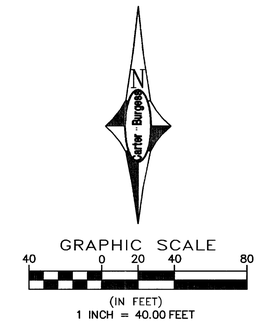

SURVEYOR'S CERTIFICATE:

I, BARRY D. BRULAND, A PROFESSIONAL LAND SURVEYOR, LICENSED IN THE STATE OF NEVADA, AS AN AGENT FOR CARTER AND BURGESS, INC., DO HEREBY CERTIFY THAT:

1. THIS PLAT REPRESENTS THE RESULTS OF A SURVEY CONDUCTED UNDER MY DIRECT SUPERVISION AT THE INSTANCE OF U S HOME CORPORATION, A DELAWARE CORPORATION.

2. THE MONUMENTS HAVE BEEN SET AND THE TIE DISTANCES ESTABLISHED AS SHOWN HEREON. THIS SURVEY WAS COMPLETED ON MAY 30, 2006.

BARRY D. BRULAND
PROFESSIONAL LAND SURVEYOR
NEVADA CERTIFICATE NO. 8352

PROFESSIONAL LAND SURVEYOR — BARRY D. BRULAND — No. 8352 — EXPIRES 12-31-06 — STATE OF NEVADA

5/30/06

LEGEND

- SUBDIVISION BOUNDARY LINE
- RIGHT-OF-WAY LINE
- SECTION LINE
- STREET CENTERLINE
- LOT LINE
- 17 — LOT NUMBER
- ○ — TYPE III MONUMENTS SET PER BOOK 114, PAGE 14 OF PLATS STAMPED PLS 8352
- △ — TYPE IV MONUMENTS SET PER BOOK 114, PAGE 14 OF PLATS STAMPED PLS 8352
- TYPE I MONUMENT SET PER BOOK 114, PAGE 14 OF PLATS STAMPED PLS 8352
- FOUND MONUMENT AS DECRIBED

BASIS OF BEARINGS

NORTH 00° 38' 00" EAST, BEING THE EASTERLY LINE OF THE SOUTHEAST QUARTER (SE 1/4) OF SECTION 14, TOWNSHIP 19 SOUTH, RANGE 60 EAST, M.D.M, CLARK COUNTY NEVADA. AS SHOWN BY MAP THEREOF IN FILE 114, PAGE 14 OF PLATS, IN THE CLARK COUNTY RECORDER'S OFFICE, CLARK COUNTY, NEVADA.

SEE SHEET 2 FOR CONTINUATION

Carter :: Burgess
Consultants in Planning, Engineering, Construction Management, and Related Services
6655 Bermuda Road
Las Vegas, Nevada 89119
(702) 938-5400
(702) 938-5454

050-4783

SCALE:	1"= 40'	JOB NO.:	240567	SHEET	OF
DRAWING FILE:	567_MON	DRN. BY:	EO/JF	1	5
DATE:	09-22-2004	CKD. BY:			

92610