



GENERAL LINE AND SYMBOL LEGEND

- T- -T- BURIED TELEPHONE CONDUIT SYSTEM
- W - W - Las Vegas Valley Water District Water Pipe
- S - S - Sanitary Sewer
- G - G - Southwest Gas S.H.P.
- 36- Section and Survey Line
- 31- Centerline (Right of Way)


- Telephone Manhole
- Sanitary Sewer Manhole
- Power Pole
- Street Light
- Traffic Signal
- W-Water or G-Gas Valve
- Existing Drop Inlet
- Fire Hydrant
- Pull Box
- Traffic Signal Controller
- Existing Asphalt Pavement to Remain
- New Asphalt Pavement Construction
- Remove and Replace Asphalt Pavement
- Construct Temporary Asphalt Curb
- Existing Concrete Curb and Gutter
- Construct Concrete Curb and Gutter per Detail "B" This Sheet
- Construct Concrete Curb and Gutter per Detail "A" This Sheet

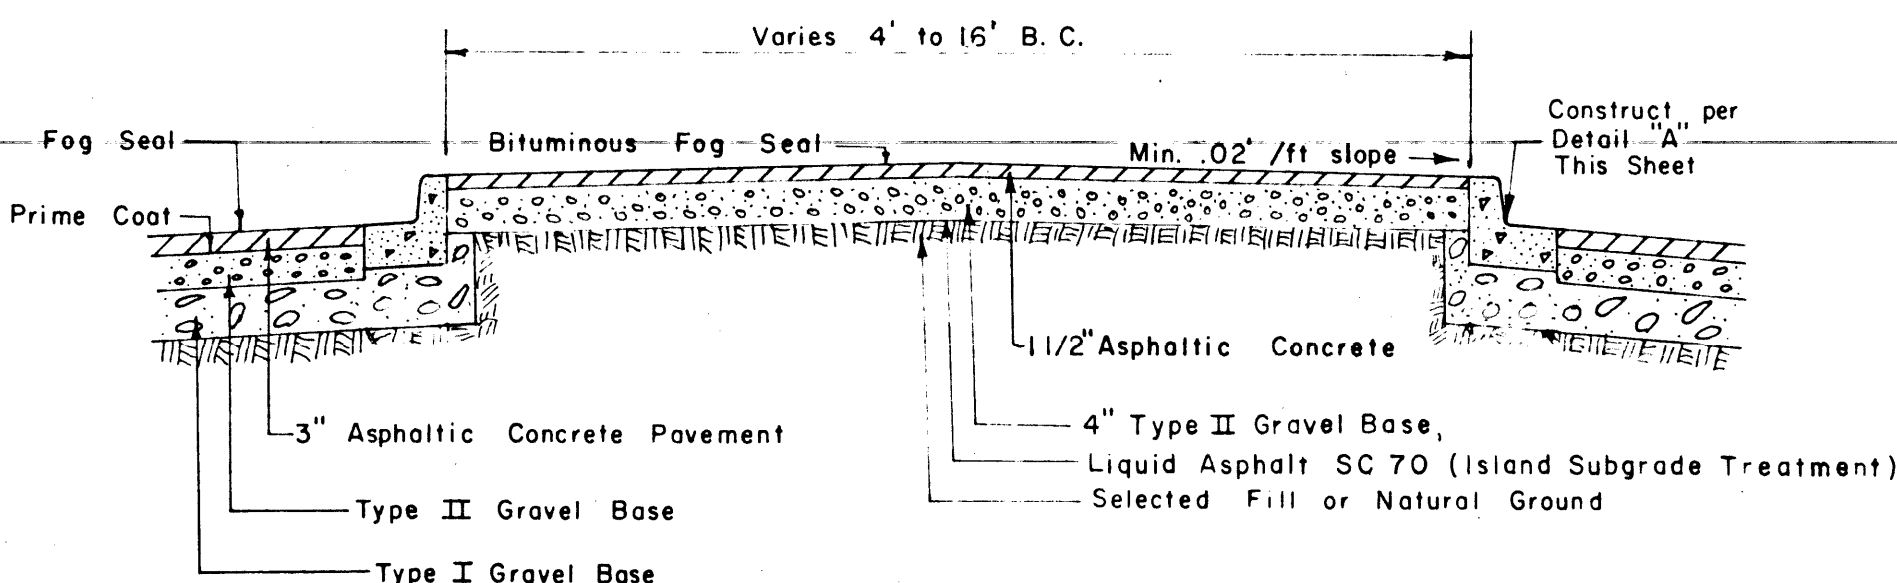


SECTION A-A
TYPICAL DETAIL - ASPHALT PAVED ISLANDS
no scale

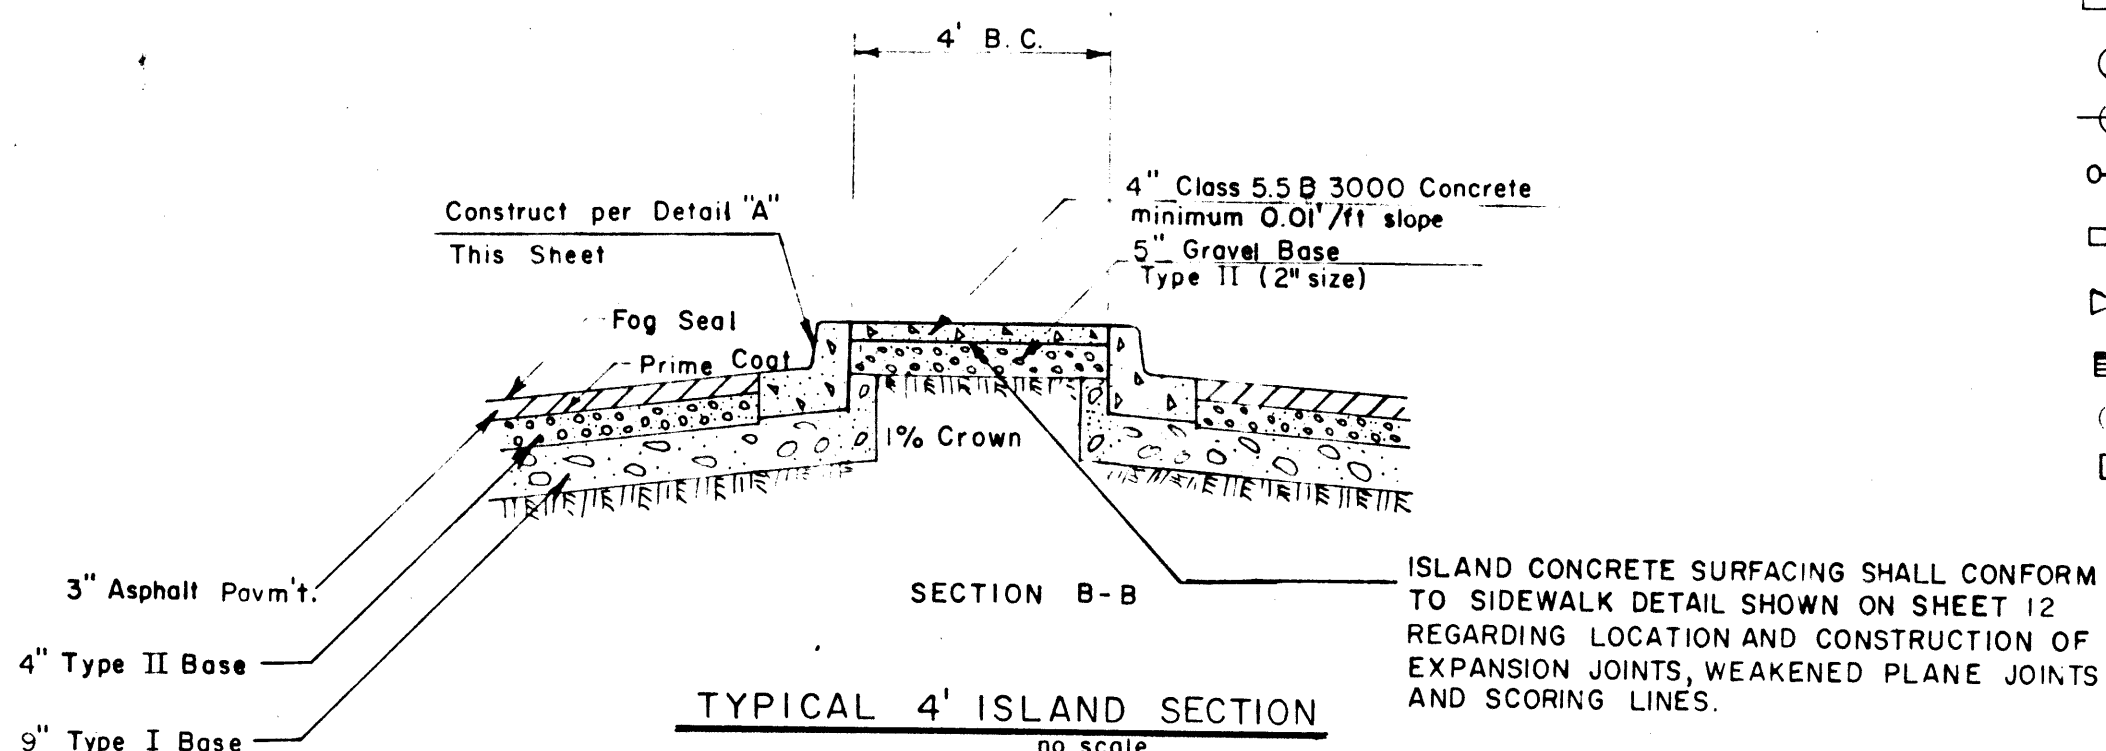

SECTION B-B
TYPICAL 4' ISLAND SECTION
no scale

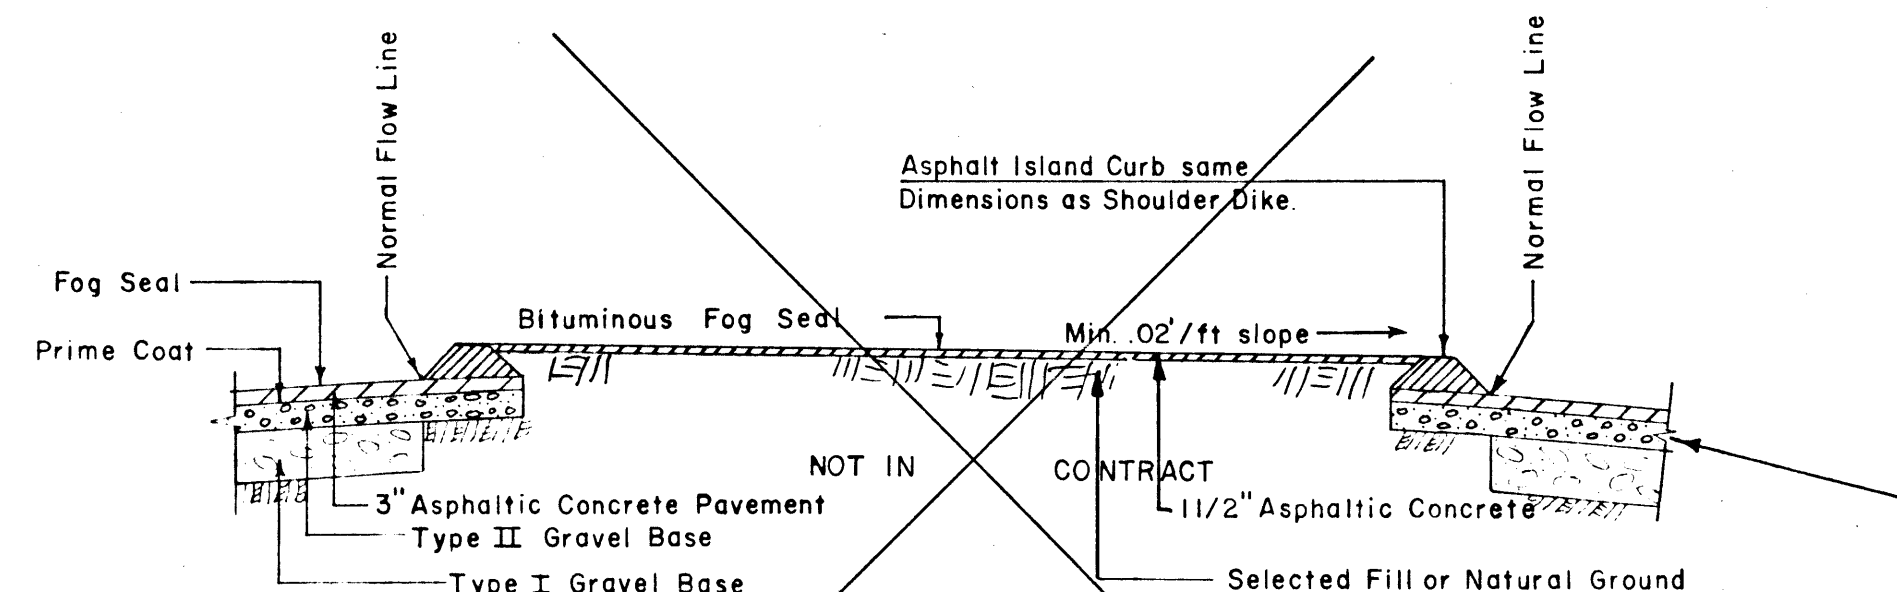


TYPICAL SECTION C-C
TEMPORARY ASPHALT ISLAND DETAIL
STATION 23+50 NORTH
no scale

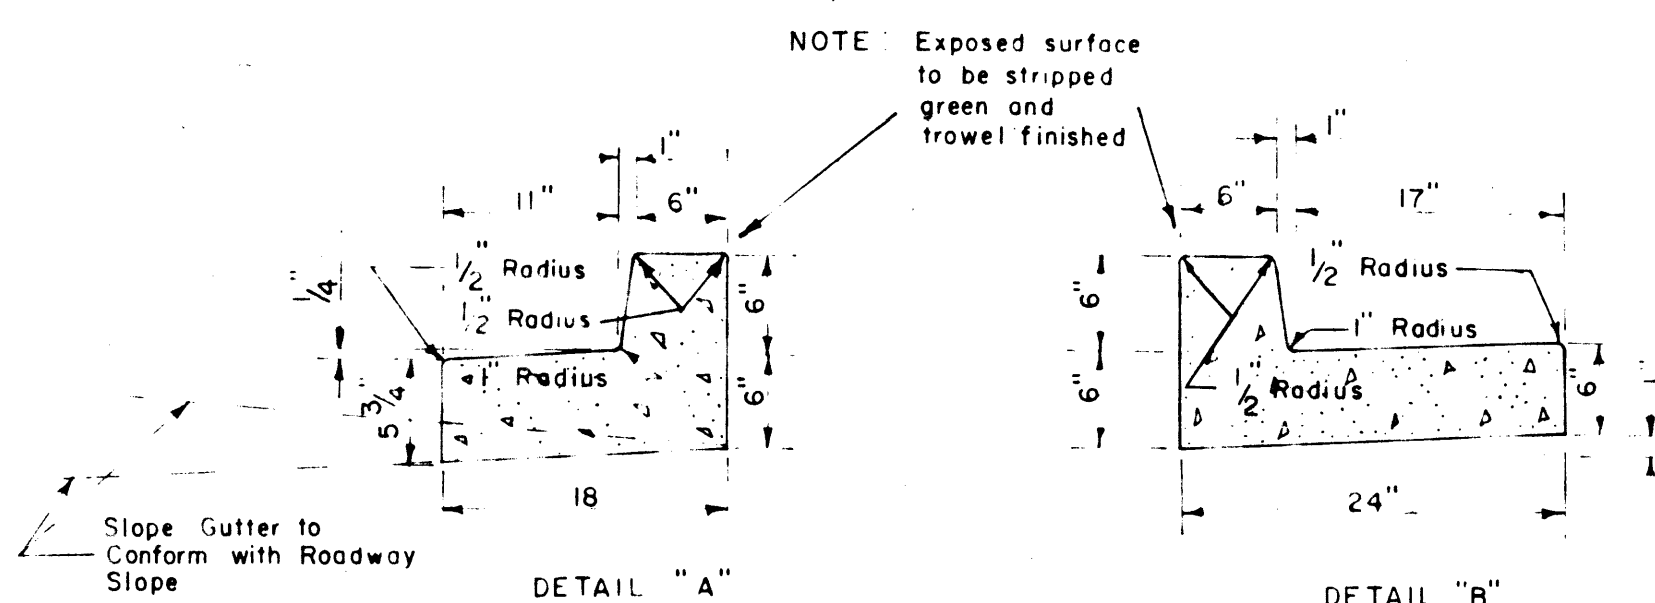


ISLAND CURB and GUTTER
0.03160 cu. yds. per ft.
CLASS 5.5 B 3000 Concrete
no scale


STANDARD "L" TYPE CURB and GUTTER
0.04617 cu. yds. per ft.
CLASS 5.5 B 3000 Concrete
no scale

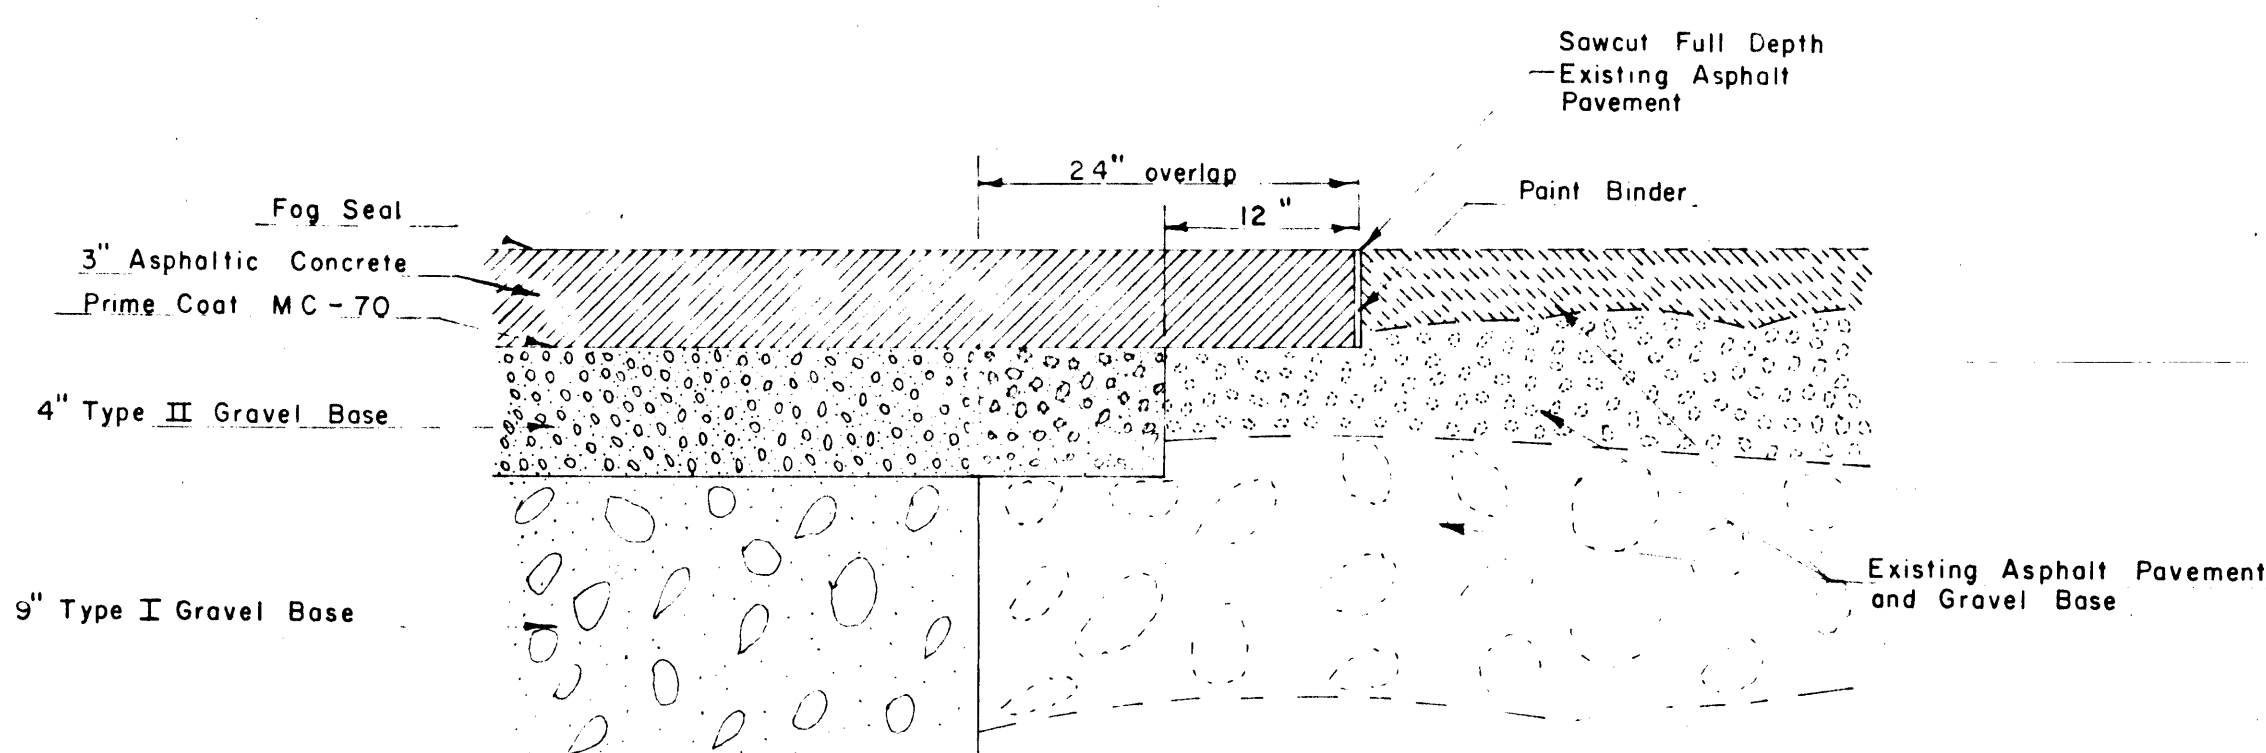


TYPICAL DETAIL
PAVEMENT JOINTING DETAIL
no scale

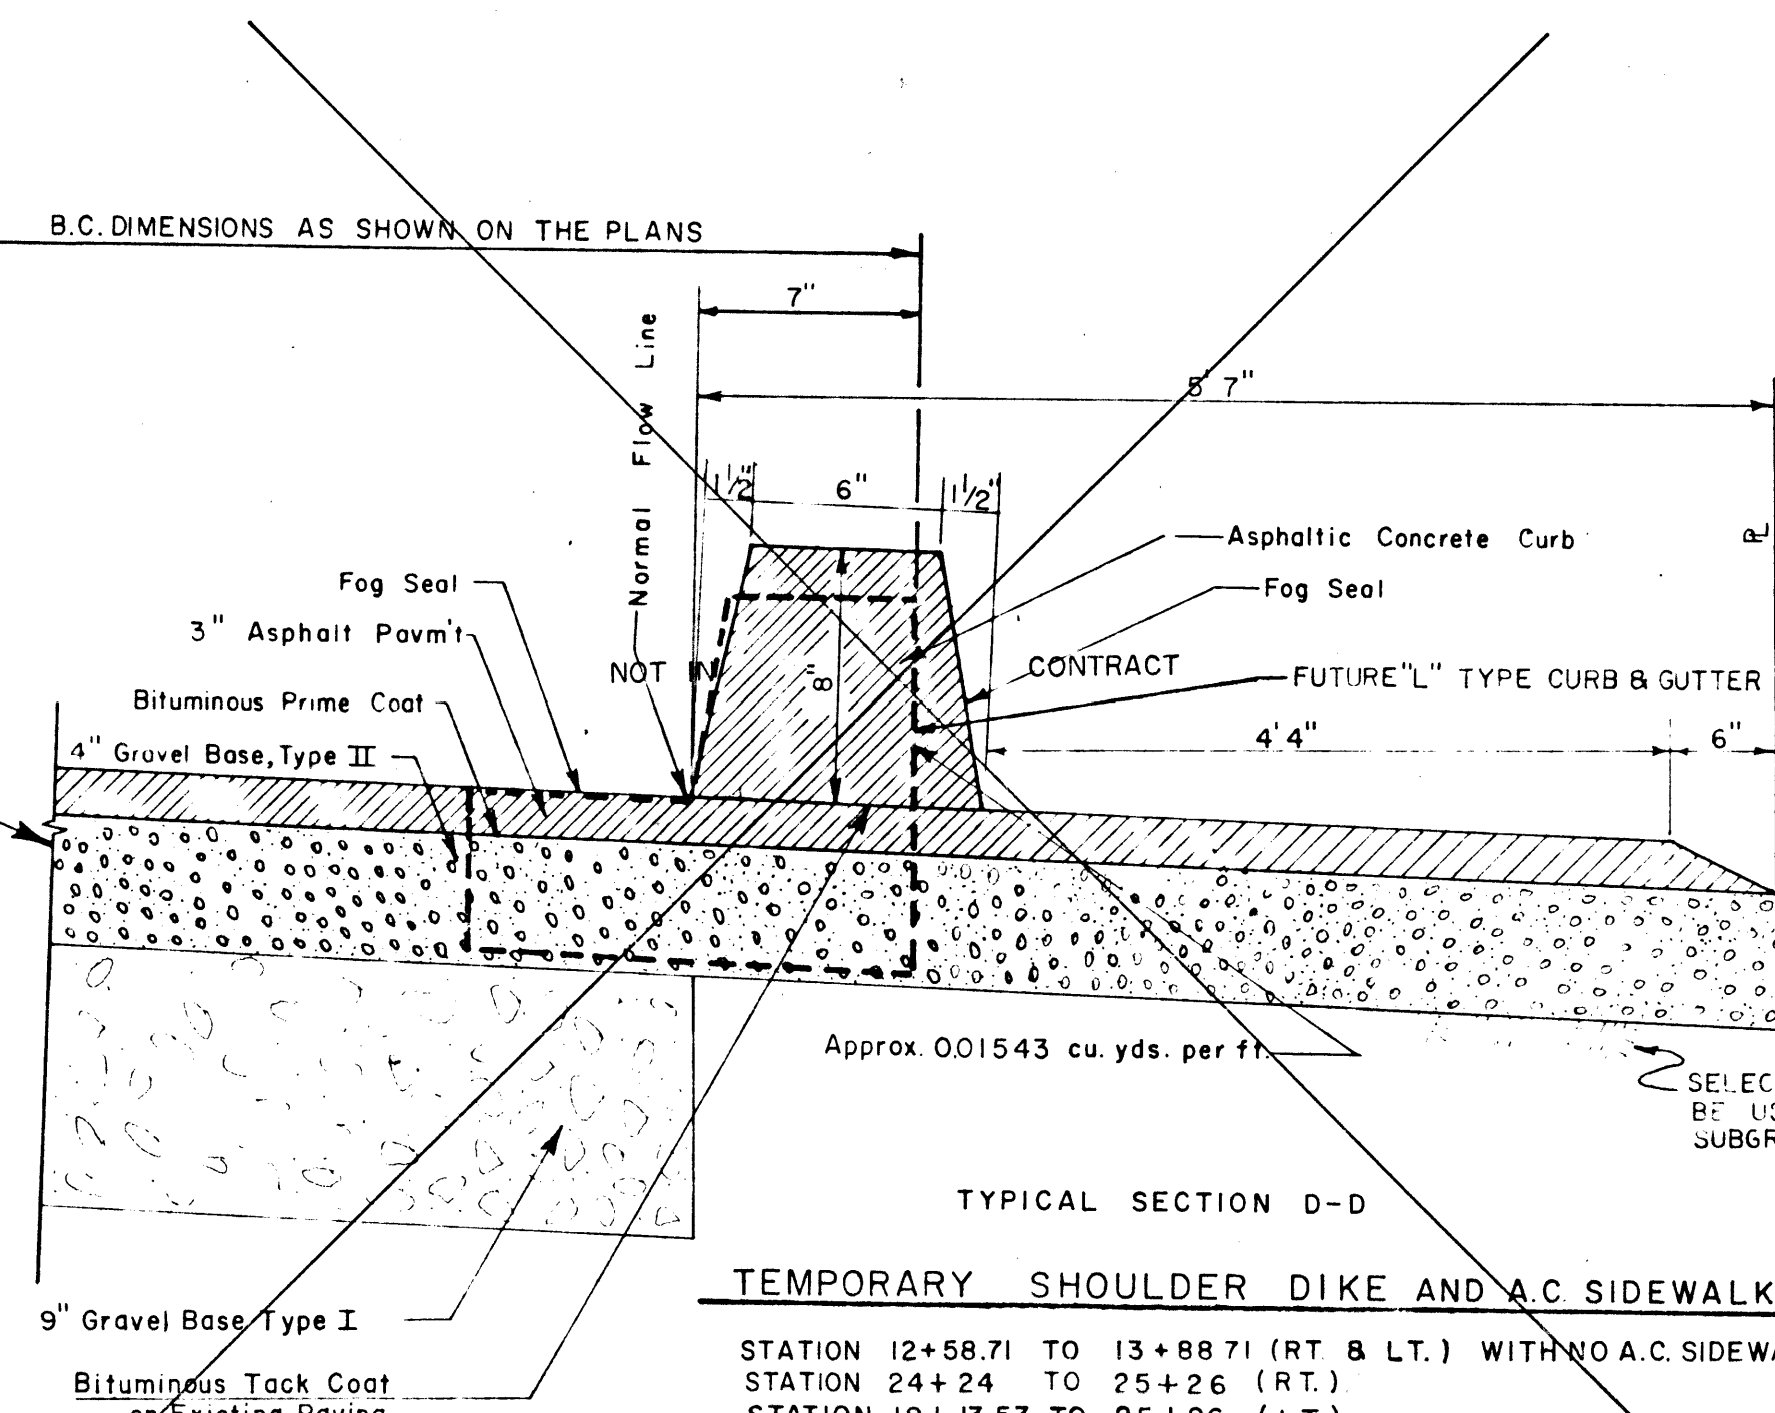


TYPICAL SECTION D-D
TEMPORARY SHOULDER DIKE AND A.C. SIDEWALK
STATION 12+58.71 TO 13+88.71 (RT & LT.) WITH NO A.C. SIDEWALK.
STATION 24+24 TO 25+26 (RT.)
STATION 19+13.53 TO 25+26 (LT.)

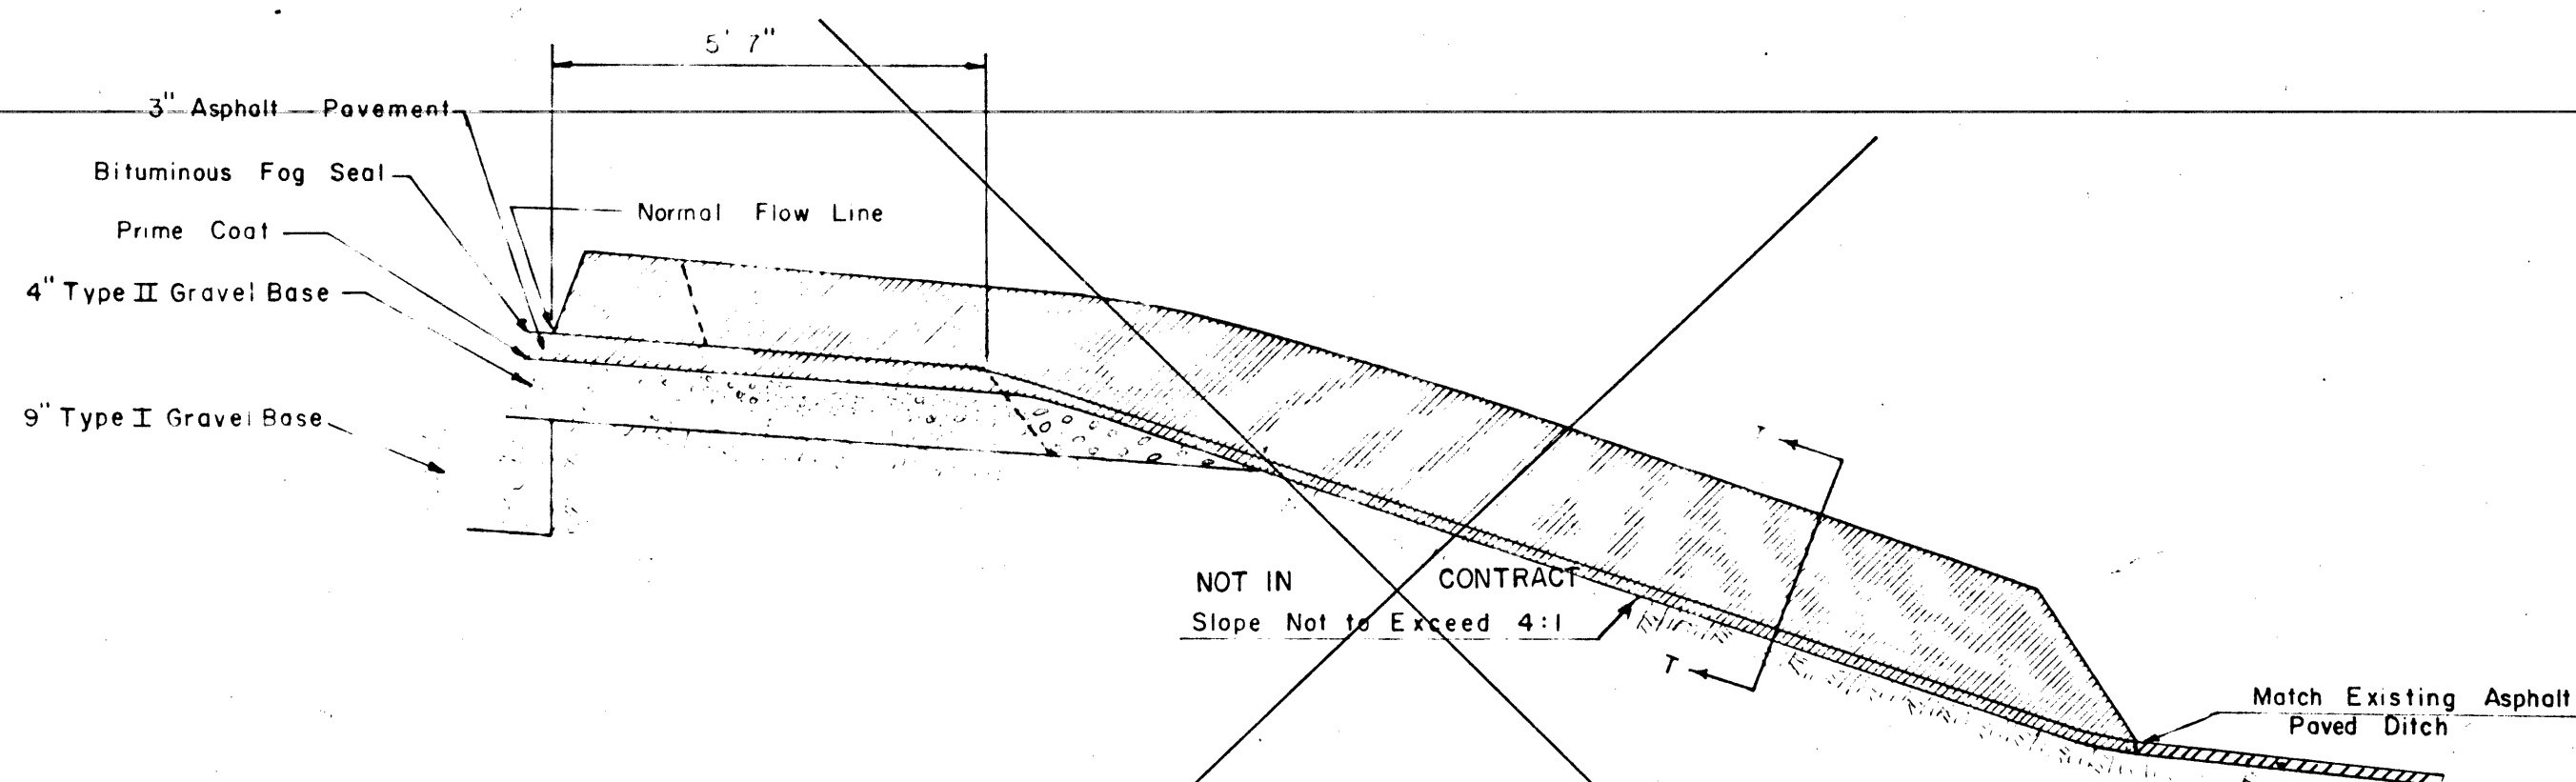

SECTION E-E
SHOULDER SPILLWAY
STATION 25+17.50
no scale

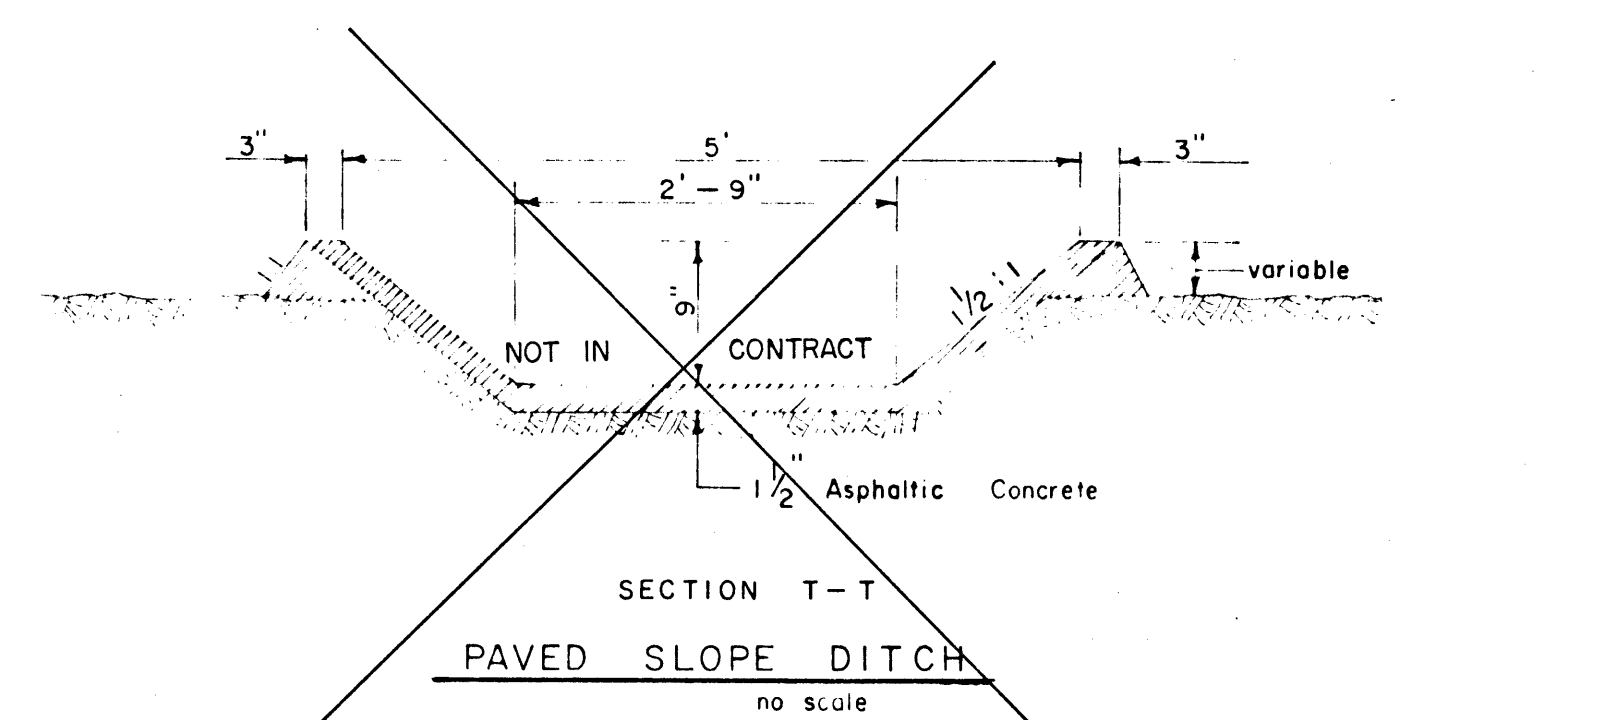

SECTION T-T
PAVED SLOPE DITCH
no scale

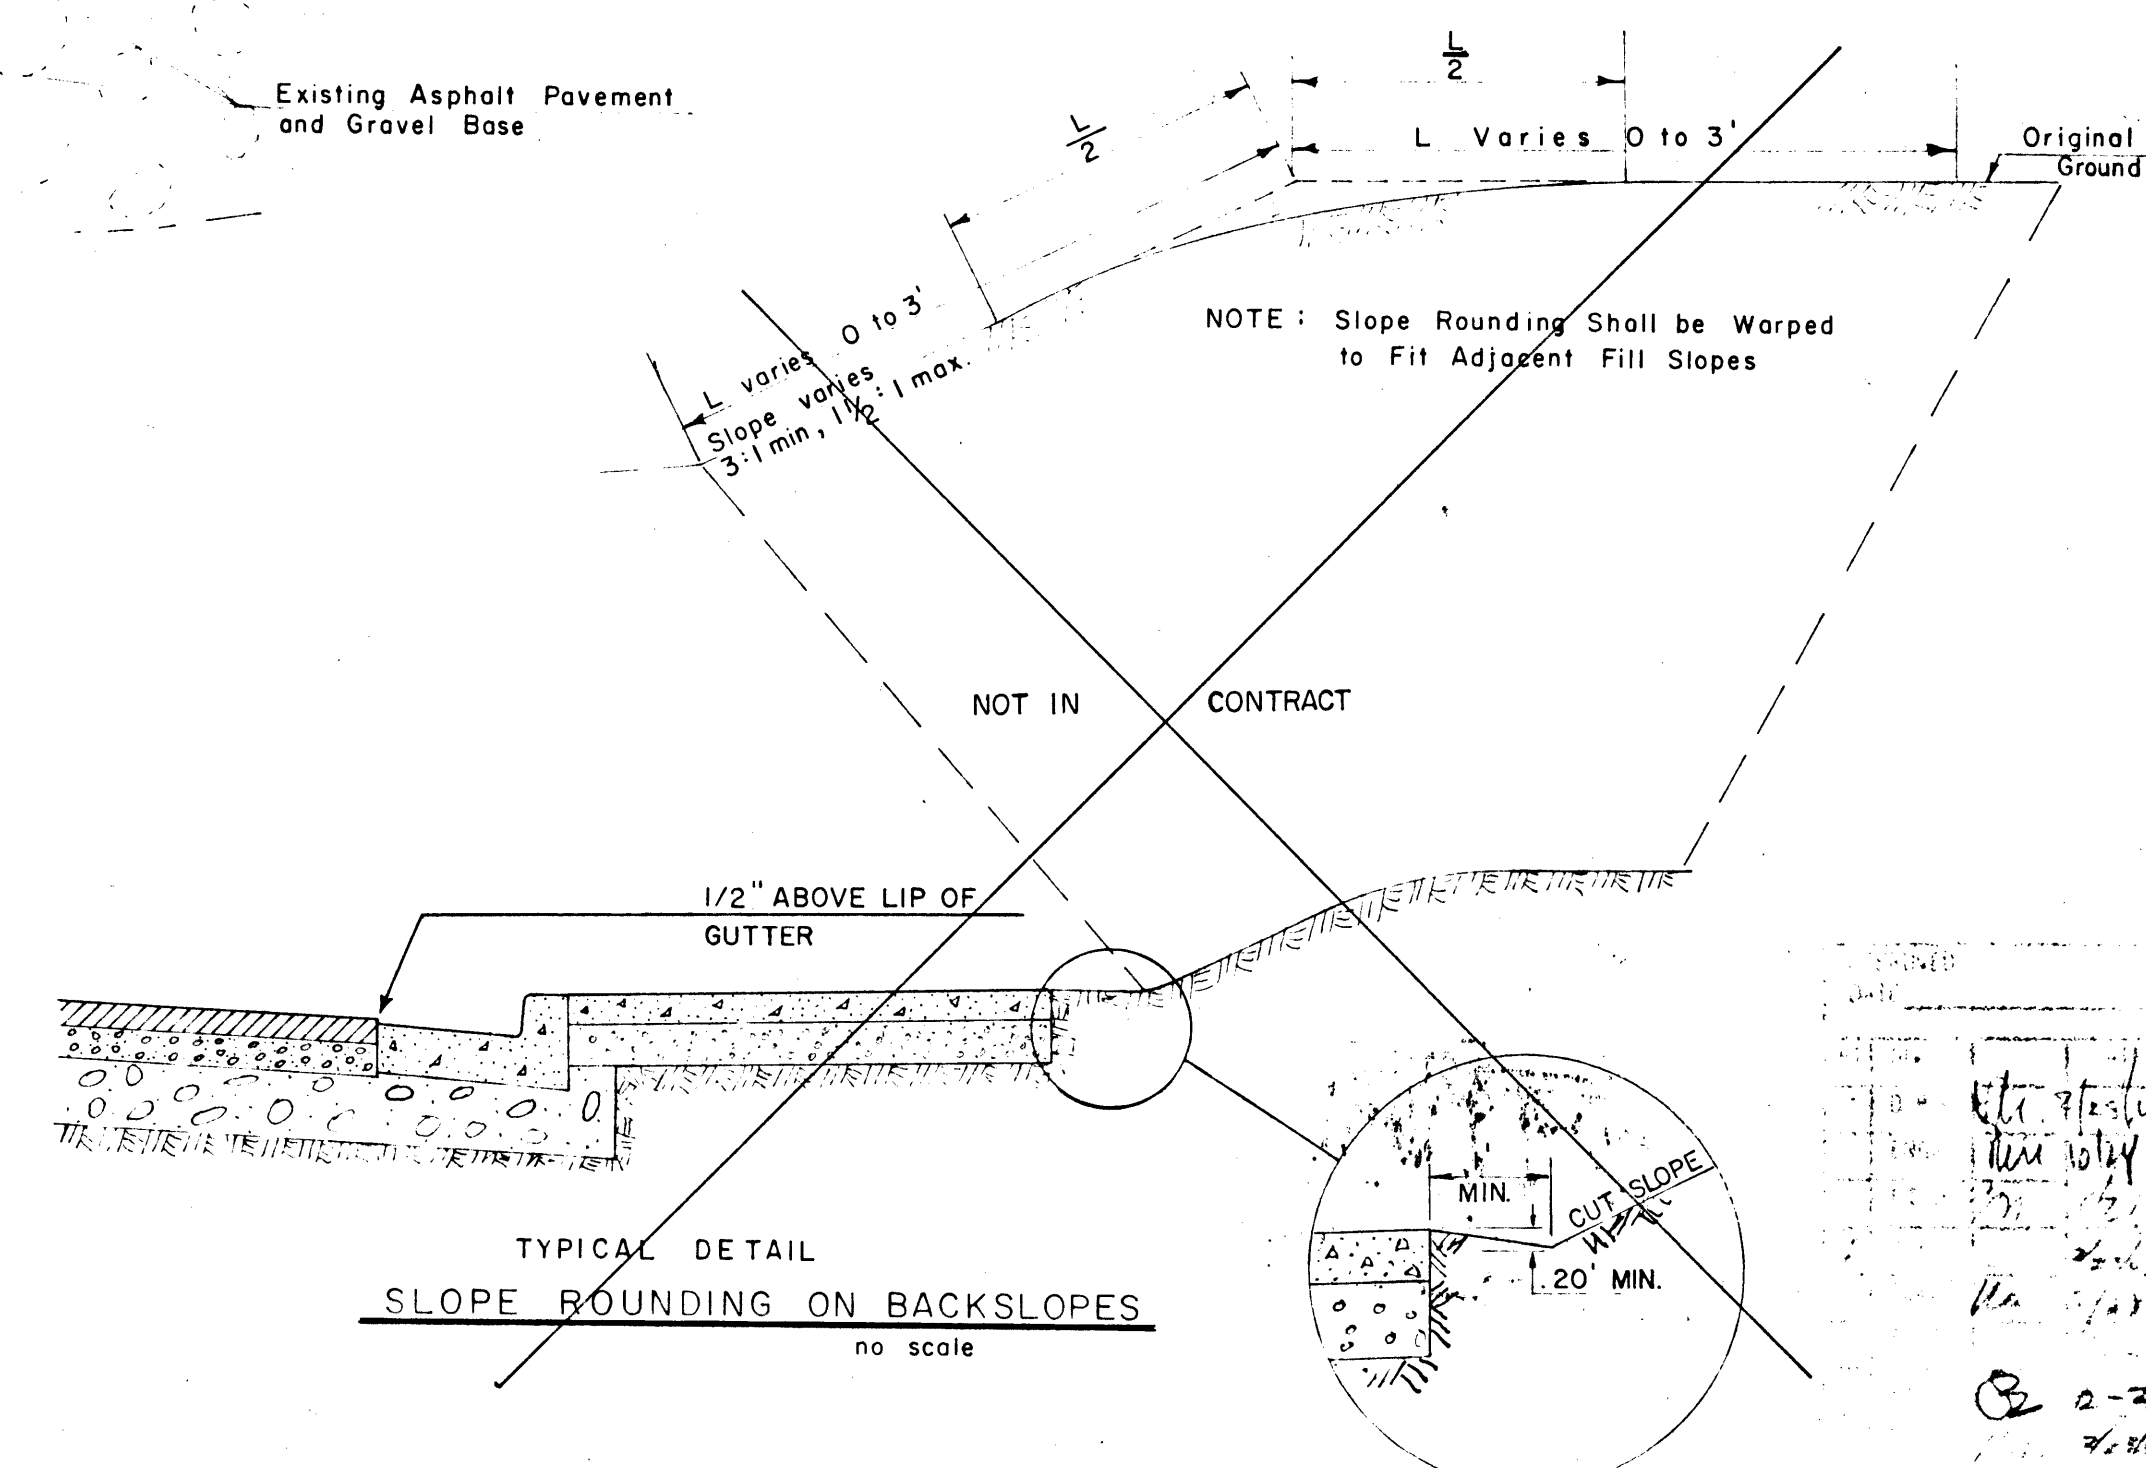

TYPICAL DETAIL
SLOPE ROUNDING ON BACKSLOPES
no scale

CONTRACT
DRAWING
MAR 30 1967

CITY OF LAS VEGAS NEVADA ENGINEERING DEPT.

DECATUR BOULEVARD - Alta Drive to West Fremont

DETAIL SHEET (GENERAL)

W.O. NO. 756	DATE	SC. (H) AS SHOWN
DES. GITTNER - Design Squad #1	8-17-66	SC. (W)
DR. SMITH	8-17-66	F.BK. NO. 65-12X
CKD. WLV		P.J. O. NO. 241
APPROVED BY CITY ENGR.	SHEET	DRAWING NO.
	9 OF 16	107V-717A

