


4.11.67

GENERAL LINE AND SYMBOL LEGEND


- T- -T- -T- BURIED TELEPHONE CONDUIT SYSTEM
- W- -W- -W- Las Vegas Valley Water District Water Pipe
- S- -S- -S- Sanitary Sewer
- G- -G- -G- Southwest Gas S.H.P.
- 36- -36- -36- Section and Survey Line
- 31- -31- -31- Centerline (Right of Way)
- FA- -FA- -FA- Fire Alarm Conduit
- TR- -TR- -TR- Traffic Signal Conduit
- L- -L- -L- Street Lighting Conduit

- | | | | |
|---|------------------------|---|--|
| ⊙ | Telephone Manhole | □ | Traffic Signal Controller |
| ⊙ | Sanitary Sewer Manhole | □ | Existing Asphalt Pavement to Remain |
| ⊙ | Power Pole | ▨ | New Asphalt Pavement Construction |
| ⊙ | Street Light | ▨ | Remove and Replace Asphalt Pavement |
| ⊙ | Traffic Signal | ▨ | Construct Temporary Asphalt Curb |
| ⊙ | W-Water or G-Gas Valve | ▨ | Existing Concrete Curb and Gutter |
| ⊙ | Existing Drop Inlet | ▨ | Construct Concrete Curb and Gutter per Detail "B" This Sheet |
| ⊙ | Fire Hydrant | | |
| ⊙ | Pull Box | | |

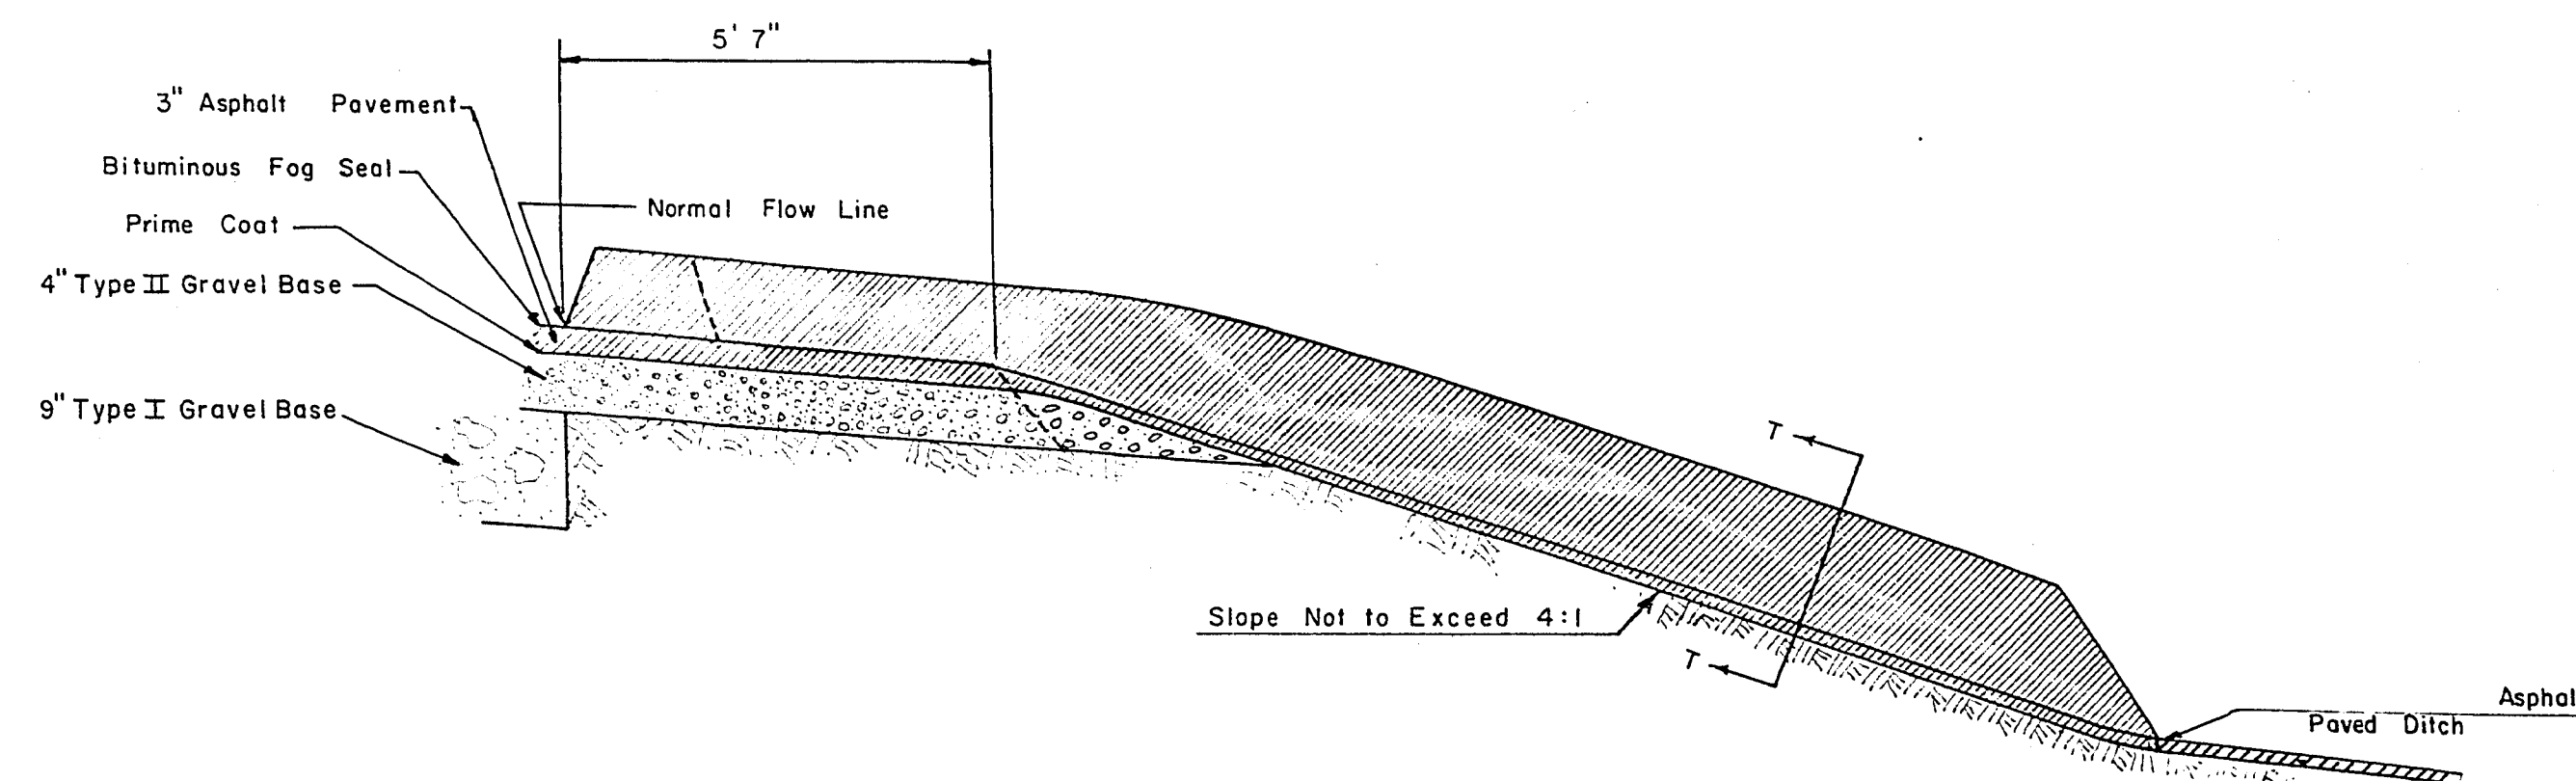


SECTION E-E

SHOULDER SPILLWAY
STATION 25+17.50
no scale

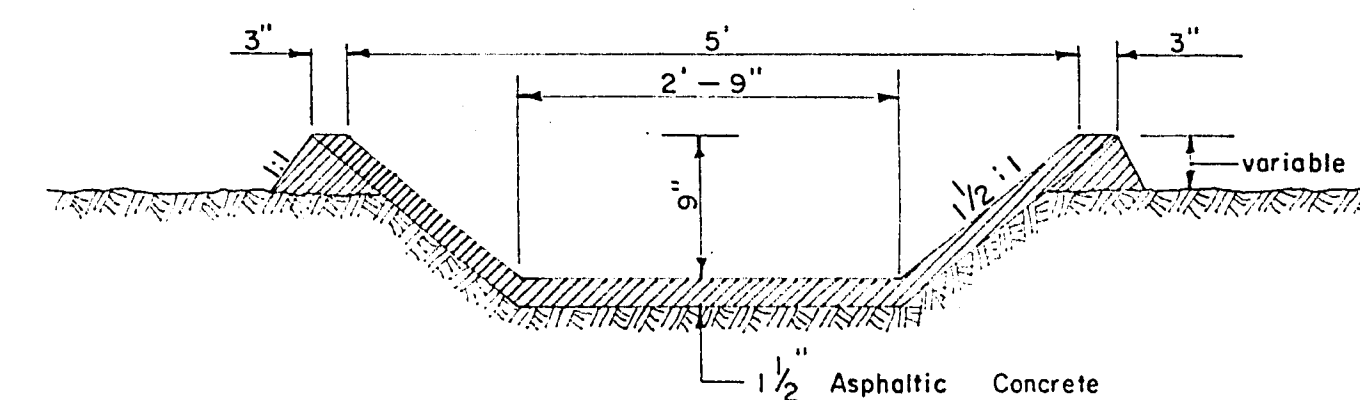


SECTION T-T

PAVED SLOPE DITCH
no scale

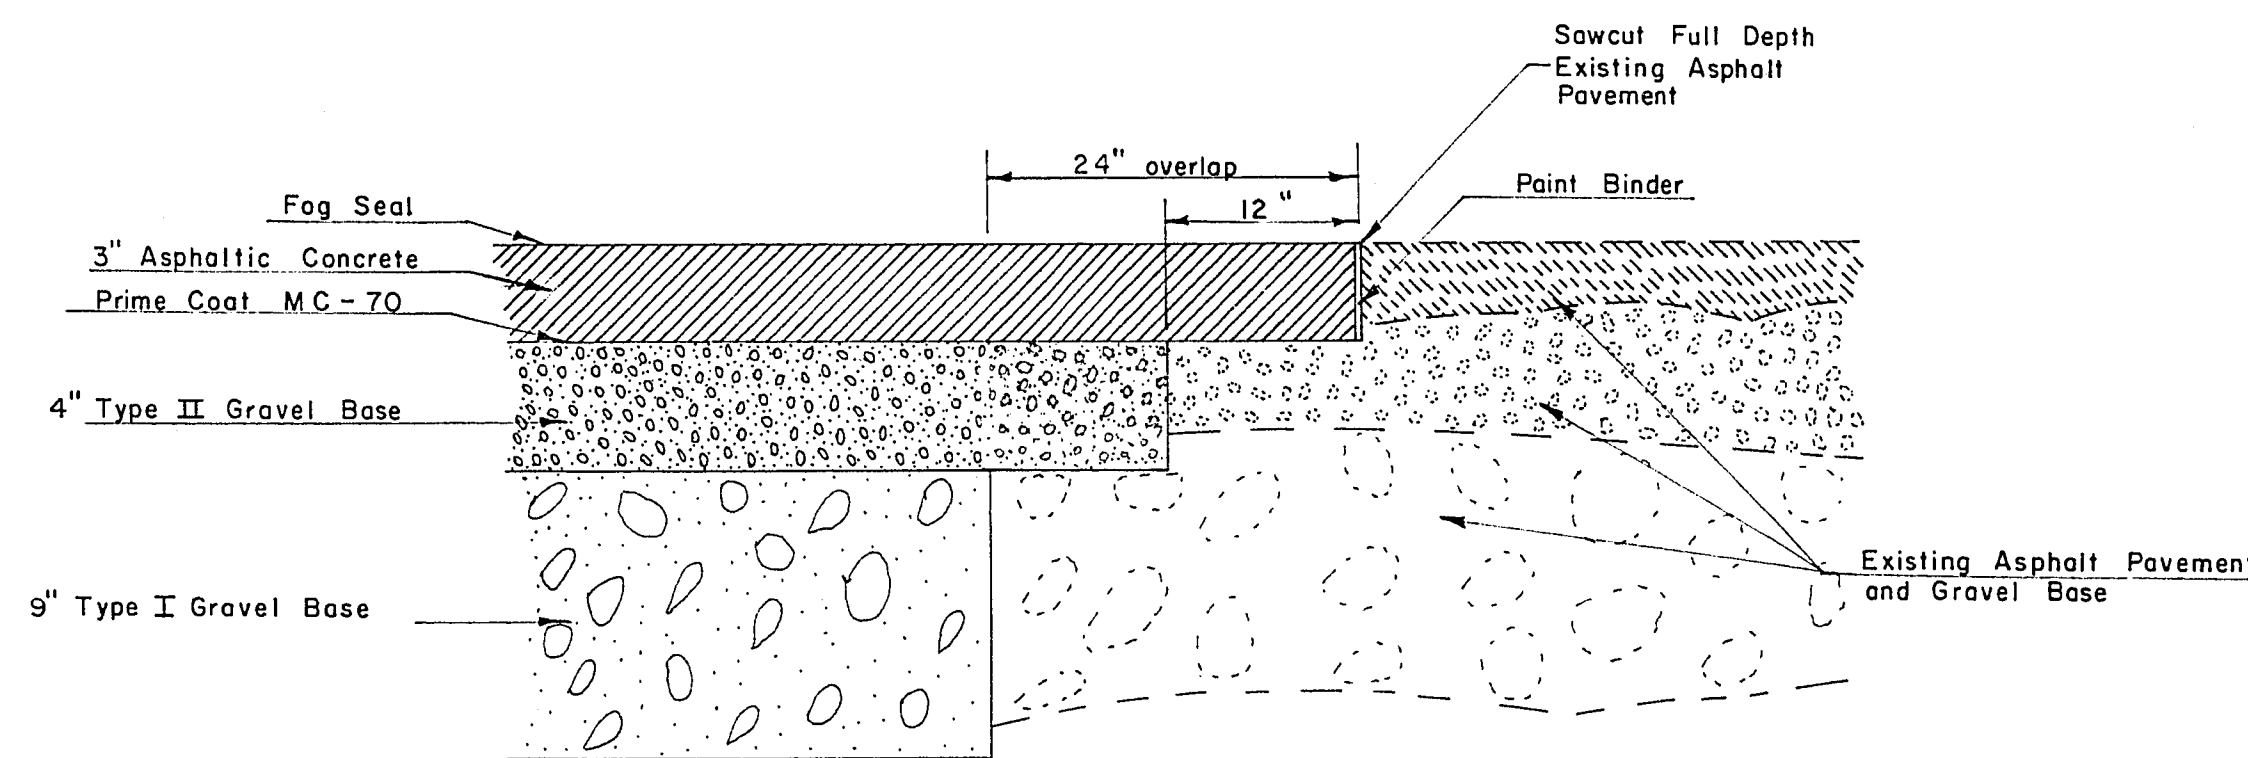


TYPICAL DETAIL

PAVEMENT JOINTING DETAIL
no scale

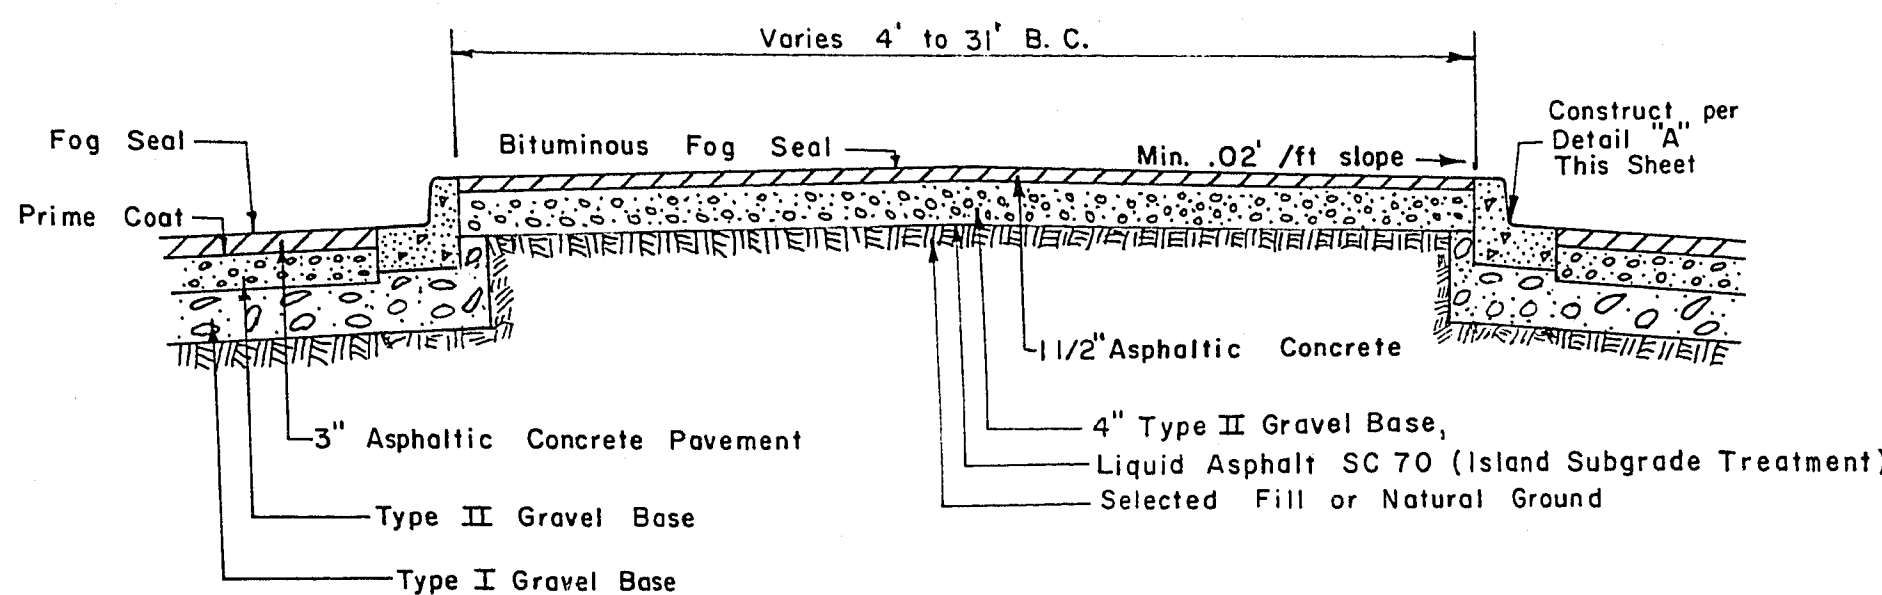


SECTION A-A

TYPICAL DETAIL - ASPHALT PAVED ISLANDS
no scale

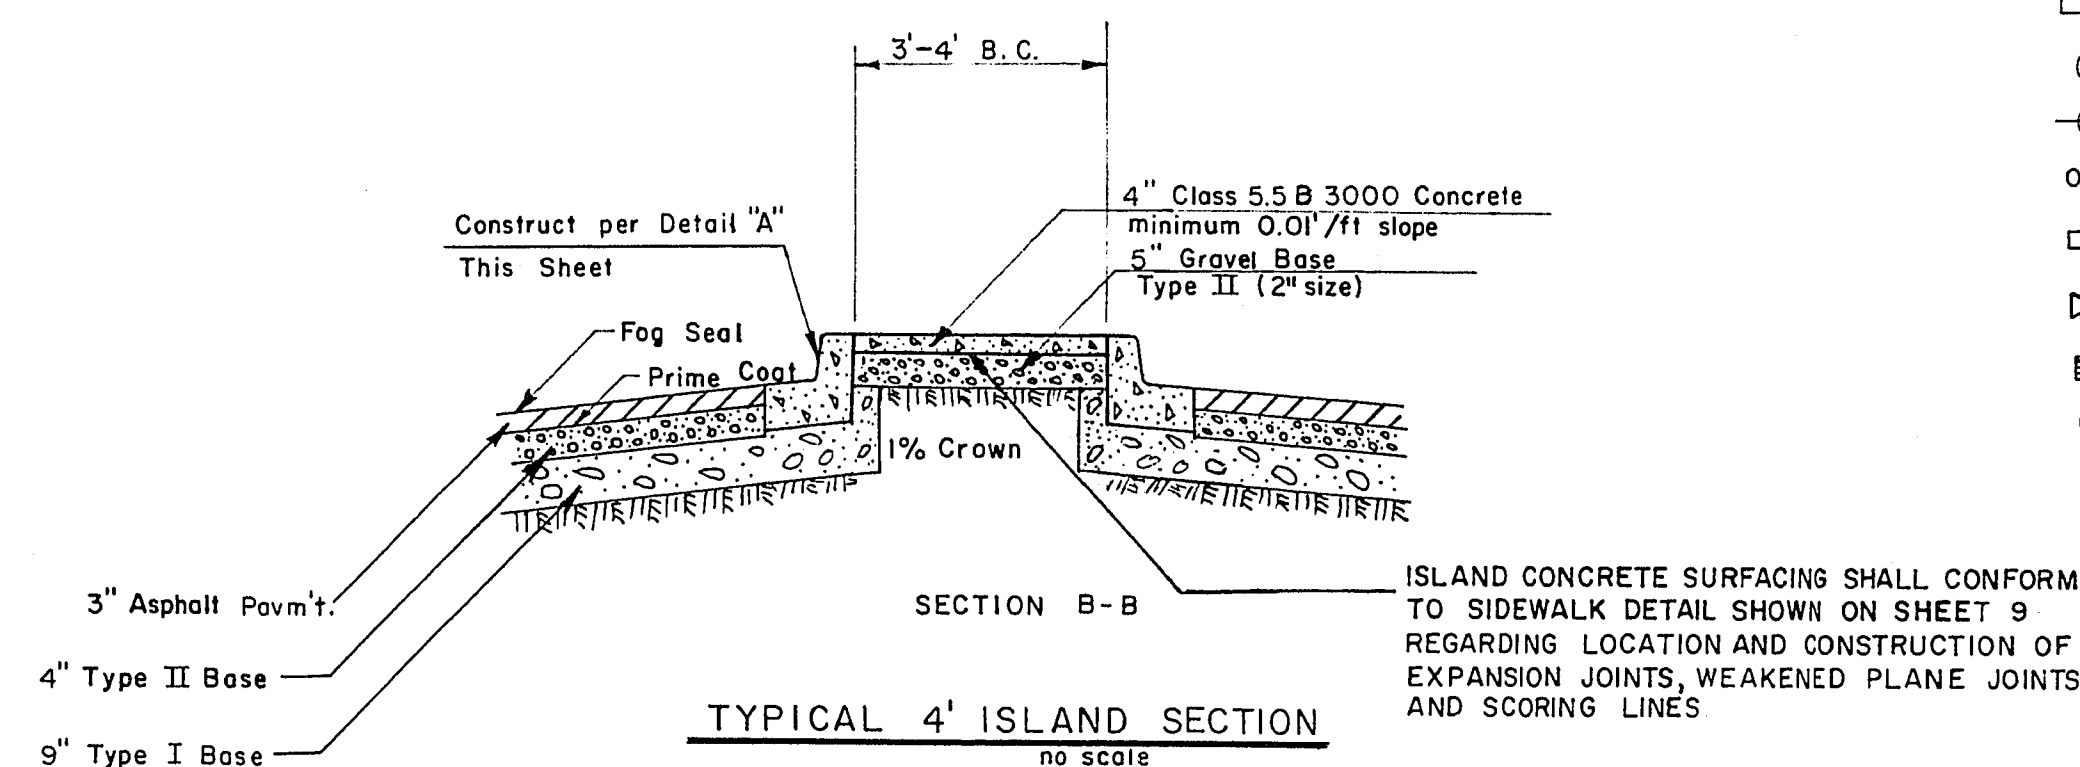

TYPICAL 4' ISLAND SECTION


no scale

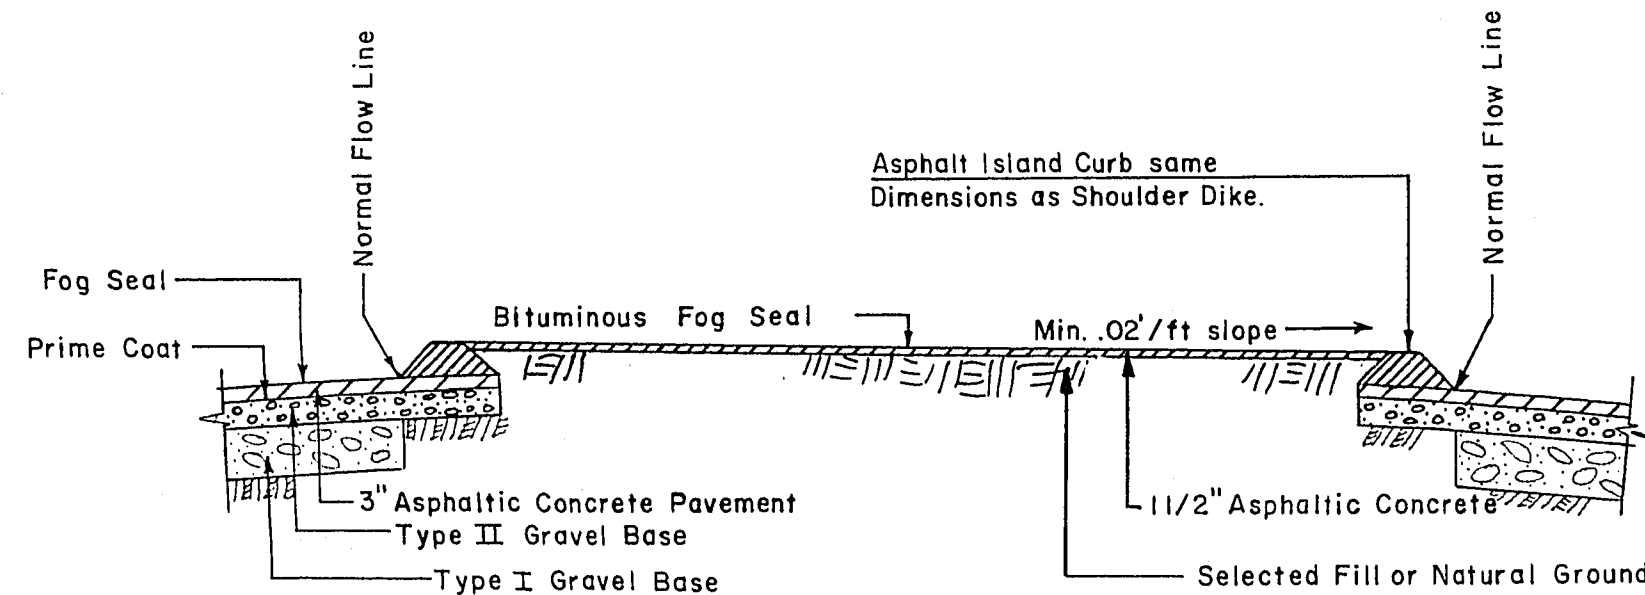

TYPICAL SECTION C-C

TEMPORARY ASPHALT ISLAND DETAIL

STATION 22+76 NORTH
no scale

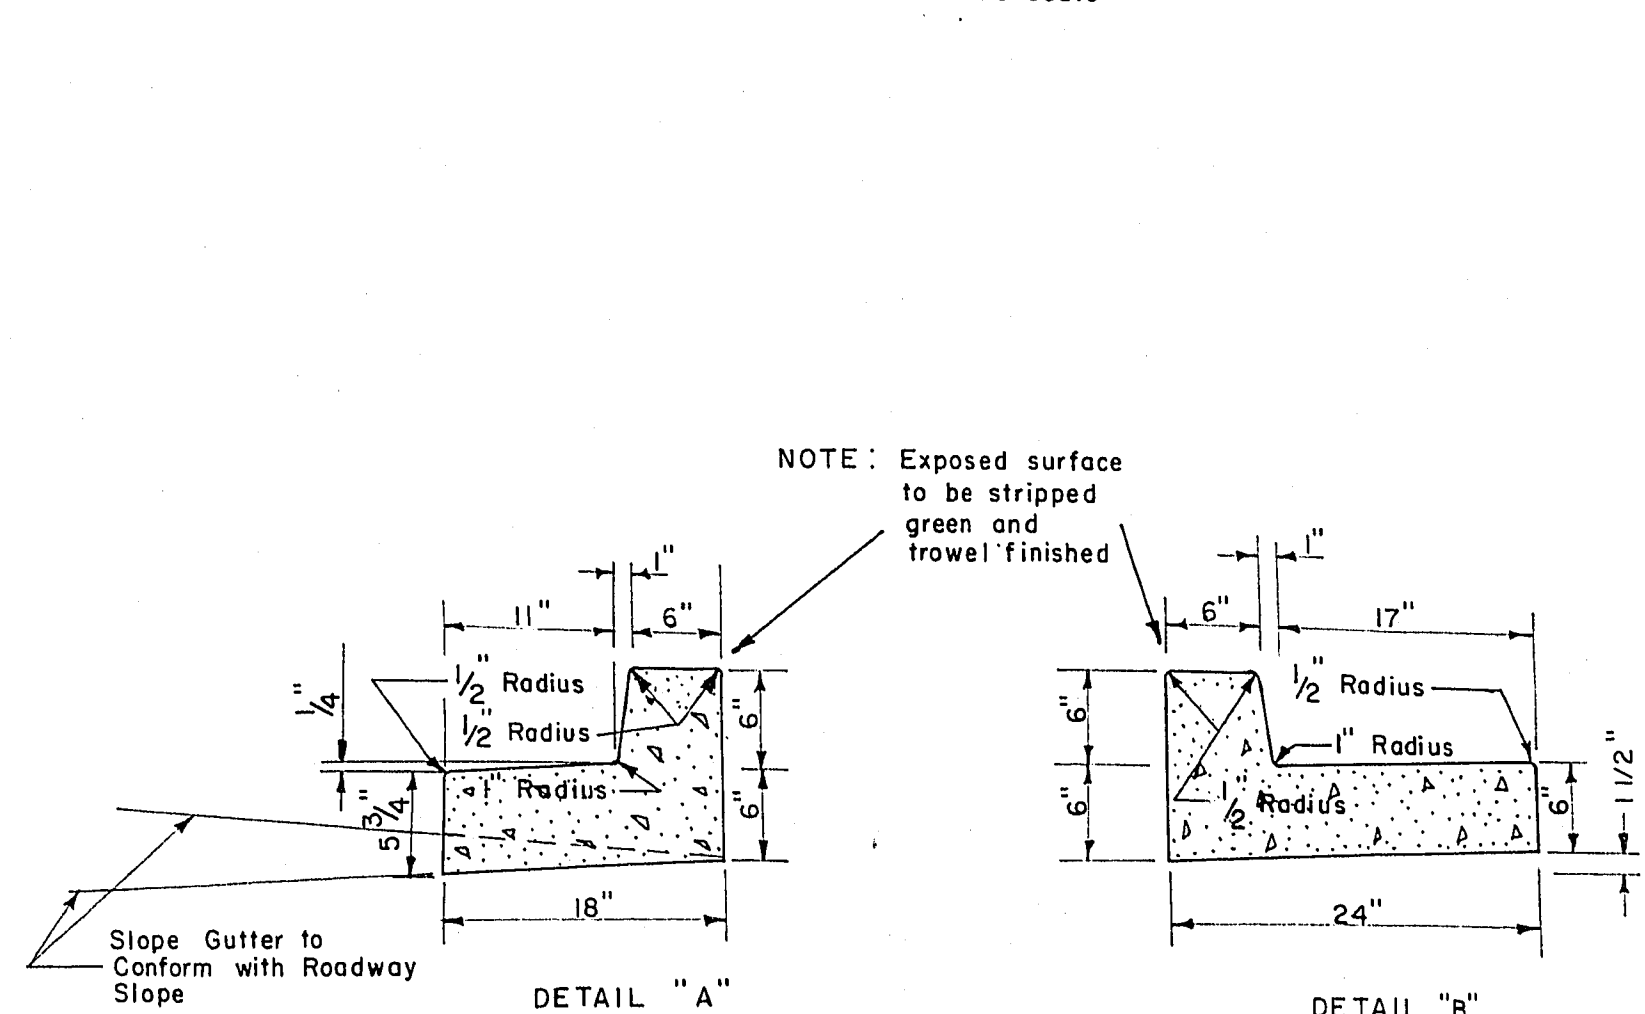


ISLAND CURB and GUTTER

0.03780 cu. yds. per ft.
CLASS 5.5 B 3000 Concrete
no scale

STANDARD "L" TYPE CURB and GUTTER


0.04617 cu. yds. per ft.
CLASS 5.5 B 3000 Concrete
no scale

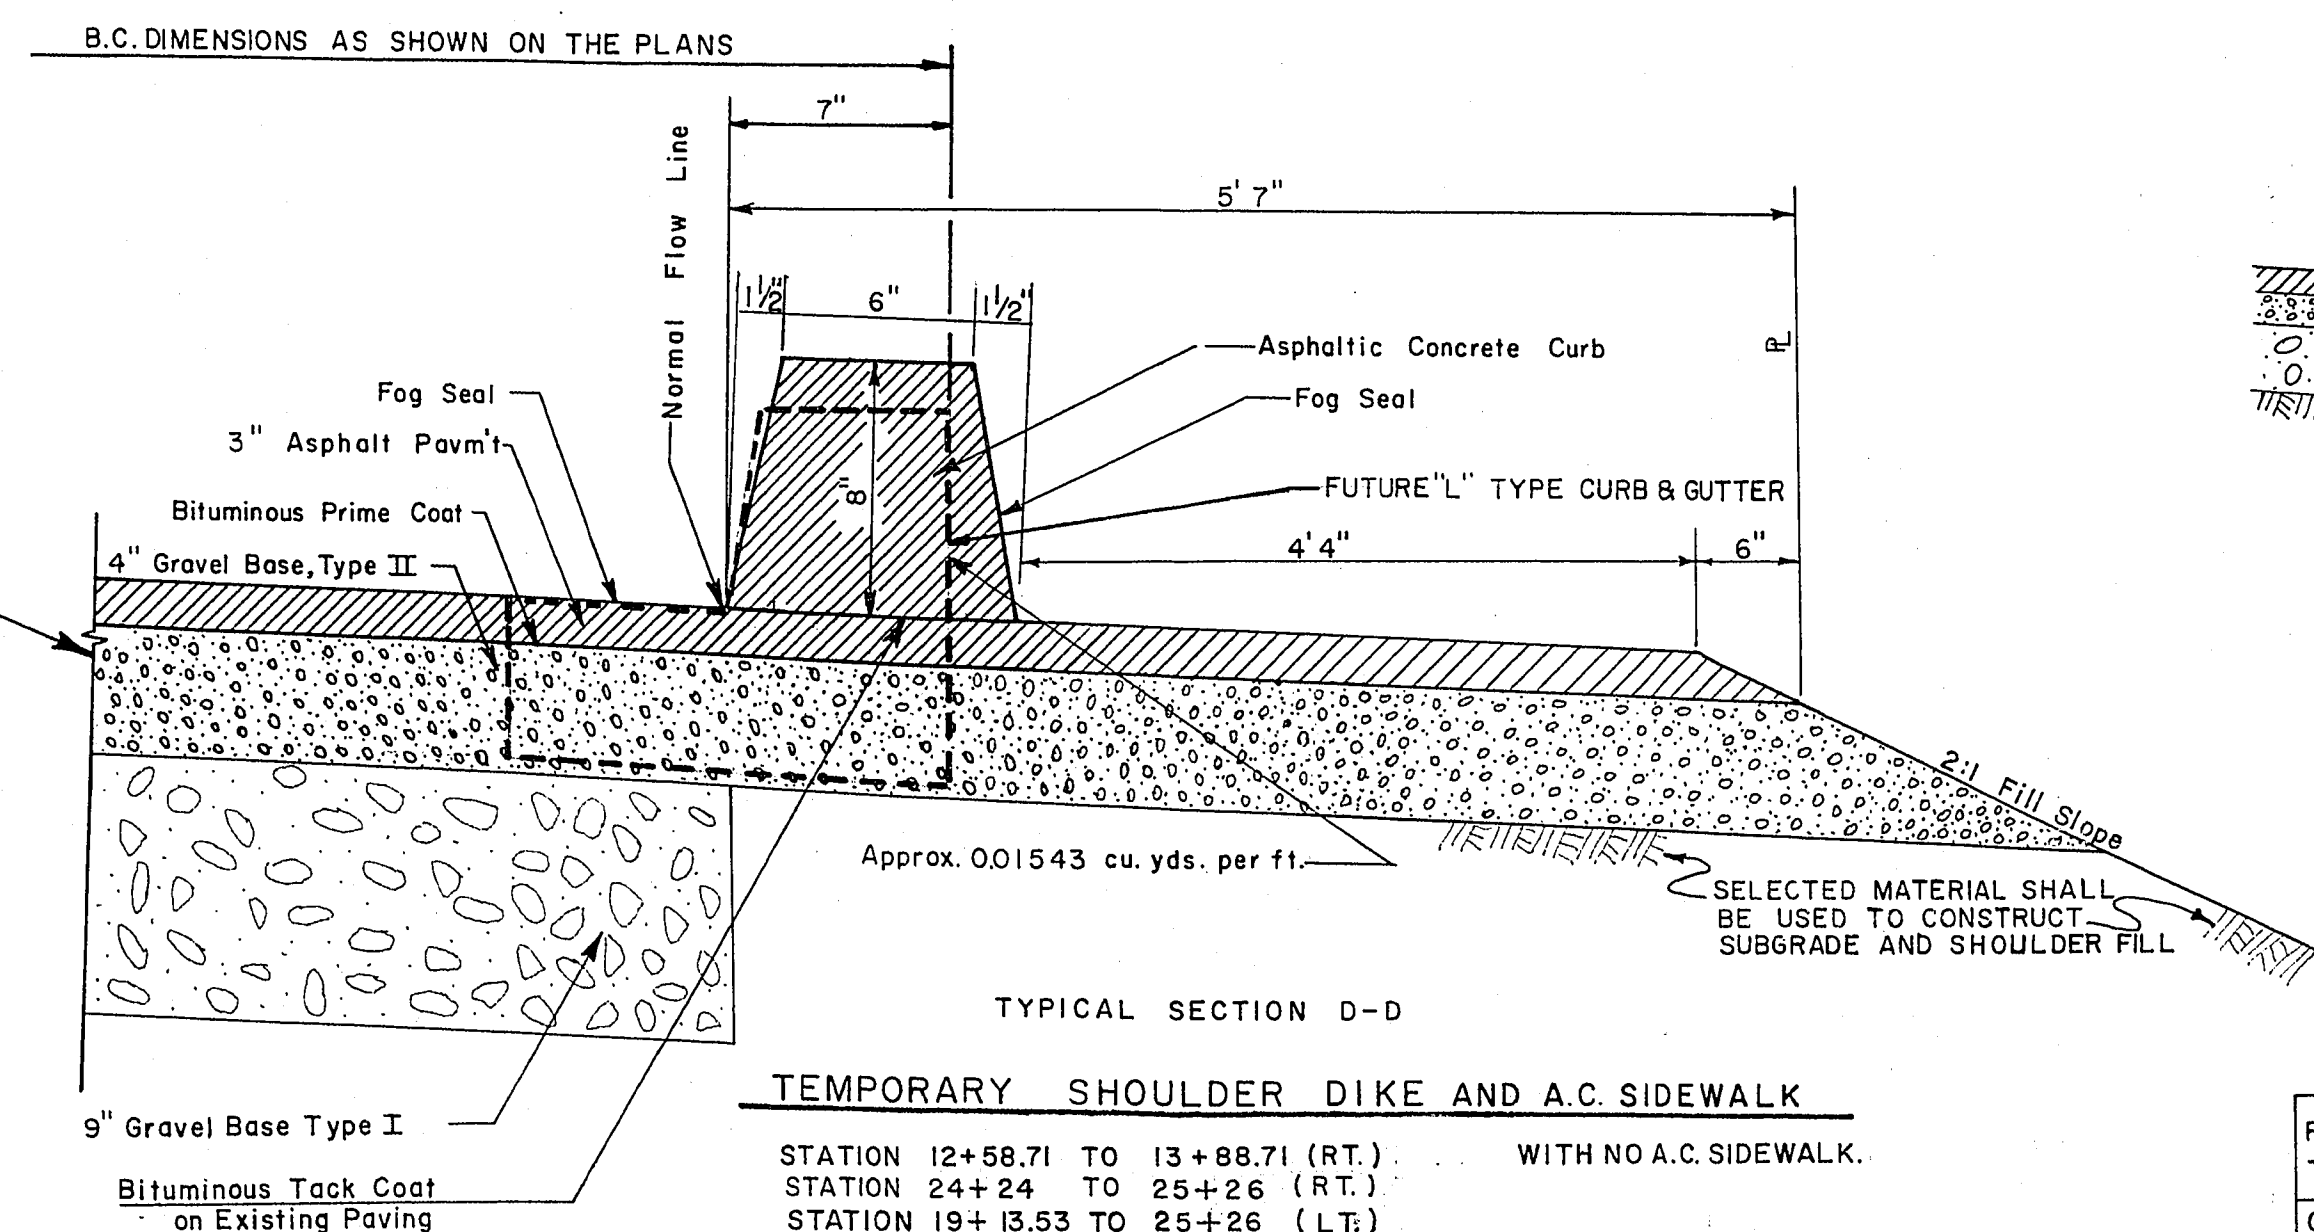

TYPICAL SECTION D-D

TEMPORARY SHOULDER DIKE and A.C. SIDEWALK

STATION 12+58.71 TO 13+88.71 (RT.) WITH NO A.C. SIDEWALK.
STATION 24+24 TO 25+26 (RT.)
STATION 19+13.53 TO 25+26 (LT.)
STATION 12+58.71 TO 12+91.71 (LT.)

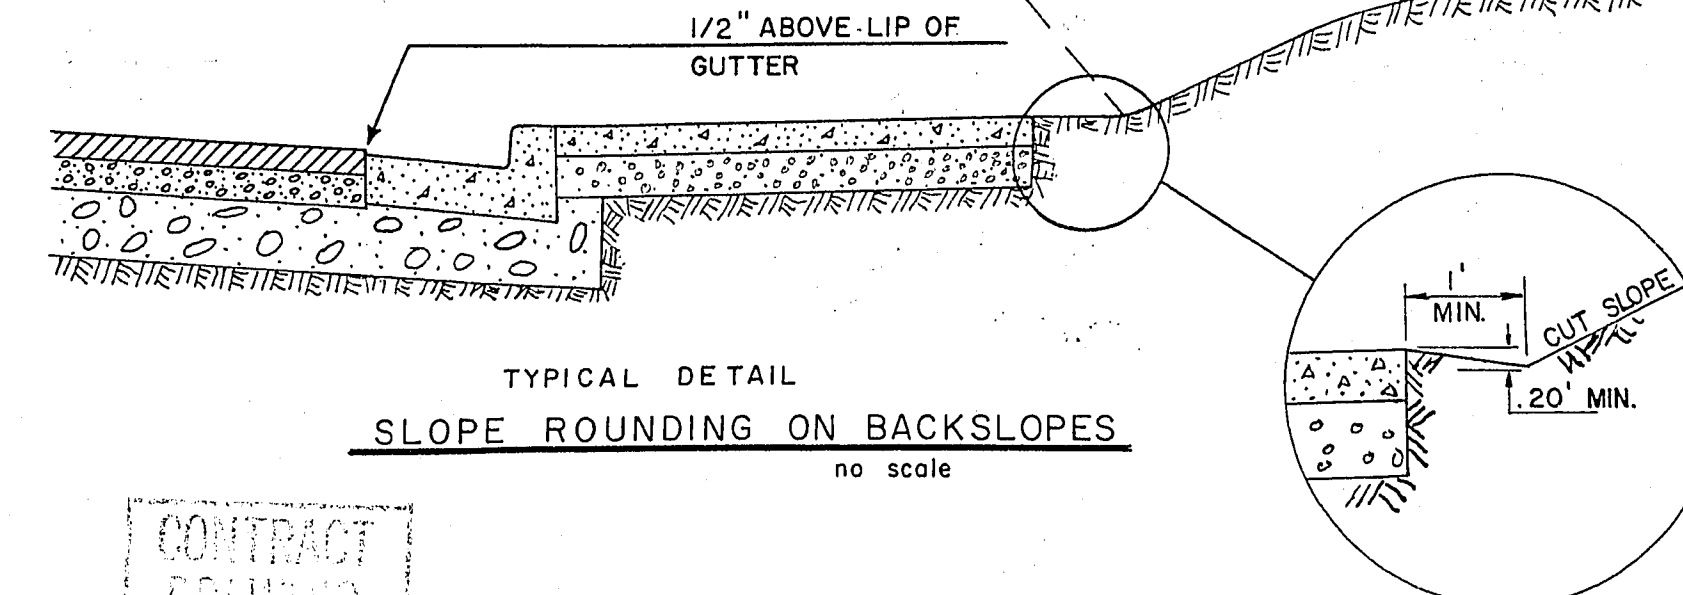

TYPICAL DETAIL

SLOPE ROUNDING ON BACKSLOPES
no scale

CONTRACT
DRAWING
MAY 24 1967

CONTRACT
DRAWING
APR 7 1967

REVISION 3 CHANGED ISLAND FROM STATION 21+53 TO 25+60 TO CONFORM TO STATE HWY. PLANS.
CITY ENGINEER
DATE
MAY 24 1967

CITY OF LAS VEGAS NEVADA ENGINEERING DEPT.

DECATUR BOULEVARD - Alta Drive to West Fremont
DETAIL SHEET (GENERAL)

W.O. NO. 756	DATE	SC. BY	AS SHOWN
DES. GITTNER - Design Squad #1	8-17-66	SC. BY	
DR. SMITH	8-17-66	F.B.K. NO. 55-12X	
CKD. M. L. Smith		P.L.O. NO. 241	
APPROVED BY CITY ENGR.		DRAWING NO.	
		3-6-67	107V-717B