

APPROXIMATE QUANTITIES - THIS SHEET

ITEM	DESCRIPTION	UNIT	QUANTITY
320.2	ISLAND SUBGRADE TREATMENT	S.Y.	360
201.1	ROADWAY EXCAVATION	C.Y.	3,993
302.1	TYPE I GRAVEL BASE	C.Y.	1,448
302.2	TYPE II GRAVEL BASE	C.Y.	702
333.1	FOG SEAL COAT	S.Y.	5,757
334.6	ASPHALT CONCRETE 1/2"	S.Y.	5,397
334.3	ASPHALTIC CONCRETE 1/2"	S.Y.	360
340.1	CONCRETE CURB & GUTTER	L.F.	666-679
340.2	ISLAND CURB (CONCRETE)	L.F.	811
340.3	CONCRETE SIDEWALK	S.F.	3,343-3,442
340.31	CONCRETE (ISLAND SURFACE)	S.F.	672
420.0	MONUMENTS	E.A.	1
512.51	ADJUST MANHOLE	E.A.	2
512.81	8" SEWER CONNECTION	E.A.	1
123.208	8" SEWER LATERAL	L.F.	67
400.210	10" EXTRA STRENGTH CONCRETE PIPE	L.F.	260
500.17	7" DROP INLET	E.A.	2
500.27	HEADWALL	E.A.	1
334.22	A.C. SHOULDER CURB	L.F.	145
334.61	SHOULDER SPILLWAY	E.A.	1
512.1	CONSTRUCT MANHOLE	E.A.	1
123.210	10" SEWER LINE	L.F.	50
290.32	SAWCUT A.C.	L.F.	76
560.5	INSTALL FIRE HYDRANT	E.A.	1


\* DELETED BY REVISION NO. 4  
 \*\* QUANTITY ADJUSTED AS SHOWN ABOVE BY REVISION NO. 4

FUTURE & EXISTING BC CURVE DATA

	DELTA	TANGENT	LENGTH	RADIUS
(C)	89° 47' 20"	29.89	47.01	30.00
(D)	90° 12' 40"	30.11	47.23	30.00
(E)	90° 38' 29"	30.34	47.46	30.00
(F)	89° 21' 31"	29.67	46.79	30.00

APPROXIMATE QUANTITIES - THIS SHEET

ITEM	DESCRIPTION	UNIT	QUANTITY
500.12T	JUNCTION BOX	E.A.	1
500.2T	HEADWALL	E.A.	1
500.13T	OUTLET BOX	E.A.	1
121.433	27" X 42" REINFORCED CONCRETE ARCH PIPE	L.F.	232
121.424	19" X 30" REINFORCED CONCRETE ARCH PIPE	L.F.	62
121.236	36" REINFORCED CONCRETE PIPE	L.F.	8
121.418	14" X 23" REINFORCED CONCRETE ARCH PIPE	L.F.	262
500.17	7" DROP INLET	E.A.	1

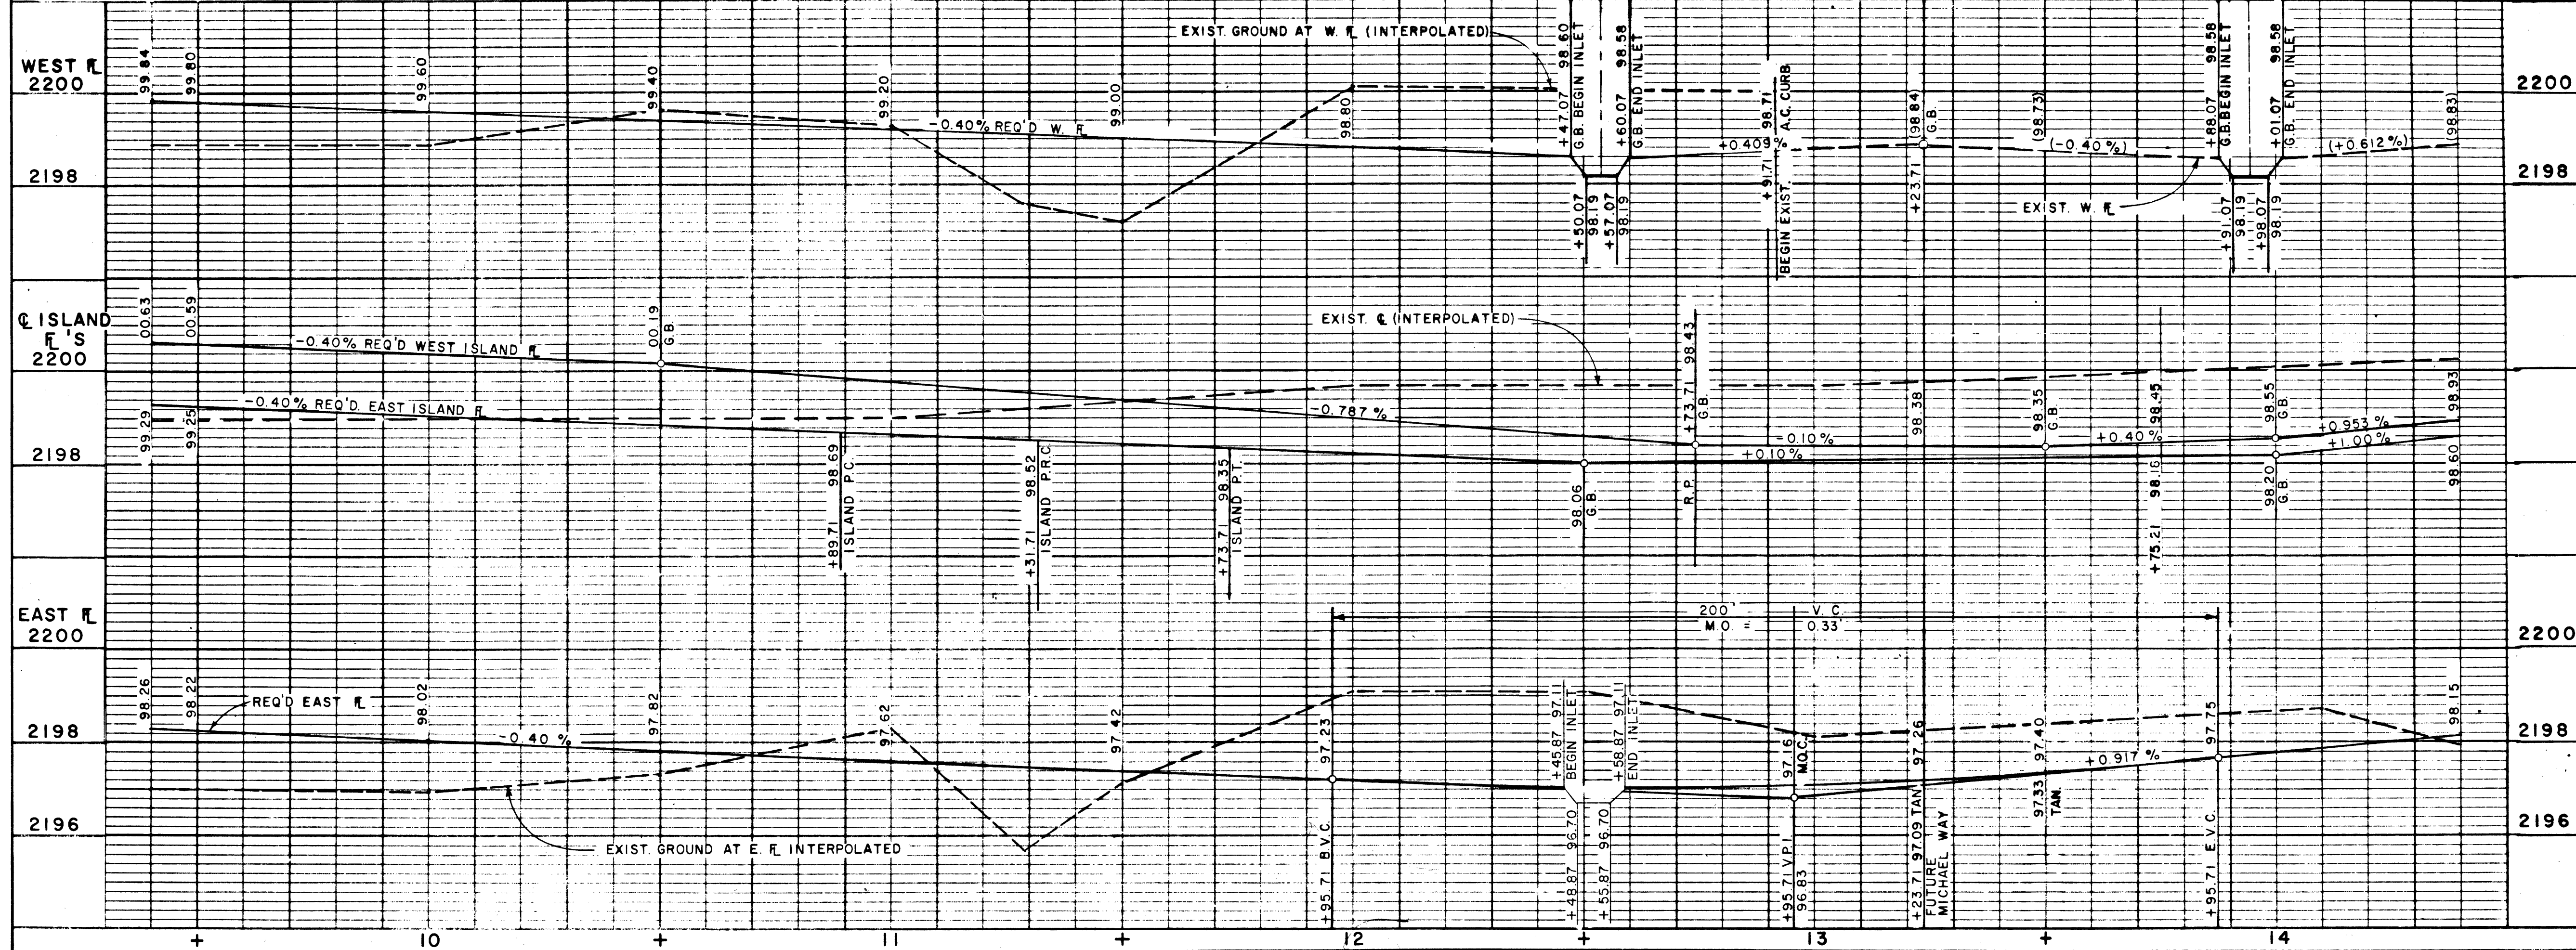

EXISTING UTILITIES ARE LOCATED ON THE PLANS FOR THE CONVENIENCE OF THE CONTRACTOR ONLY. THE CONTRACTOR SHALL BEAR FULL RESPONSIBILITY FOR PROTECTION OF UTILITIES AND THE CITY BEARS NO RESPONSIBILITY FOR UTILITIES NOT SHOWN ON THE PLANS OR NOT IN THE LOCATION SHOWN ON THE PLANS.

**CONTRACT DRAWING**  
 JUL 19 1967

APPROVED: **C.P. BRECHER** 7-10-67  
 R.S. & H. MANAGING ENGINEER DATE

REVISION NO.	DESCRIPTION	BY	DATE	APPROVAL

**CITY OF LAS VEGAS NEVADA**  
 DEPARTMENT OF PUBLIC WORKS  
 SERVICES DIVISION  
**DECATUR BOULEVARD**  
**MICHAEL WAY DRAINAGE**

W.O. NO. 756 F.B.N. NO. 65-12X DATE 5-22-67 DRAWING NO. 107V-717C  
 SC (H) 1" = 20' SC (V) 1" = 2' 5-22-67 PJO. NO. 241  
 DES. G. GITTNER  
 DR. K. GODDARD  
 APPROVED BY DIRECTOR OF PUBLIC WORKS  
*G.P. Howe* 7/11 SHEET 2 OF 5

