11-4-78

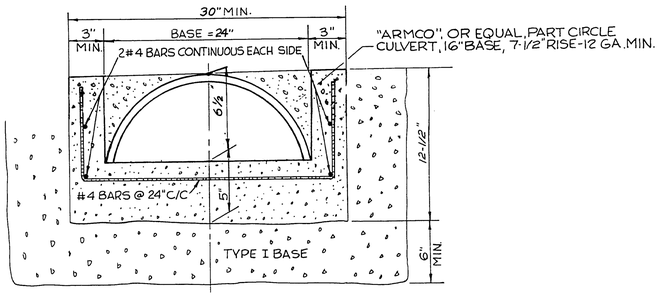

PART CIRCLE CULVERT

NO SCALE

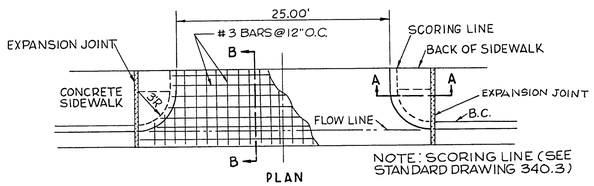

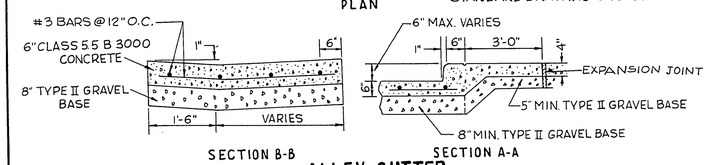

ALLEY GUTTER

NO SCALE
(STANDARD DRAWING 340.6)

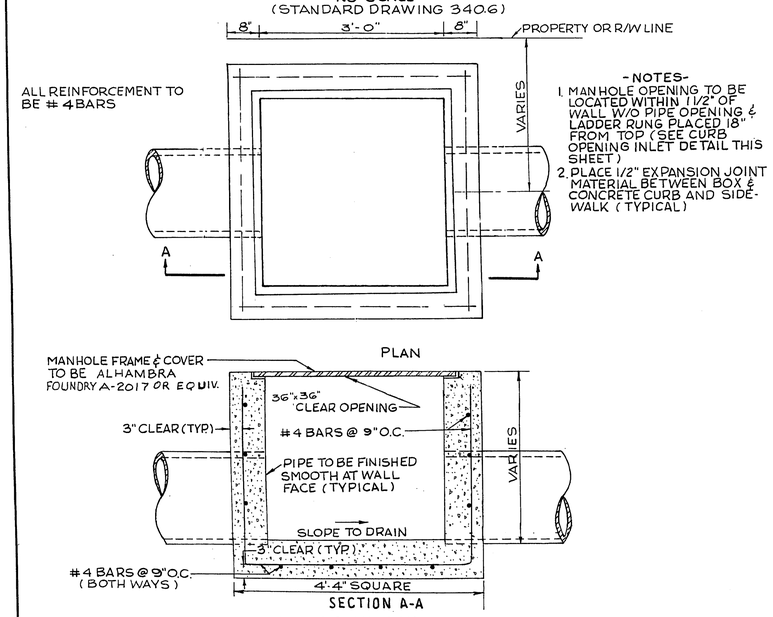

-NOTES-

1. MANHOLE OPENING TO BE LOCATED WITHIN 1 1/2" OF WALL W/O PIPE OPENING & LADDER RUNG PLACED 18" FROM TOP (SEE CURB OPENING INLET DETAIL THIS SHEET)
2. PLACE 1/2" EXPANSION JOINT MATERIAL BETWEEN BOX & CONCRETE CURB AND SIDEWALK (TYPICAL)

JUNCTION BOX

NO SCALE

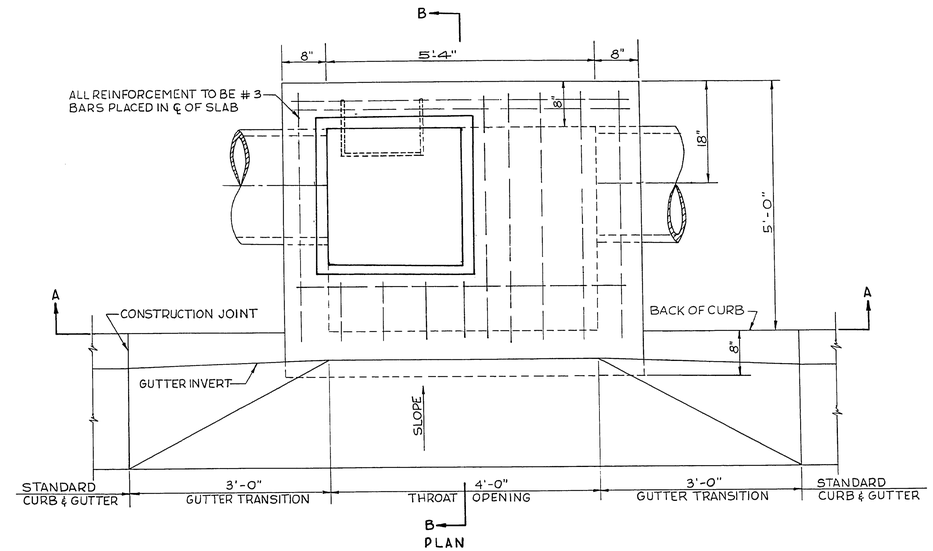

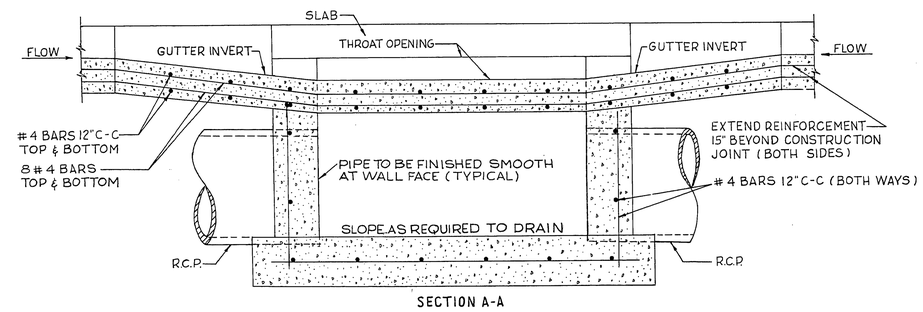

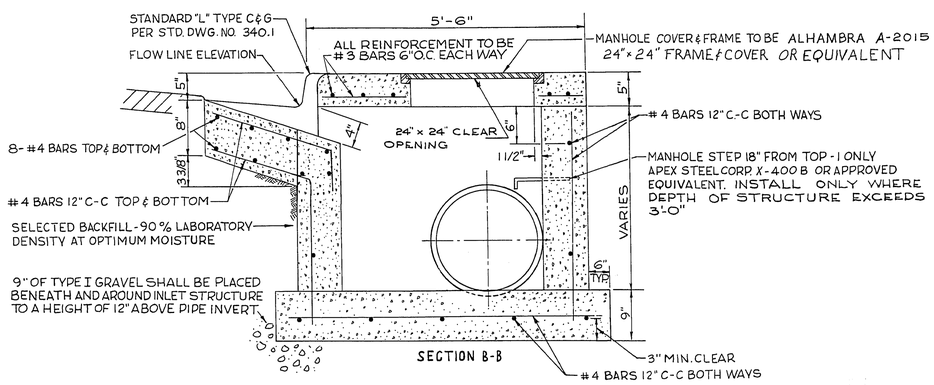

4' CURB OPENING INLET DETAIL TYPE I

NO SCALE

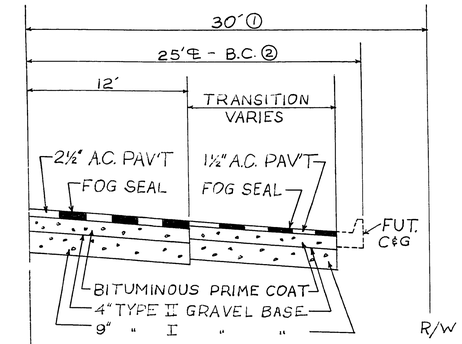

TYPICAL SECTION INTERSECTING STREETS

① 44' @ LAKE MEAD BLVD & SMOKE RANCH RD.
② 50' @ LAKE MEAD BLVD & SMOKE RANCH RD.

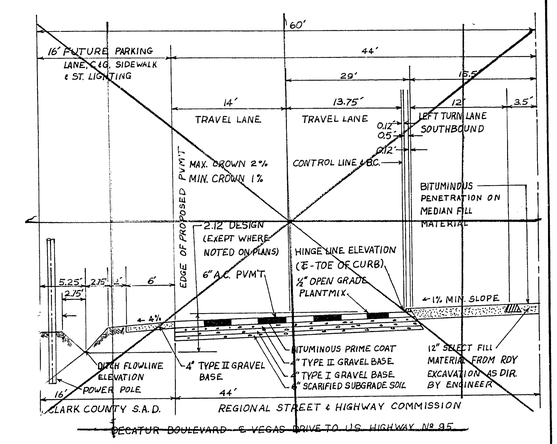

REV.	DATE	DESCRIPTION	APP.

CITY OF LAS VEGAS, NEVADA
ENGINEERING DEPARTMENT

DETAIL SHEET
DECATUR BLVD.
WASHINGTON AVE. TO U.S. HIGHWAY Nº 95

		DATE
W.O. 75-70 & 4810		
DESIGN	G.E.C.	
DRAWN	HURTADO	6-22-67
CHECKED	S.C.D.	
CONSULTING ENG.	RE 2487	5-17-68
CITY ENGINEER		3/15/69

SCALE: AS NOTED

C.L.V. DRWG. Nº 107V-738

PREPARED BY TYSON ENGINEERING COMPANY INC.

SHEET 27 OF 42

"AS CONSTRUCTED"