11-4-69

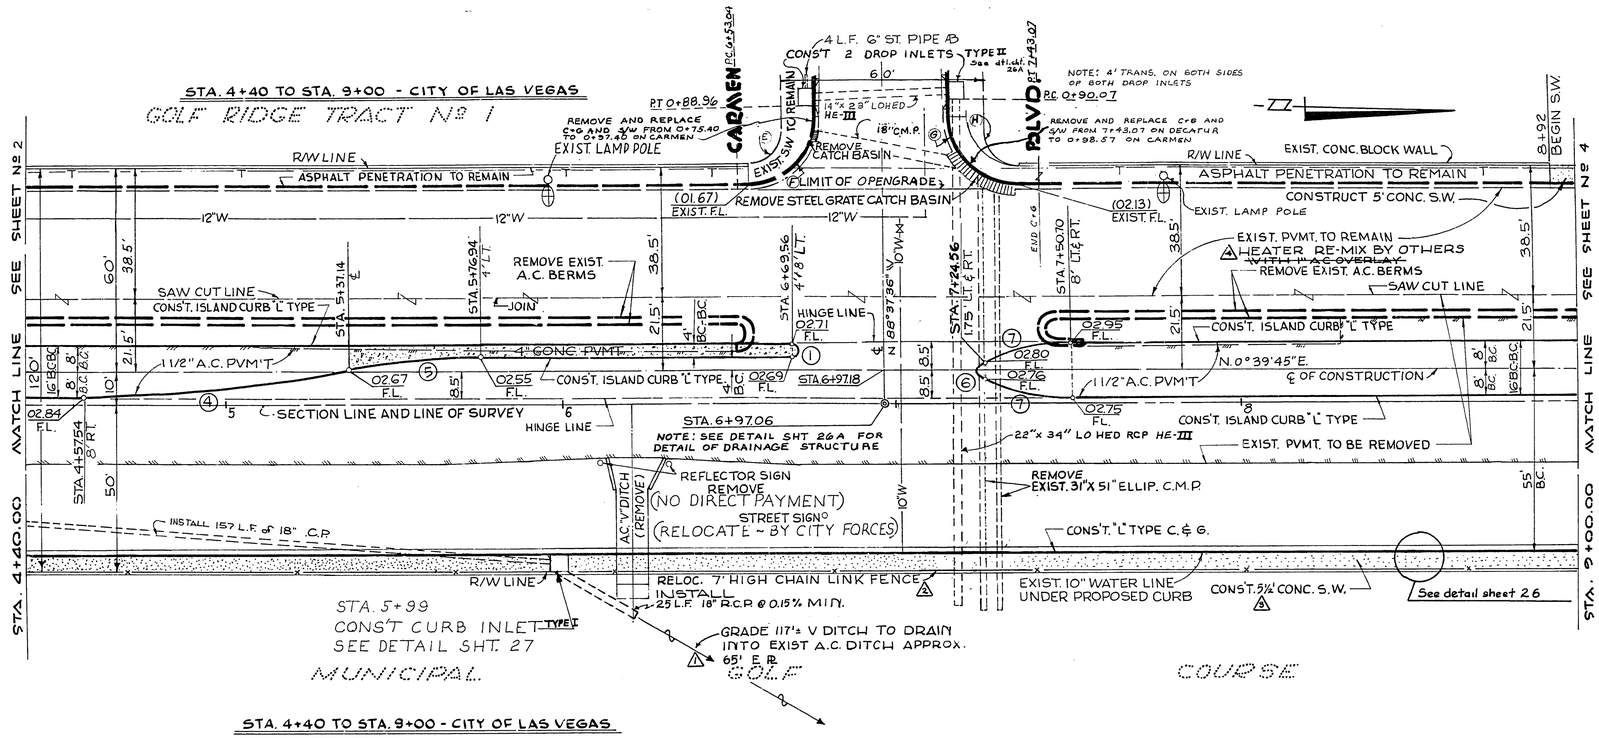

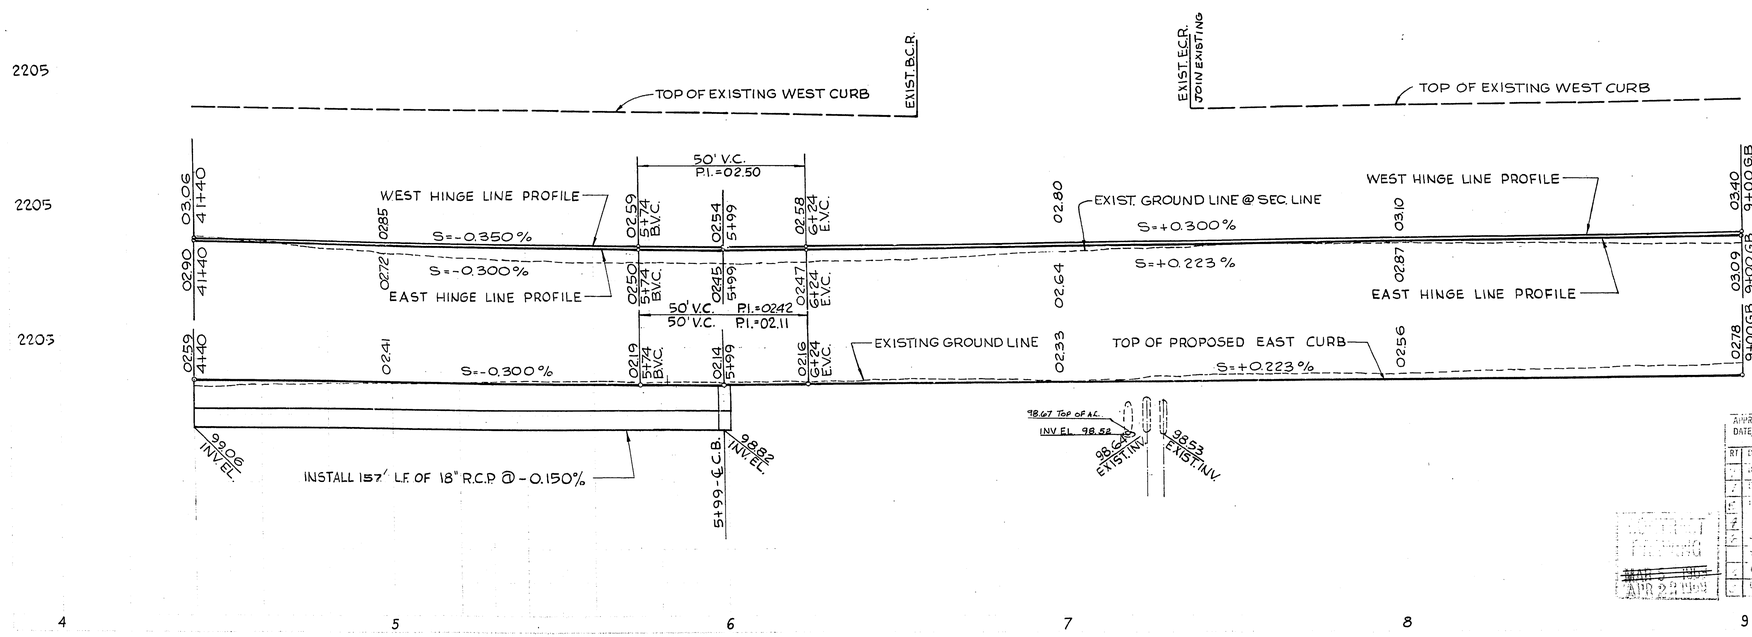

CURVE	DELTA	RADIUS	LENGTH	TANGENT
①	180°00'00"	2.00'	6.28'	∞
④	11°28'42"	400.00'	80.13'	40.20'
⑤	11°28'42"	200.00'	40.07'	20.10'
⑥	122°05'24"	2.00'	4.26'	3.61'
⑦	28°57'18"	50.00'	25.27'	12.91'
Ⓔ	89°17'21"	15.00'	23.38'	14.82'
Ⓕ	89°17'21"	24.50'	38.18'	24.20'
Ⓖ	90°42'39"	24.50'	38.79'	24.80'
Ⓗ	90°42'39"	15.00'	23.75'	15.19'

REV.	DATE	DESCRIPTION	APP.
1	4-2-69	GRADE V DITCH TO DRAIN	
2	4-2-69	RELOCATE CHAIN LINK FENCE	
3	4-2-69	CONST. 5½' CONC. S.W.	
4	4-2-69	HEATER RE-MIX BY OTHERS	
4	4-16-69	REVISED CULVERT	
		RBS 4/18/69	

CITY OF LAS VEGAS, NEVADA
ENGINEERING DEPARTMENT

DECATUR BLVD.

WASHINGTON AVE. TO U.S. HIGHWAY Nº 95

STA. 4+40.00 TO STA. 9+00.00

WO 7570 & 4810	DATE	HORIZONTAL SCALE 1" = 20'
DESIGN G.E.C.		
DRAWN HURTADO	12-1-66	VERTICAL SCALE 1" = 5'
CHECKED JGD		
CONSULTING ENG. R.E. 2467	5-17-68	
TRAFFIC ENG.		F.B. Nº
CITY ENGINEER	3/5/69	C.L.V. DRWG. Nº 107V-738
PREPARED BY TYSON ENGINEERING COMPANY INC.		SHEET 3 OF 42

ITEM	DESCRIPTION	R.S.H.	C.L.V. S.A.D.	C.L.V.	TOTAL	UNIT
121.218	18" R.C.P. 1350D	182.223			182.223	L.F.
201.100	EXCAVATION	1649.1637		G.4	1607.1761	C.Y.
201.100	SAWCUT A.C. PAVEMENT	460.605		146	460.751	L.F.
302.100	TYPE I GRAVEL BASE	638.675			638.679	C.Y.
302.200	TYPE II GRAVEL BASE	4004.425	1	35.53	4040.195	C.Y.
333.100	BIT. FOG SEAL	4334.645			840.0	S.Y.
333.500	1/2" OPEN GRADE PLANTMIX	4770.		195	4770.	S.Y.
334.400	2½" A.C. PAVEMENT			195	195	S.Y.
334.212	6" A.C. PAVEMENT	3160			3160	S.Y.
334.300	1 1/2" A.C. ISLAND PAVEMT	434			434	S.Y.
340.190	24" "L" TYPE CURB & G.	466.546		87	466.633	L.F.
340.200	18" "L" TYPE CURB & GUTTER	820		86.75	906.75	L.F.
340.300	4" CONC. SIDEWALK		40	3208	3248	S.F.
340.311	4" CONC. ISLAND PAVMT				587	S.F.
200.500T	RELOCATE FENCE			460	460	L.F.
500.100T	ENCASEMENT BLANKET	500			500	S.F.
500.200T	CURB INLET TYPE I	1			1	EACH
500.201T	CURB INLET TYPE II	2			2	EACH
N.I.C.	REMOVE 31" x 51" ELLIP. RCP			1	1	EACH
121.527	22"x34" LO HED RCP	148			148	L.F.
200.110	REMOVE 31" x 51" CMP	250			250	L.F.
200.110	REMOVE CATCH BASIN	1			1	EACH
200.110	REMOVE CURB & GUTTER	79.105			79.105	L.F.
200.110	REMOVE SIDEWALK	339.435			339.435	S.F.
560.760	RELOCATE WATER LINE			LS	LS	LS
340.312	ISLAND CONC. COLOR	587			587	S.F.
121.518	14"x23" LO HED RCP	41			41	L.F.

107-V-738