11-4-50

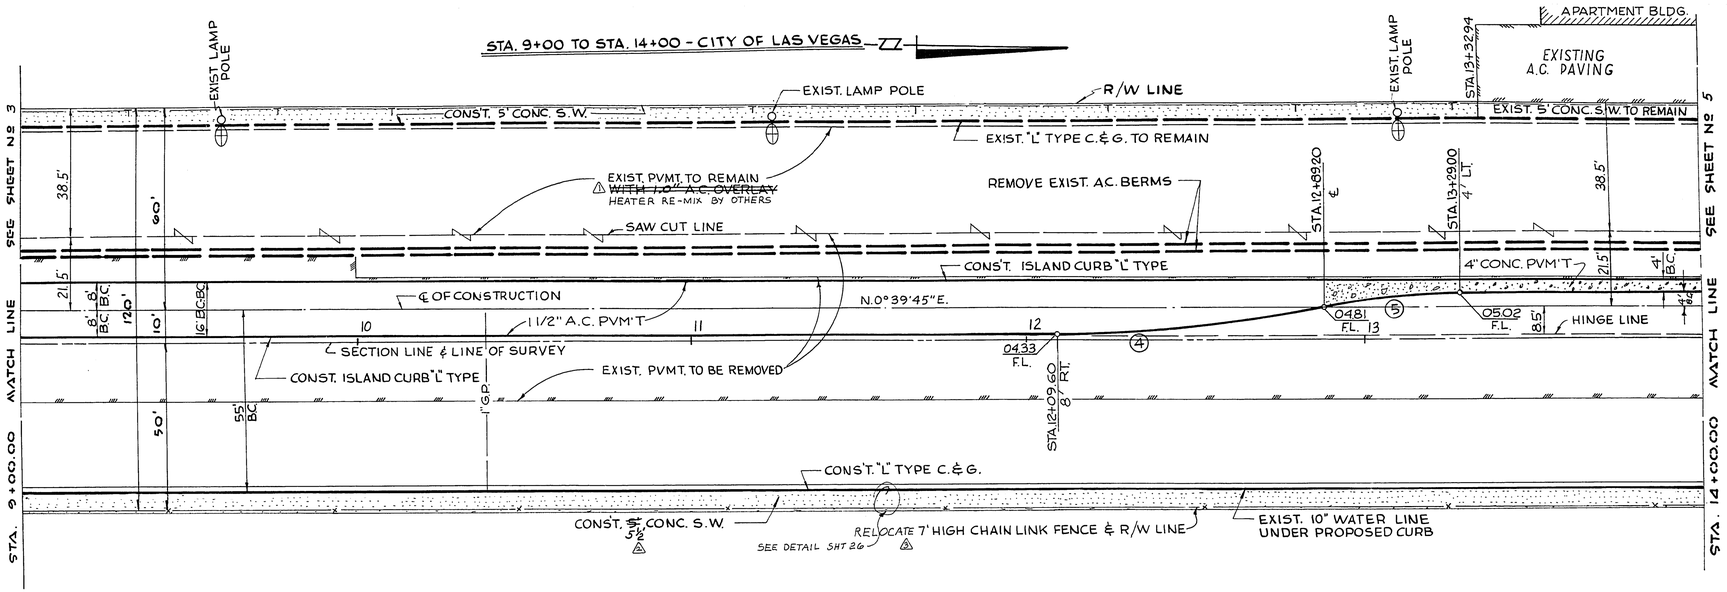

STA. 9+00 TO STA. 14+00 - CITY OF LAS VEGAS

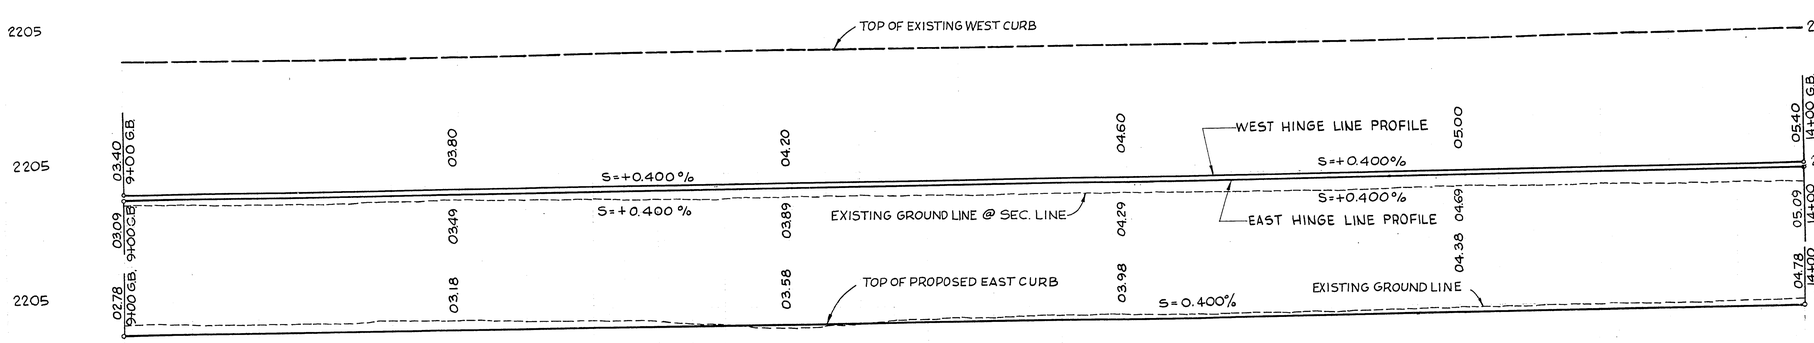

"AS CONSTRUCTED"

ITEM	DESCRIPTION	R.S.H.	CLV. SAD	C.L.V.	TOTAL	UNIT
201.100	EXCAVATION	1336	60	69	1465	C.Y.
201.100	SAWCUT A.C. PAVEMENT	500			500	L.F.
302.100	TYPE I GRAVEL BASE	664			664	C.Y.
302.200	TYPE II GRAVEL BASE	440	30	35.35	505.35	C.Y.
333.100	BIT. FOG SEAL	668			668	S.Y.
333.500	1/2" OPEN GRADE PLANT MIX	5019			5019	S.Y.
334.200	1" A.C. OVERLAY	1750			1750	S.Y.
334.212	6" A.C. PAVEMENT	3258			3258	S.Y.
334.300	1 1/2" A.C. ISLAND PAVEMENT	668			668	S.Y.
340.190	24" "L" TYPE CURB & GUTTER	500			500	L.F.
340.200	18" "L" TYPE CURB & GUTTER	1001			1001	L.F.
340.300	4" CONC. SIDEWALK		216.5	8750 / 2550	11300	S.F.
340.311	4" ISLAND CONCRETE	496			496	S.F.
200.500/T	RELOCAT FENCE		500		500	L.F.
340.312	ISLAND CONC. COLOR	496			496	S.F.

CURVE	DELTA	RADIUS	LENGTH	TANGENT
④	11°28'42"	400.00'	80.13'	40.20'
⑤	11°28'42"	200.00'	40.07'	20.10'

REV	DATE	DESCRIPTION	APP.
3	4-3-69	Heater re-mix by others replaces 1" AC overlay on remain pvmt	
2	4-3-69	Const. 5' conc. sw. to 5½'	
1	4-3-69	Relocate 7' chain link fence	
		RPS 4/18/69	

CITY OF LAS VEGAS, NEVADA
ENGINEERING DEPARTMENT

DECATUR BLVD.

WASHINGTON AVE. TO U.S. HIGHWAY Nº 95

STA. 9+00.00 TO STA. 14+00.00

		DATE
W.O. 7570 & 4810		
DESIGN	G.E.C.	
DRAWN	HURTADO	11-2-66
CHECKED	S.E.O.	
CONSULTING ENG.	R.E. 2467	5-17-68
TRAFFIC ENG.		
CITY ENGINEER		3/5/69

HORIZONTAL SCALE 1" = 20'
VERTICAL SCALE 1" = 5'
F.B. Nº
C.L.V. DRWG. Nº 107V-738

PREPARED BY TYSON ENGINEERING COMPANY INC.

SHEET 4 OF 42

APPROVED
DATE

RT	DIV		DATE
7	D.P.W.		3/5/69
1	ENG.		2/26
5	T.		3-4-69
4			
6	S.		
	SUP.		
2	TRAF.		2/26
3	UTIL.		

CONTROLLER DRAFTING
~~MAR 5 1969~~
APR 2 1969

107-V 738