11-4-51

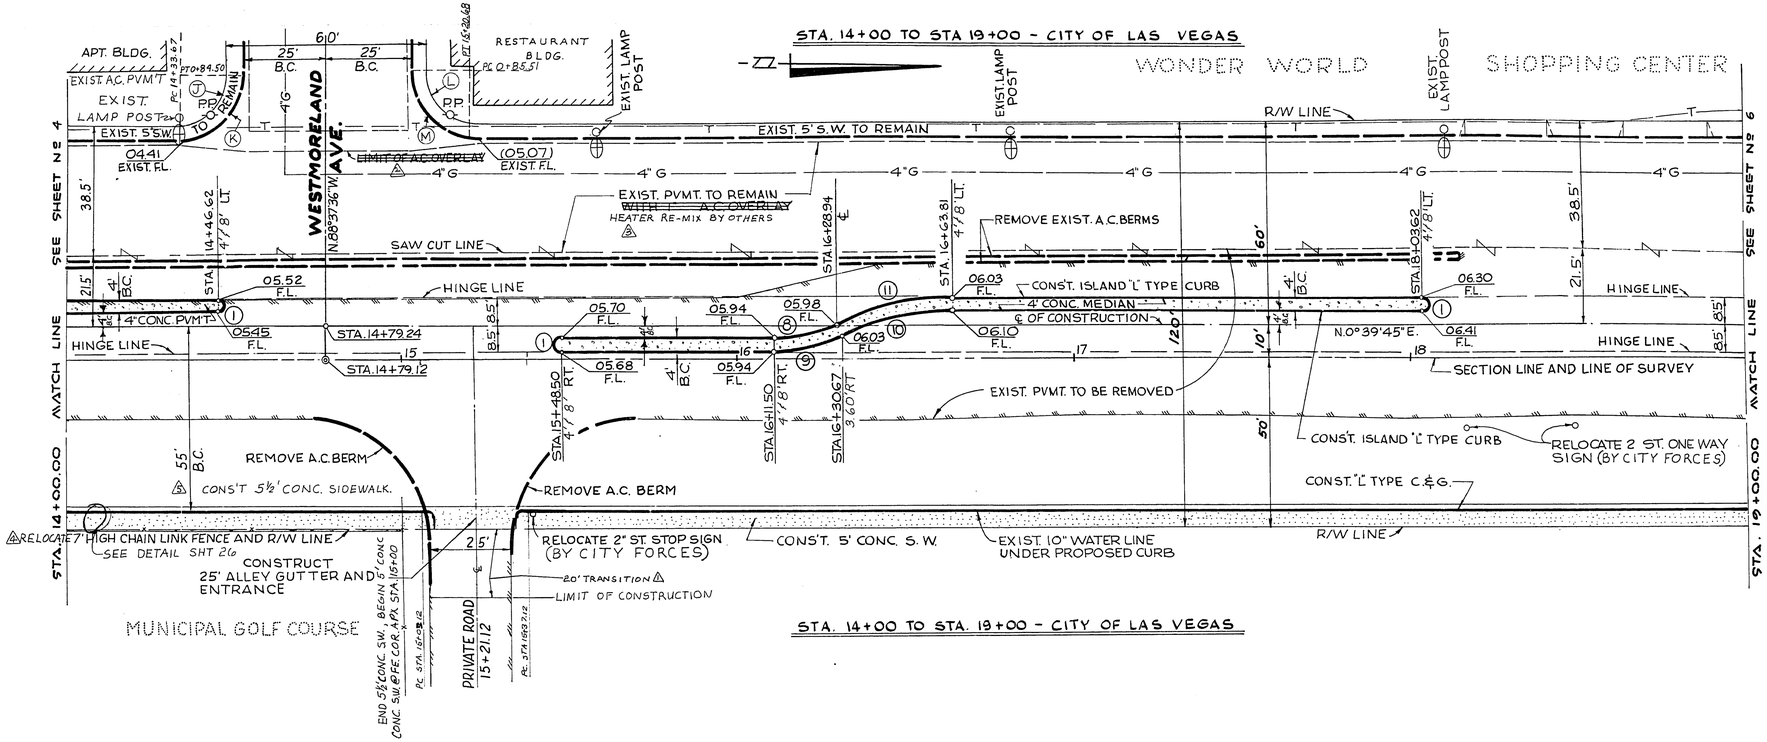

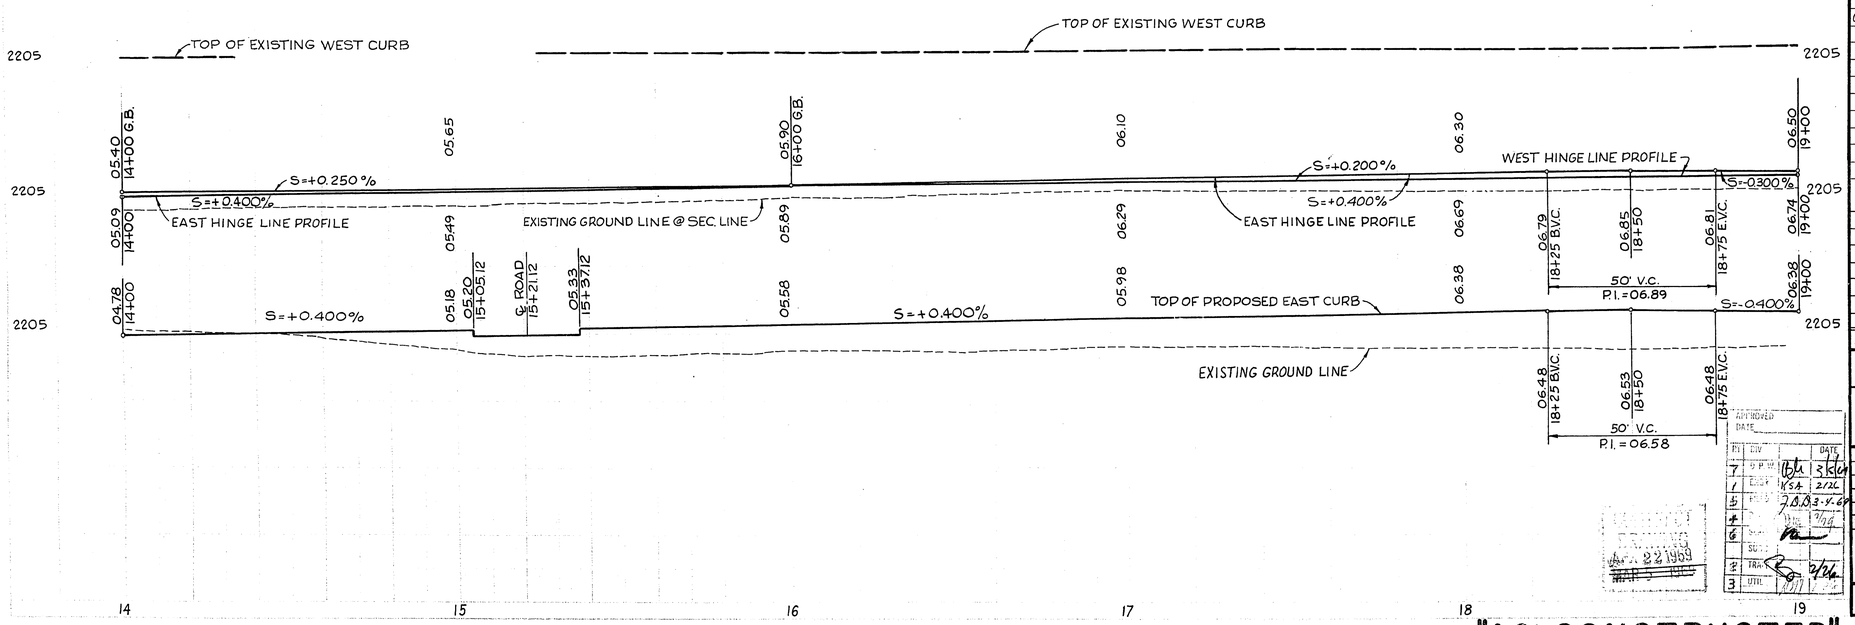

"AS CONSTRUCTED"

ITEM	DESCRIPTION	R.S.H.	C.L.V. SAD	C.L.V.		TOTAL	UNIT
201.100	EXCAVATION	1895		69		1965	C.Y.
201.100	SAWCUT A.C. PAVEMENT	500				500	L.F.
302.100	TYPE 1 GRAVEL BASE	7.02				7.62	C.Y.
302.200	TYPE 2 GRAVEL BASE	4.71				~~8.85~~ 5.12	C.Y.
333.500	1½" OTW GRADE PLANTMIX	5753				5753	S.Y.
334.200	1½" OTW OVERLAY	~~1750~~				~~1750~~	S.Y.
334.212	C.A.C. PAVEMENT	4003				4003	S.Y.
340.190	24" TYPE CURB & GUTTER	475				475	L.F.
340.200	18" "L" TYPE CURB & GUTTER	625				625	L.F.
340.300	4" CONC. SIDEWALK					~~2375~~	S.F.
340.311	4" CONC. ISLAND PAVEMT	1233				1233	S.F.
340.600	CONC. ALLEY GUTTER			175		175	S.F.
334.300	1½" A.C. PAVEMENT			56		56	S.Y.
N.I.C.	RELOCATE SIGN					3	EACH
200.500T	RELOCATE FENCE			100		100	L.F.
340.312	ISLAND CONC. COLOR	1233				1233	S.F.

CURVE	DELTA	RADIUS	LENGTH	TANGENT
①	180°0000	2.00'	6.28'	∞
⑧	25°50'31"	40.00'	18.04'	9.18'
⑨	25°50'31"	44.00'	19.85'	10.09'
⑩	25°50'31"	76.00'	34.28'	17.44'
⑪	25°50'31"	80.00'	36.08'	18.35'
Ⓙ	89°17'21"	15.00'	23.38'	14.82'
Ⓚ	89°17'21"	20.00'	31.17'	19.75'
Ⓛ	90°42'39"	15.00'	23.75'	15.19'
Ⓜ	90°42'39"	20.00'	31.66'	20.25'

REV.	DATE	DESCRIPTION	APP.
4	3-27-69	ADDED 20' TRANSITION	
3	4-3-69	Delete: "Limit of AC overlay" Westmoreland Ave.	
2	4-3-69	Heater re-mix by others replaces 1" AC overlay on remain pvmt	
1	4-3-69	Relocate 7' chain link fence	
0	4-3-69	Const: 5½' sw 14+00 to end of fence	
		G.R.S. 4/8/69	

CITY OF LAS VEGAS, NEVADA
ENGINEERING DEPARTMENT

DECATUR BLVD.
WASHINGTON AVE. TO U.S. HIGHWAY Nº 95
STA. 14+00.00 TO STA. 19+00.00

		DATE
W.O. 75701 4810		
DESIGN	C.E.C.	
DRAWN	HURTADO	12-2-66
CHECKED	S.P.D.	
CONSULTING ENG.	R.E. 2467	5-17-68
TRAFFIC ENG.		
CITY ENGINEER		3/5/69

HORIZONTAL SCALE 1" = 20'
VERTICAL SCALE 1" = 5'
F.B. Nº
C.L.V. DRWG. Nº 107 V-738

PREPARED BY
TYSON ENGINEERING COMPANY INC.

SHEET 5 OF 42

107 V 738