
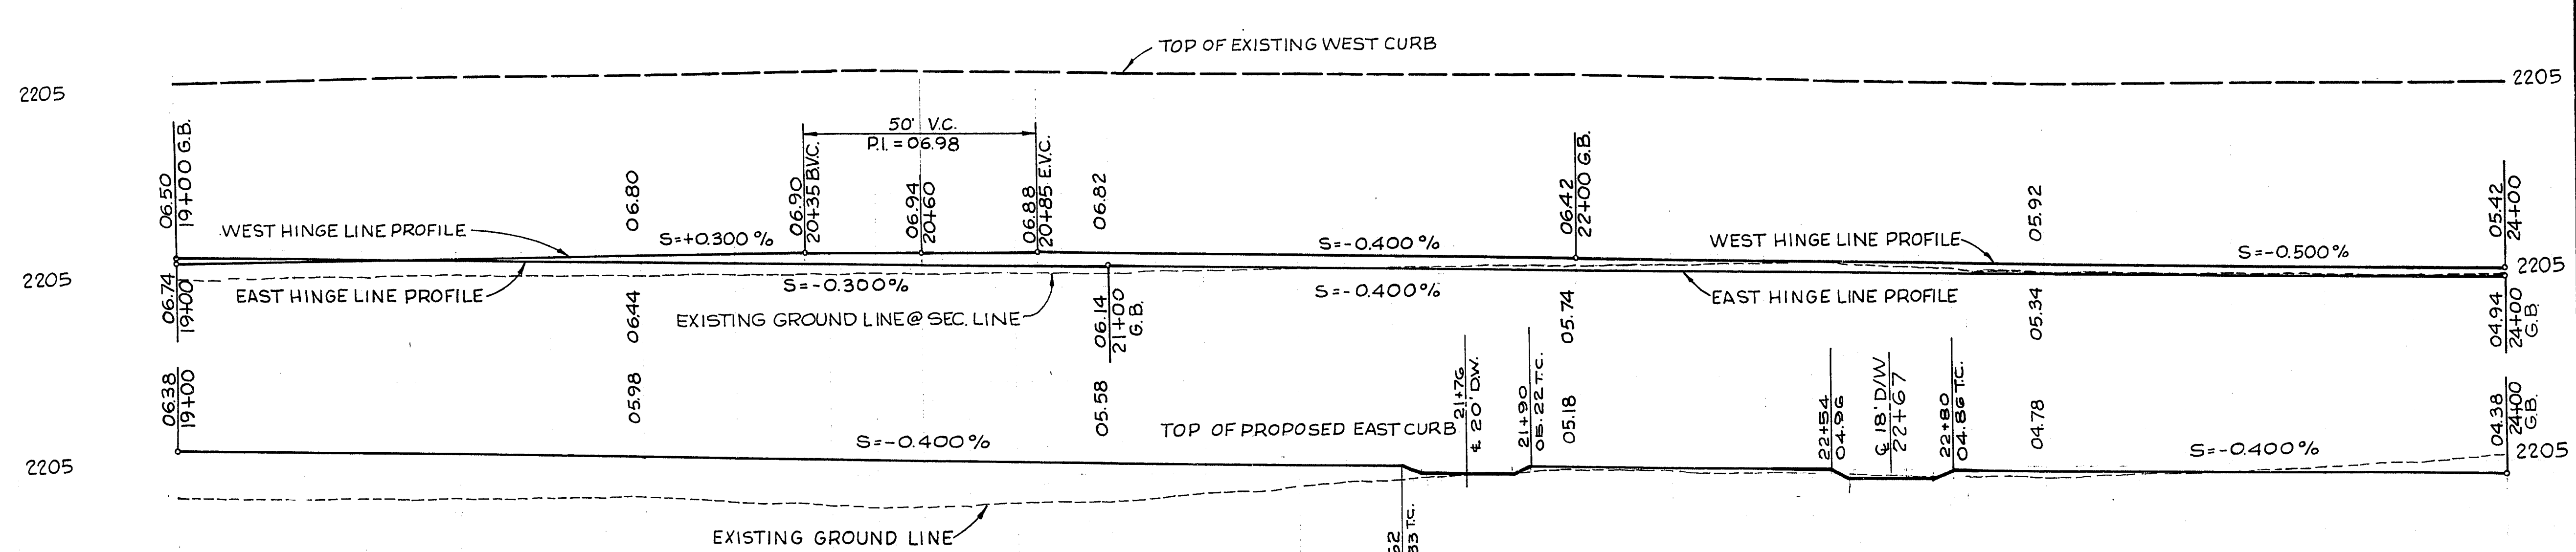


11-4-53

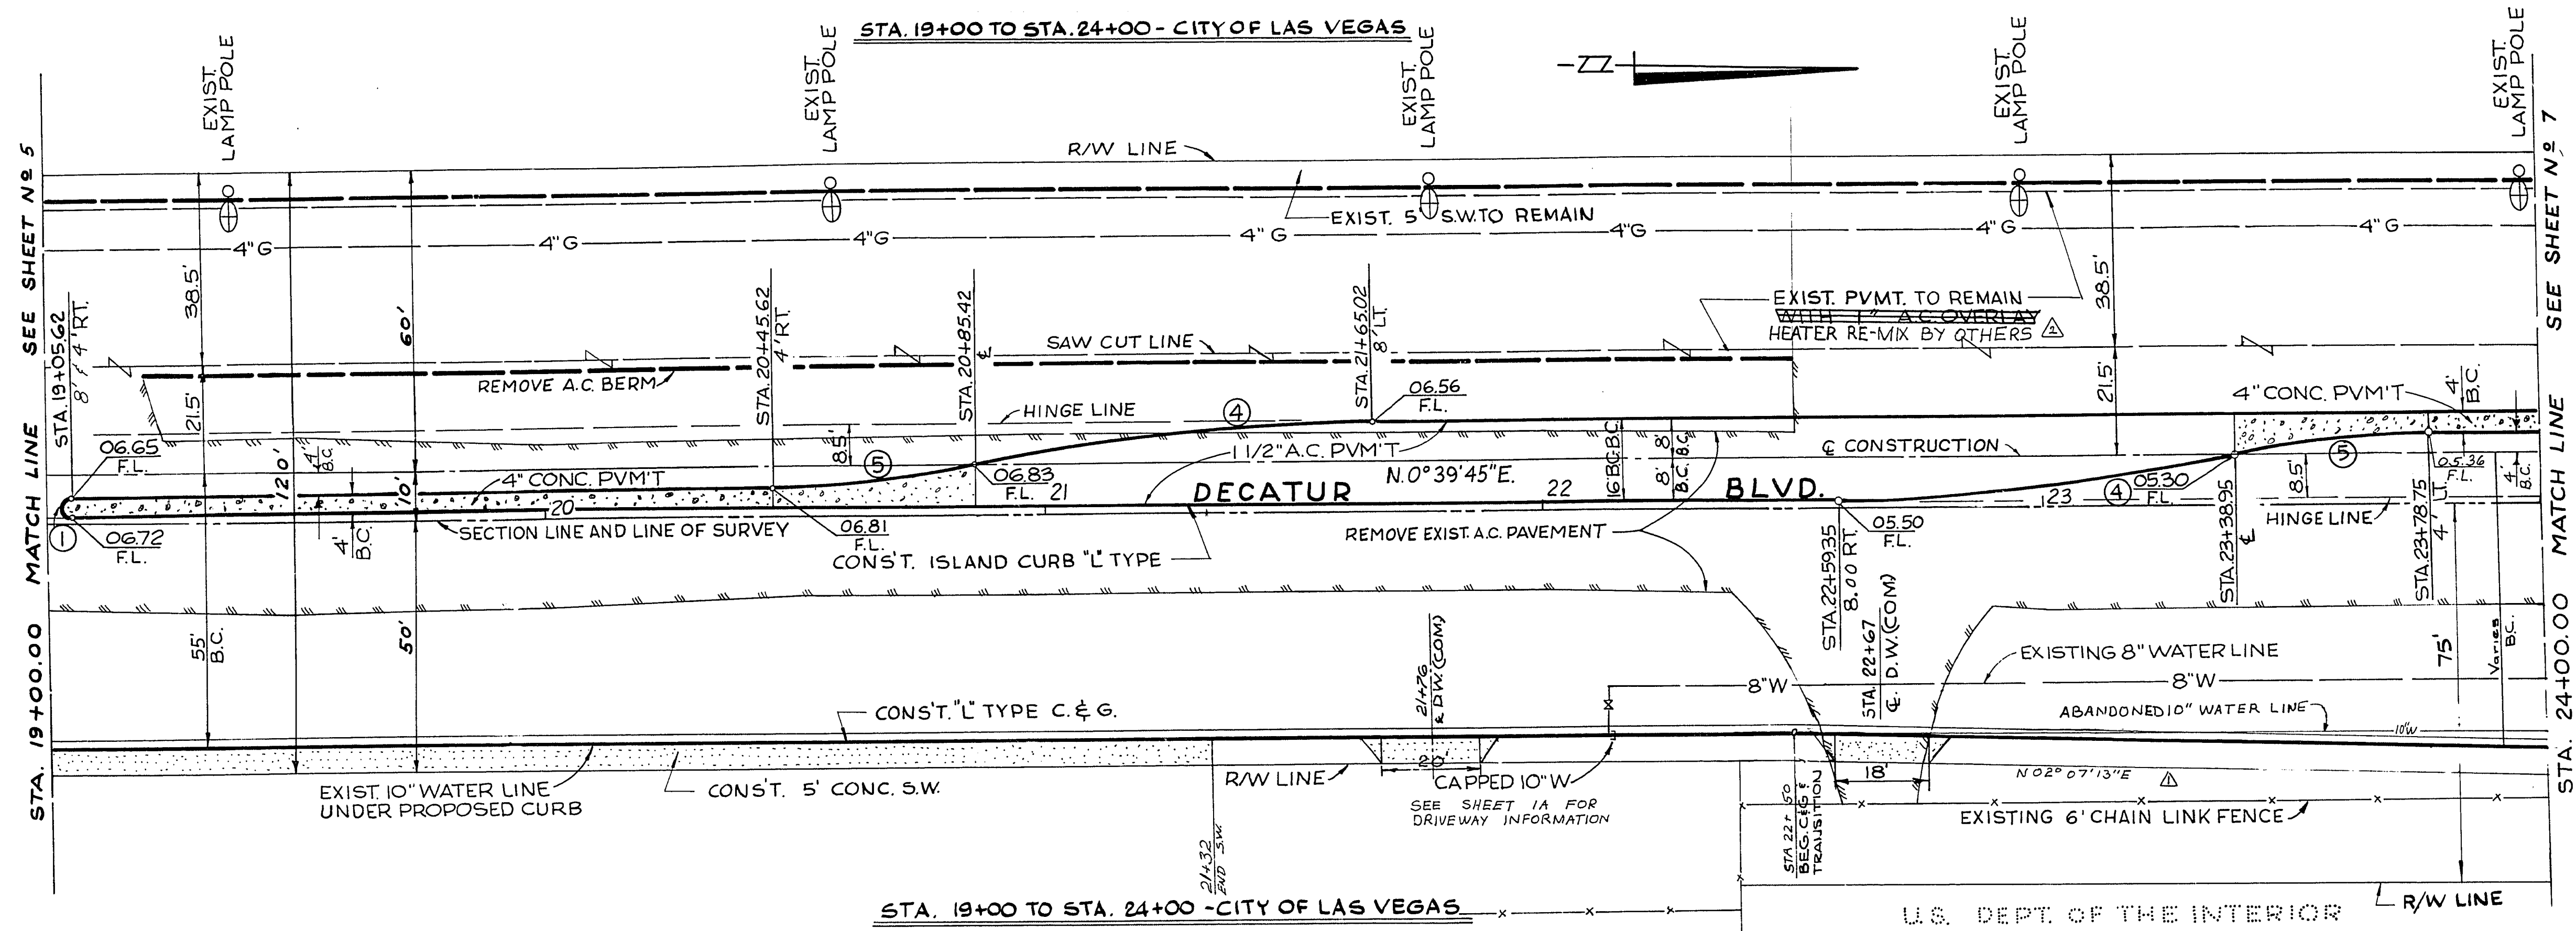

ITEM	DESCRIPTION	R.S.H.	CLV S.A.D.	CLV.	TOTAL	
					UNIT	CLV.
201.100	EXCAVATION	168.4		69	1753	C.Y.
201.100	REMOVE EXIST. AC PAVEMENT	500			500	L.F.

CURVE	DELTA	RADIUS	LENGTH	TANGENT
①	180°00'00"	2.00'	6.28'	∞
②	11°28'42"	400.00'	80.13'	40.20'
③	11°28'42"	200.00'	40.07'	20.10'

REV	DATE	DESCRIPTION	APP.
4-3-49		MOVE SIDEWALK, C&G FROM 22+50 TO 22+07'13"E TO 25+86.34	
4-3-49		Heater re-mix by others replaces 1" AC overlay on remain pvm't.	
4-16-69		Delete sidewalk (portion) east side from 21+32	

CITY OF LAS VEGAS, NEVADA  
ENGINEERING DEPARTMENT

**DECATUR BLVD.**  
WASHINGTON AVE. TO U.S. HIGHWAY N<sup>o</sup> 95  
STA. 19+00.00 TO STA. 24+00.00

DESIGN	G.E.C.	DATE	HORIZONTAL SCALE
DRAWN	HURTADO	12-3-66	1" = 20'
CHECKED	S.C.D.		VERTICAL SCALE
CONSULTING ENG.	PERZBERG	5-17-68	1" = 5'
TRAFFIC ENG.			F.B. N <sup>o</sup>
CITY ENGINEER			

C.L.V. DRWG. NO. 107V-738  
PREPARED BY TYSON ENGINEERING COMPANY INC. SHEET 6 OF 42

APP'D	DATE	DATE
7	3/14/67	
1	2/22/67	

AS CONS

107-7738