


FIELD CHECK DATE
 CONSTRUCTION DIVISION
 ENGINEERING SECTION

FIELD CHECK DATE
 CONSTRUCTION DIVISION
 ENGINEERING SECTION

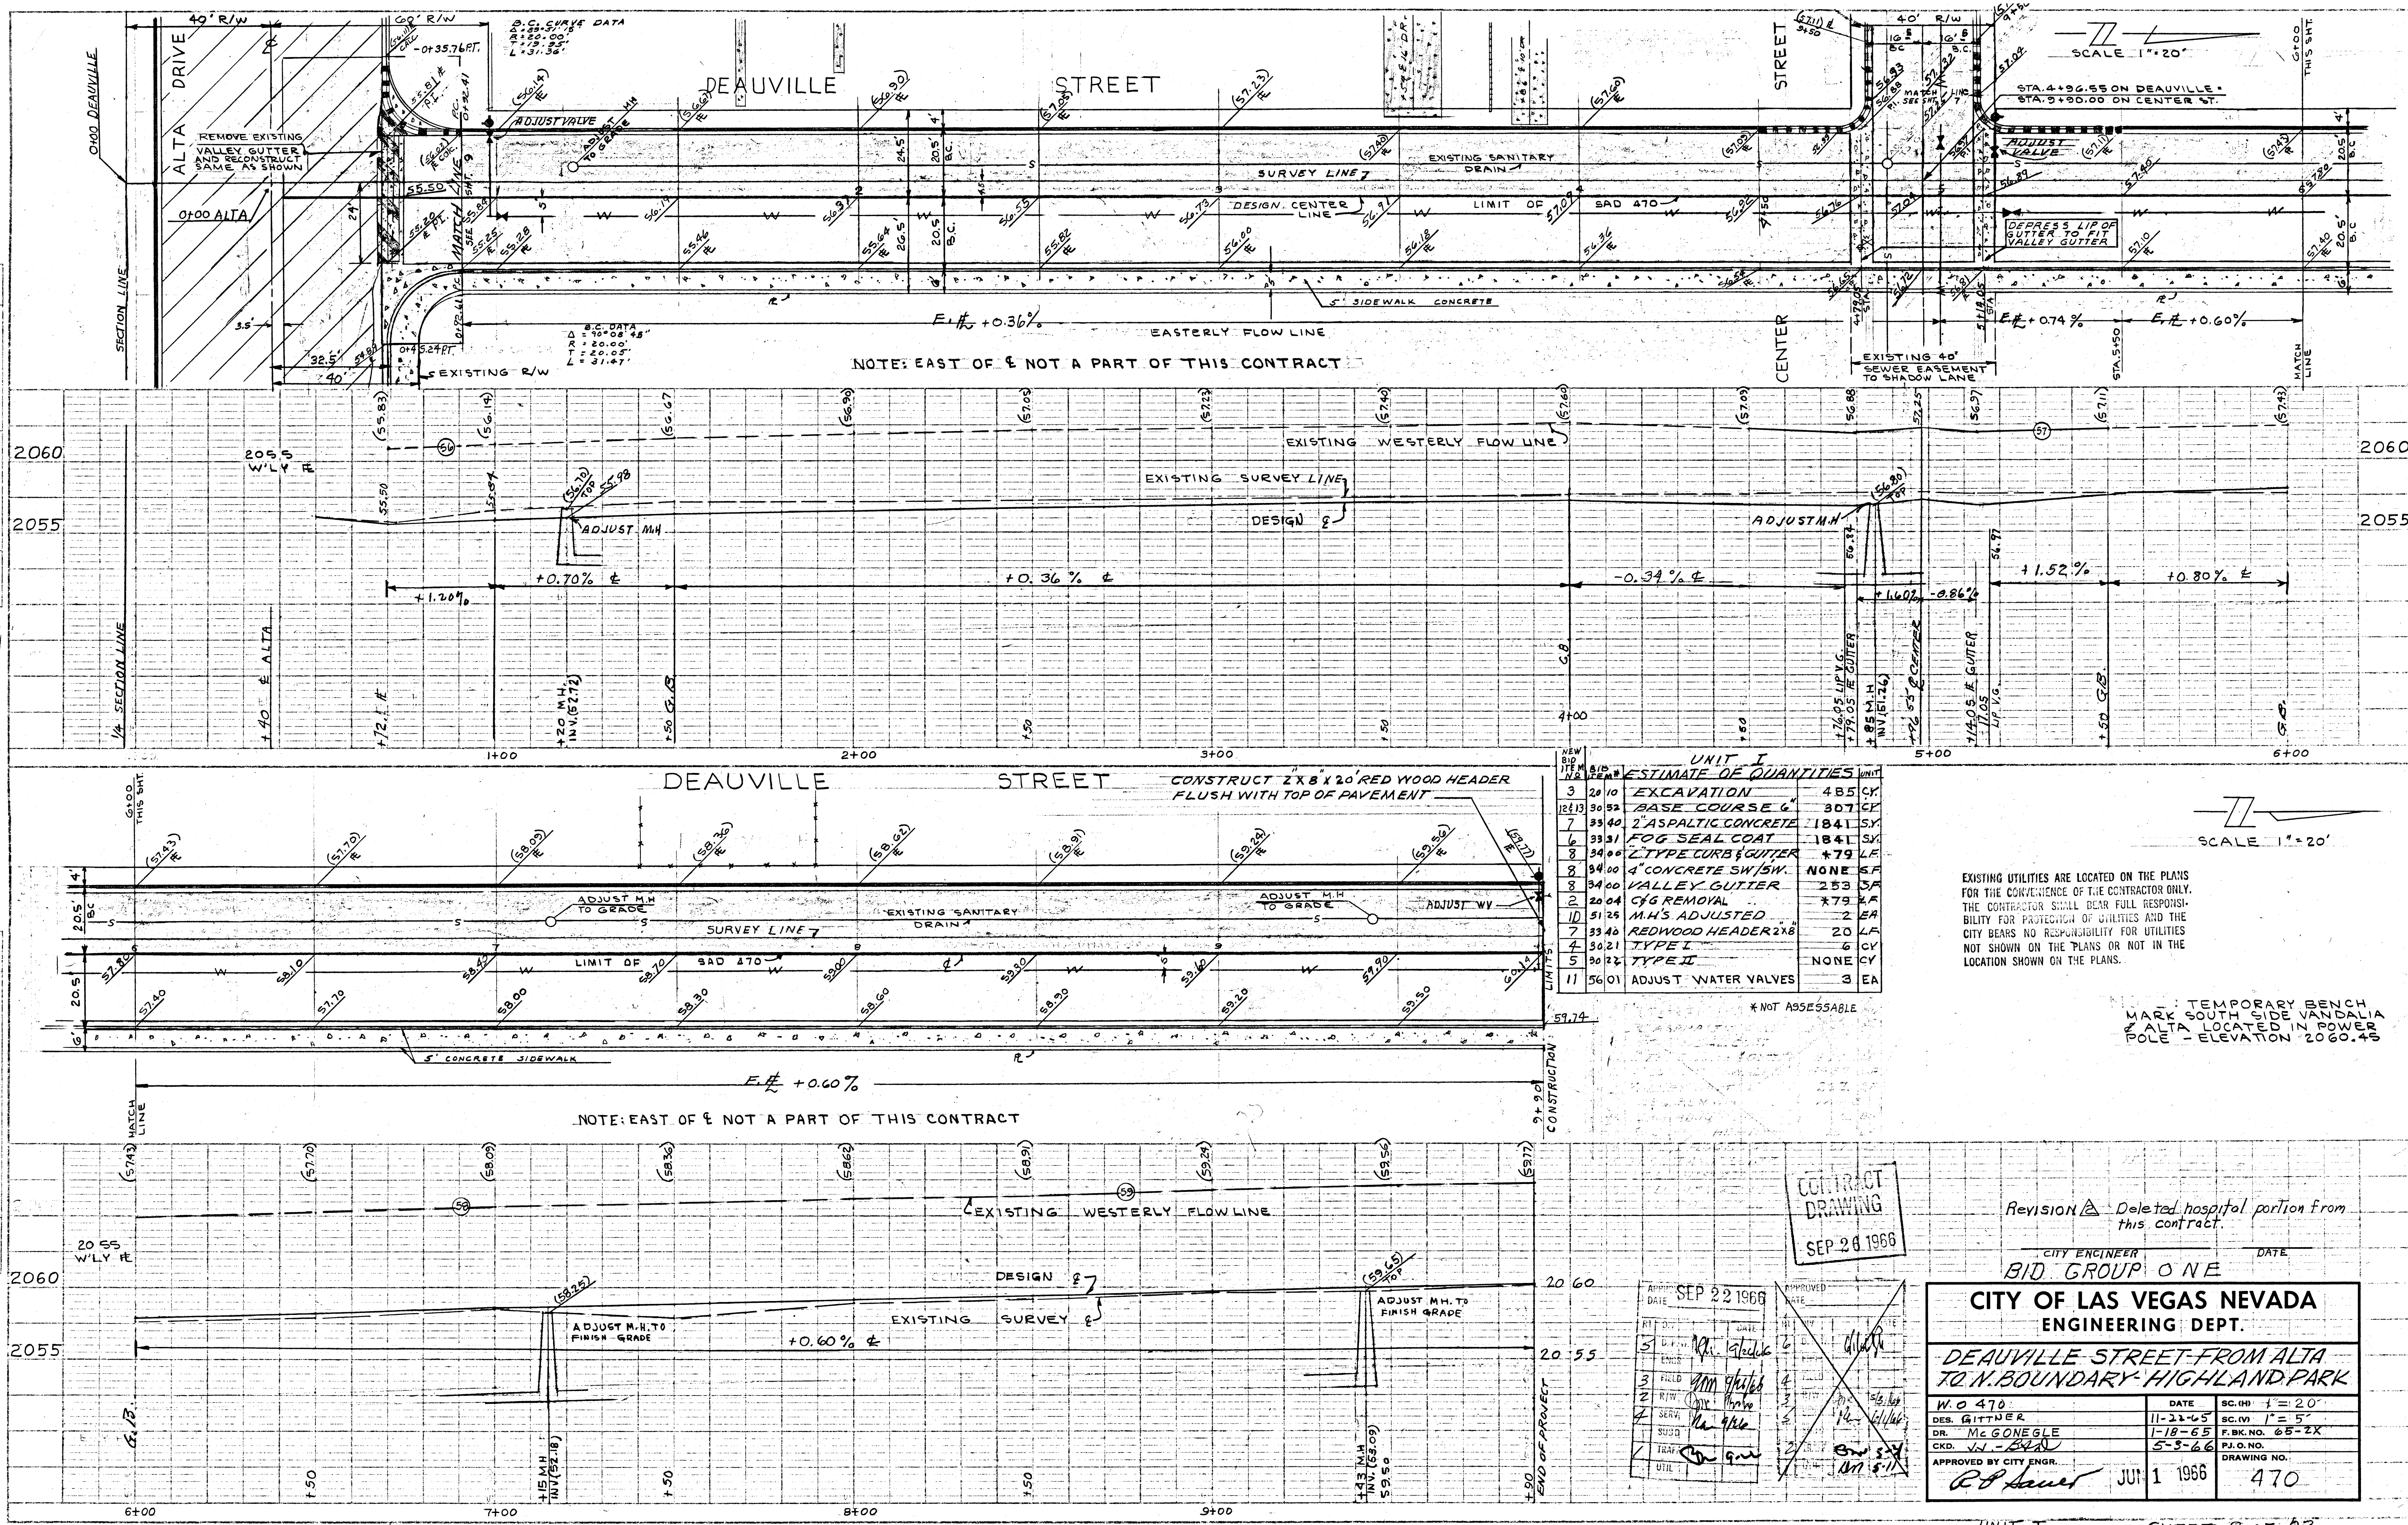

UNIT I

NO.	DESCRIPTION	QUANTITY	UNIT
3	EXCAVATION	485	CU YD
10	BASE COURSE 6"	307	CU YD
7	2" ASPHALT CONCRETE	184	CU YD
6	FOG SEAL COAT	184	CU YD
8	2" TYPE CURB & GUTTER	79	LF
8	4" CONCRETE SW/SH	NONE	EA
8	VALLEY GUTTER	253	EA
2	CFG REMOVAL	79	EA
10	M.H.'S ADJUSTED	2	EA
7	REDWOOD HEADER 2x8	20	LF
4	TYPE I	6	CU YD
5	TYPE II	NONE	CU YD
11	ADJUST WATER VALVES	3	EA

* NOT ASSESSABLE

EXISTING UTILITIES ARE LOCATED ON THE PLANS FOR THE CONVENIENCE OF THE CONTRACTOR ONLY. THE CONTRACTOR SHALL BEAR FULL RESPONSIBILITY FOR PROTECTION OF UTILITIES AND THE CITY BEARS NO RESPONSIBILITY FOR UTILITIES NOT SHOWN ON THE PLANS OR NOT IN THE LOCATION SHOWN ON THE PLANS.

TEMPORARY BENCH MARK SOUTH SIDE VANDALIA ALTA LOCATED IN POWER POLE - ELEVATION 2060.45

CONTRACT DRAWING
 SEP 26 1966

Revision A Deleted hospital portion from this contract.

CITY ENGINEER
 BID GROUP ONE

CITY OF LAS VEGAS NEVADA
 ENGINEERING DEPT.

DEAUVILLE STREET FROM ALTA TO N. BOUNDARY-HIGHLAND PARK

W.O. 470	DATE 11-22-65	SC. 1/1"=20'
DES. GITTNER	11-22-65	SC. 1/1"=5'
DR. Mc GONIGLE	1-18-66	F.B.K. NO. 65-2X
CKD. J.L. - 244	5-3-66	P.L.O. NO.
APPROVED BY CITY ENGR.	JUN 1 1966	DRAWING NO. 470

UNIT I SHEET 8 OF 23