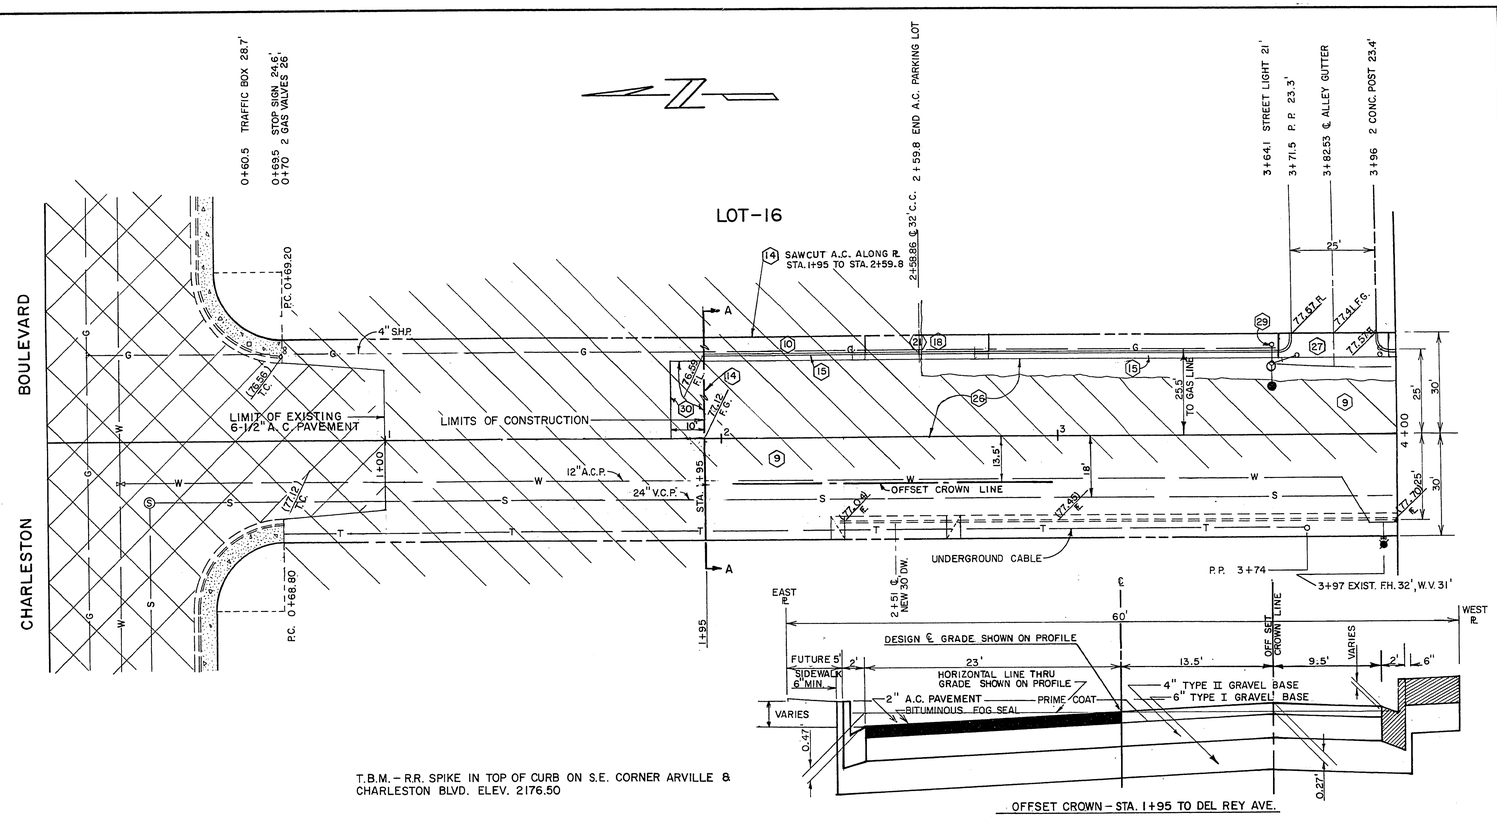

T.B.M. – R.R. SPIKE IN TOP OF CURB ON S.E. CORNER ARVILLE & CHARLESTON BLVD. ELEV. 2176.50

ARVILLE STREET

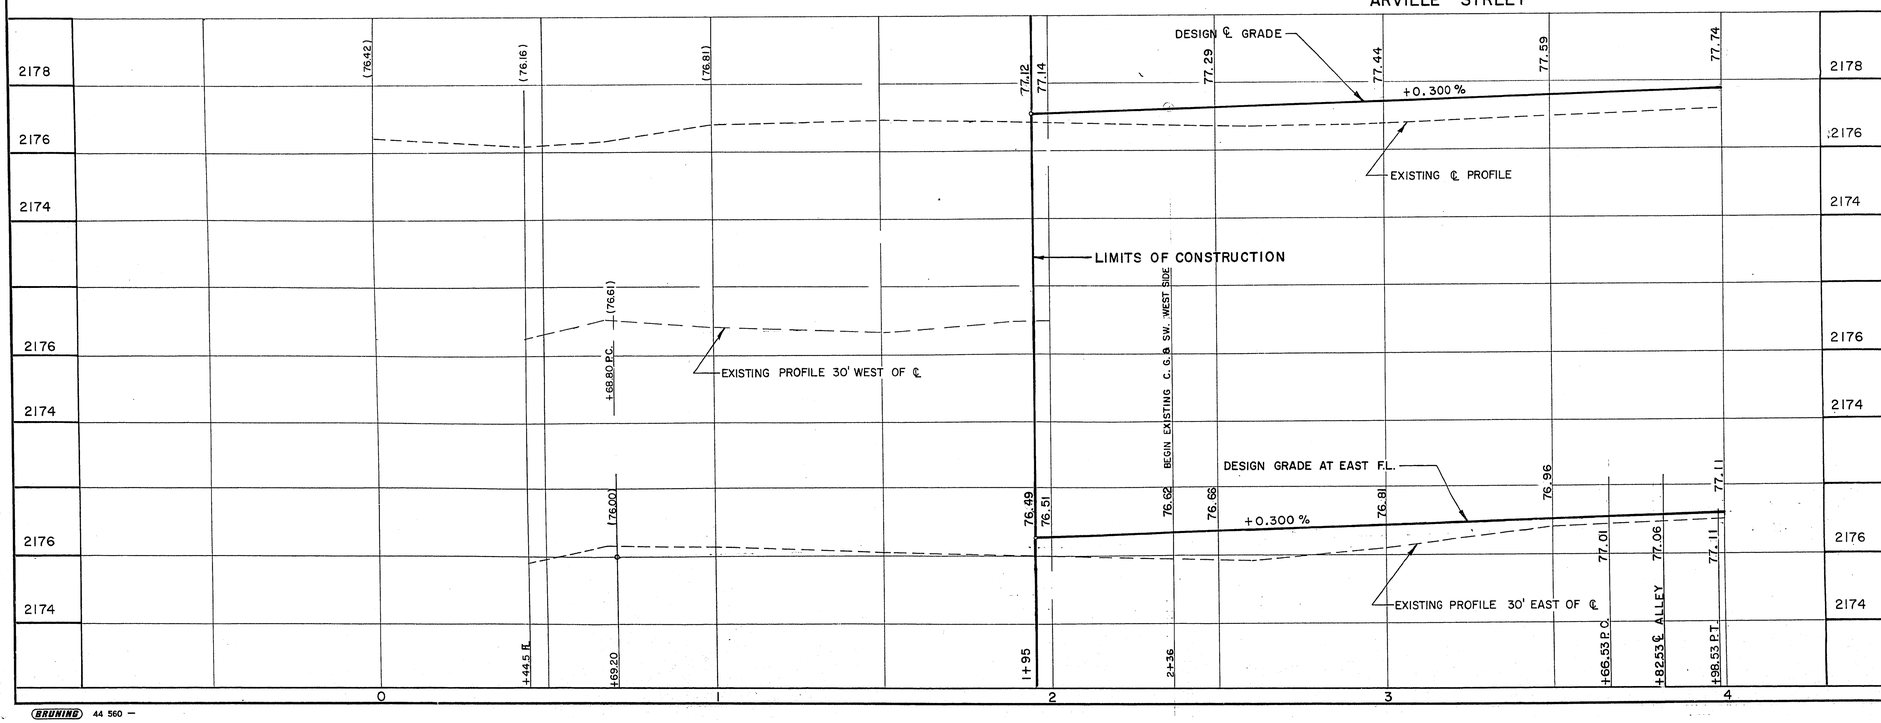

CONST. NOTE NO.	APPROXIMATE QUANTITIES – THIS SHEET			
	ITEM	DESCRIPTION	UNIT	QUANTITY
	201.100	EXCAVATION	C.Y.	35
26	302.100	TYPE I GRAVEL	C.Y.	97
26	302.200	TYPE II GRAVEL	C.Y.	58
21	334.003	1-1/2" A.C. TRANSITION	S.Y.	18
26	334.004	2" A.C. PAVEMENT	S.Y.	524
15	340.014	"L" TYPE CURB AND GUTTER	L.F.	133
30	334.004	2" A.C. PAVEMENT (TEMP. TRANS.)	S.Y.	26
18	340.226	COMMERCIAL CURB CUT	L.F.	40
27	340.326	CONCRETE ALLEY GUTTER	S.F.	224
14	201.100	SAWCUT A.C.	L.F.	95
9 & 10	201.100	REMOVE A.C. PAVEMENT	S.Y.	497
29	L-1	RELOCATE & REWIRE EXIST. ST. LIGHT ON NEW 60" FOUNDATION	EA.	1

APPROVED
DATE

BY	DATE
7	10-27-69
6	9-10-69
5	7-10-69
4	7/5/69
3	9/8
2	
1	KSA 9/3/69

CONTRACT DRAWING
SEP 22 1969

REVISION NO.	DESCRIPTION	BY	DATE	APPROVAL
1	AS-BUILT R. ELEV'S. WESTSIDE CHGD. GRADE TO MATCH	M.P	10/27	

REVISIONS

CITY OF LAS VEGAS NEVADA
DEPARTMENT OF PUBLIC WORKS
SERVICES DIVISION

EAST SIDE OF ARVILLE STREET CHARLESTON BLVD. TO DEL REY AVE.

W.O. NO. 3057	F. BK. NO. 69-3X	DATE
SC. (H) 1" = 20'	SC. (V) 1" = 2'	JUNE, 1969
DES. W. JAUBERT		DRAWING NO. 107V-801
DR. H. FRAZIER		FILE NO.
APPROVED BY DIRECTOR OF PUBLIC WORKS	9/16/69	SHEET 3 OF 5

15-1-77

BRUNING 44 560