


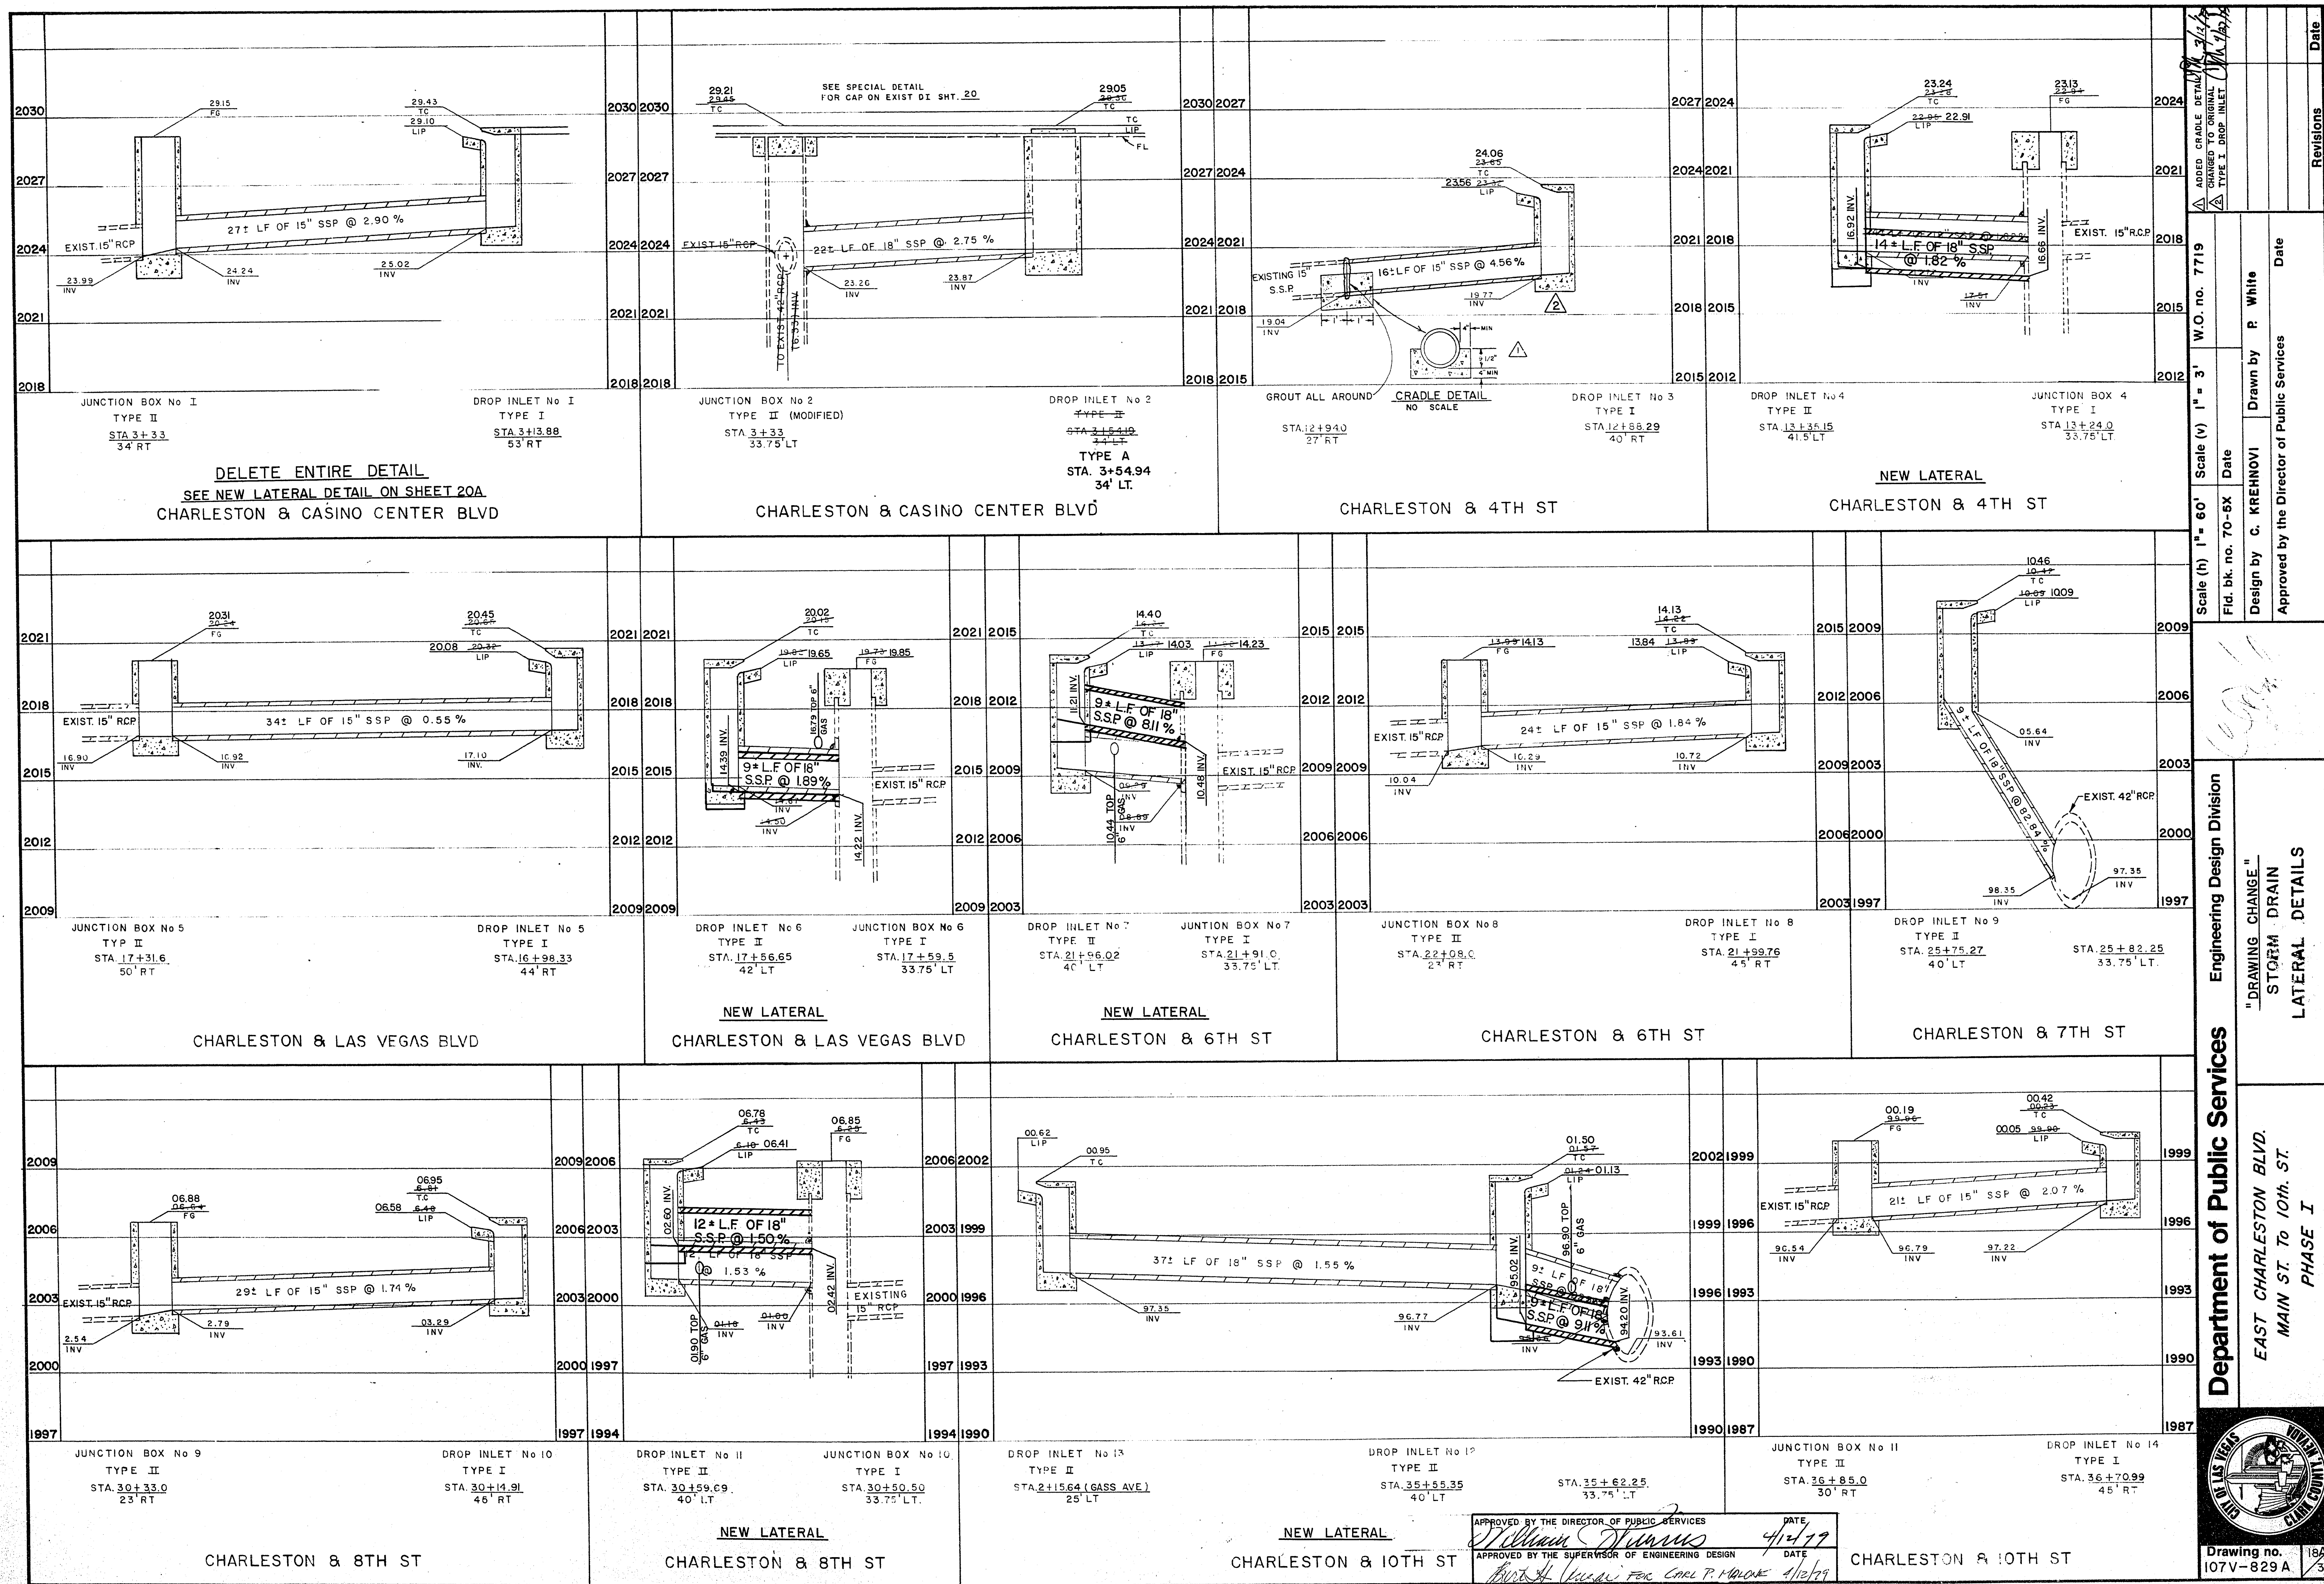

Revisions		Date	
1	ADD CRADLE DETAIL	4/12/19	
2	ADD CRADLE DETAIL	4/12/19	
Scale (h) 1" = 60'	Scale (v) 1" = 3'	W.O. no. 7719	Date

Design by C. KREHNOVI	Drawn by P. White	Date

Approved by the Director of Public Services	Approved by the Director of Engineering Design

Department of Public Services	Engineering Design Division

"DRAWING CHANGE"	STORM DRAIN	LATERAL DETAILS

EAST CHARLESTON BLVD.	MAIN ST. TO 10TH ST.	PHASE I

Drawing no.	184
107V-829A	58

17-4-119