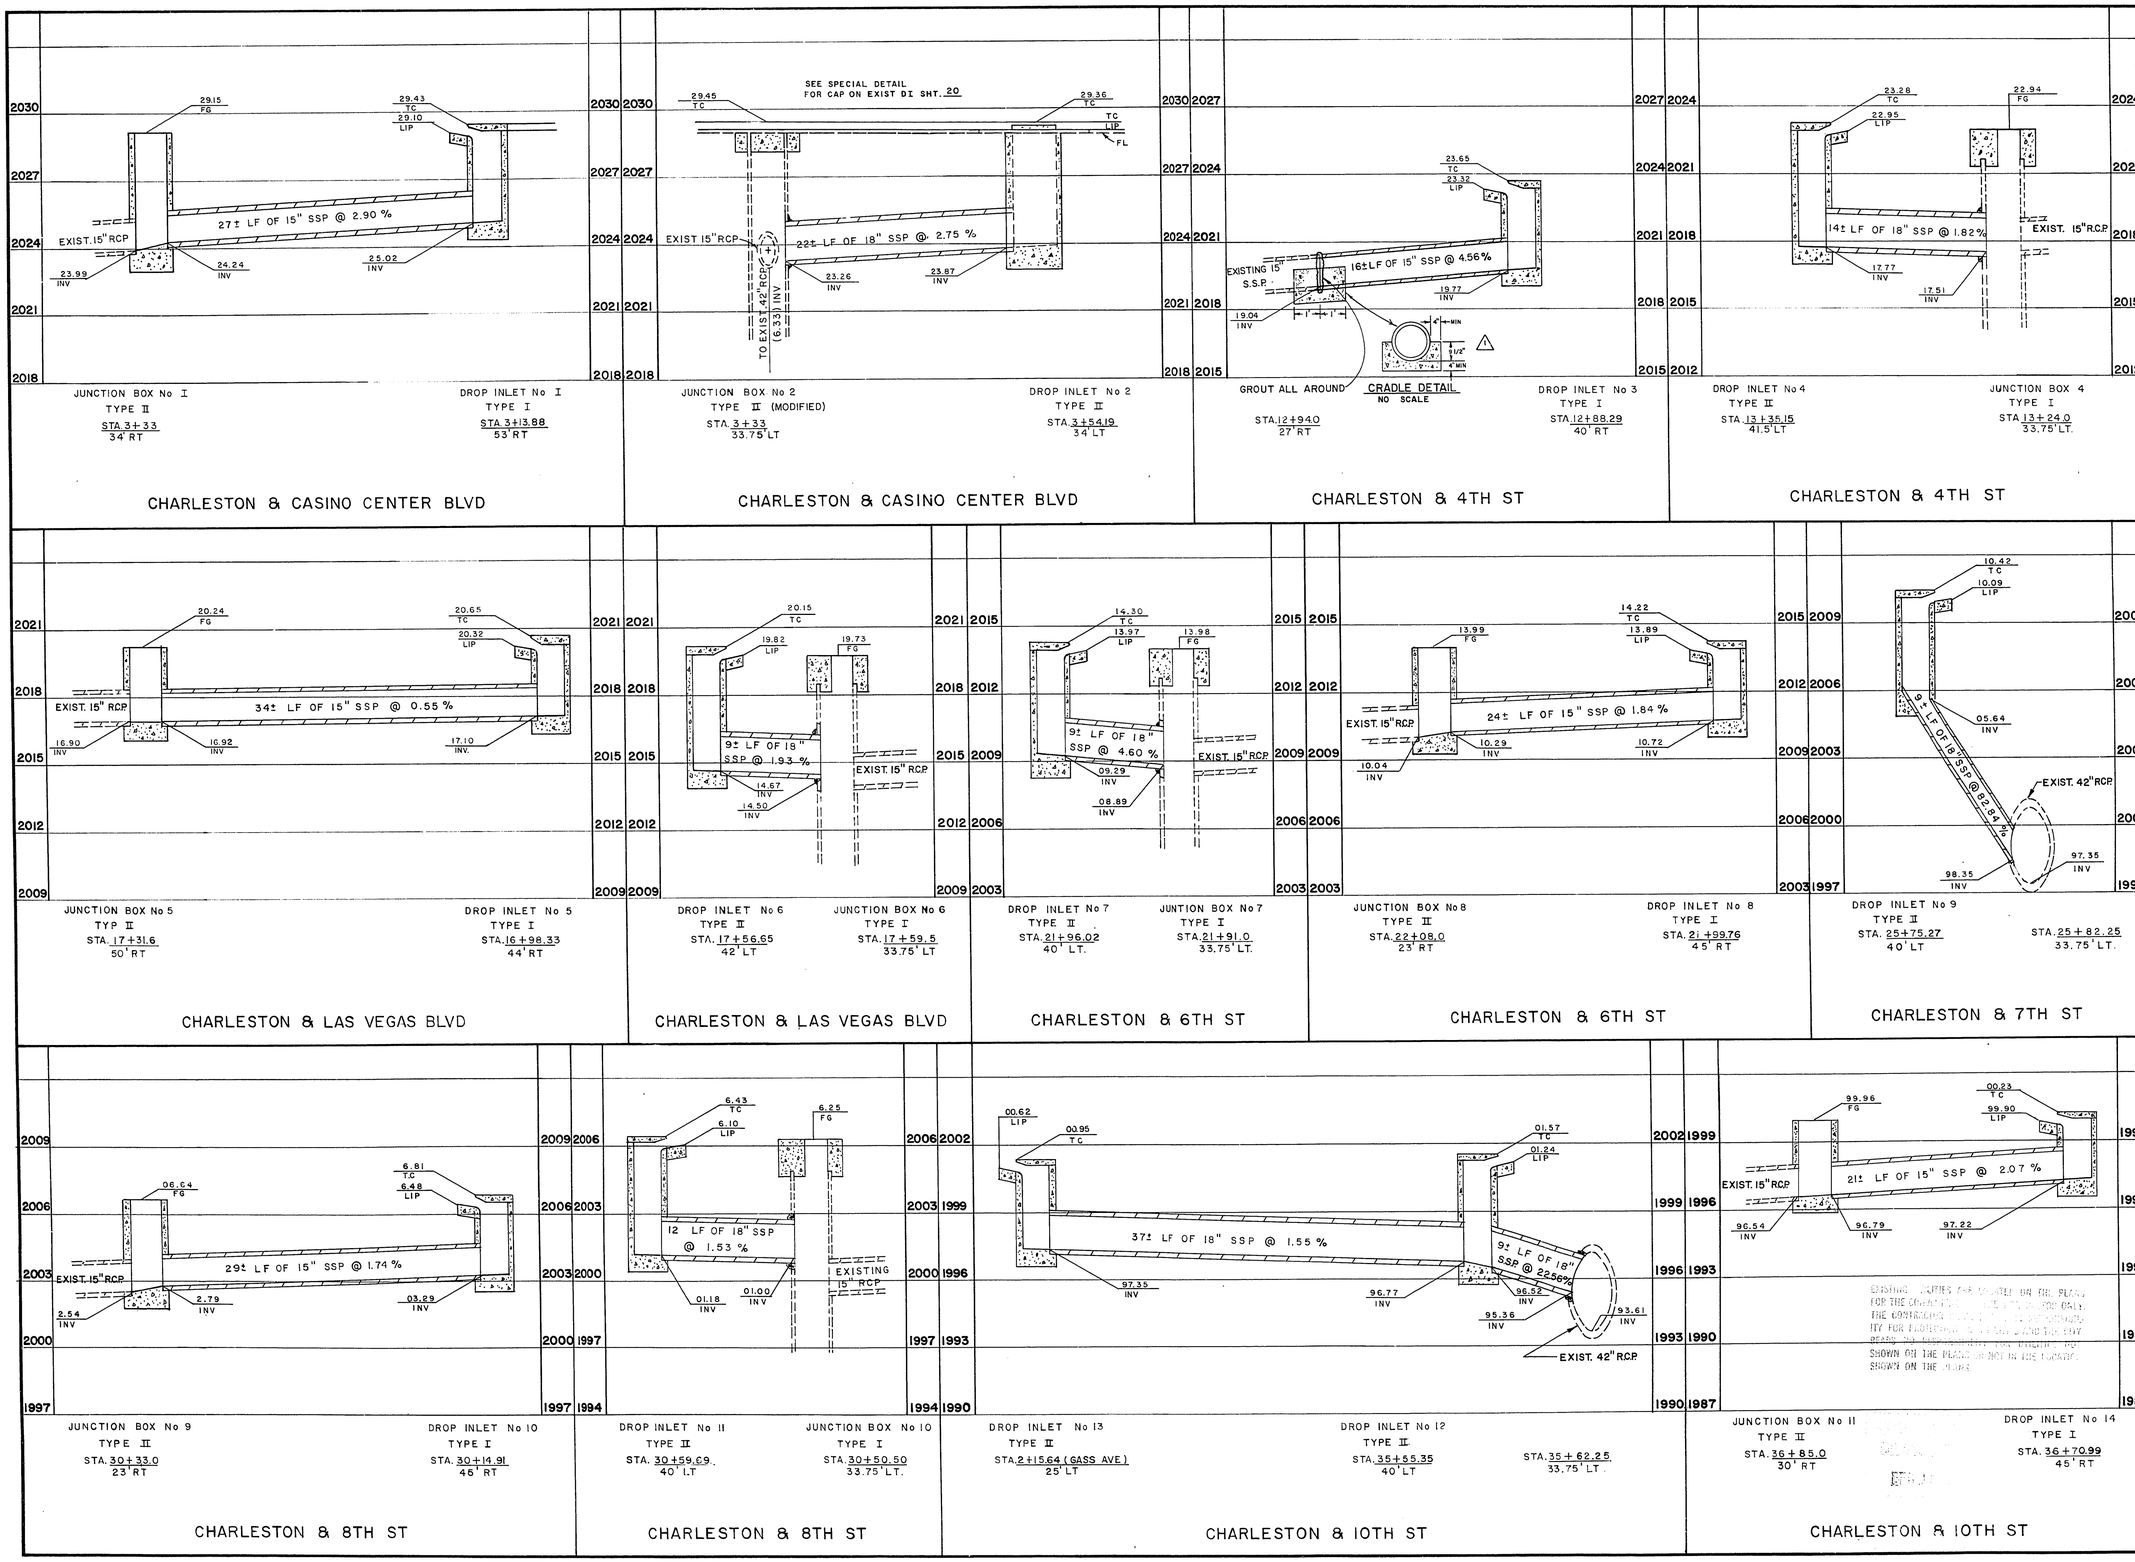

Revisions	Date
ADDED CRADLE DETAIL	3/12/99

Scale (h) 1" = 60' | Scale (v) 1" = 3' | W.O. no. 7719

Fld. bk. no. 70-5X | Date | Drawn by P. White

Design by C. KREHNOVI | Date | Approved by the Director of Public Services

Department of Public Services — Engineering Design Division

STORM DRAIN LATERAL DETAILS

EAST CHARLESTON BLVD.
MAIN ST. To 10th. ST.
PHASE I

CITY OF LAS VEGAS

Drawing no. 107V-829 A | 18/38

17-4-120