




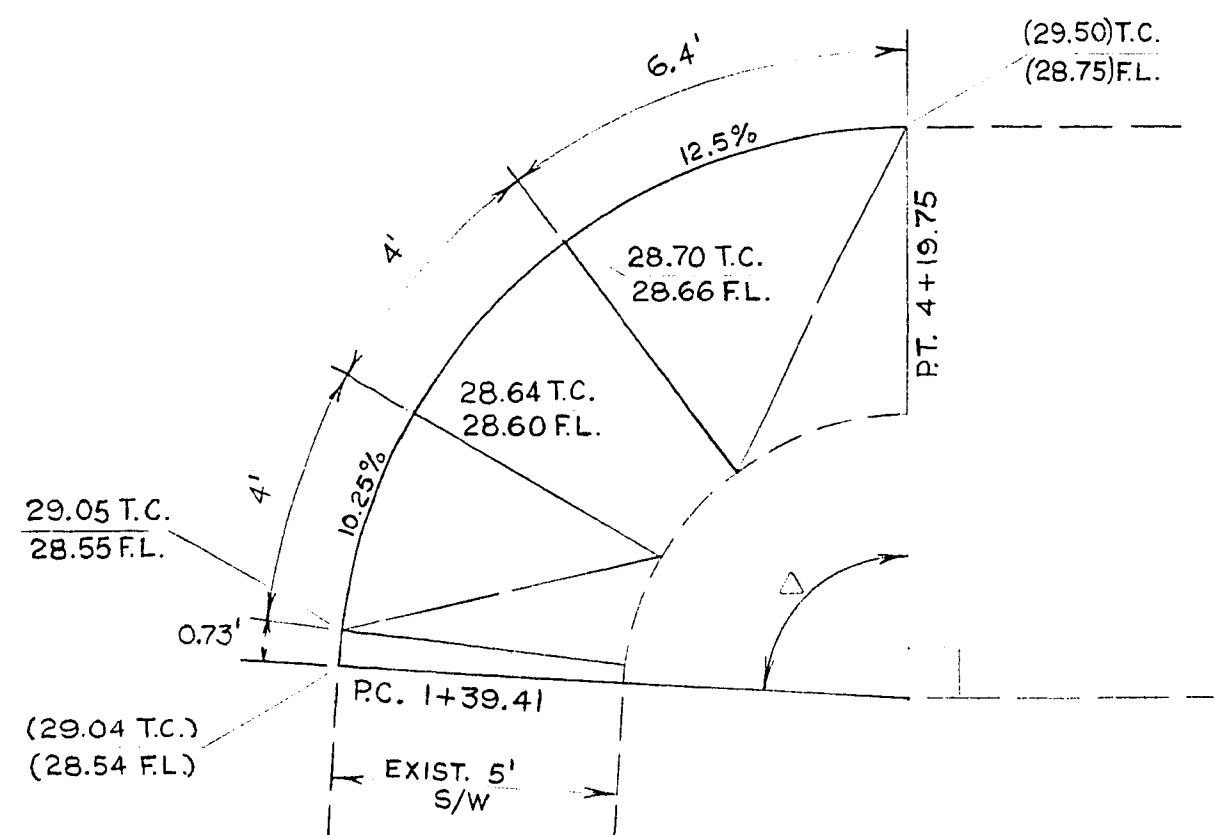


S.E. CORNER CASINO CENTER BLVD.

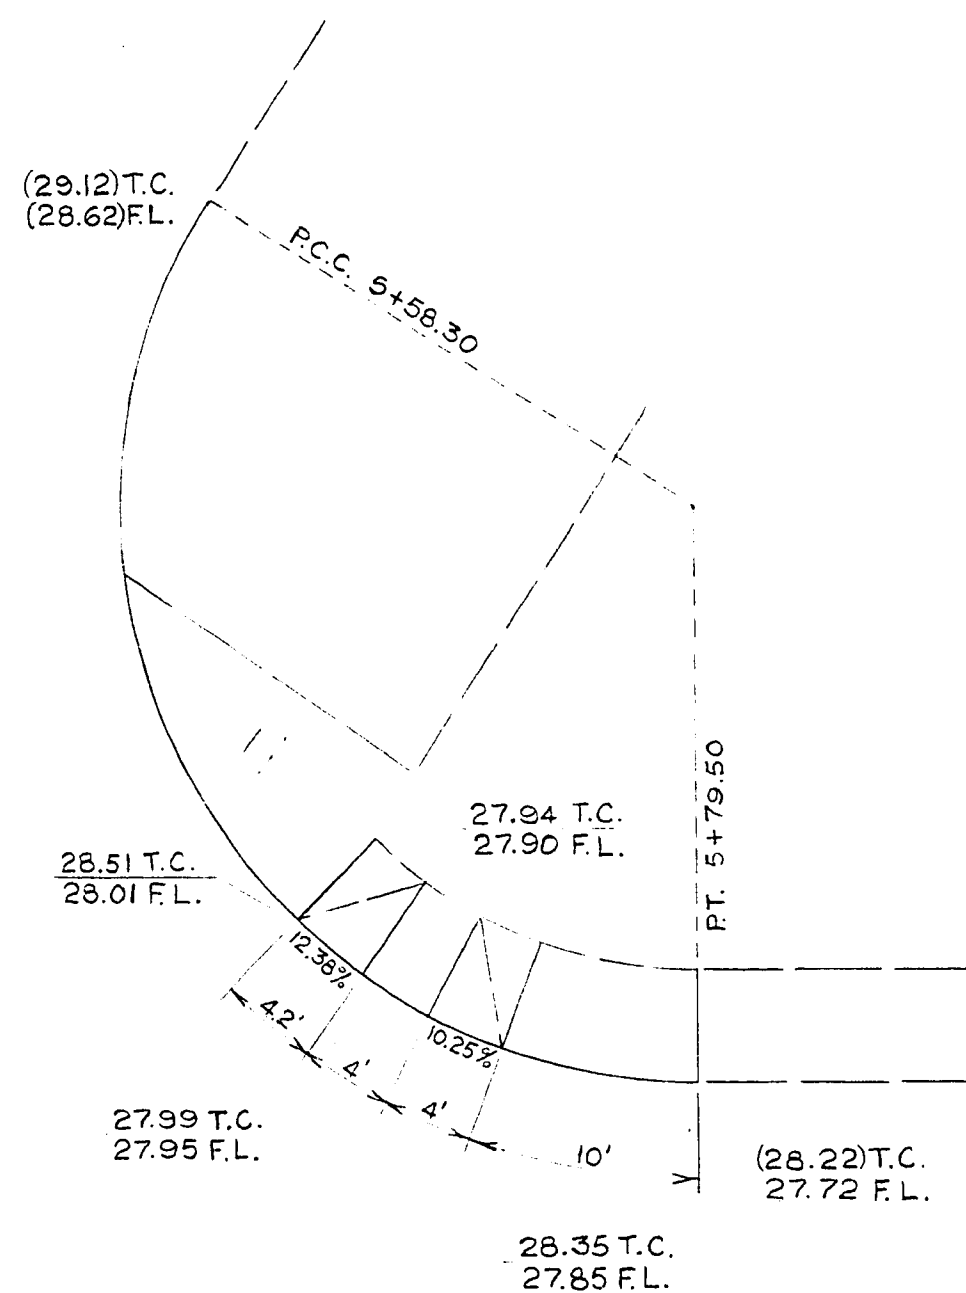


N.E. CORNER CASINO CENTER BLVD.

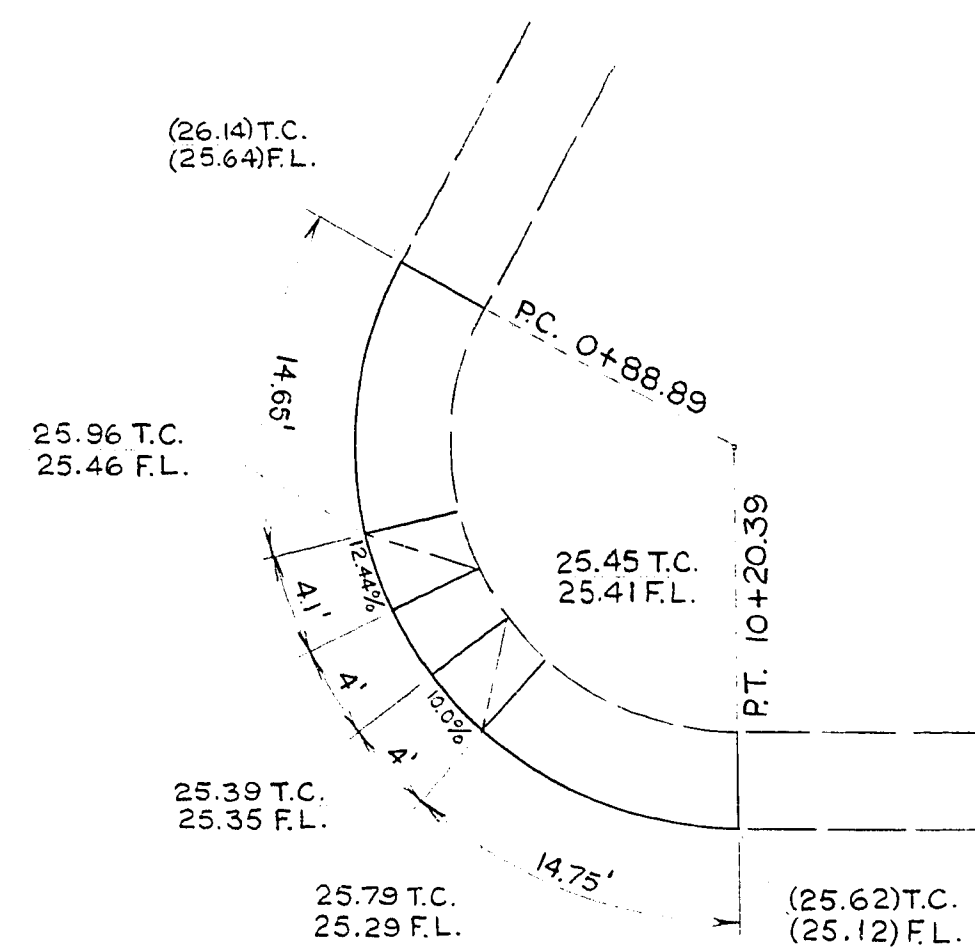


N.E. CORNER 3RD. ST.

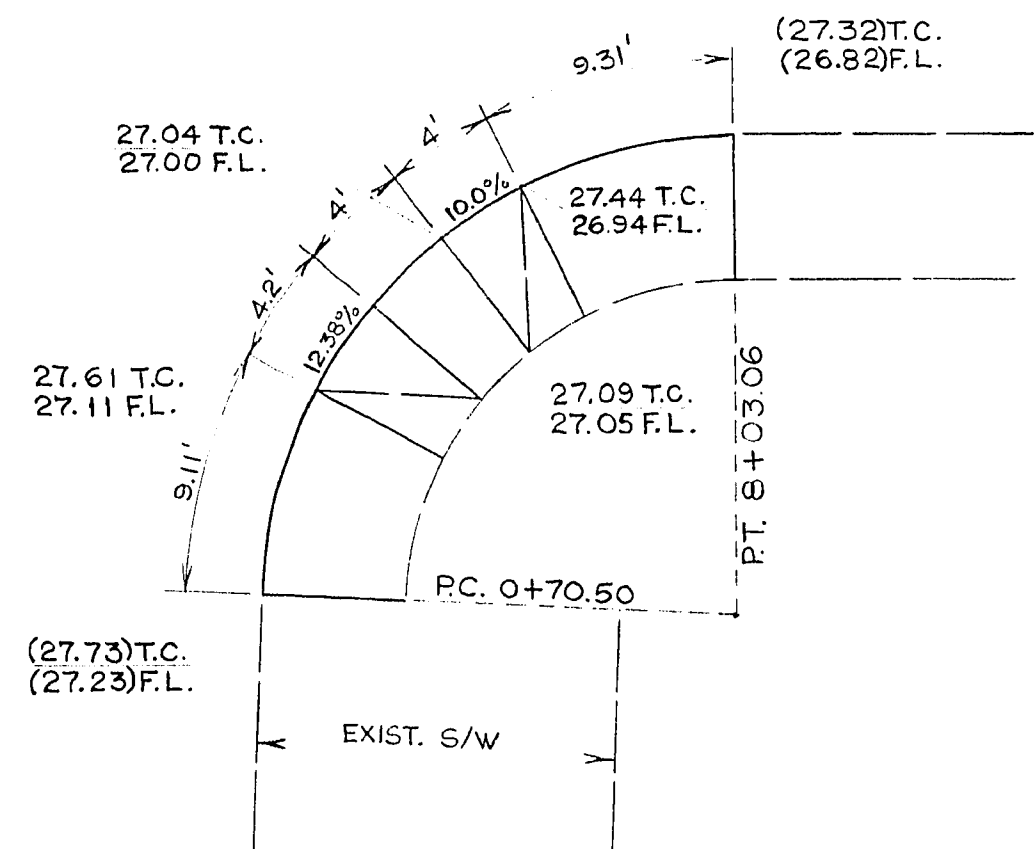


S.E. CORNER 3RD. ST.

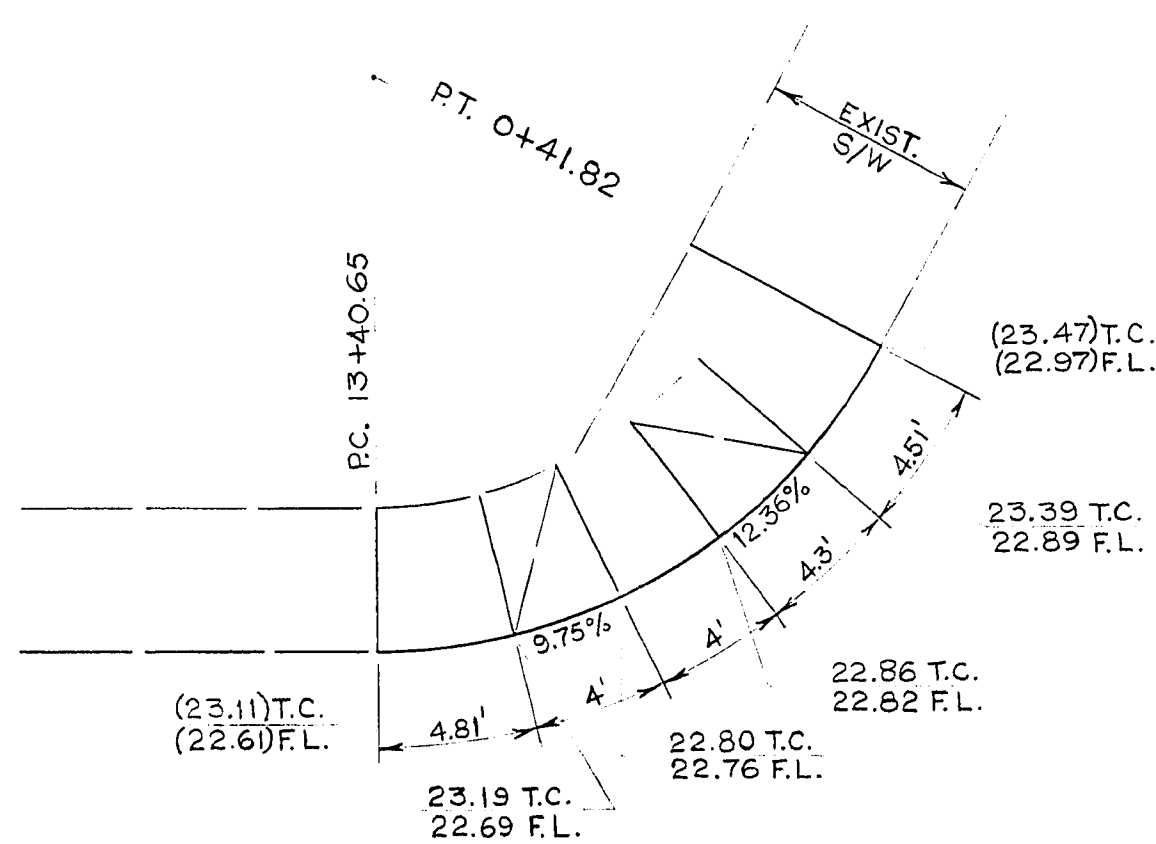


N.W. CORNER 4TH. ST.

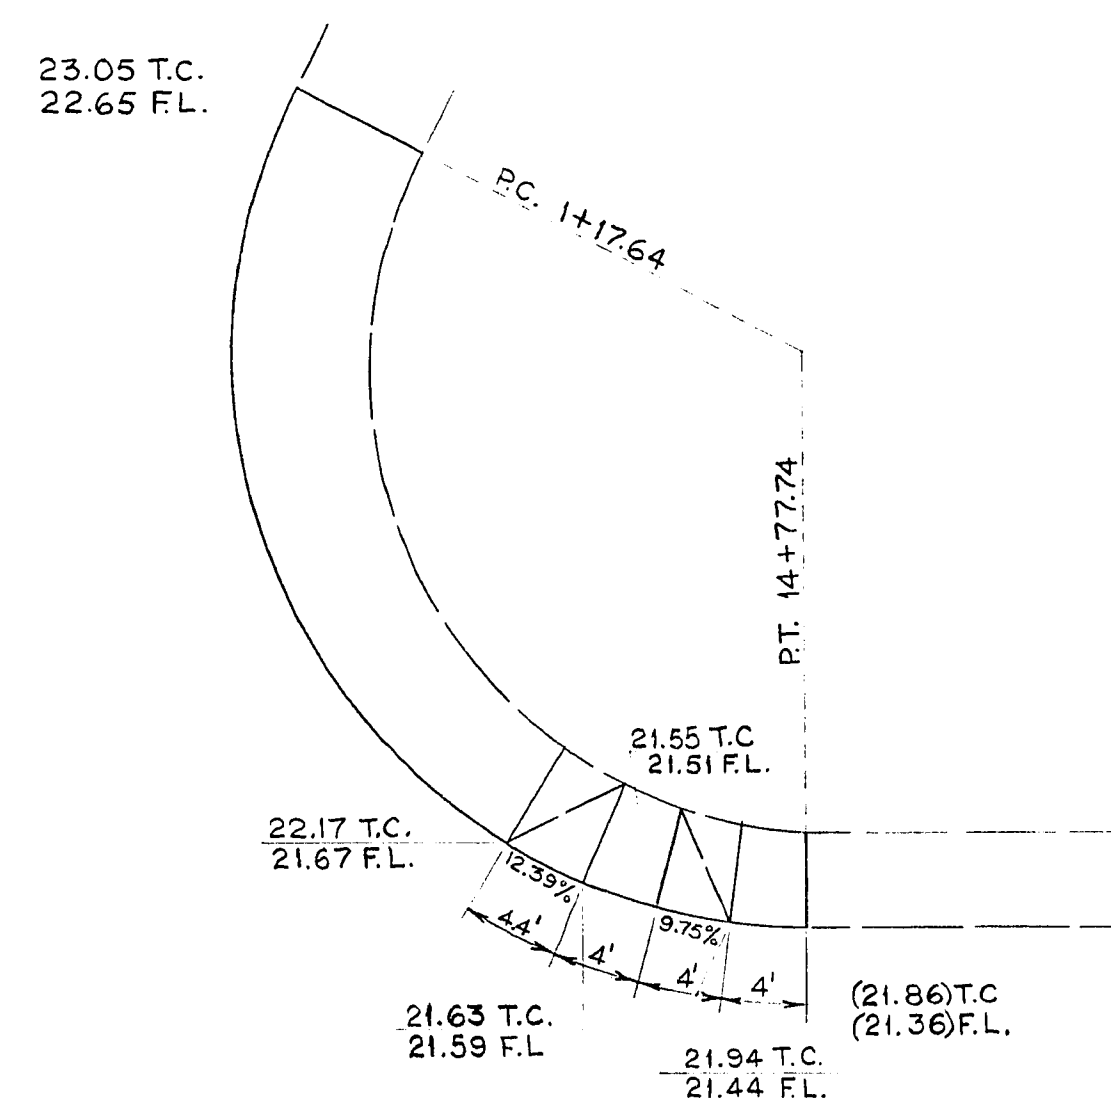


N.E. CORNER 4TH. ST.

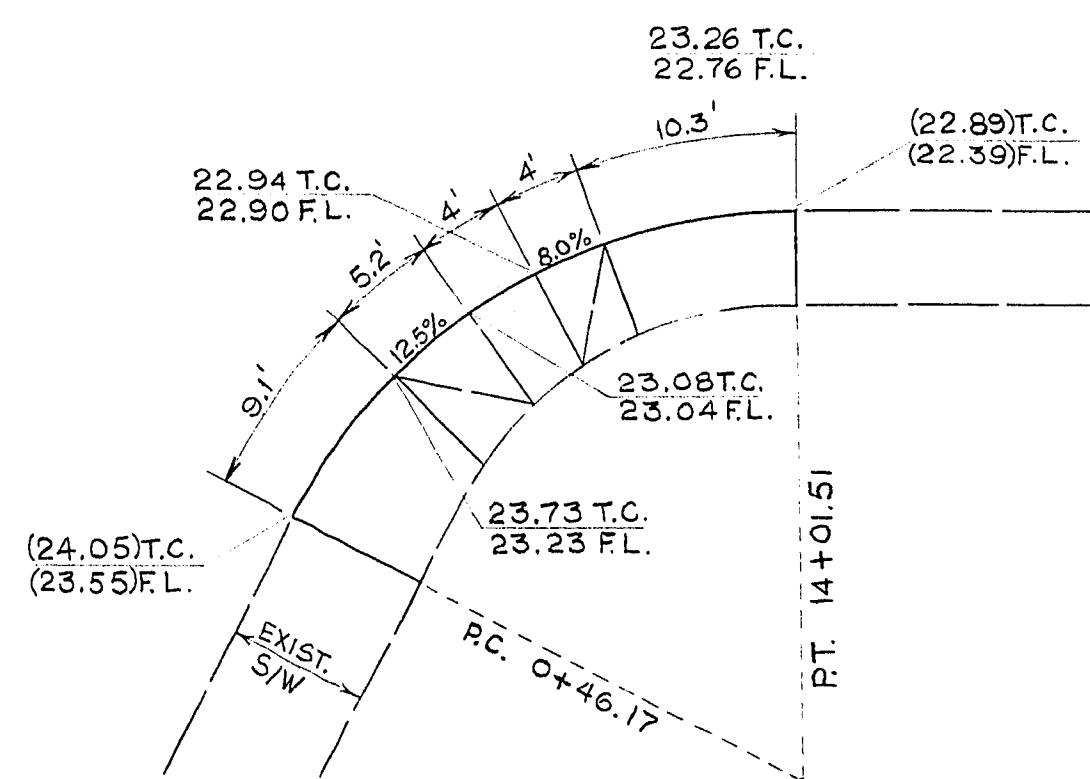

S.E. CORNER 4TH. ST.

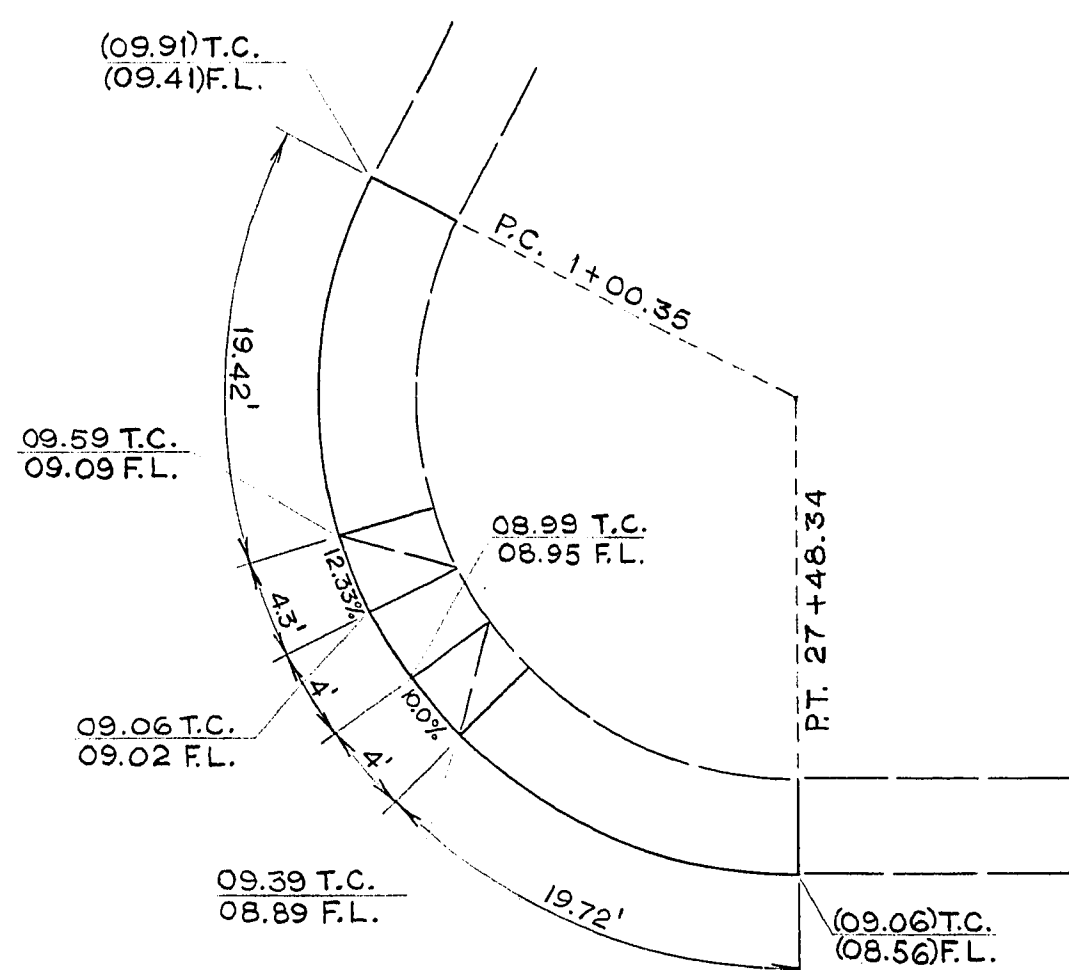


N.E. CORNER 7TH. ST.

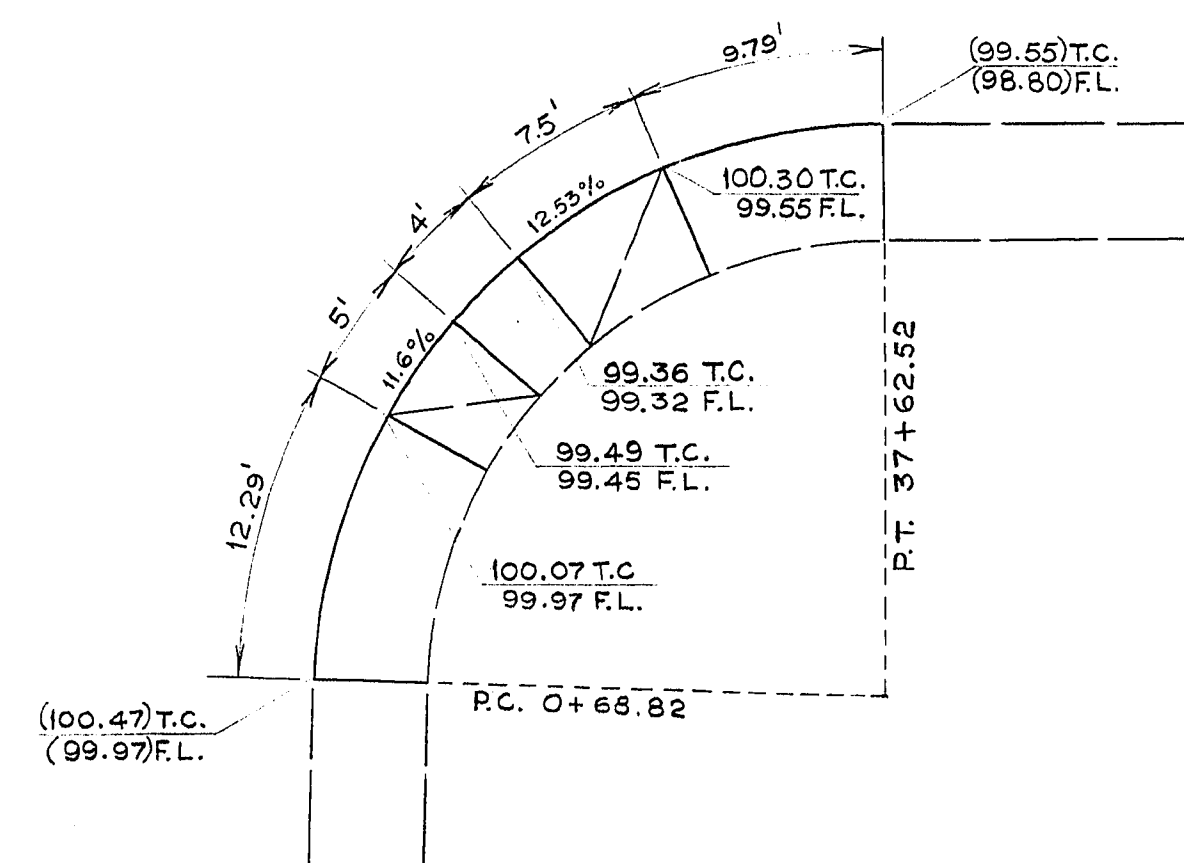

S.E. CORNER 10TH. ST.

APPROVED BY THE DIRECTOR OF PUBLIC SERVICES
 DATE 4/13/79
 APPROVED BY THE SUPERVISOR OF ENGINEERING DESIGN
 DATE 4/13/79

Department of Public Services		Engineering Design Division	
EAST CHARLESTON BLVD. MAIN ST. TO 10TH. ST. PHASE I		"DRAWING CHANGE" ADDITIONAL WHEEL-CHAIR RAMPS DETAIL	
Scale (h) NO SCALE	Scale (v) N/A	W.O. no. 7719	Date
Fid. bk. no. 70-5X	Date	Drawn by S.S. NORATH	Date
Design by C. KREHNOVI		Approved by the Director of Public Services	
Signature: [Signature]		Date: 4/13/79	
Revisions		Date	

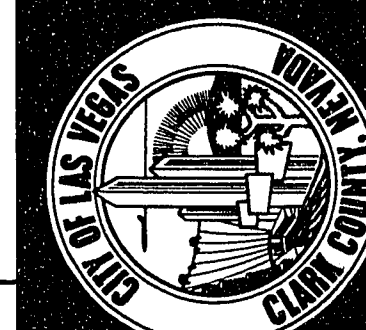

Drawing no. 107V-829A

17-4.124