



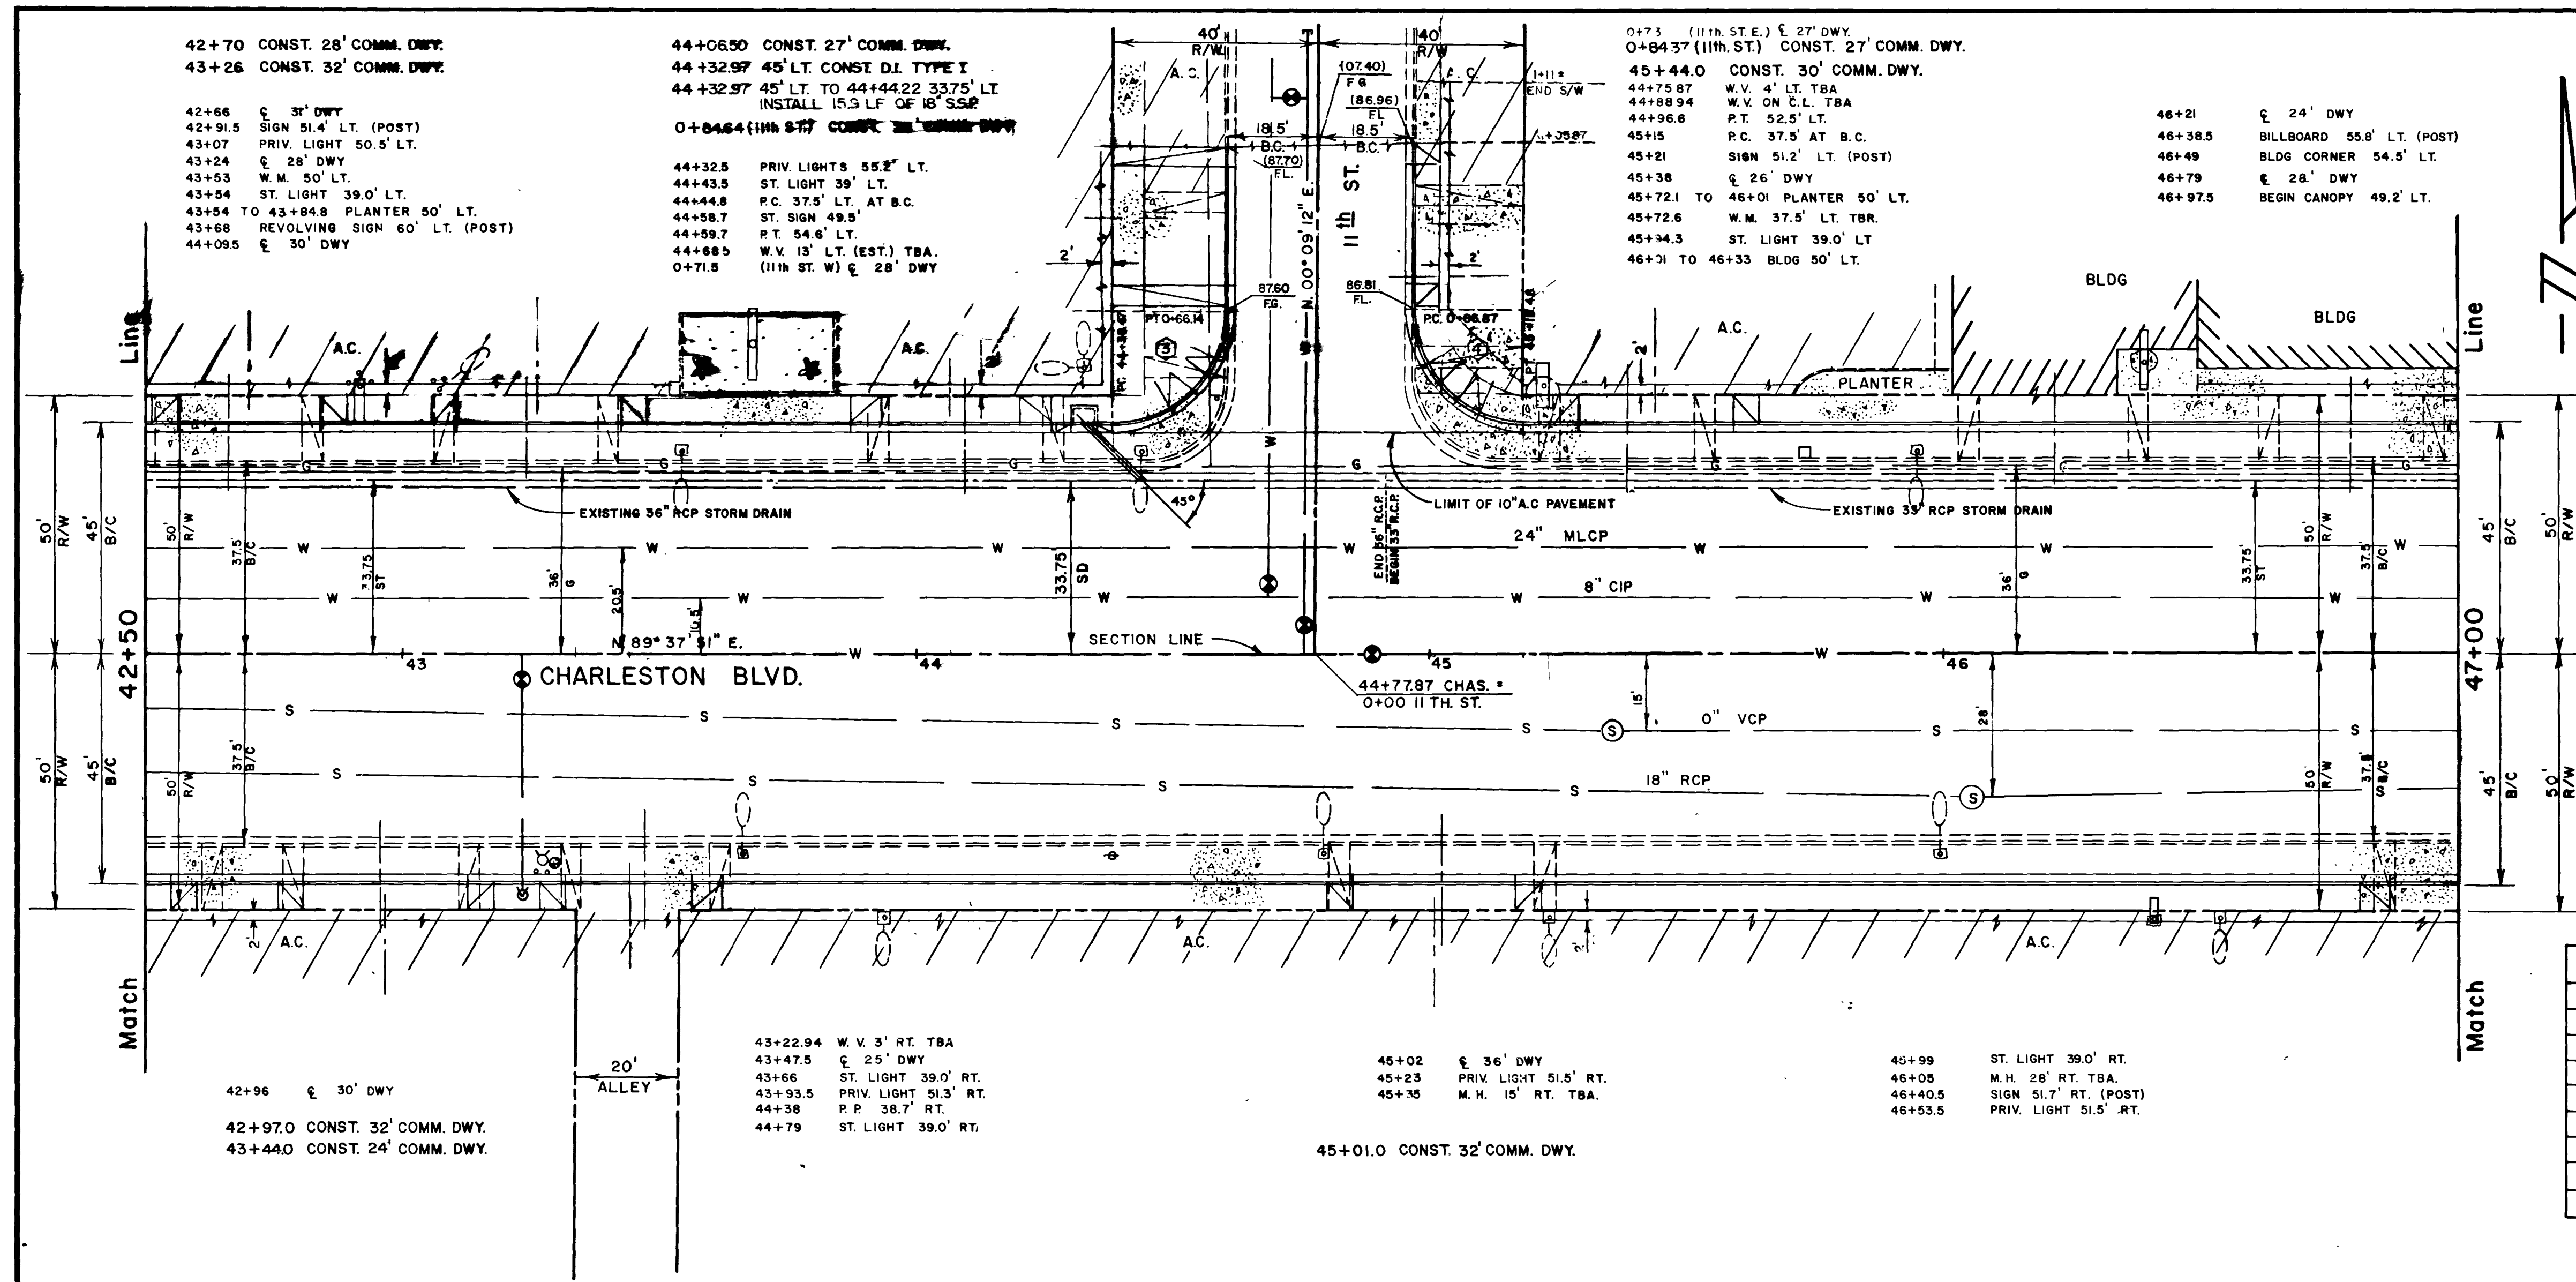


CURVE DATA					
NO.	LOC.	RAD.	DELTA	TAN.	LENGTH
3	B/C	21.50'	89°28'39"	21.30'	33.58'
4	B/C	21.50'	90°31'21"	21.70'	33.97'

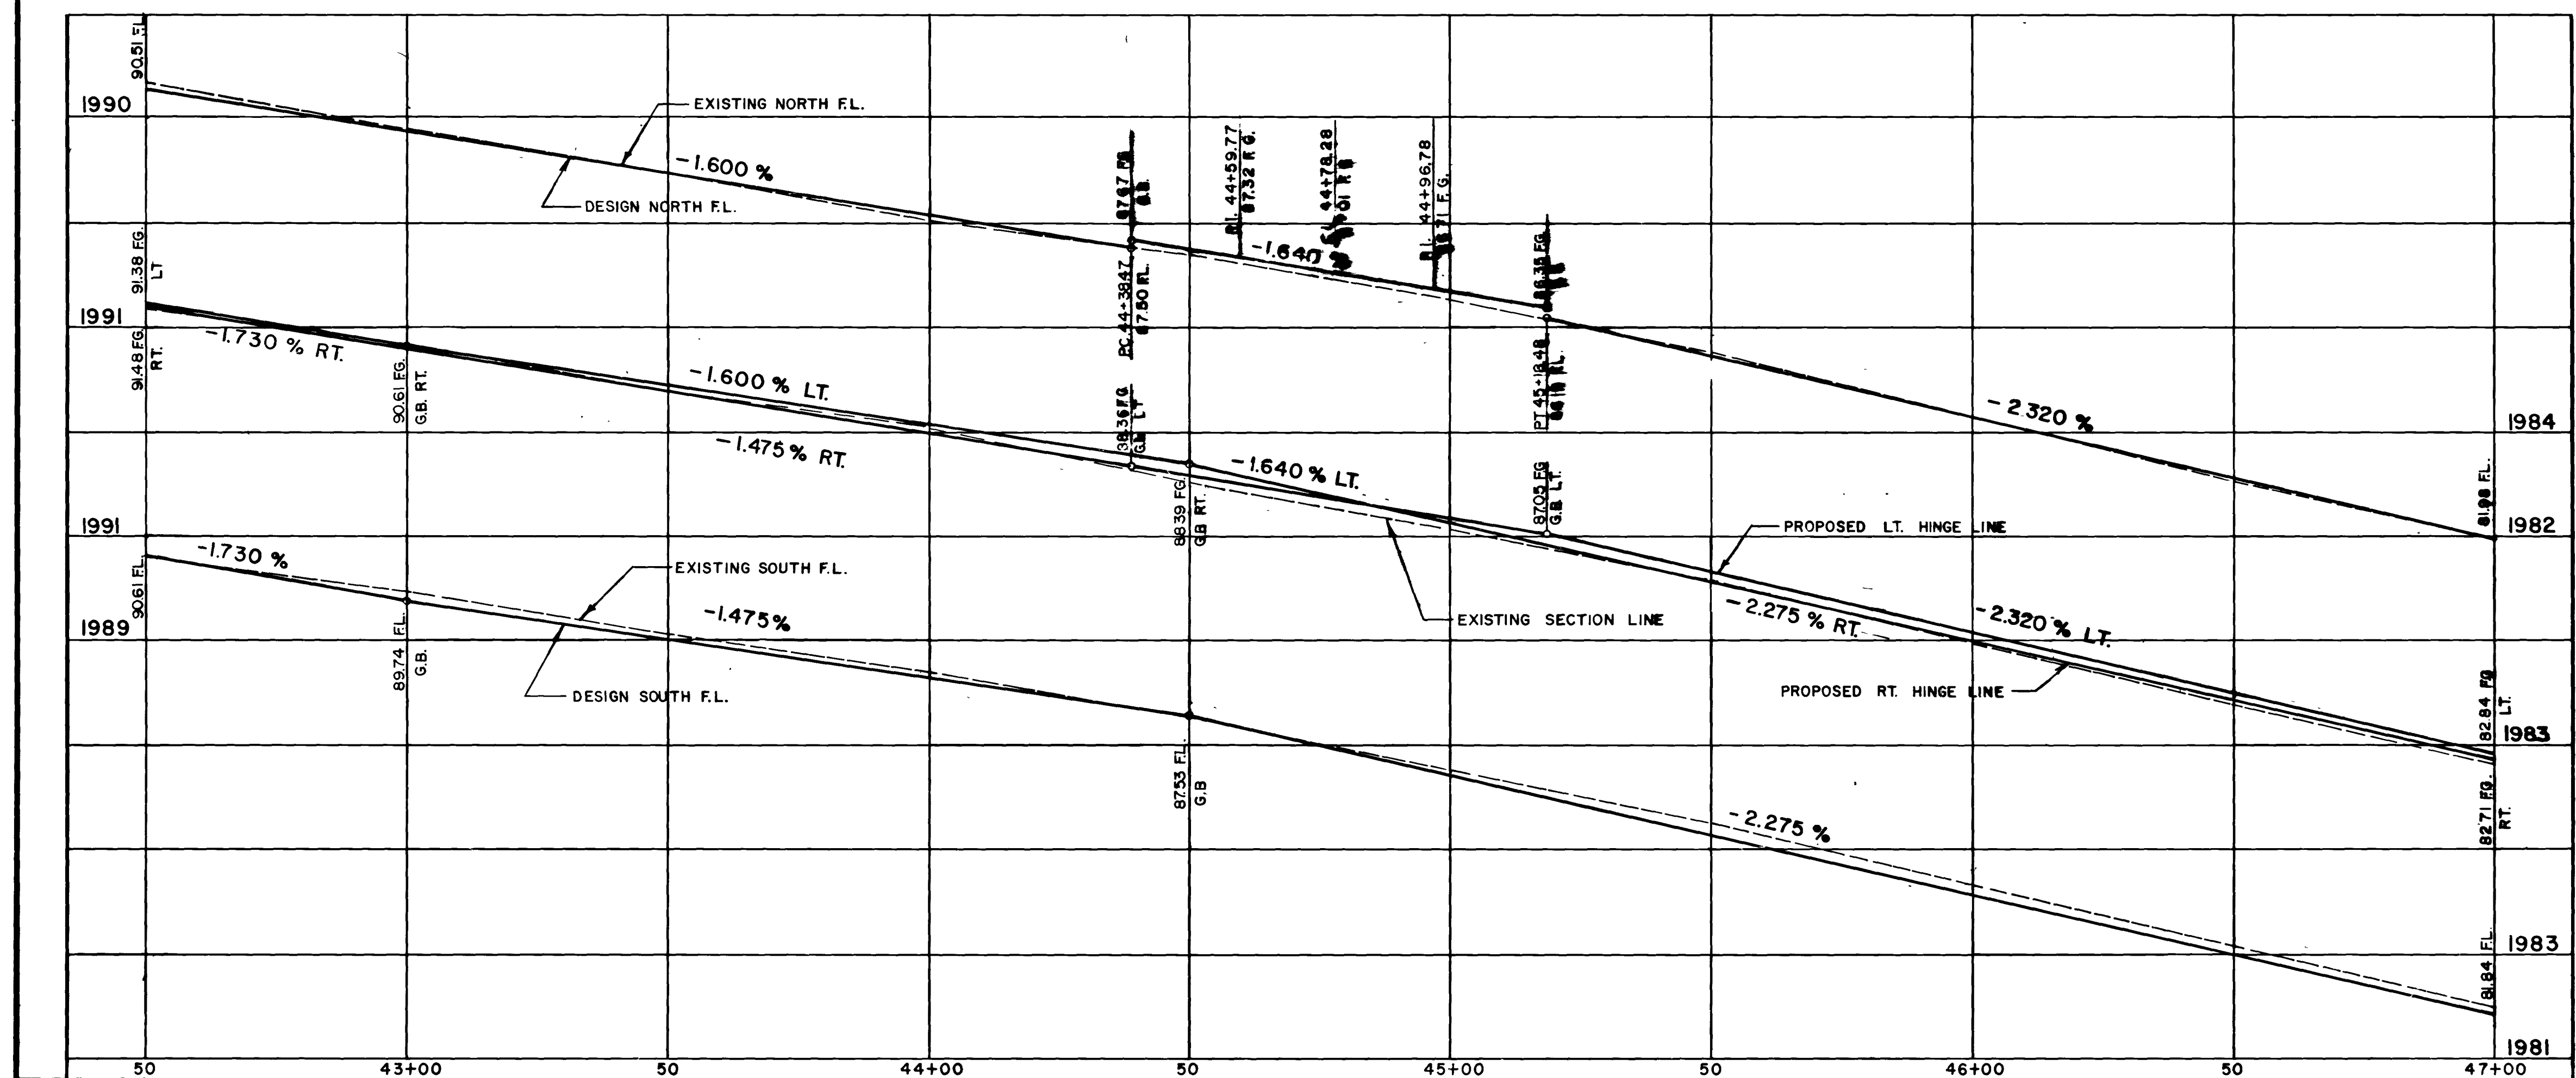

EXISTING UTILITIES ARE LOCATED ON THE PLANS FOR THE CONVEYANCE OF THE PROJECT. THE CONTRACTOR SHALL BE RESPONSIBLE FOR THE LOCATION OF UTILITIES NOT SHOWN ON THE PLANS OR NOT IN THE LOCATION SHOWN ON THE PLANS.

Scale (h) 1" = 20'		Scale (v) 1" = 2'		W.A. no. 0327	
Fid. bk. no. 70-5XA		Date FEB 23 1990		Drawn by S. NORATH	
Design by C. KREHNOVI		Approved by the Director of Public Services		Date 2-25-90	
Department of Public Services Engineering Design Division PLAN AND PROFILE PHASE II					
Contract Drawing 107V-829B 6					

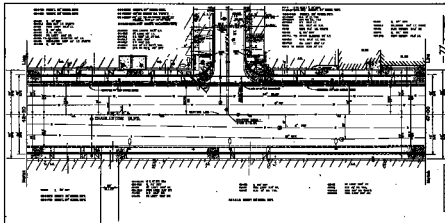

GRADE DATA

STATION	SPC	RA	SPC	RA	SPC	RA
1+00						
1+20						
1+40						
