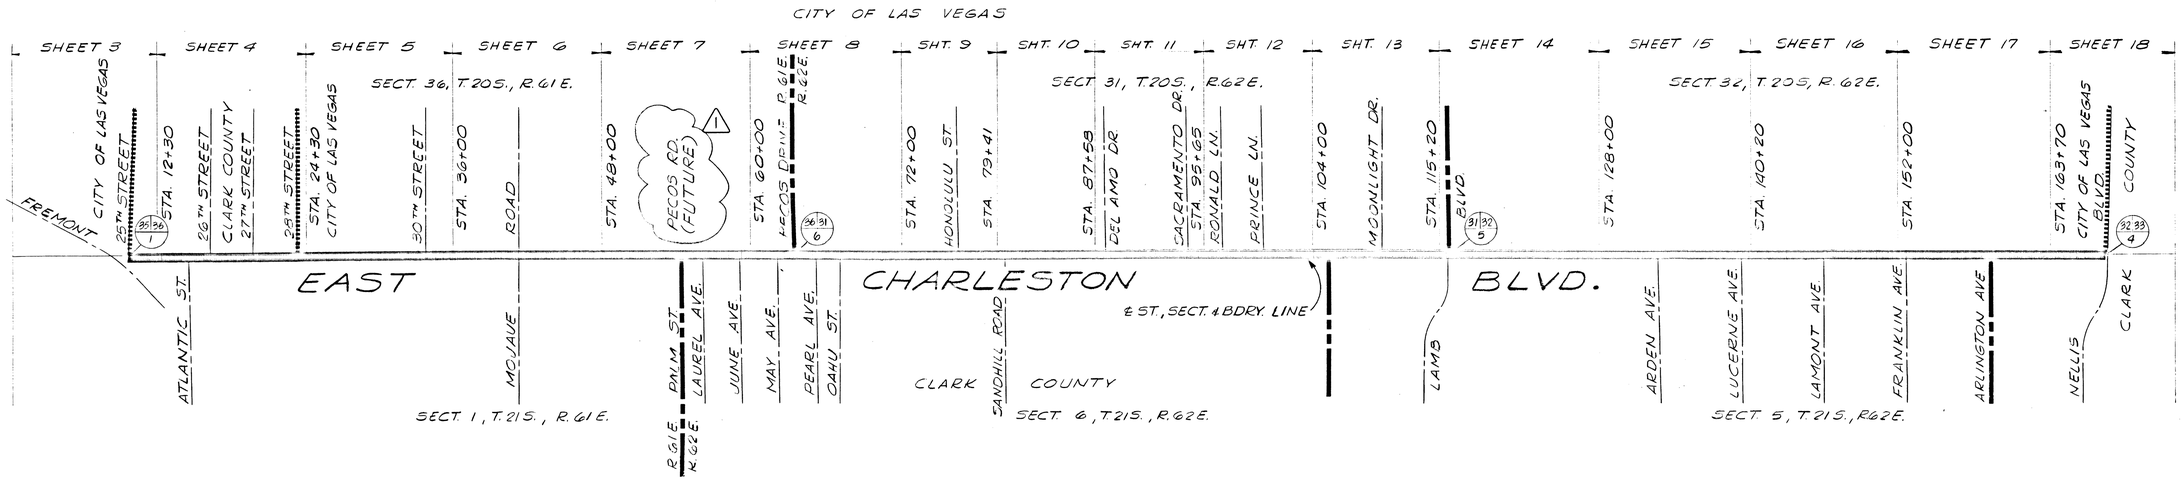

KEY MAP

600 0 600 1200
GRAPHIC SCALE

LEGEND

—S—	EXISTING SANITARY SEWER
—O—	EXISTING MANHOLE
—W—	EXISTING WATER LINE
—G—	EXISTING GAS LINE
—SD—	EXISTING STORM DRAIN
—T—	BURIED TELEPHONE CONDUIT
—P—	BURIED POWER CONDUIT
—⋈—	VALVE
	PROPERTY LINE
	EXISTING CURB, GUTTER & SIDEWALK
	EXISTING EDGE OF A.C. PAVEMENT
	EXISTING DRIVEWAY
—x—x—	EXISTING FENCE
	EXISTING CONC. BLK. WALL
	EXISTING POWER &/OR TELE. POLE
	EXISTING POLE W/DOWN GUY & ANCHOR
	EXISTING FIRE HYDRANT
	EXISTING STREET LIGHT
	EXISTING TRAFFIC SIGNAL LIGHT
	EXISTING ADVERTISING SIGN
	EXISTING STREET SIGN
T.C.	TOP OF CURB
F.G.	FINISH GRADE
E.P.	EDGE OF PAVEMENT
EX.	EXISTING
C&G	CURB & GUTTER
SW.	SIDEWALK
B.C.	BACK OF CURB
DR.	DRIVEWAY
T.D.	TRAFFIC DETECTOR
B.B.	BILLBOARD
	CONC. BLK. WALL W/PILASTERS
	BOUNDARY LINE (THIS SHEET ONLY)
x 1740.2	SPOT ELEVATION (EXISTING)
1800	CONTOUR LINE (EXISTING)
(I)	CURVE DATA REFERENCE NUMBER
8"	EXISTING TREE, UNLESS NOTED, & DIAMETER
	EXISTING STRUCTURE
31/32 5	SECTION CORNER
1/4 32	1/4 SECTION CORNER
1/16 32	1/16 SECTION CORNER
	BENCH MARK
DB-1	DRILL BORING NUMBER & LOCATION
C.C.S.D.	CLARK COUNTY SANITATION DISTRICT
(B) OR (2)	CONSTRUCTION NOTES
	NEW CONCRETE SIDEWALK
C.B.	CATCH BASIN

LIST OF DRAWINGS

- COVER SHEET
1. LIST OF DRAWINGS, LEGEND, KEY MAP, AND VICINITY MAP
2. GENERAL AND CONSTRUCTION NOTES
3. PLAN AND PROFILE 8+95 TO 12+30
4. PLAN AND PROFILE 12+30 TO 24+30
5. PLAN AND PROFILE 24+30 TO 36+00
6. PLAN AND PROFILE 36+00 TO 48+00
7. PLAN AND PROFILE 48+00 TO 60+00
8. PLAN AND PROFILE 60+00 TO 72+00
9. PLAN AND PROFILE 72+00 TO 79+41
10. PLAN AND PROFILE 79+41 TO 87+58
11. PLAN AND PROFILE 87+58 TO 95+65
12. PLAN AND PROFILE 95+65 TO 104+00
13. PLAN AND PROFILE 104+00 TO 115+20
14. PLAN AND PROFILE 115+20 TO 128+00
15. PLAN AND PROFILE 128+00 TO 140+20
16. PLAN AND PROFILE 140+20 TO 152+00
17. PLAN AND PROFILE 152+00 TO 163+70
18. PLAN AND PROFILE 163+70 TO 174+00
19. STREET INTERSECTIONS, 25TH STREET & MOJAVE ROAD
20. STREET INTERSECTION, LAMB BOULEVARD
21. STREET INTERSECTION, NELLIS BOULEVARD
22. STREET SECTIONS KEY MAP
23. TYPICAL STREET SECTIONS I
24. TYPICAL STREET SECTIONS II
25. TYPICAL DETAILS I
26. TYPICAL DETAILS II
27. LOGS OF BORINGS
28. STORM DRAIN PLAN AND PROFILE 10+00 TO 24+30 AND DETAILS
29. STORM DRAIN PLAN AND PROFILE 24+30 TO 48+00
30. STORM DRAIN PLAN AND PROFILE 48+00 TO 72+00
31. STORM DRAIN PLAN AND PROFILE 72+00 TO 96+00
32. STORM DRAIN PLAN AND PROFILE 96+00 TO 120+00
33. STORM DRAIN PLAN AND PROFILE 120+00 TO 132+44.09 AND DETAILS
34. STORM DRAIN PLAN AND PROFILE 132+44.09 TO 145+00 AND DETAILS
35. STORM DRAIN PLAN AND PROFILE 145+00 TO 157+50 AND DETAILS
36. STORM DRAIN PLAN AND PROFILE 157+50 TO 169+57, AND DETAILS
37. STORM DRAIN DETAILS I
38. STORM DRAIN CONNECTOR PIPE DETAILS I
39. STORM DRAIN CONNECTOR PIPE DETAILS II
40. STREET AND MEDIAN LIGHTING PLAN 8+95 TO 36+30
41. STREET AND MEDIAN LIGHTING PLAN 36+30 TO 72+30
42. STREET AND MEDIAN LIGHTING PLAN 72+30 TO 108+40
43. STREET AND MEDIAN LIGHTING PLAN 108+40 TO 144+20
44. STREET AND MEDIAN LIGHTING PLAN 144+20 TO 172+30
45. MOJAVE ROAD INTERSECTION TRAFFIC SIGNAL SYSTEM
46. LAMB BOULEVARD INTERSECTION TRAFFIC SIGNAL SYSTEM
47. NELLIS BOULEVARD INTERSECTION TRAFFIC SIGNAL SYSTEM
48. PALM STREET INTERSECTION TRAFFIC SIGNAL SYSTEM
49. SANDHILL ROAD INTERSECTION TRAFFIC SIGNAL SYSTEM
50. ARDEN AVENUE INTERSECTION TRAFFIC SIGNAL SYSTEM
51. TRAFFIC SIGNAL SYSTEM SERVICE POINTS, NOTES AND LEGEND
52. SUMMARY OF QUANTITIES & DRIVEWAY SCHEDULE
53. 25TH STREET INTERSECTION TRAFFIC SIGNAL SYSTEM △1

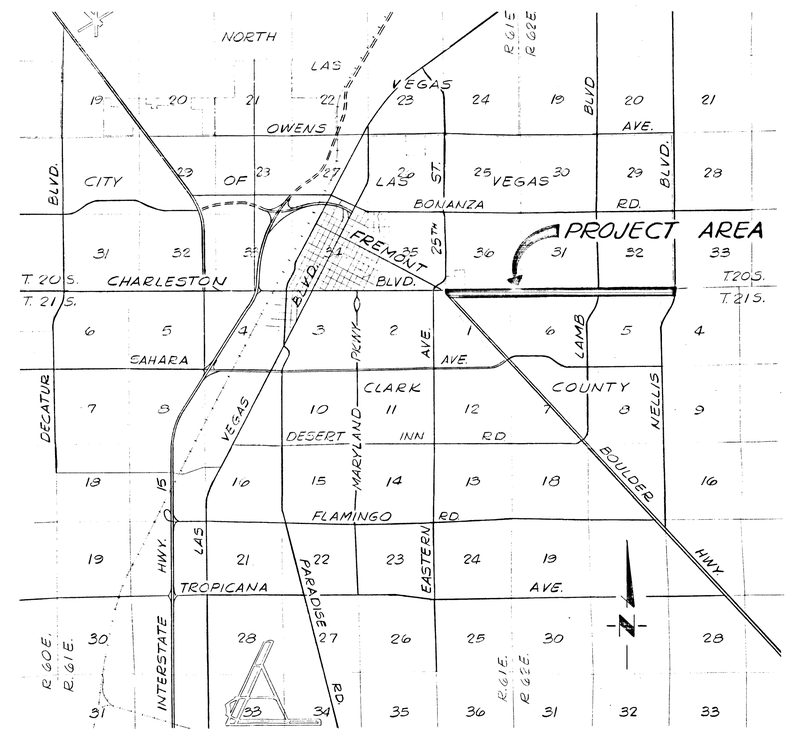

VICINITY MAP

NO SCALE

AS BUILT DRAWING

REV	DATE	DESCRIPTION
1	9-5-73	AS-BUILT

RECOMMENDED G. C. WALLACE R.E. NO. 1815 DATE 5-2-73
MONTGOMERY ENGINEERS OF NEVADA R.E. NO. 12315 DATE 5-2-73

WALLACE - MONTGOMERY, A JOINT VENTURE
G. C. WALLACE, Consulting Engineer 735-5709
MONTGOMERY ENGINEERS OF NEVADA 735-7198
LAS VEGAS, NEVADA

REGIONAL STREET AND HIGHWAY COMMISSION, CLARK CO., NEV.
EAST CHARLESTON BLVD. FROM FREMONT ST. TO NELLIS BLVD.

LIST OF DRAWINGS, LEGEND, KEY MAP, AND VICINITY MAP

SHEET 1 OF 53 SHEETS

22-4-117 107-V943