


	Δ	BCR	T	L
①	88°02'25"	25.00	24.10	38.41
②	92°01'43"	25.00	25.95	40.20

NOTE
FOR 25th ST. INTERSECTION -
SEE SHT. 19

SCALE: HORIZ. 1" = 40'
VERT. 1" = 4'

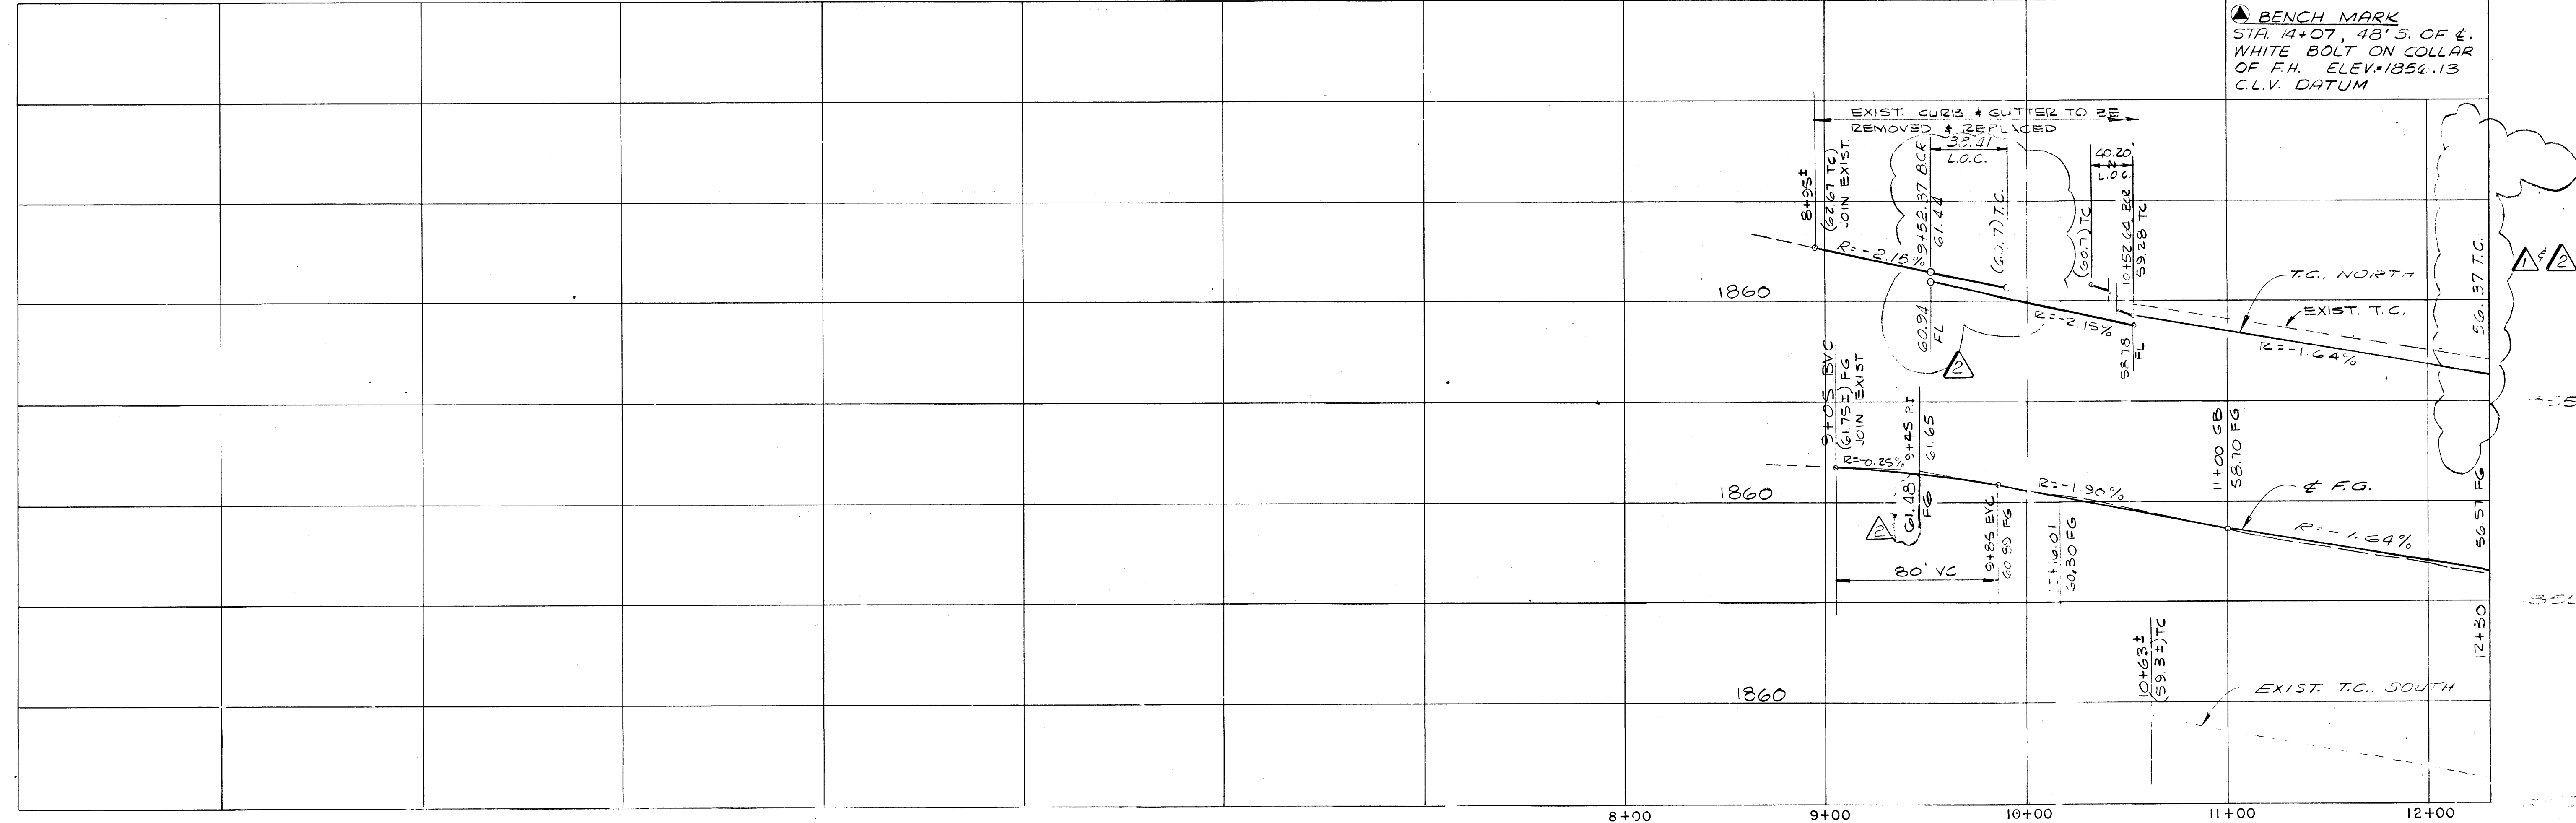

RECOMMENDED G. C. WALLACE MONTGOMERY ENGINEERS OF NEVADA 735-5709 LAS VEGAS, NEVADA	DATE 1/15/13 REV 1/15/13	DESCRIPTION ELIMINATE A.D. #6 IMPROVE W. SIDE CHAS. - 25' TO 20' W. EXTEND MEDIAN WEST 6.25'	DATE 1/15/13 REV 1/15/13	DESCRIPTION ELIMINATE A.D. #6 IMPROVE W. SIDE CHAS. - 25' TO 20' W. EXTEND MEDIAN WEST 6.25'
REGIONAL STREET AND HIGHWAY COMMISSION, CLARK CO., NEV. EAST CHARLESTON BLVD FROM FREMONT ST. TO NELLIS BLVD. PLAN AND PROFILE 8+95 TO 12+30 SHEET 3 OF 5 SHEETS				