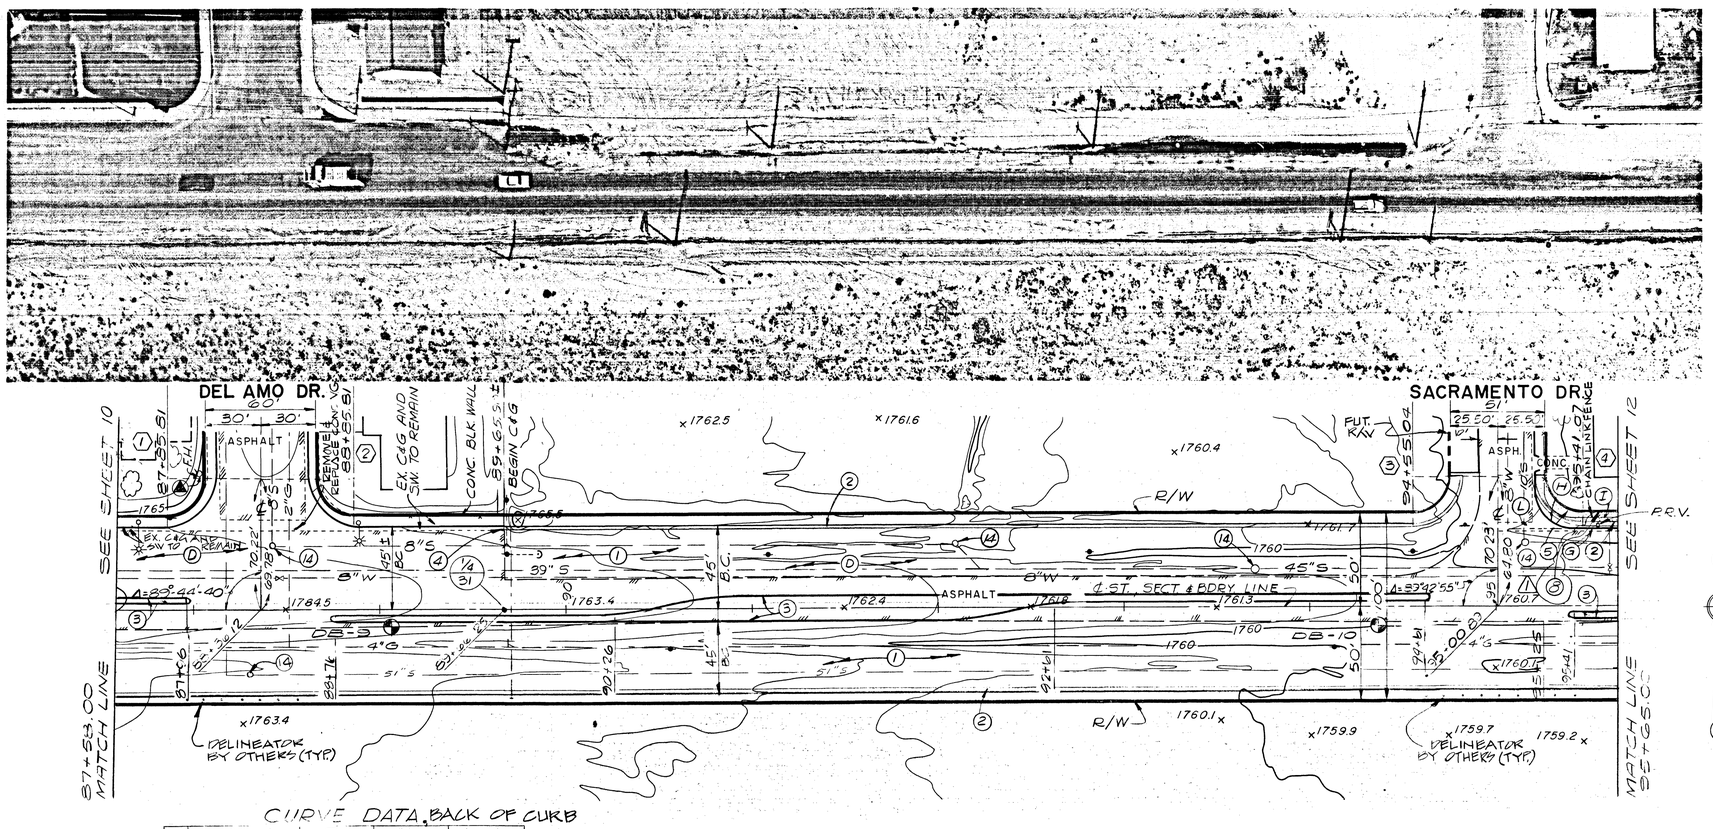

CURVE DATA, BACK OF CURB

	Δ	R.	T.	L.	
1	90°15'20"	25.00'	25.11'	39.38	EXIST
2	89°44'40"	25.00	24.89'	39.16'	EXIST
3	90°17'05"	25.00'	25.12'	39.39'	
4	89°42'55"	20.00	19.90'	31.32'	

SCALE: HORIZ. 1"=40'
VERT. 1"=4'

BENCH MARK
STA. 88+03, 73' N. OF ℄ @ N.W. CURB RETURN OF DEL AMO DR. WHITE BOLT ON COLLAR OF F.H. ELEV. = 1766.64 C.L.V. DATUM

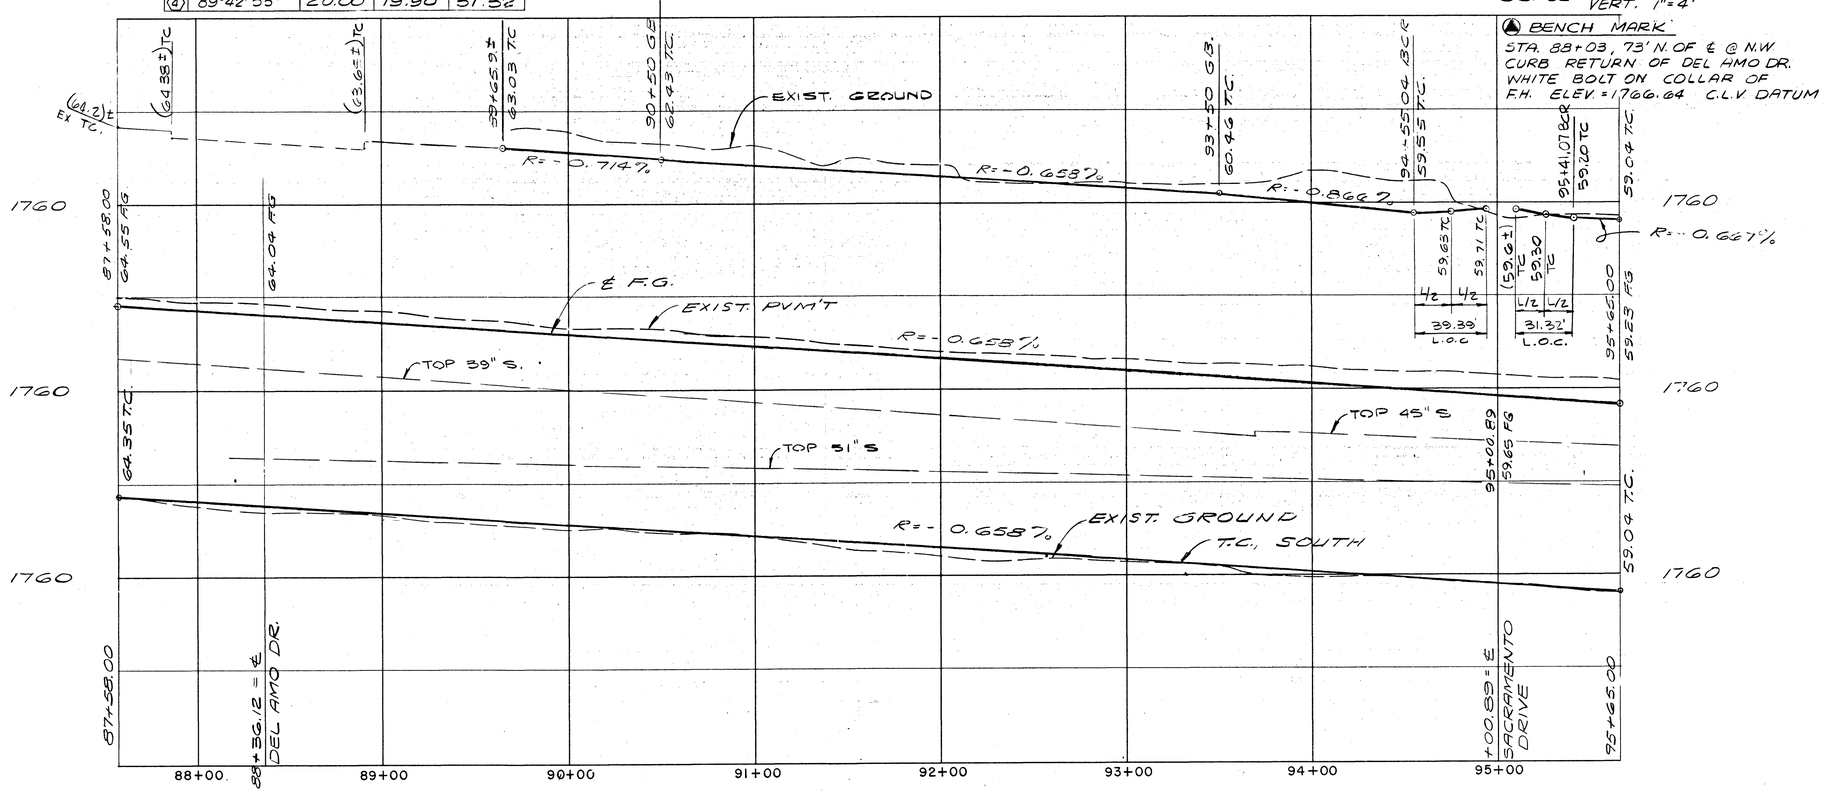

AS BUILT DRAWING

REV	DATE	DESCRIPTION
1	9-5-75	AS-BUILT

RECOMMENDED G. C. WALLACE R.E. NO. 1315 DATE 5/8/72
MONTGOMERY ENGINEERS OF NEVADA R.E. NO. 2315 DATE 5-2-73

WALLACE - MONTGOMERY, A JOINT VENTURE
G. C. WALLACE, Consulting Engineer — MONTGOMERY ENGINEERS OF NEVADA
735-5709 — 735-7198
LAS VEGAS, NEVADA

REGIONAL STREET AND HIGHWAY COMMISSION, CLARK CO., NEV.
EAST CHARLESTON BLVD. FROM FREMONT ST. TO NELLIS BLVD.

PLAN AND PROFILE
87+58 TO 95+65

SHEET 11 OF 53 SHEETS

COMPILED BY
AMERICAN AERIAL SURVEYS, INC.
COVINA, CALIFORNIA

22-4-127 107-V 943