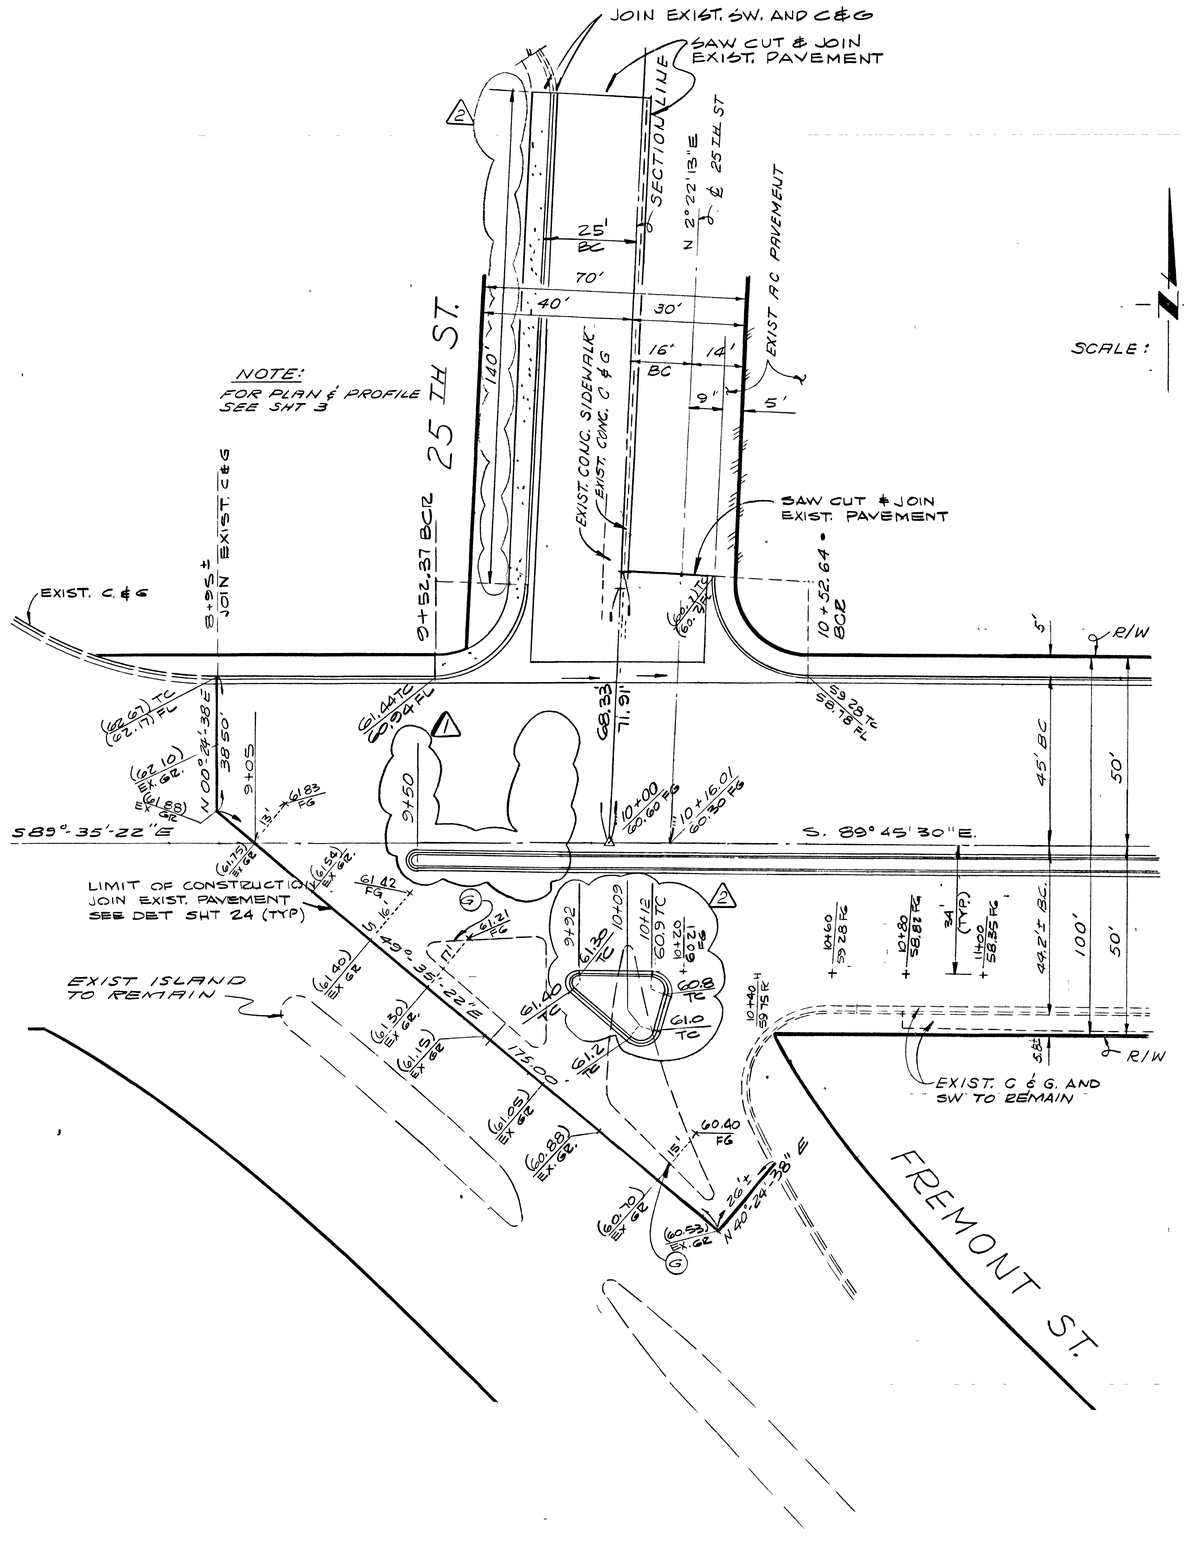

SCALE: 1" = 20'

NOTE: FOR PLAN & PROFILE SEE SHT 6

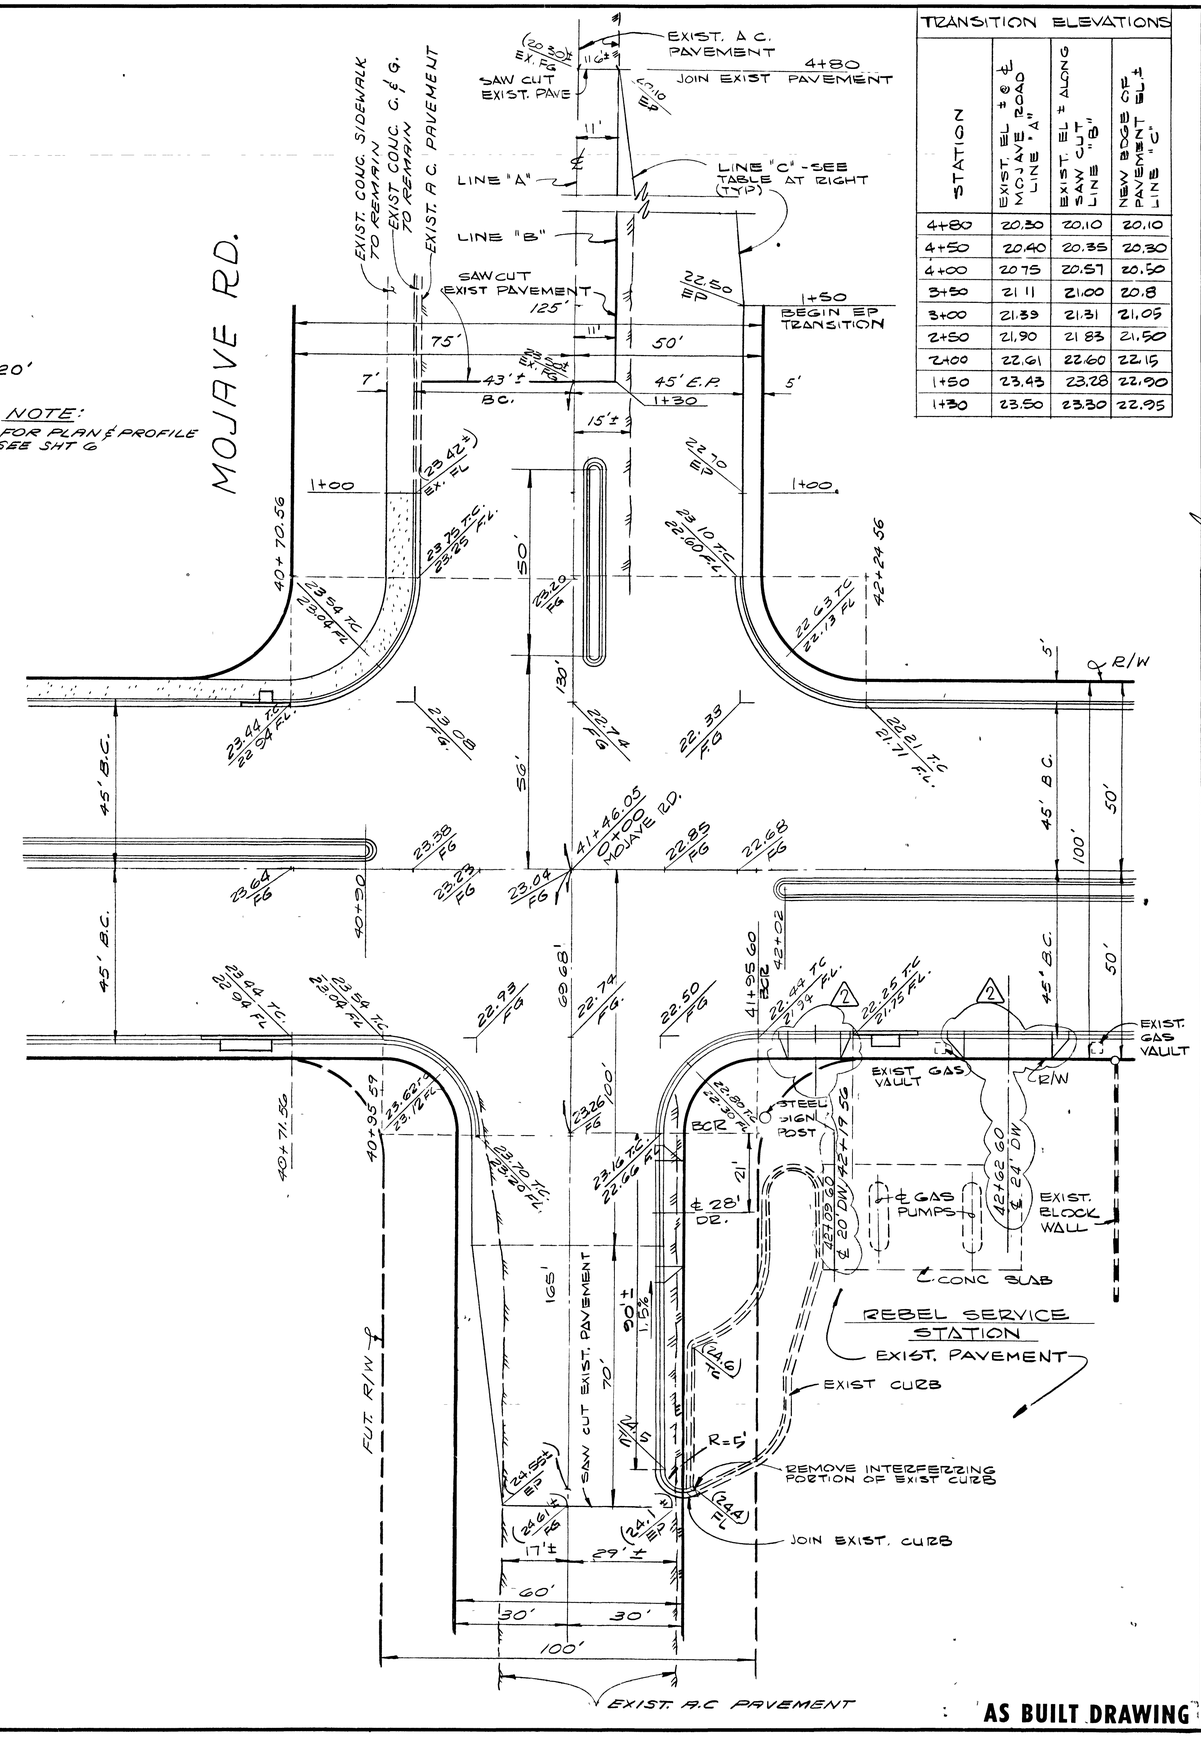

TRANSITION ELEVATIONS

STATION	EXIST. EL ± @ ℄ MOJAVE ROAD LINE "A"	EXIST. EL ± ALONG SAW CUT LINE "B"	NEW EDGE OF PAVEMENT EL ± LINE "C"
4+80	20.30	20.10	20.10
4+50	20.40	20.35	20.30
4+00	20.75	20.57	20.50
3+50	21.11	21.00	20.8
3+00	21.39	21.31	21.05
2+50	21.90	21.83	21.50
2+00	22.61	22.60	22.15
1+50	23.43	23.28	22.90
1+30	23.50	23.30	22.95

REV	DATE	DESCRIPTION
1	5-5-74	EXTEND MEDIAN WEST 25'
2	9-5-75	AS-BUILT

RECOMMENDED G. C. WALLACE — R E NO 7 — DATE 12/5 5/8/73

MONTGOMERY ENGINEERS OF NEVADA — R E NO 23/5 — DATE 5-2-73

WALLACE - MONTGOMERY, A JOINT VENTURE
G. C. WALLACE, Consulting Engineer — MONTGOMERY ENGINEERS OF NEVADA
735-5709 — 735-7198
LAS VEGAS, NEVADA

REGIONAL STREET AND HIGHWAY COMMISSION, CLARK CO., NEV.
EAST CHARLESTON BLVD. FROM FREMONT ST TO NELLIS BLVD

STREET INTERSECTIONS
25 TH STREET AND MOJAVE ROAD

SHEET 19 OF 53 SHEETS

AS BUILT DRAWING

22-4-135 107-V943